

WARREN COUNTY WATER DISTRICT



June 29, 2006

RECEIVED

JUN 30 2006

PUBLIC SERVICE
COMMISSION


MS BETH O'DONNELL
EXECUTIVE DIRECTOR
PUBLIC SERVICE COMMISSION
PO BOX 615
FRANKFORT KY 40602

RE: Case No. 2005-00299
Warren County Water District
Water System Additions – Project 17 Cemetery Road

Dear Ms. O'Donnell:

In accordance with the Commission's Order in the referenced case, enclosed are a copy of the "as-built" drawings and a copy of my letter to the Kentucky Division of Water certifying that construction of the project was completed in accordance with the approved plans and specifications. If you need any additional information, please let us know.

Sincerely,


Jonathan E. Schubarth, P.E.
Manager of Engineering

js

Enclosures:



WARREN COUNTY WATER DISTRICT



June 1, 2006

MS DONNA S MARLIN
DRINKING WATER BRANCH
DEPT FOR ENVIRONMENTAL PROTECTION
FRANKFORT OFFICE PARK
14 REILLY ROAD
FRANKFORT KY 40601

Re: DW #1140487-03-011
Project 17/Cemetery Road
Warren County, Kentucky

Dear Ms. Marlin:

In accordance with the Division of Water approval letter dated December 3, 2003, this is to affirm that the water lines and appurtenances on the referenced project are complete and in service. All work has been performed in accordance with the approved Drawings, Specifications, Change Orders, and stipulations.

If we can provide any additional information at this time, please let us know.

Sincerely,

Jonathan E. Schubafth, P.E.
Manager of Engineering

js



WATER SYSTEM ADDITIONS - PROJECT 17

WARREN COUNTY WATER DISTRICT

WARREN COUNTY, KENTUCKY


(AS BUILT)

PROPOSED PLANS

CEMETERY ROAD TRANSMISSION FACILITIES

INDEX OF DRAWINGS

SHEET NO.	DESCRIPTION
DW01	PLAN & PROFILE LINE TA STA. 0+00 THRU STA. 14+00
DW02	PLAN & PROFILE LINE TA STA. 14+00 THRU STA. 20+21
DW03	PLAN & PROFILE LINE TB STA. 1+54 THRU STA. 16+00
DW03A	DRAKES CREEK CROSSING
DW04	PLAN & PROFILE LINE TB STA. 16+00 THRU STA. 31+00
DW05	PLAN & PROFILE LINE TB STA. 31+00 THRU STA. 45+00
DW06	PLAN & PROFILE LINE TB STA. 45+00 THRU STA. 55+00
DW06A	PRESSURE REDUCING STATION
DW07	PLAN & PROFILE LINE TB STA. 55+00 THRU STA. 70+00
DW08	PLAN & PROFILE LINE TB STA. 70+00 THRU STA. 78+00
DW09	PLAN & PROFILE LINE TB STA. 78+00 THRU STA. 93+00
DW10	PLAN & PROFILE LINE TB STA. 93+00 THRU STA. 104+00
DW11	PLAN & PROFILE LINE TB STA. 104+00 THRU STA. 118+00
DW12	PLAN & PROFILE LINE TB STA. 118+00 THRU STA. 135+00
DW13	PLAN & PROFILE LINE TB STA. 135+00 THRU STA. 147+00
DW14	PLAN & PROFILE LINE TB STA. 147+00 THRU STA. 162+50
DW15	PLAN & PROFILE LINE TB STA. 162+50 THRU STA. 178+00
DW16	PLAN & PROFILE LINE TB STA. 178+00 THRU STA. 193+00
DW17	PLAN & PROFILE LINE TB STA. 193+00 THRU STA. 208+00
DW18	PLAN & PROFILE LINE TB STA. 208+00 THRU STA. 223+00
DW19	PLAN & PROFILE LINE TB STA. 223+00 THRU STA. 238+00
DW20	PLAN & PROFILE LINE TB STA. 238+00 THRU STA. 253+25
DW21	PLAN & PROFILE LINE TB STA. 253+25 THRU STA. 268+00
DW22	PLAN & PROFILE LINE TB STA. 268+00 THRU STA. 272+94
1W01CBA	DRAKES CREEK PUMPING STATION ELECTRICAL PLAN
1W01CBB	DRAKES CREEK PUMPING STATION ELECTRICAL PLAN
DWWD	STANDARD WATERWORKS DETAILS

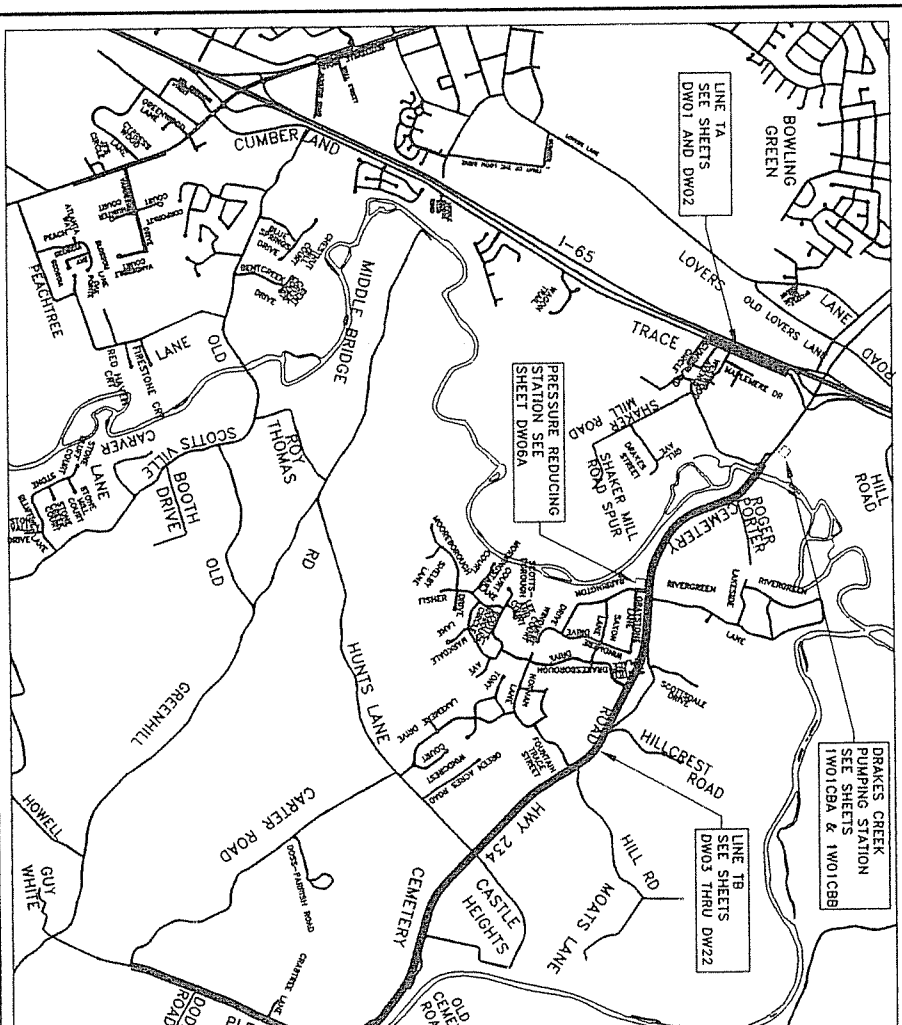



RECEIVED
JUN 30 2006
PUBLIC SERVICE
COMMISSION

First Class Mail

WARREN COUNTY WATER DISTRICT

523 U.S. Hwy. 31-W By-Pass • P.O. Box 10180 • Bowling Green, KY 42102-4780
Phone: 270.842.0052 • Fax: 270.842.8360

To:

MS BETH O'DONNELL
EXECUTIVE DIRECTOR
PUBLIC SERVICE COMMISSION
PO BOX 615
FRANKFORT KY 40602

CONTENTS: FIRST CLASS MAIL OR FOURTH CLASS MAIL.
POSTMASTER: THIS PARCEL MAY BE OPENED FOR INSPECTION.