

Northern Kentucky Water District

August 28, 2015

Ms. Linda Faulkner, Director
Division of Filings
Kentucky Public Service Commission
P.O. Box 615
Frankfort, KY 40602

RECEIVED
AUG 31 2015
PUBLIC SERVICE
COMMISSION

RE: Case No. 2014-00100
FTTP 36" Raw Water Extension

Ms. Faulkner:

Below is the break down of construction costs for the above mentioned case number. The amounts are classified into appropriate accounts in accordance with the Uniform System of Accounts.

Account #331, Water Mains	\$ 1,127,426.49
Account #335, Hydrants	\$ <u>30,095.57</u>
Total Project Cost	\$ 1,157,522.06

I have also enclosed copies of "as-built" drawings and a statement that the project construction was inspected under the supervision of a Professional Engineer and has been completed in accordance with the approved plans and specifications as required by this order. This should complete all items as required by this order. If you have any questions, please be sure to let me know.

Sincerely,



Bob Harthun
Construction Supervisor

Enclosures (2)

Cc: File

Mr. Jack Bragg – V.P. Financial, NKWD
Mr. Jack Hughes – District PSC Attorney

BURGESS & NIPLE

312 Plum Street | 12th Floor | Cincinnati, OH 45202 | 513.579.0042

Mr. Kyle Ryan
Northern Kentucky Water District
2835 Crescent Springs Road
P.O. Box 18640
Erlanger, KY 41018

RE 36" Raw Water Main Project
Fort Thomas Treatment Plant
Construction Certification

August 27, 2015

Dear Mr. Ryan;

During the construction of the above project, Burgess & Niple, Inc. completed spot check observations on the construction activities. With these observations along with the day to day observations by Northern Kentucky Water District inspector, the project was completed to the best of our knowledge in accordance with the plans and specifications.


If there are any questions, do not hesitate to call.

Sincerely,



Donald W Bezold, PE
Project Engineer



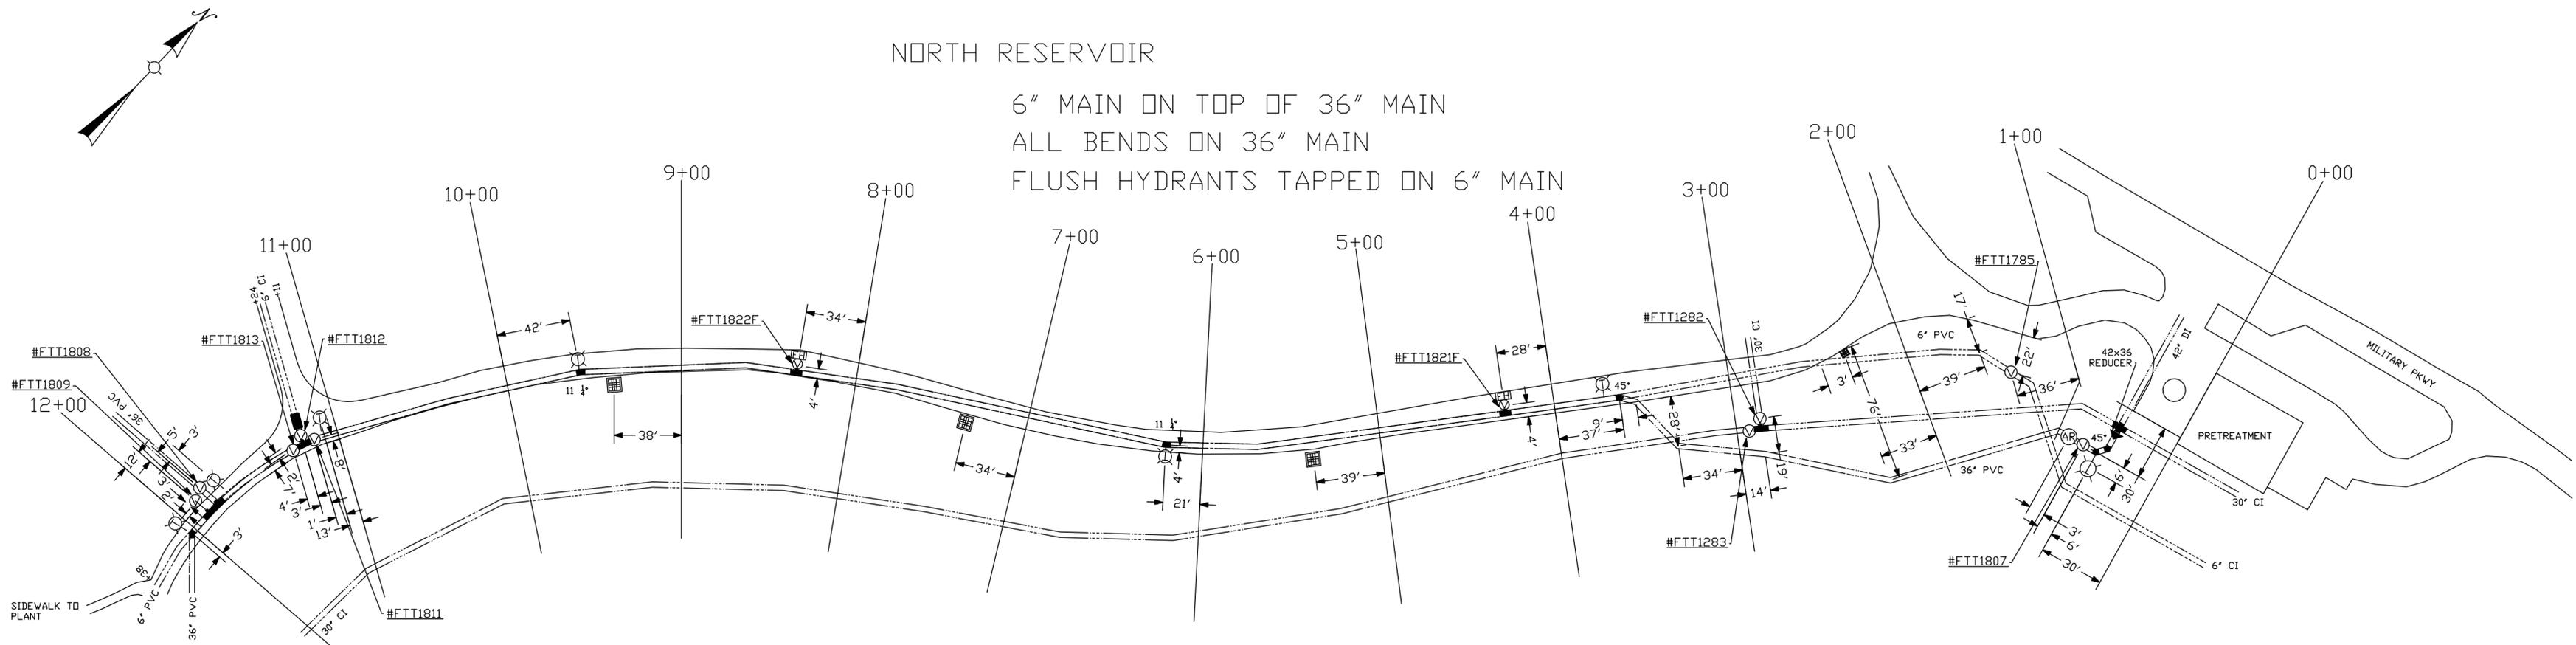

NORTH RESERVOIR

6" MAIN ON TOP OF 36" MAIN
 ALL BENDS ON 36" MAIN
 FLUSH HYDRANTS TAPPED ON 6" MAIN


- LEGEND**
- ==== 30" WATER MAIN
 - ==== 36" WATER MAIN
 - ==== 42" WATER MAIN
 - ==== 4" WATER MAIN
 - ==== 6" WATER MAIN
 - ==== 8" WATER MAIN
 - ▬ = DRAIN
 - ⊠ = TEST BOX
 - ⊙ = VALVE
 - ⊙ = METER
 - ⊙ = UTILITY POLE
 - ⊠ = FLUSH HYDRANT
 - ⊗ = FIRE HYDRANT
 - ⊠ = METER INSIDE
 - ⊙ = LAMP POST

S-22		REC-633	
NORTHERN KENTUCKY WATER DISTRICT LOCATION MAPS			
FT THOMAS TREATMENT PLANT			
DRAWN BY: SAR	REvised DATE:	SCALE: 1" = 50'	DATE: 5-1-15
TRACED BY: SAR		DRAWING NO.:	CC226A
CHECKED BY: TK			
FIELD BOOK NO.:			

SEE MAP #CC226B

PRETREATMENT

MILITARY PKWY

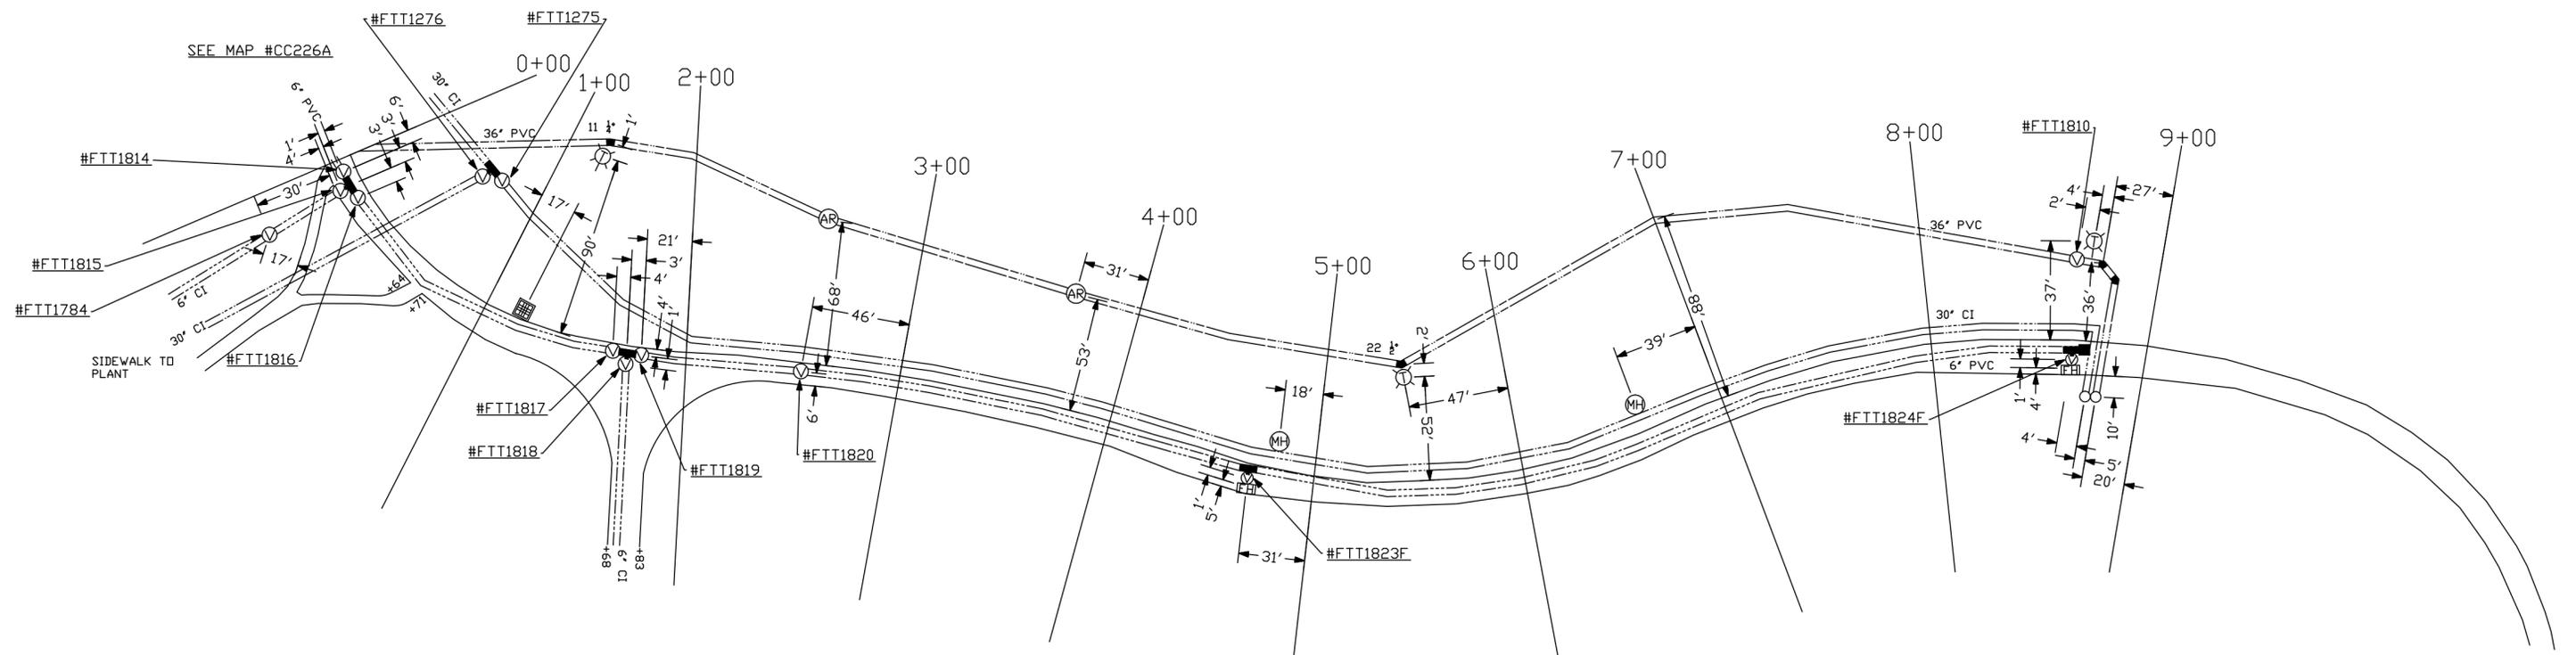

SOUTH RESERVOIR

- LEGEND**
- ==== 30" WATER MAIN
 - ==== 36" WATER MAIN
 - ==== 4" WATER MAIN
 - ==== 6" WATER MAIN
 - ==== 8" WATER MAIN
 - ===== DRAIN
 - ⊠ = TEST BOX
 - ⊙ = VALVE
 - ⊙ = METER
 - ⊙ = UTILITY POLE
 - ⊠ = FLUSH HYDRANT
 - ⊗ = FIRE HYDRANT
 - ⊠ = METER INSIDE
 - ⊙ = LAMP POST

S-22		REC-633	
NORTHERN KENTUCKY WATER DISTRICT LOCATION MAPS			
FT THOMAS TREATMENT PLANT			
DRAWN BY: SAR	REVISD DATE		
TRACED BY: SAR	SCALE: 1" = 50'		
CHECKED BY: TK	DATE: 5-1-15		
FIELD BOOK NO.	DRAWING NO.	CC226B	