

COMMONWEALTH OF KENTUCKY
BEFORE THE PUBLIC SERVICE COMMISSION

In the Matter of:

APPLICATION OF UNITED STATES CELLULAR)
OPERATING COMPANY (FORMERLY KNOWN AS)
KENTUCKY RSA #9-10, INC.) FOR A CERTIFICATE)
OF PUBLIC CONVENIENCE AND NECESSITY TO)
CONSTRUCT A CELL SITE ONE MILE NORTH OF) CASE NO. 97-190
LEE CITY, OFF HIGHWAY 205 SOUTH, NEAR EXIT)
57 (HELECHAWA INTERCHANGE) OF THE)
MOUNTAIN PARKWAY, IN WOLFE COUNTY,)
KENTUCKY (LEE CITY SITE))

O R D E R


The Commission has received the attached letter from Donnie McQuire regarding the proposed telecommunications services facility to be located 2200 feet east of Highway 205, approximately 1500 feet southeast of Exit 57 on the Mountain Parkway, Wolfe County, Kentucky.

IT IS THEREFORE ORDERED that:

1. United States Cellular Operating Company ("United States Cellular") shall respond to Mr. McQuire's concerns by certified letter, within 10 days from the date of this Order.
2. United States Cellular shall file a copy of the certified letter and dated receipt, within 7 days of the date on the receipt.

Done at Frankfort, Kentucky, this 21st day of May, 1997.

ATTEST:


Executive Director

PUBLIC SERVICE COMMISSION


For the Commission

RECEIVED

MAY 05 1997

PUBLIC SERVICE
COMMISSION

Dear Public Service Commission

This letter is to inform you and United States Cellular of 3101 North Green River Road, Suite 530 Evansville, Indiana 47715 that I, Donnie McQuinn, of 8370 old KY 15 41360 want no part of this project.

I do not want this facility to interfere in any way with the use or control of said property in any way, shape, form or fashion.

Please address concerns to:

Donnie McQuinn

8370 old KY 15

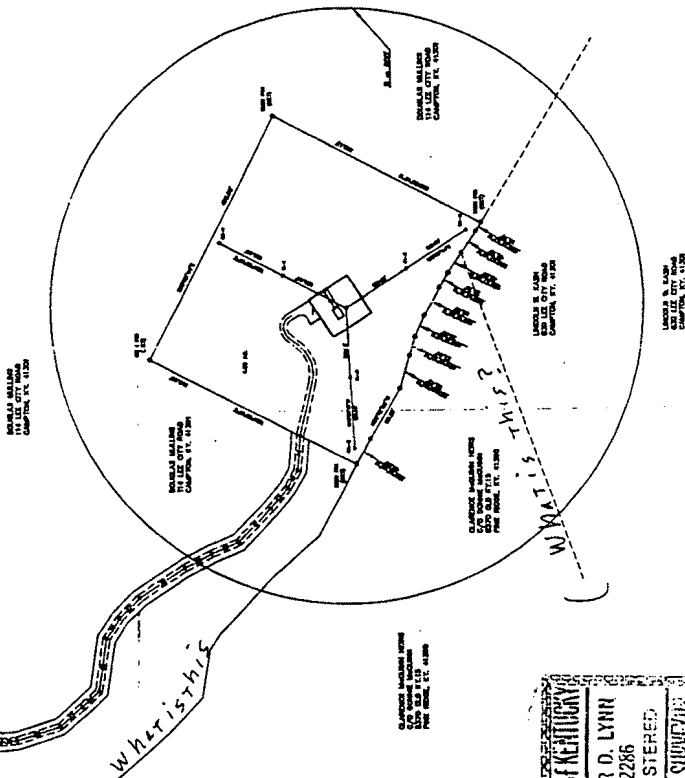
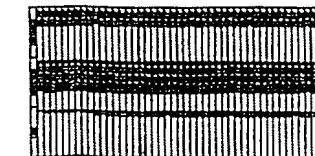
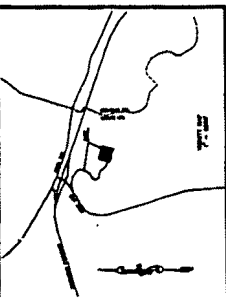
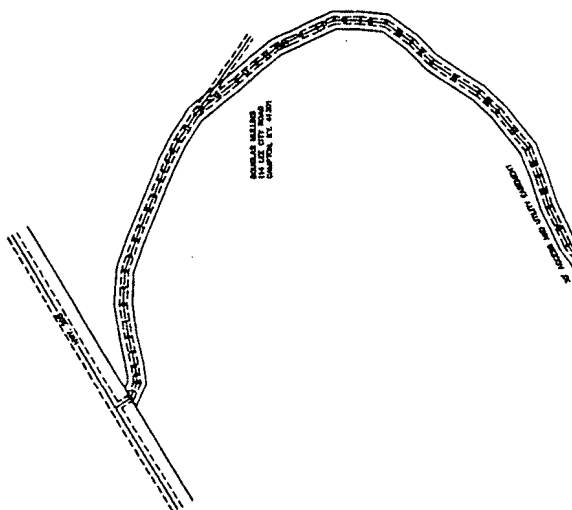
Line Ridge, KY 41360

606-668-6337-3106

This letter refers to:

KY RSA #9-10 INC.

Case # 97190

[illegible][illegible]

KENTUCKY RSA #10 INC. C/O UNITED STATES CELLULAR EVANSVILLE, INDIANA		TOPOGRAPHIC SURVEY, SITE PLAN & GROUNDING PLAN	
DATE OF SURVEY 10/20/87	DATE OF PLAN 10/20/87	LOCATION LOCATED ON HWY 30S WEST CORNERS, KENTUCKY	DRAWING NO. 10/20/87
A S C R L L INC.		ASSOCIATED ENGINEERS, INC.	
DATE OF SURVEY 10/20/87	DATE OF PLAN 10/20/87		

STATE OF KENTUCKY
ROGER D. LYNN
2286
REGISTERED
LAND SURVEYOR

ALL INFORMATION CONTAINED HEREIN IS UNCLASSIFIED
DATE 11-11-2010 BY 60322 UCBAW