

NORTHERN KENTUCKY WATER DISTRICT KENTON COUNTY, KENTUCKY



TAYLOR MILL TREATMENT PLANT BELT FILTER PRESS REPLACEMENT

**DRAWINGS FOR:
NKWD PROJECT NO. 184-0488
GRW PROJECT NO. 4384**

JULY, 2017

RON LOVAN _____ PRESIDENT/CEO
 NORTHERN KENTUCKY WATER DISTRICT BOARD OF COMMISSIONERS
 FRED A. MACKE, JR. _____ CHAIRPERSON
 CLYDE CUNNINGHAM _____ VICE CHAIRPERSON
 DAVID M. SPAULDING, ESQ. _____ SECRETARY
 DOUGLAS C. WAGNER, CDT _____ TREASURER
 DR. PATRICIA SOMMERKAMP _____ COMMISSIONER
 JOSEPH J. KOESTER _____ COMMISSIONER




801 CORPORATE DRIVE
LEXINGTON, KY 40503

THIS RECORD DOCUMENT HAS BEEN PREPARED BASED ON INFORMATION PROVIDED BY THE CONSTRUCTION CONTRACTOR GRW ENGINEERS, INC. HAS ATTEMPTED TO VERIFY THE ACCURACY AND/OR COMPLETENESS OF THIS INFORMATION BUT SHALL NOT BE RESPONSIBLE FOR ANY ERRORS OR OMISSIONS WHICH MAY BE INCORPORATED HEREIN AS A RESULT.

GRW
 engineering | architecture | geospatial
 www.grwinc.com


ENGINEER/ARCHITECT: David C. Osborne
 CONSTRUCTION COMPANY: Dugan & Meyers
 DATE: 4/23/19

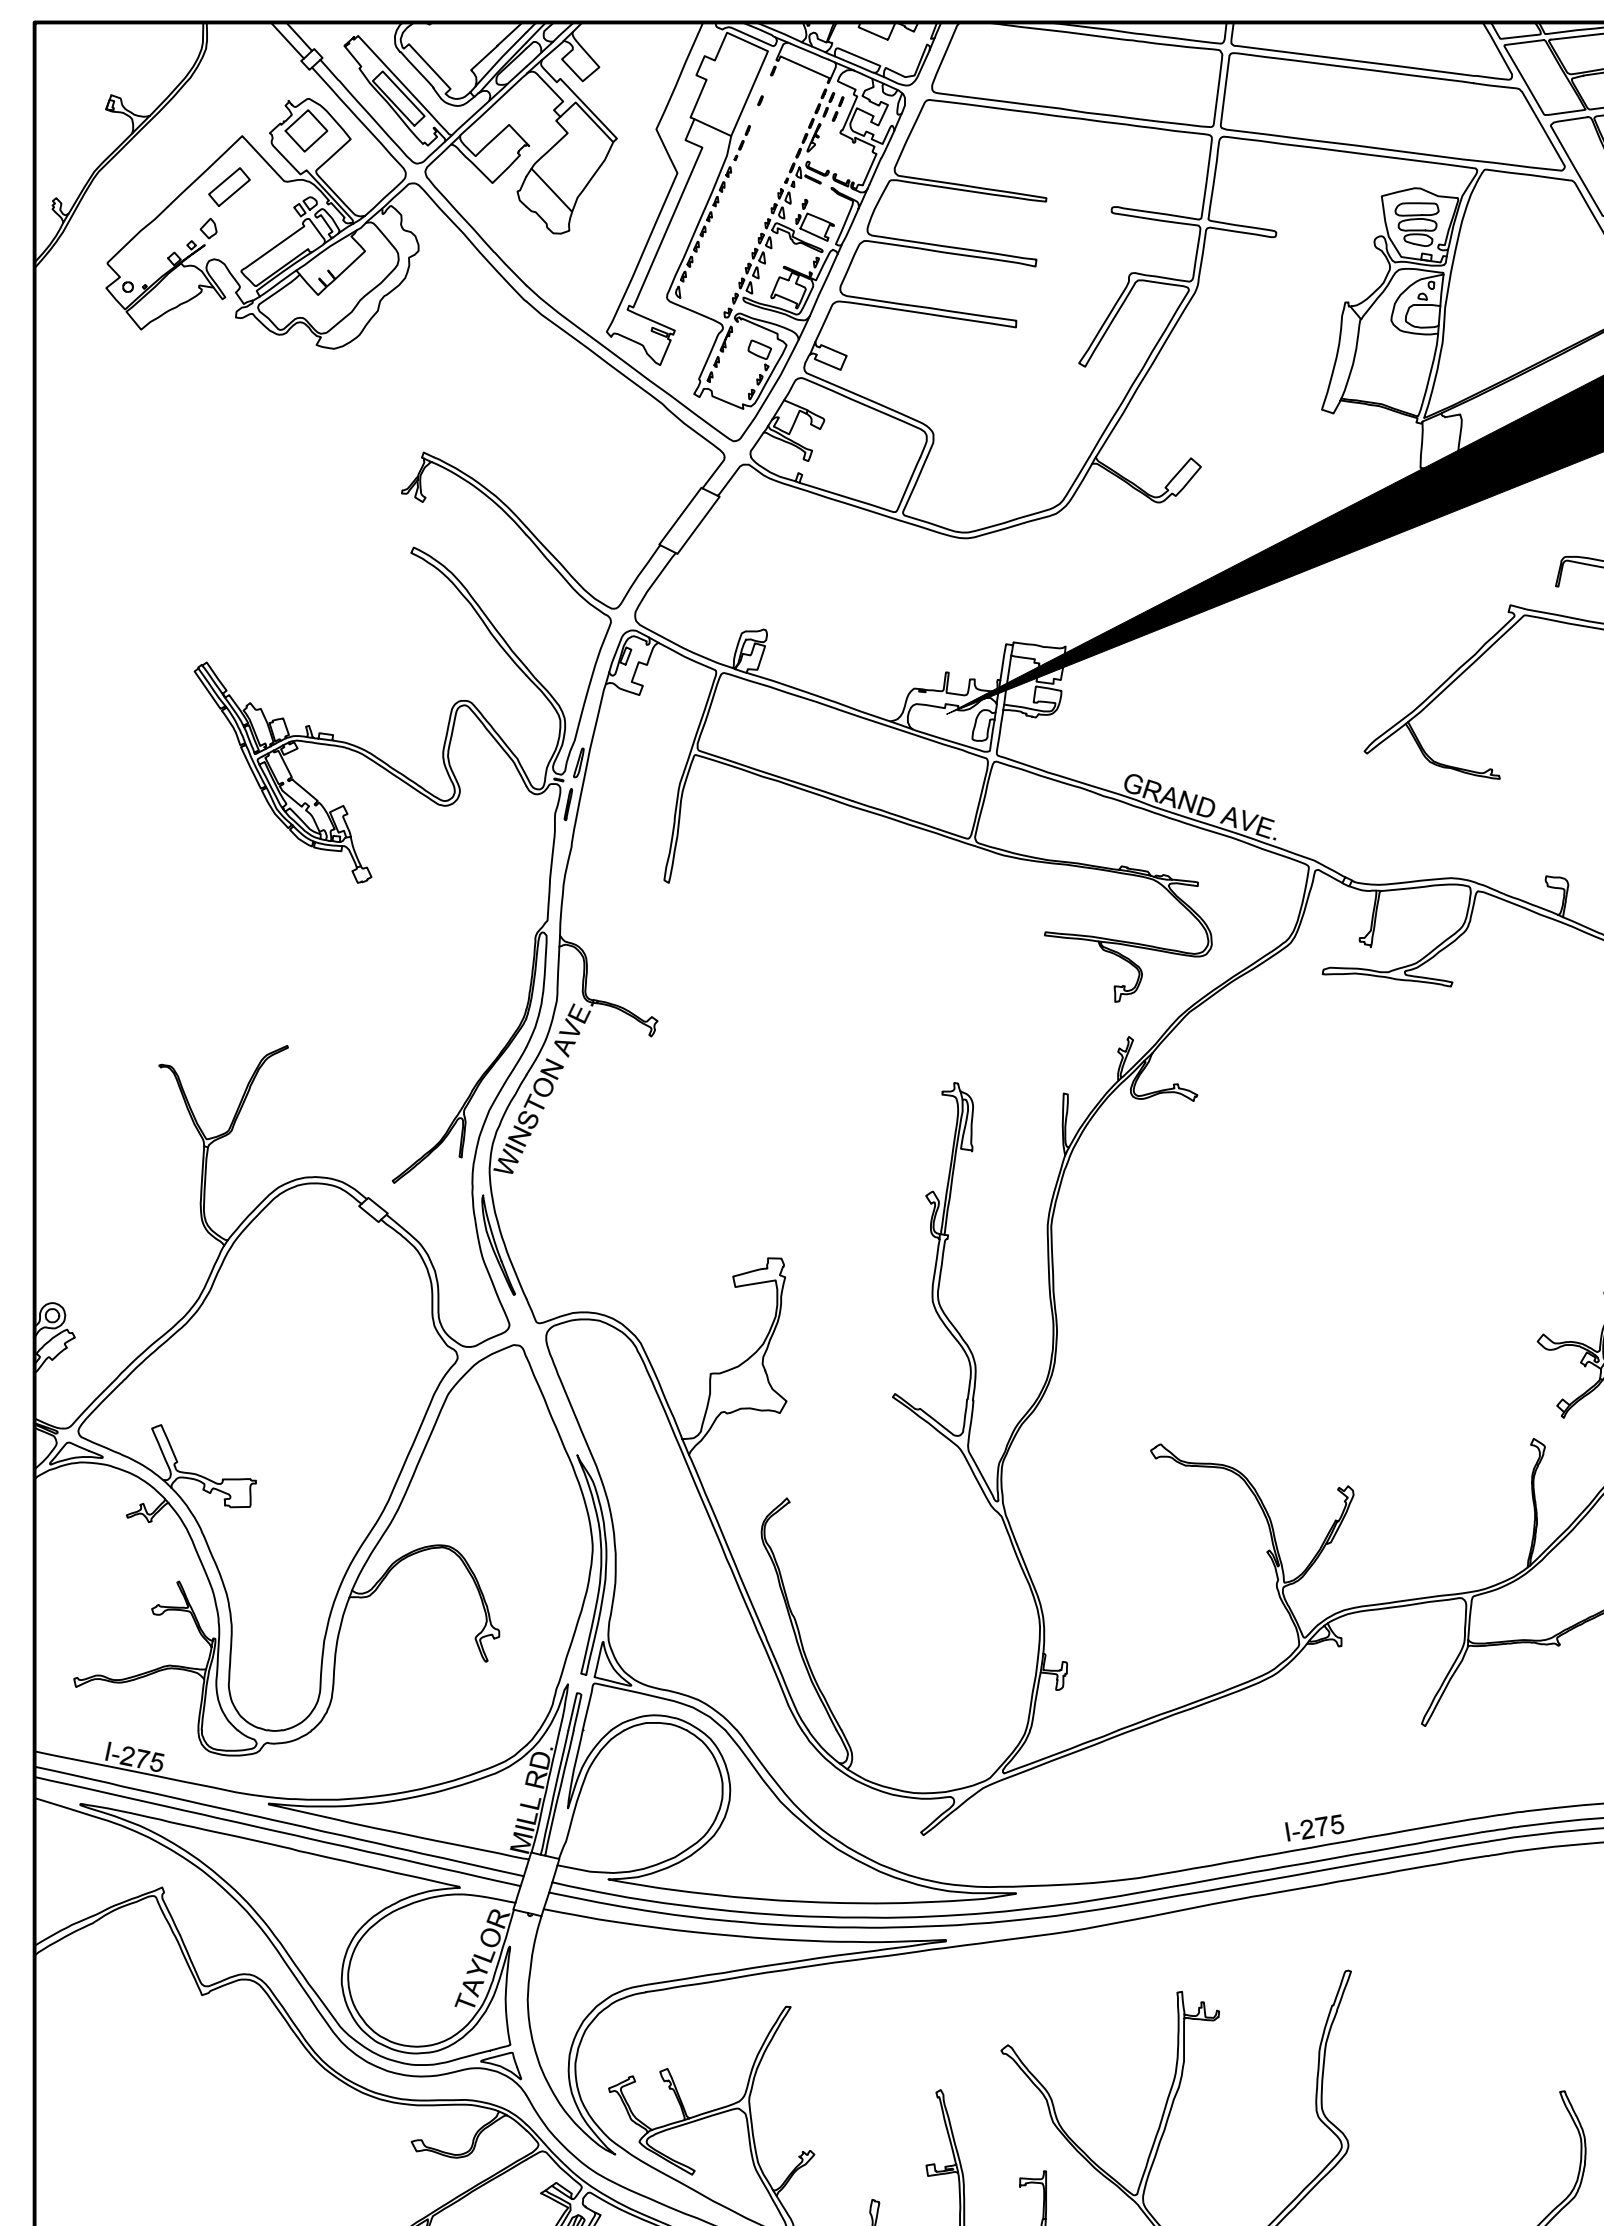

VICINITY MAP
NOT TO SCALE

PROJECT SITE
608 GRAND AVENUE
TAYLOR MILL, KY 41015

PROJECT BUILDING
RESIDUALS HANDLING BUILDING

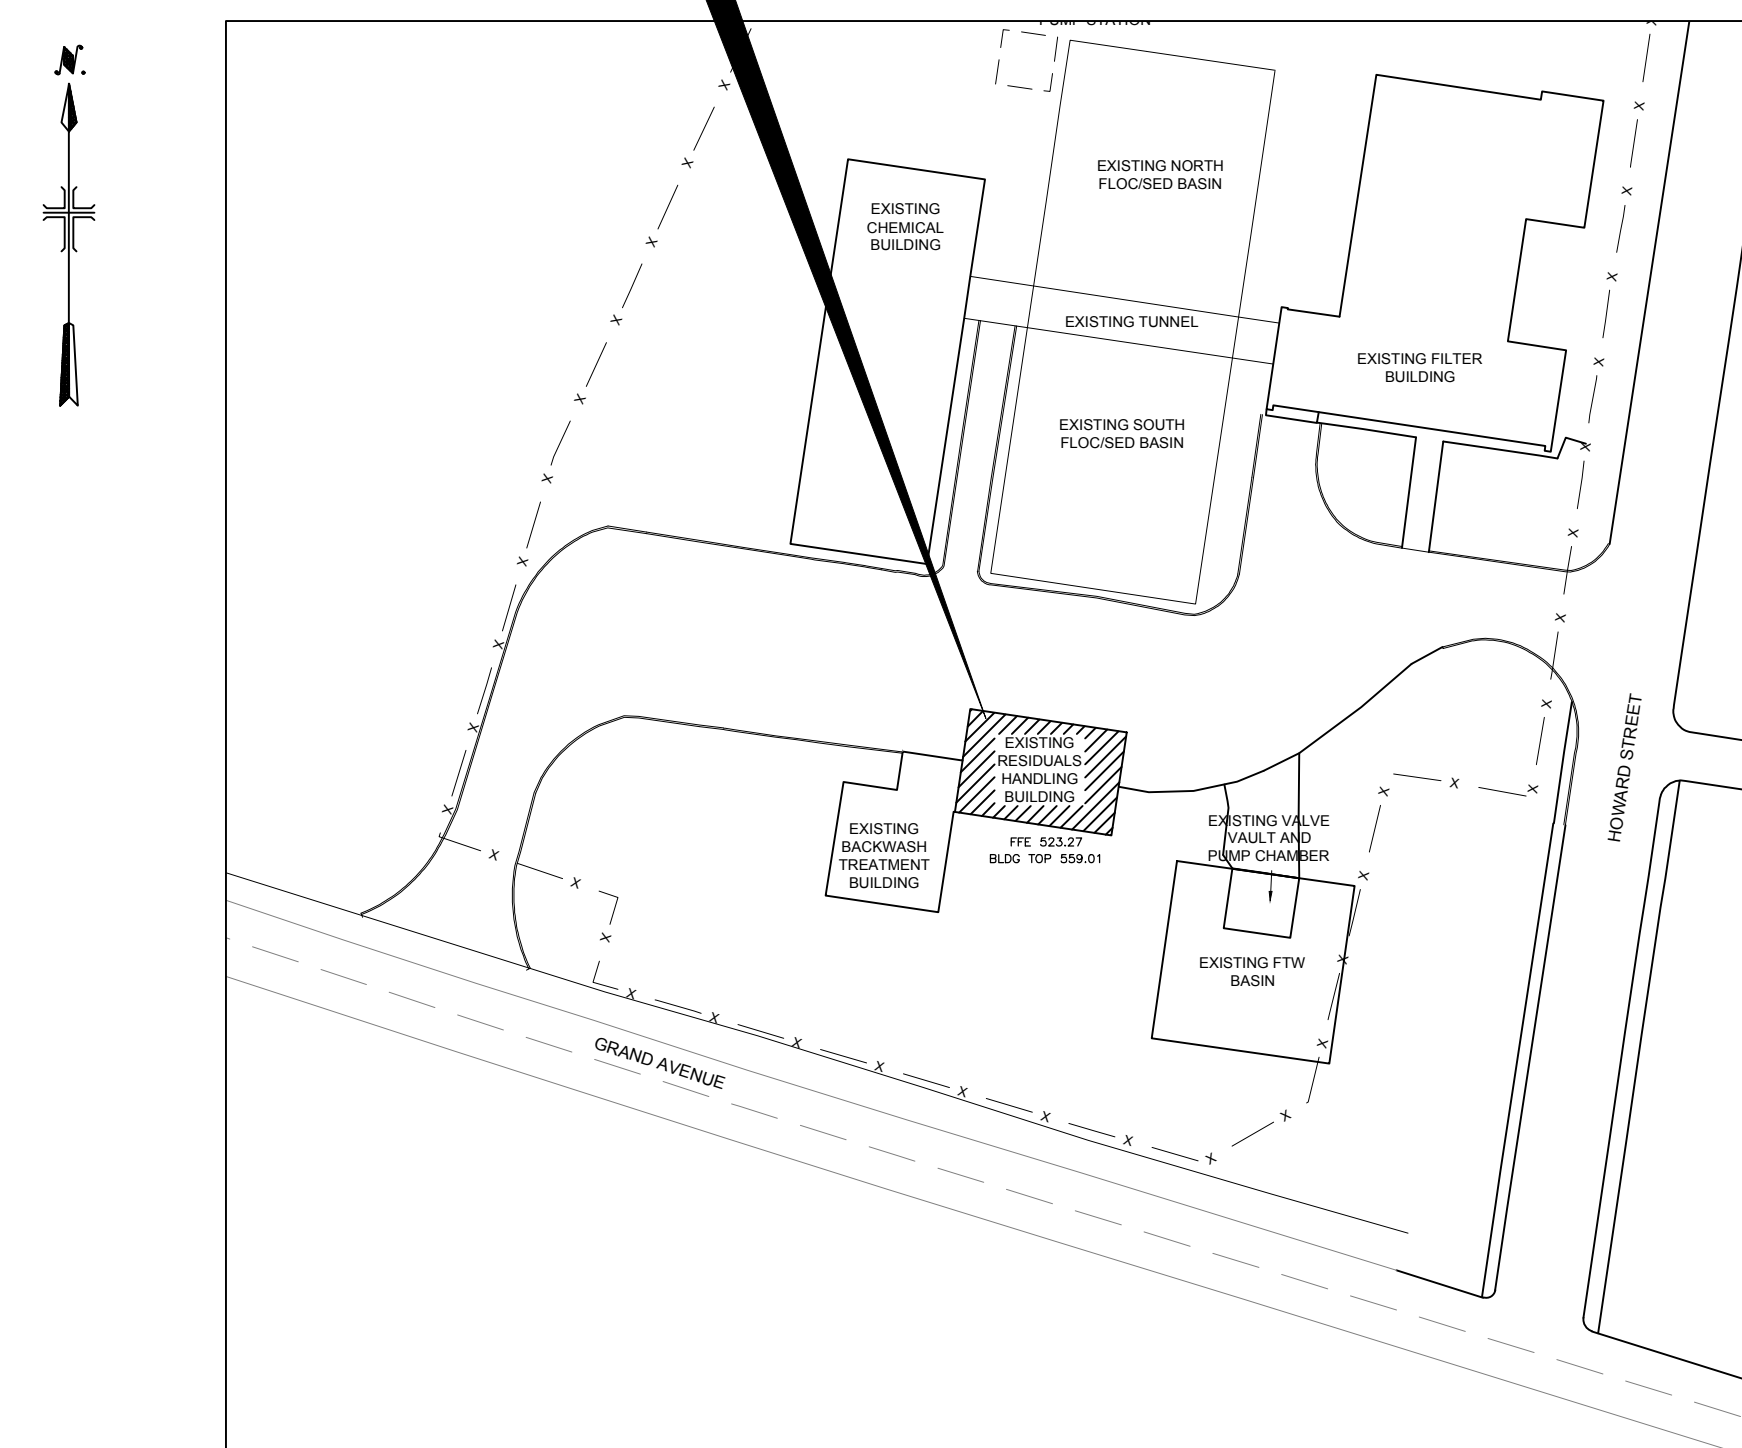

SITE MAP
NOT TO SCALE

PLOTTED BY: mwilliamson

PRINTED: 4/23/2019 @ 2:37PM

FILE NAME: U:\4384-NKVD-TMTP-BFP-Working Drawings\AutoCAD\4384-G-001.dwg

GENERAL

G-001 DRAWING INDEX

CIVIL

C-010 SITE LOCATION PLAN
C-101 BELT FILTER PRESS REPLACEMENT - DEMOLITION PLAN
C-102 BELT FILTER PRESS REPLACEMENT - PLAN AND SECTION

STRUCTURAL

S-001 GENERAL NOTES
S-002 GENERAL NOTES
S-101 FRAMING PLAN
S-501 SECTIONS
S-502 SECTIONS

ARCHITECTURAL

A-001 GENERAL NOTES AND SYMBOLS
A-101 DEMOLITION PLAN
A-102 CONSTRUCTION PLAN
A-401 SECTIONS AND ELEVATIONS
A-501 DETAILS

LIFE SAFETY

LS-101 LIFE SAFETY PLAN

MECHANICAL

M-001 MECHANICAL LEGEND AND GENERAL NOTES
M-101 HVAC PLANS

PLUMBING

P-101 PLUMBING DEMOLITION PLANS
P-102 PLUMBING NEW WORK PLANS
P-601 PLUMBING SCHEDULES AND DETAILS
P-602 PLUMBING RISER DIAGRAMS

ELECTRICAL

E-001 ELECTRICAL SYMBOLS
E-101 ELECTRICAL DEMOLITION PLAN
E-102 LIGHTING DEMO AND NEW WORK PLAN
E-103 ELECTRICAL NEW WORK PLANS
E-601 ELECTRICAL DETAILS AND SCHEDULES
E-602 ELECTRICAL SCHEDULES
E-701 POINT TO POINT
E-702 POINT TO POINT


SHEET NUMBERING LEGEND

X-X-XXX
00X - GENERAL (SYMBOLS LEGEND, NOTES, ETC.)
1XX - PLANS
2XX - ELEVATIONS
3XX - SECTIONS
4XX - LARGE-SCALE VIEWS
5XX - DETAILS
6XX - SCHEDULES AND DIAGRAMS
7XX - USER DEFINED
8XX - USER DEFINED
BUILDING DESIGNATOR
DISCIPLINE DESIGNATOR
G - GENERAL
C - CIVIL
S - STRUCTURAL
A - ARCHITECTURAL
F - FIRE PROTECTION
P - PLUMBING
M - MECHANICAL
E - ELECTRICAL
I - INSTRUMENTATION

GRW PROJECT NO. 4384

CLIENT PROJECT NO.

ALL RIGHTS RESERVED. NO PART OF THIS DOCUMENT SHALL BE REPRODUCED IN WHOLE OR IN PART BY ANY MEANS WITHOUT THE WRITTEN PERMISSION OF GRW ENGINEERS, INC. AND SHALL NOT BE USED FOR ANY OTHER PROJECT OTHER THAN THIS SPECIFIC PROJECT WITHOUT WRITTEN PERMISSION.

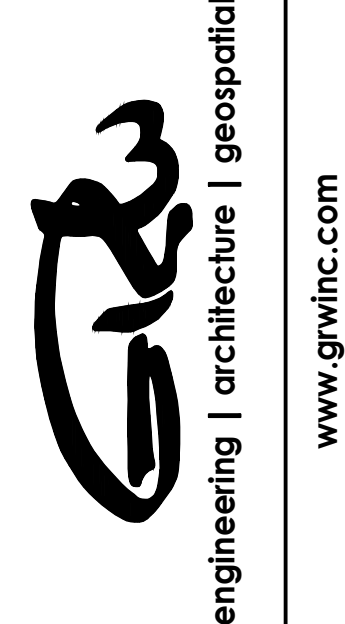

DRAWING INDEX

TAYLOR MILL TREATMENT PLANT
NORTHERN KENTUCKY WATER DISTRICT

DESIGNED: JAB
DRAWN: JAB
REVIEWED: RCC
APPROVED: RCC

NO.	REVISIONS DESCRIPTION	DATE	BY

DATE: APRIL, 2019

SCALE: NONE

SHEET NO.

G-001

THIS RECORD DOCUMENT HAS BEEN PREPARED BASED ON INFORMATION PROVIDED BY THE CONSTRUCTION CONTRACTOR. GRW ENGINEERS, INC. HAS ATTEMPTED TO VERIFY THE ACCURACY AND/OR COMPLETENESS OF THIS INFORMATION BUT SHALL NOT BE RESPONSIBLE FOR ANY ERRORS OR OMISSIONS WHICH MAY BE INCORPORATED HEREIN AS A RESULT.

engineering | architecture | geospatial
www.grwinc.com



ENGINEER/ARCHITECT: David C. Osborne
CONSTRUCTION COMPANY: Dugan & Meyers
DATE: 4/23/19

RECORD DOCUMENTS

PLOTTED BY: mwilliamson

PRINTED: 4/23/2019 @ 2:30PM

FILE NAME: U:\4384-NKVD-TMTP-BFP-Working Drawings\AutoCAD\4384-C-010.dwg

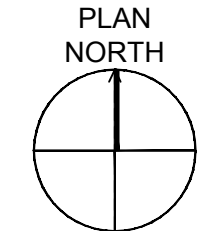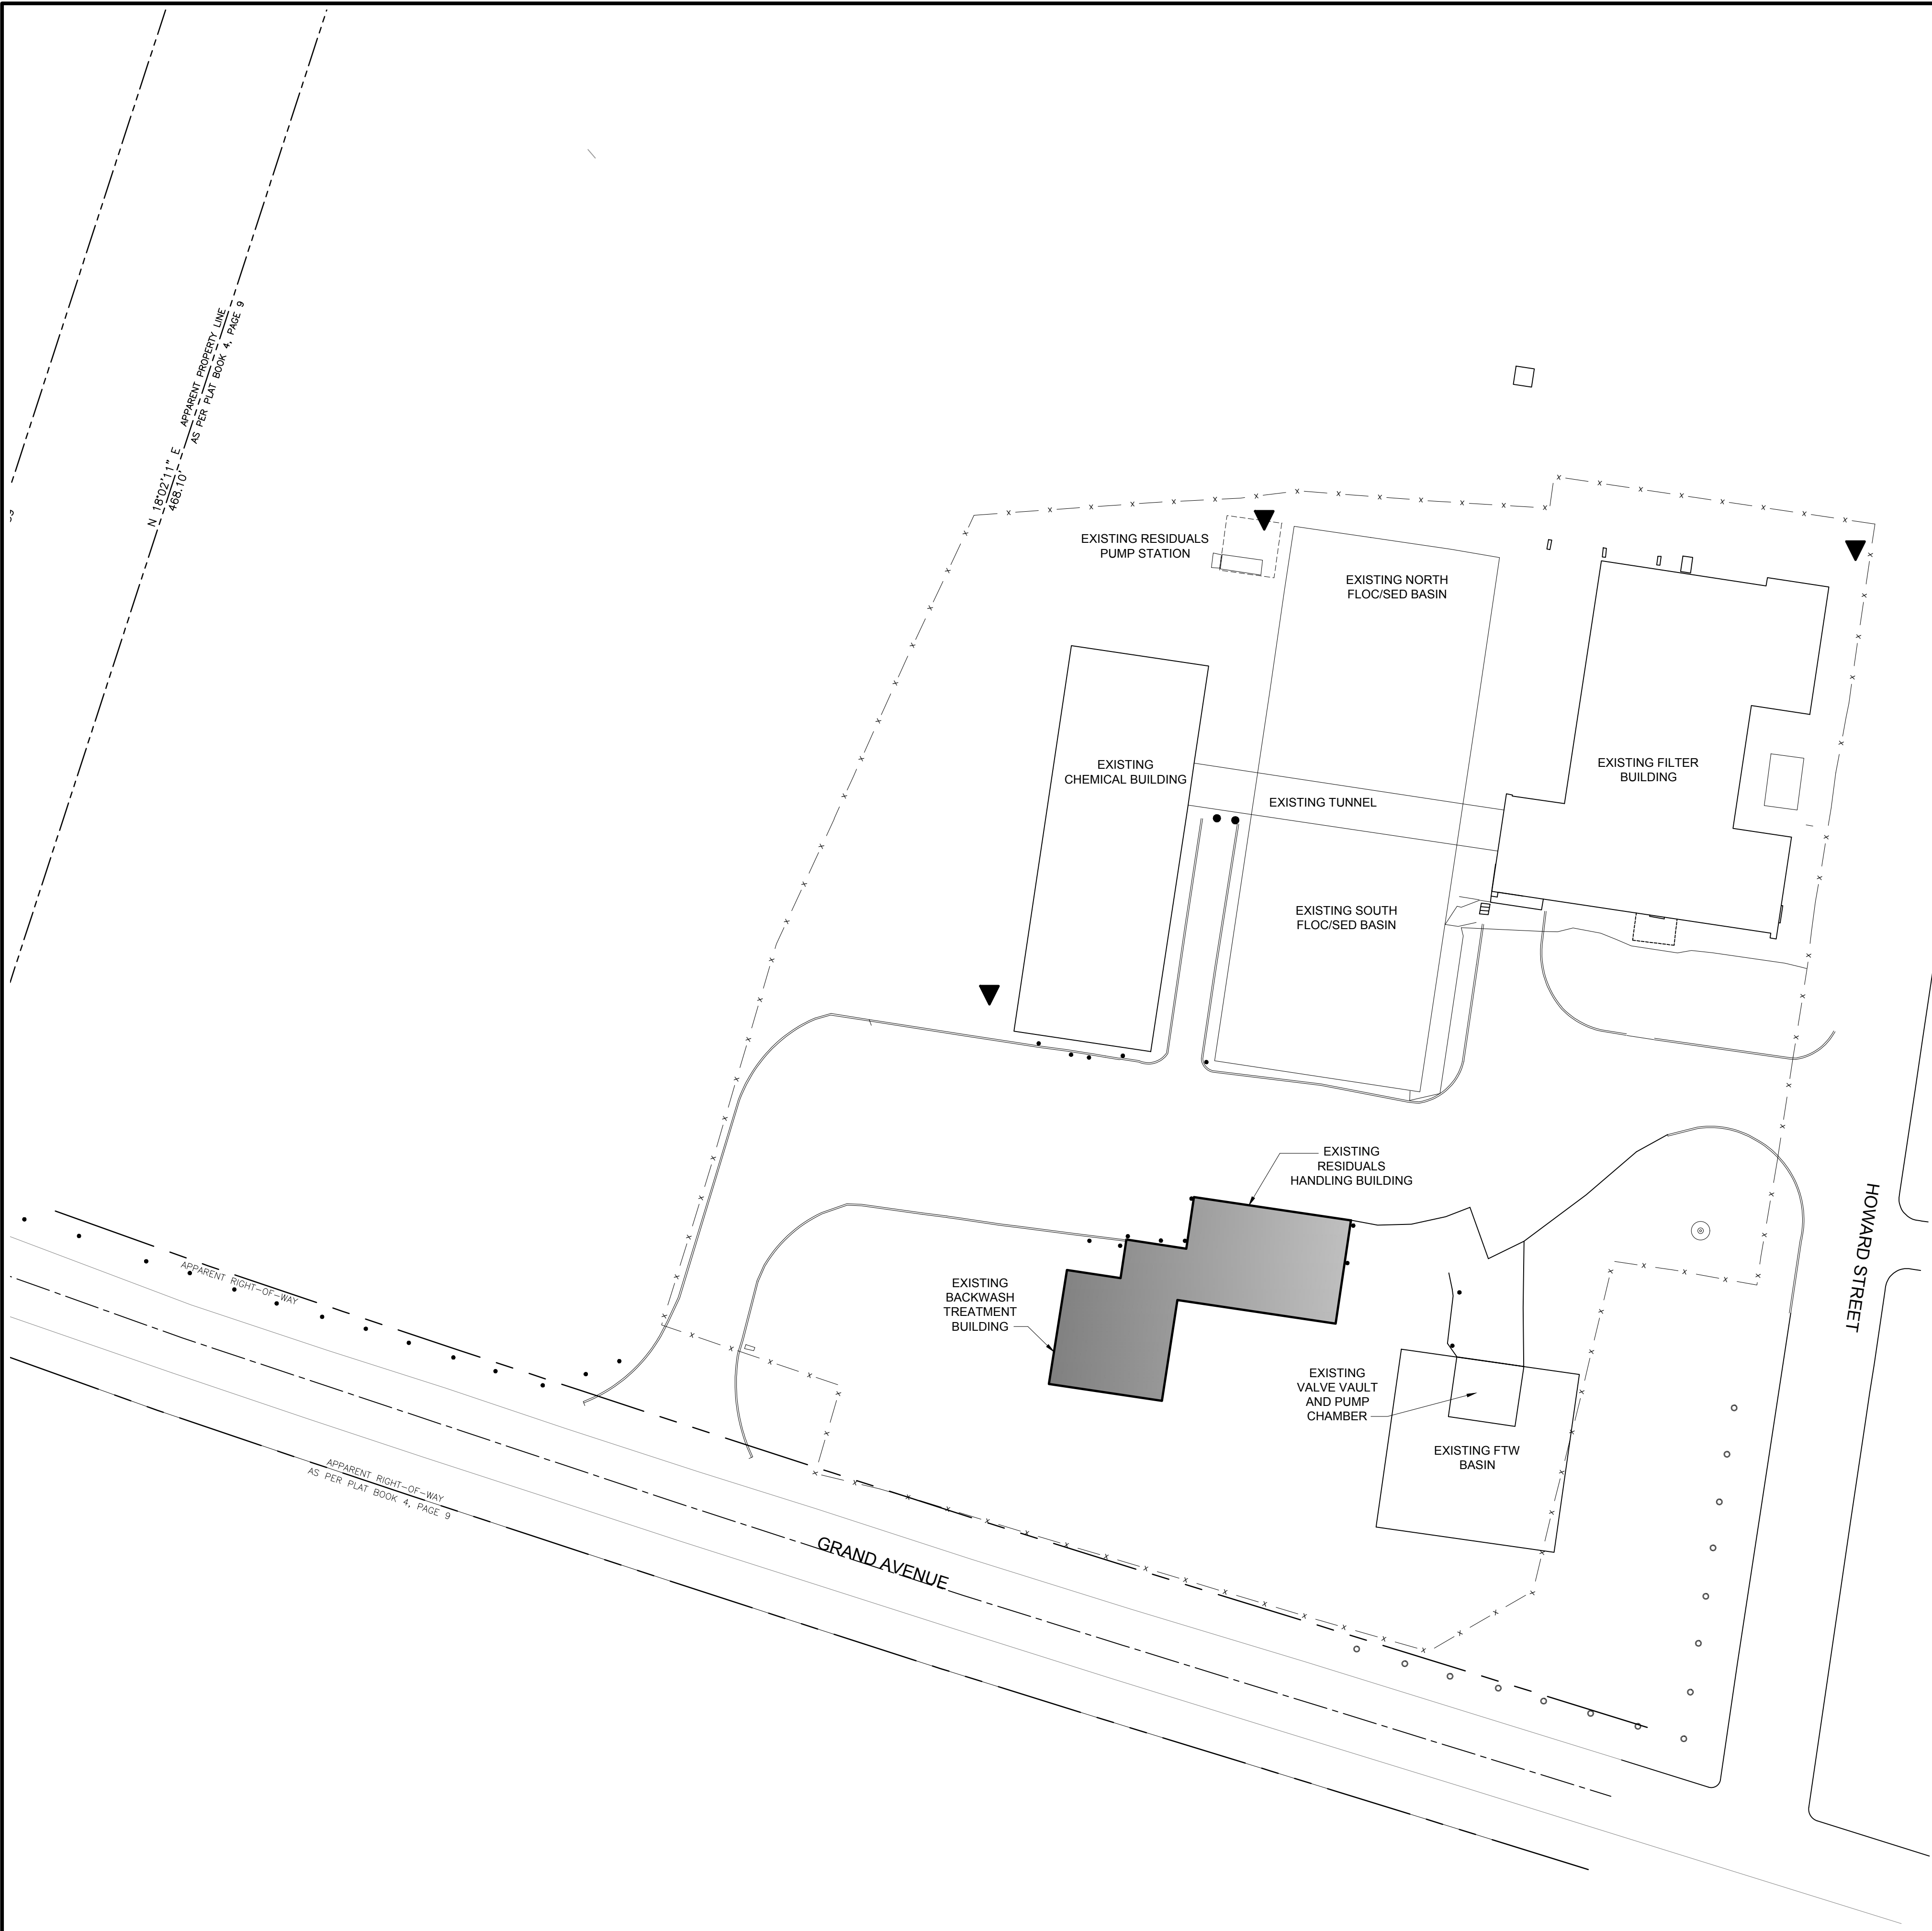

GENERAL NOTES:

1. CONTRACTOR SHALL NOT USE TOP OF FTW BASIN, TOP OF RESIDUALS HOLDING BASIN OR GRAVEL AREA OUTSIDE OF THE FENCE BY THE CHURCH FOR OFFICES, LAYDOWN, PARKING ETC. CONTRACTOR SHALL NOT BLOCK ACCESS TO LOADING DOCKS, DUMPSTER BAYS OR CHEMICAL FILL STATIONS AT ANY TIME. OTHER AREAS INSIDE AND OUTSIDE THE FENCE ON NKVD PROPERTY ARE TENTATIVELY ACCEPTABLE PENDING OWNER APPROVAL.

THIS RECORD DOCUMENT HAS BEEN PREPARED BASED ON INFORMATION PROVIDED BY THE CONSTRUCTION CONTRACTOR GRW ENGINEERS, INC. HAS ATTEMPTED TO VERIFY THE ACCURACY AND/OR COMPLETENESS OF THIS INFORMATION BUT SHALL NOT BE RESPONSIBLE FOR ANY ERRORS OR OMISSIONS WHICH MAY BE INCORPORATED HEREIN AS A RESULT.

GRW
 engineering | architecture | geospatial
 www.grwinc.com

ENGINEER/ARCHITECT: David C. Osborne
 CONSTRUCTION COMPANY: Dugan & Meyers
 DATE: 4/23/19

NO.	REVISIONS DESCRIPTION	DESIGNED		DRAWN		REVIEWED		APPROVED	
		DATE	BY	DATE	BY	DATE	BY	DATE	BY

DATE: APRIL, 2019
 SCALE: 1"=30'
 SHEET NO. C-010


GRW
 engineering | architecture | geospatial
 www.grwinc.com

GRW PROJECT NO. 4384
 CLIENT PROJECT NO.

ALL RIGHTS RESERVED. NO PART OF THIS DOCUMENT SHALL BE REPRODUCED IN WHOLE OR IN PART WITHOUT THE WRITTEN PERMISSION OF GRW ENGINEERS, INC. AND SHALL NOT BE USED FOR ANY OTHER PROJECT OTHER THAN THIS SPECIFIC PROJECT WITHOUT WRITTEN PERMISSION.

SITE LOCATION PLAN
 TAYLOR MILL TREATMENT PLANT
 NORTHERN KENTUCKY WATER DISTRICT

RECORD DOCUMENTS

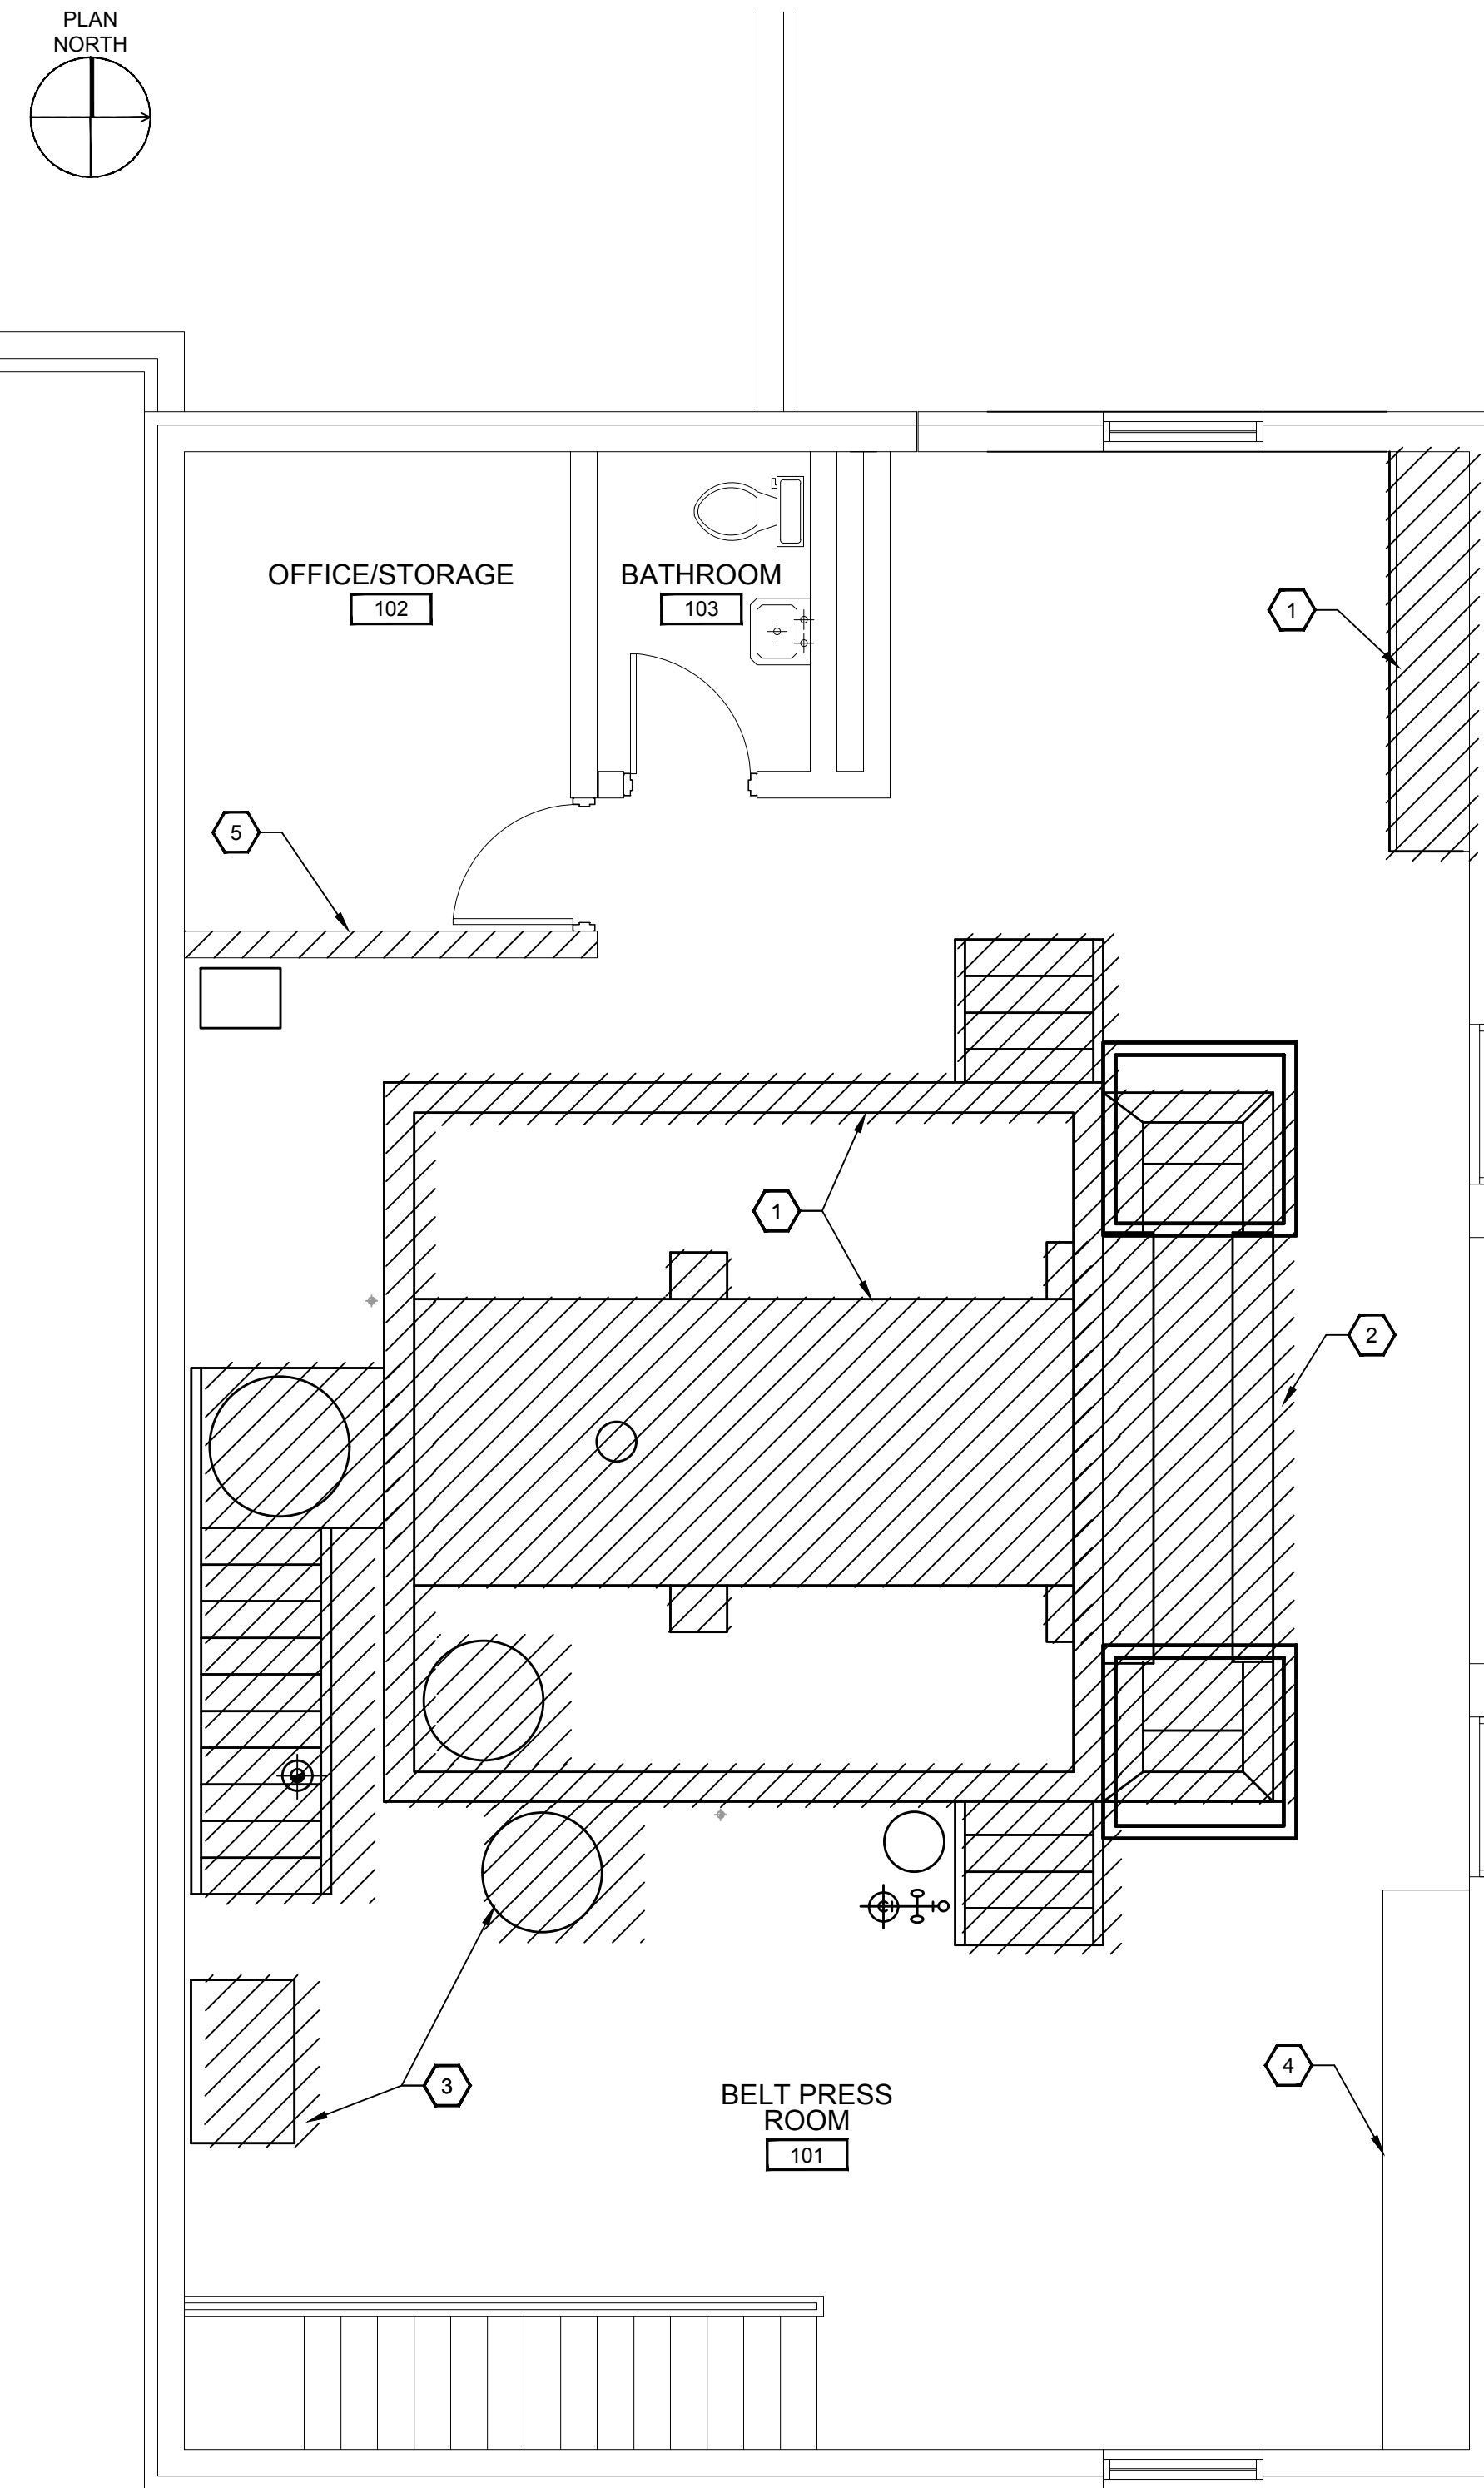

DEMOLITION PLAN

SCALE: 1/4"=1'-0"

□ SHEET KEYNOTES:

1. REMOVE EXISTING BELT FILTER PRESS AND ASSOCIATED PIPING, MOTORS, CONTROL PANELS, CONDUIT, WIRE, CONCRETE CONTAINMENT AREA, SERVICE PLATFORMS, HANDRAIL, ETC.
2. REMOVE EXISTING CONVEYOR SYSTEM AND ASSOCIATED MOTORS, CONTROL PANELS, CONDUIT, WIRE, ETC.
3. REMOVE EXISTING ABANDONED POLYMER FEED SYSTEM AND ASSOCIATED PUMPS, PIPING, MOTORS, CONTROL PANEL, CONDUIT, WIRE, MIXING TANKS, ETC.
4. EXISTING MOTOR CONTROL CENTER (TO REMAIN)
5. EXISTING OFFICE/STORAGE WALL TO BE REMOVED (SEE ARCHITECTURAL SHEETS)

LEGEND

TO BE DEMOLISHED

GENERAL NOTES:

1. ALL REMOVAL AND DEMOLITION SHALL BE COORDINATED WITH THE CONSTRUCTION SEQUENCING SCHEDULE. SEE SPECIFICATION SECTION 013213.
2. NOTES, DIMENSIONS, ETC. TAKEN FROM EXISTING AS-BUILT PLANS. CONTRACTOR SHALL FIELD VERIFY.
3. SALVAGE OF EQUIPMENT AS INDICATED IN SPECIFICATION SECTION 024100.

THIS RECORD DOCUMENT HAS BEEN PREPARED BASED ON INFORMATION PROVIDED BY THE CONSTRUCTION CONTRACTOR. GRW ENGINEERS, INC. HAS ATTEMPTED TO VERIFY THE ACCURACY AND/OR COMPLETENESS OF THIS INFORMATION BUT SHALL NOT BE RESPONSIBLE FOR ANY ERRORS OR OMISSIONS WHICH MAY BE INCORPORATED HEREIN AS A RESULT.

engineering | architecture | geospatial
www.grwinc.com

ENGINEER/ARCHITECT: David C. Osborne
CONSTRUCTION COMPANY: Dugan & Meyers
DATE: 4/23/19

NO.	REVISIONS DESCRIPTION	DESIGNED		DRAWN		REVIEWED		APPROVED	
		DATE	BY	DATE	BY	DATE	BY	DATE	BY

DATE: **APRIL, 2019**
SCALE: **1/4" = 1'-0"**
SHEET NO. **C-101**

BELT FILTER PRESS REPLACEMENT DEMOLITION PLAN

TAYLOR MILL TREATMENT PLANT
NORTHERN KENTUCKY WATER DISTRICT


engineering | architecture | geospatial
www.grwinc.com

GRW PROJECT NO. 4384
CLIENT PROJECT NO. _____

PLOTTED BY: mwilliamson


PRINTED: 4/23/2019 @ 2:33PM

FILE NAME: U:\4384-NK\VD T\TTP BFP\Working Drawings\AutoCAD\4384_C-102.dwg

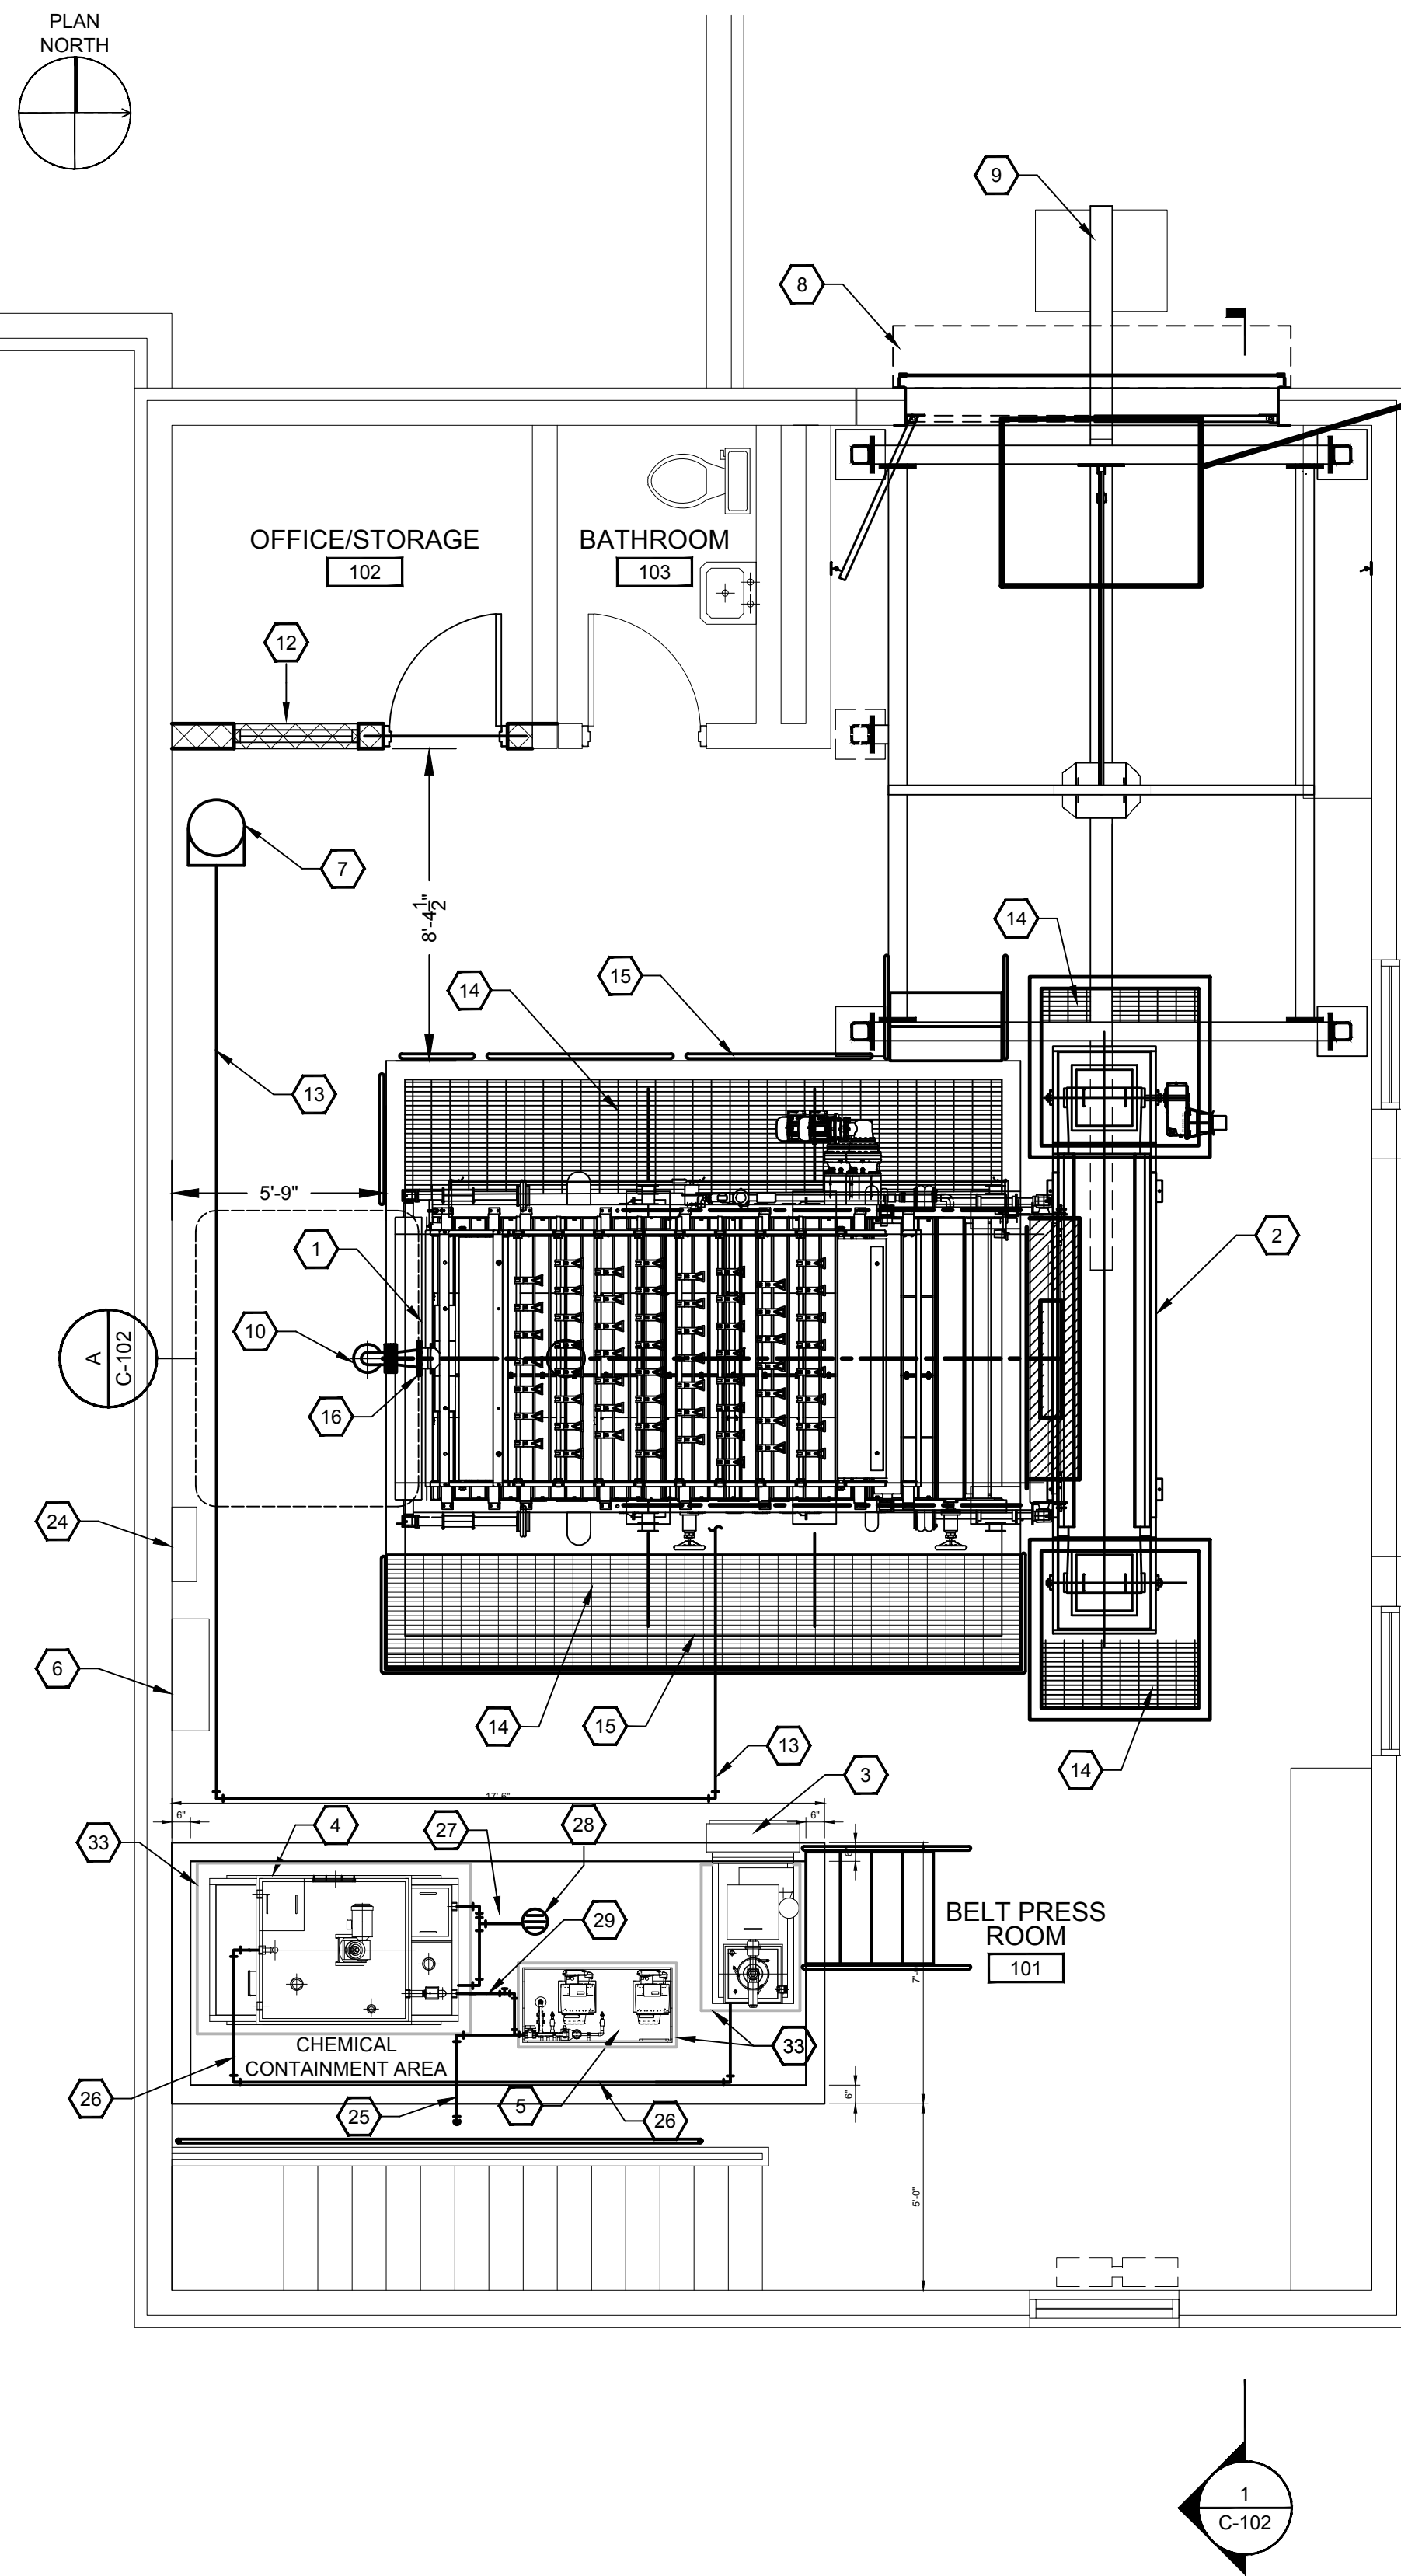

PLAN

SCALE: 1/4"=1'-0"

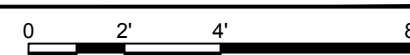


A
C-102

1
C-102



SHEET KEYNOTES:

1. BELT FILTER PRESS
2. BELT CONVEYOR
3. POLYMER PROCESSING MODULE
4. POLYMER MIXING & AGING TANKS
5. POLYMER FEED PUMPS
6. BELT FILTER PRESS CONTROL PANEL
7. AIR COMPRESSOR (SUPPLIED BY PRESS MANUFACTURER)
8. OPENING FOR OVERHEAD COILING DOOR (SEE ARCHITECTURAL DRAWINGS FOR DETAIL)
9. MONORAIL HOIST SYSTEM (SEE STRUCTURAL DRAWINGS FOR DETAIL)
10. 4" DI 90° ELBOW
11. CONNECT TO EXISTING 1/2" POLYMER FEED LINE W/ TEE AND (2) BALL VALVES
12. CONSTRUCT NEW WALL (SEE ARCHITECTURAL & STRUCTURAL SHEETS)
13. 1/4" POLYURETHANE AIR LINE CONDUIT
14. 2" ALUMINUM GRATING (TYP.) (SEE STRUCTURAL SHEETS FOR DETAIL)
15. REMOVABLE 1-1/2" ALUMINUM HANDRAIL SYSTEM (SEE ARCHITECTURAL SHEETS FOR DETAIL)
16. 6" X 4" DI REDUCER
17. 4" DI PIPE
18. CORE DRILL FLOOR SLAB FOR 4" DI PIPE PENETRATION AND SEAL W/ MODULAR EPDM PIPE PENETRATION SEAL ELEMENT
19. 4" PLUG VALVE W/ HANDWHEEL
20. 4"x4"x4" DI TEE
21. 4" DI 45° ELBOW
22. 4" DI FLANGE FILLER
23. CONTRACTOR TO CUT EXISTING 4" DI SLUDGE FEED LINE AND CONNECT VIA 4" FLANGE COUPLING ADAPTOR.
24. EXISTING FIRST FLOOR POLYMER PUMP SPEED CONTROLS TO BE RELOCATED.
25. 1/2" CPVC POLYMER FEED PUMPS DISCHARGE PIPING
26. 1/2" PVC POLYMER TRANSFER PIPING
27. 2" PVC POLYMER DRAIN PIPING
28. PROPOSED POLYMER CONTAINMENT FLOOR DRAIN
29. 1/2" CPVC POLYMER FEED PUMPS SUCTION PIPING (SEE PLUMBING SHEETS FOR SOLENOID VALVES & PIPING)
30. EXISTING 8" DI BELT FILTER PRESS FILTRATE DRAIN PIPING
31. CONTRACTOR TO CUT IN 8"x8"x4" DI REDUCING TEE ON EXISTING 8" DI PRESS FILTRATE DRAIN PIPING
32. 4" DI POLYMER CONTAINMENT DRAIN PIPING
33. CONCRETE EQUIPMENT PAD

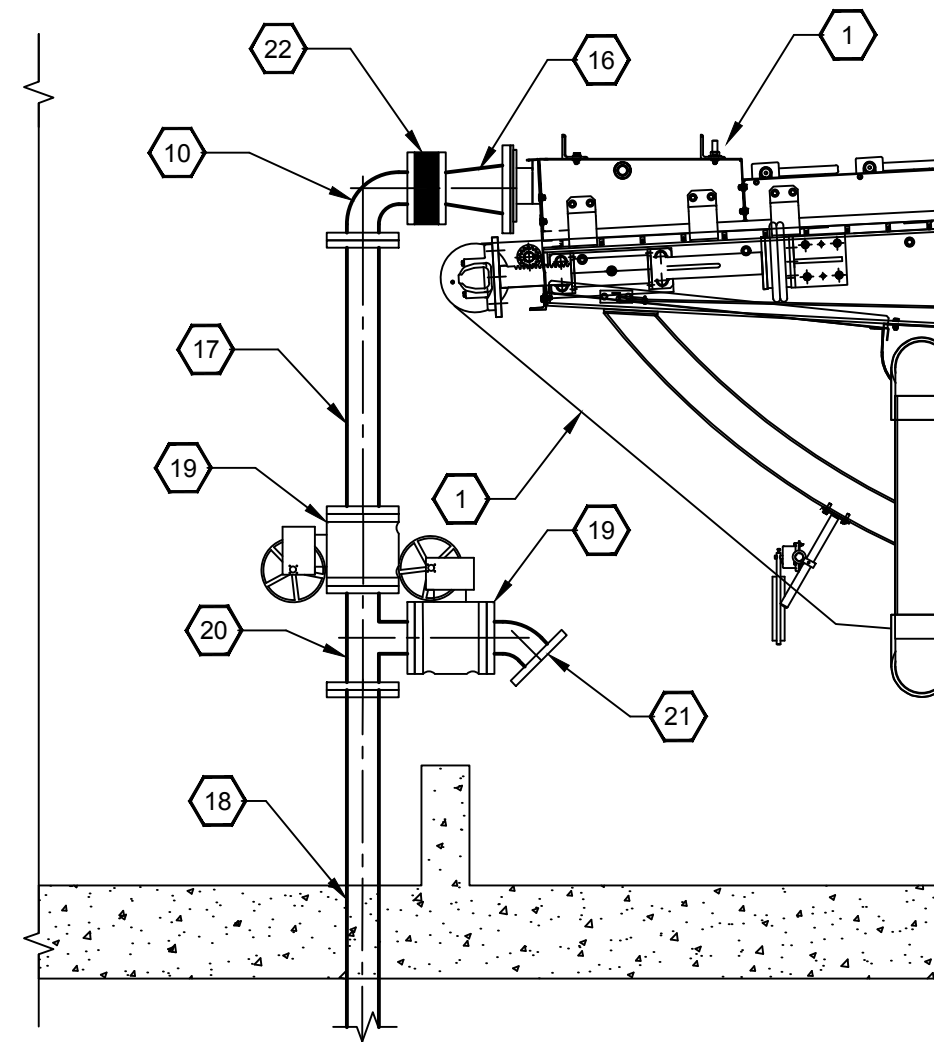

**DETAIL A
SHEET C-102**

SCALE: 1/2"=1'-0"

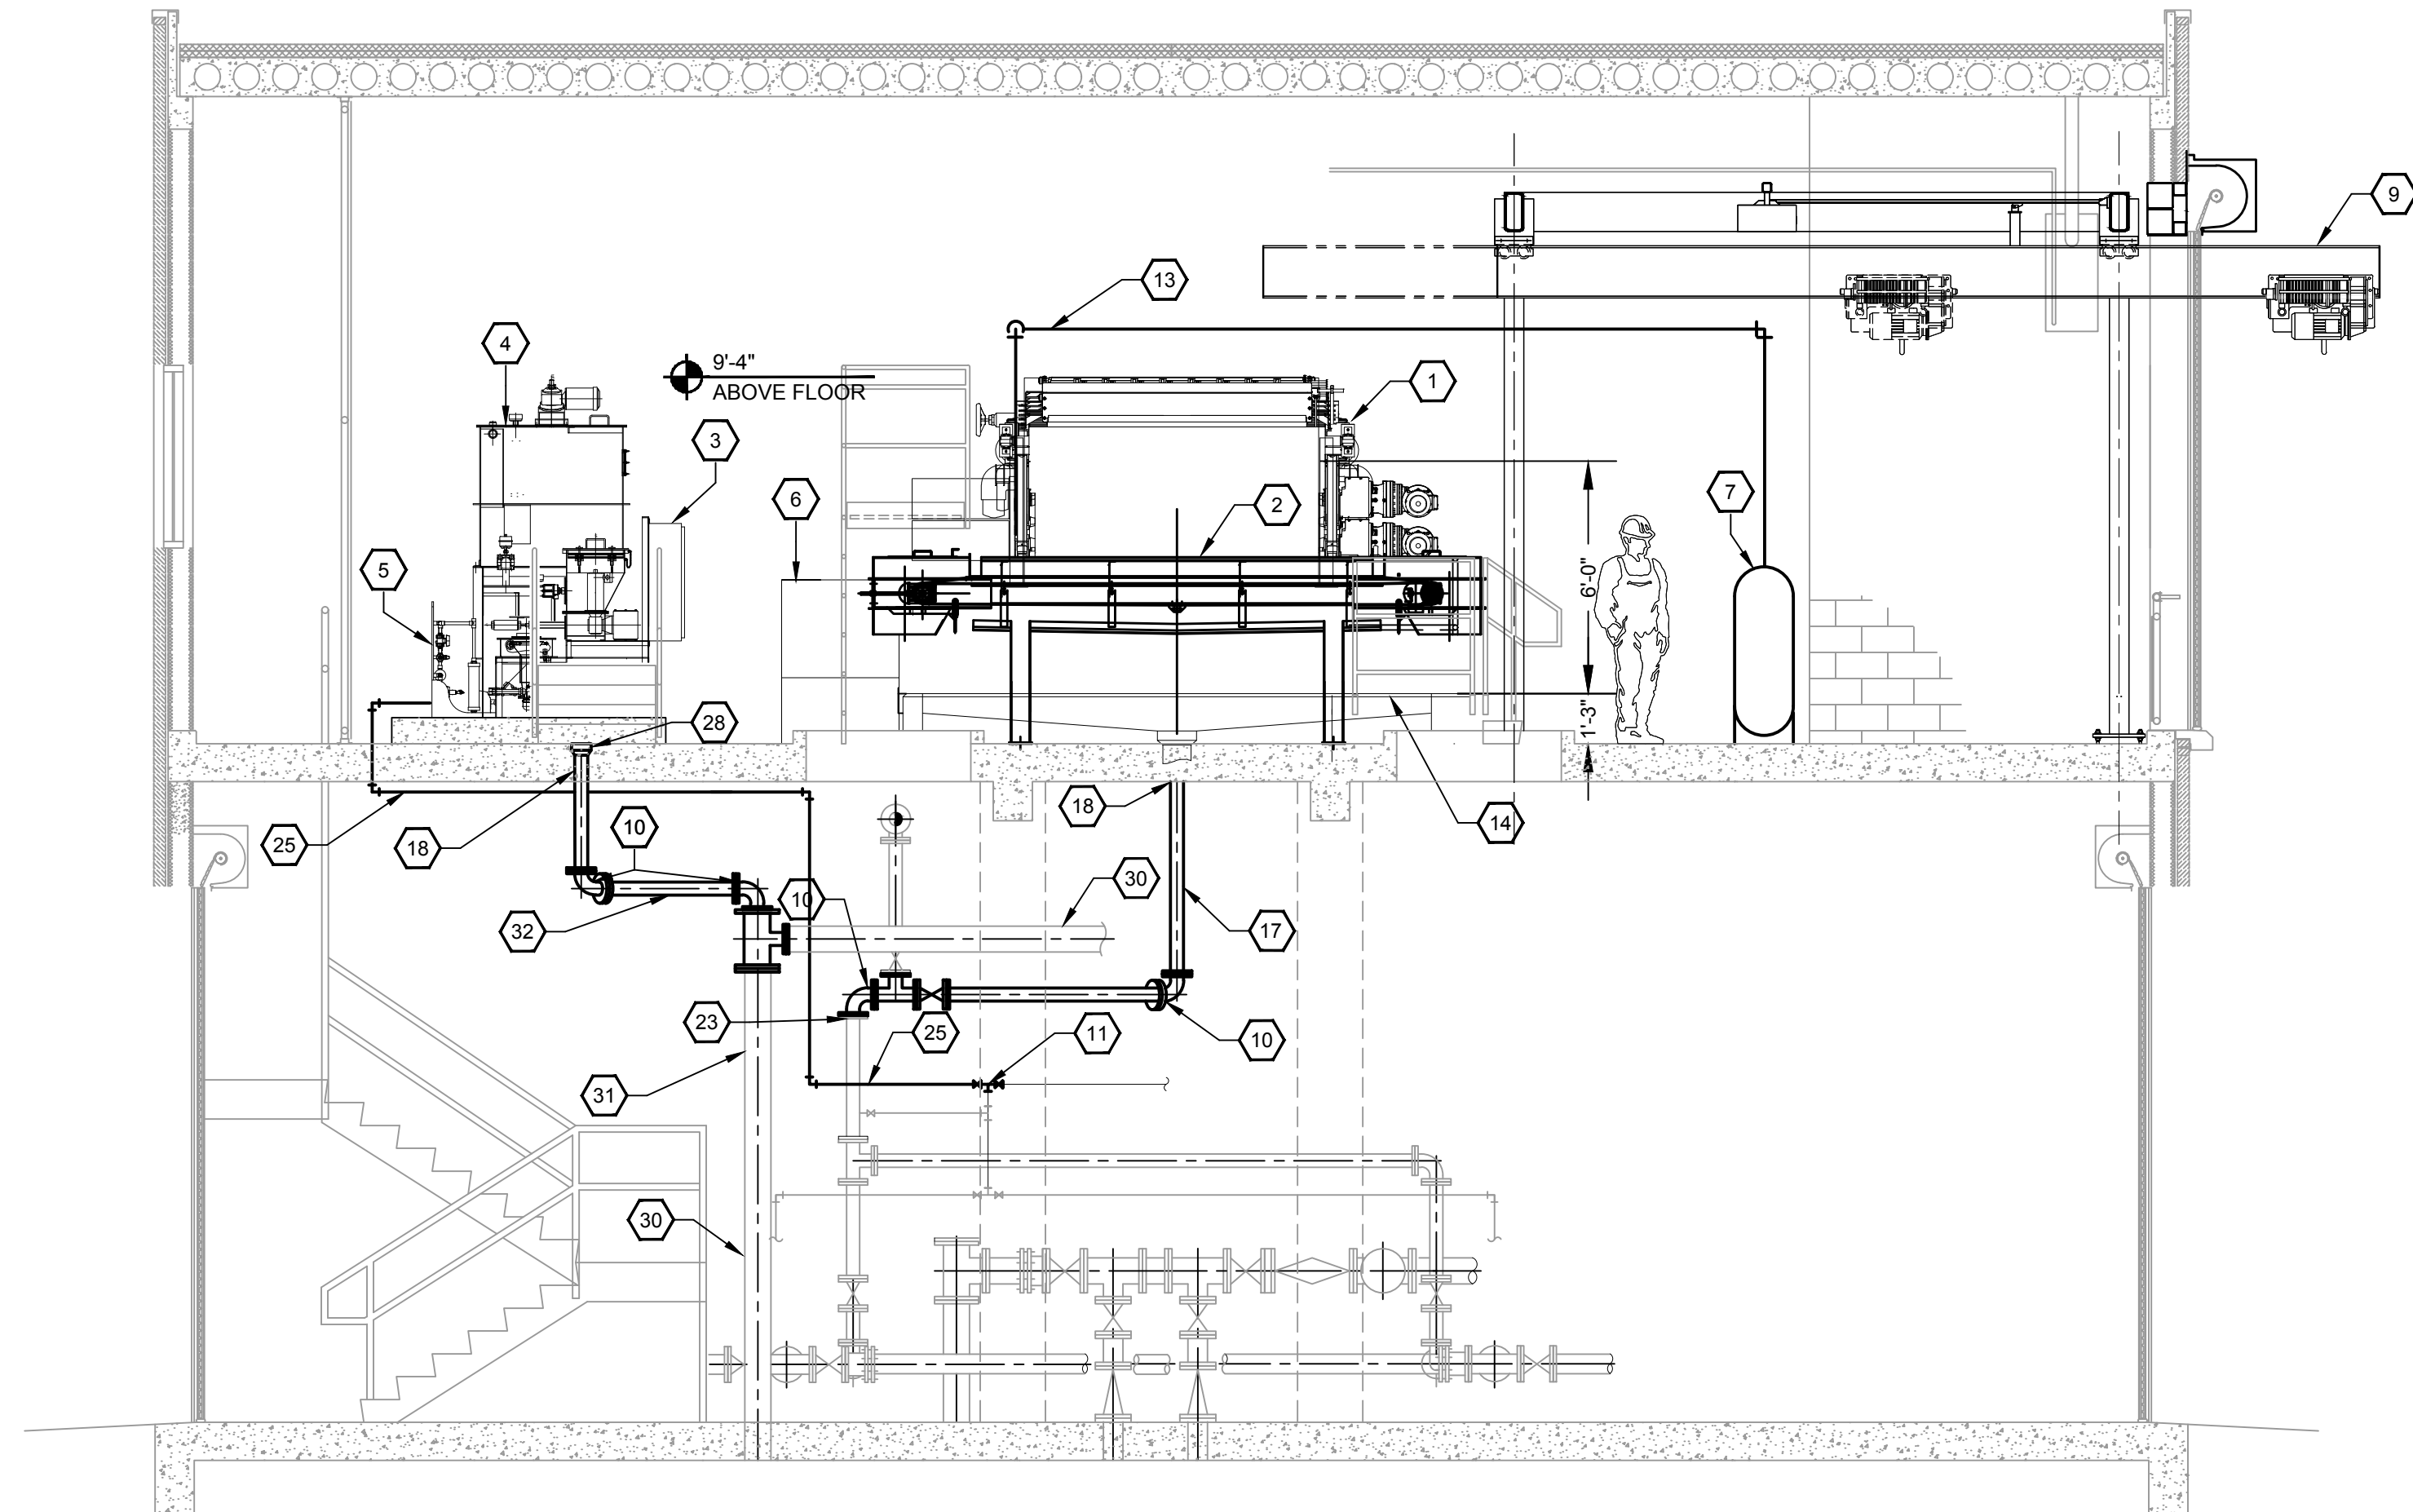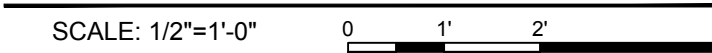

1 SECTION

SCALE: 1/4"=1'-0"



GENERAL NOTES:

1. CONTRACTOR SHALL PROVIDE PIPE SUPPORTS AND HANGERS AS REQUIRED.
2. NOTES, DIMENSIONS, ETC. TAKEN FROM EXISTING AS-BUILT PLANS. CONTRACTOR SHALL FIELD VERIFY.

THIS RECORD DOCUMENT HAS BEEN PREPARED BASED ON INFORMATION PROVIDED BY THE CONSTRUCTION CONTRACTOR, GRW ENGINEERS, INC. HAS ATTEMPTED TO VERIFY THE ACCURACY AND/OR COMPLETENESS OF THIS INFORMATION BUT SHALL NOT BE RESPONSIBLE FOR ANY ERRORS OR OMISSIONS WHICH MAY BE INCORPORATED HEREIN AS A RESULT.

engineering | architecture | geospatial
www.grwinc.com

ENGINEER/ARCHITECT: David C. Osborne
CONSTRUCTION COMPANY: Dugan & Meyers
DATE: 4/23/19

NO.	DATE	DESCRIPTION	DESIGNED	DCO	DRAWN	DCO	REVIEWED	AAB	APPROVED	AAB

DATE: APRIL, 2019
SCALE: 1/4" = 1'-0"
SHEET NO. C-102

engineering | architecture | geospatial
www.grwinc.com

**BELT FILTER PRESS REPLACEMENT
PLAN AND SECTION**
TAYLOR MILL TREATMENT PLANT
NORTHERN KENTUCKY WATER DISTRICT

GRW PROJECT NO. 4384
CLIENT PROJECT NO.
ALL RIGHTS RESERVED. NO PART OF THIS DOCUMENT SHALL BE REPRODUCED IN WHOLE OR IN PART WITHOUT THE WRITTEN PERMISSION OF GRW ENGINEERS, INC. AND SHALL NOT BE USED FOR ANY OTHER PROJECT OTHER THAN THIS SPECIFIC PROJECT WITHOUT WRITTEN PERMISSION.

SPECIAL INSPECTION

1. SPECIAL INSPECTION IS REQUIRED ACCORDING TO SECTION 1704 OF THE KENTUCKY BUILDING CODE.
2. SPECIAL INSPECTIONS SHALL BE PERFORMED FOR THE FOLLOWING WORK AS REQUIRED IN THE KENTUCKY BUILDING CODE:
 - 2.1. CONTRACTOR'S STATEMENT OF RESPONSIBILITY IN ACCORDANCE WITH SECTION 1704.4
 - 2.1.1. CONTRACTOR SHALL SUBMIT A STATEMENT THAT:
 - 2.1.1.1. ACKNOWLEDGES THE REQUIREMENTS STATED IN THIS STATEMENT OF SPECIAL INSPECTIONS.
 - 2.1.1.2. ACKNOWLEDGES THAT CONTROL WILL BE EXERCISED OVER THE QUALITY OF CONSTRUCTION TO CONFORM TO THE APPROVED CONSTRUCTION DOCUMENTS.
 - 2.1.1.3. ACKNOWLEDGES THAT THERE ARE ORGANIZATIONAL PROCEDURES IN PLACE FOR EXERCISING CONTROL OF QUALITY OF THE CONSTRUCTION INCLUDING:
 - 2.1.1.3.1. APPOINTMENT OF A PERSON WITHIN THE CONTRACTOR'S ORGANIZATION TO EXERCISE CONTROL QUALITY OF CONSTRUCTION
 - 2.1.1.3.2. THE PERSONS WITHIN THE CONTRACTOR'S ORGANIZATION TO WHOM THE QUALITY CONTROL REPORTS ARE DISTRIBUTED
 - 2.1.1.3.3. THE METHOD AND FREQUENCY OF REPORTING THE QUALITY CONTROL RESULTS WITHIN THE CONTRACTOR'S ORGANIZATION
 - 2.2. FABRICATORS IN ACCORDANCE WITH SECTION 1704.2
 - 2.2.1. SUBMIT REPORT OF INSPECTOR'S APPROVAL OF FABRICATOR'S QC PLAN OR FABRICATOR'S NATIONALLY RECOGNIZED QC CERTIFICATION.
 - 2.2.2. SUBMIT FABRICATOR'S CERTIFICATE OF COMPLIANCE STATING THAT THE WORK WAS PERFORMED IN ACCORDANCE WITH THE APPROVED CONSTRUCTION DOCUMENTS. SUBMITTED AT THE COMPLETION OF SUCH WORK.
 - 2.3. STEEL CONSTRUCTION IN ACCORDANCE WITH SECTION 1704.3
 - 2.3.1. SUBMIT MILL TEST REPORTS AND MATERIAL CERTIFICATIONS FOR ALL STEEL MEMBERS, FASTENERS, BOLTS, NUTS, WASHERS AND REINFORCEMENT STEEL FOR CONCRETE AND MASONRY.
 - 2.3.2. SUBMIT REPORT OF INSPECTION OF MARKING AND CONNECTION DETAILS FOR ALL MEMBERS AND CONNECTIONS. VERIFY ALL STEEL MEMBERS ARE INSTALLED IN THE CORRECT LOCATIONS AND ARE CONNECTED IN ACCORDANCE WITH THE CONSTRUCTION DOCUMENTS AND APPROVED ERECTION DRAWINGS.
 - 2.3.3. SUBMIT REPORT OF INSPECTION OF BOLT TENSIONING FOR EACH APPLICABLE CONNECTION
 - 2.3.4. SUBMIT REPORT OF VISUAL INSPECTION OF ALL FIELD WELDS.
 - 2.4. CONCRETE CONSTRUCTION IN ACCORDANCE WITH SECTION 1704.4
 - 2.4.1. SUBMIT REPORT OF COMPRESSIVE STRENGTH, SLUMP AND AIR CONTENT TEST RESULTS. SAMPLE AND TEST CONCRETE AT LEAST ONCE PER DAY AND ONCE FOR EVERY ADDITIONAL 50 CUBIC YARDS OF CONCRETE PER DAY THEREAFTER.
 - 2.4.2. SUBMIT REPORT OF INSPECTION OF FORMS, REINFORCEMENT, AND CONCRETE DELIVERY TICKETS PRIOR TO EACH PLACEMENT OF CONCRETE.
 - 2.4.3. SUBMIT MATERIAL CERTIFICATIONS OF CEMENT, AGGREGATE, ADMIXTURES AND REINFORCEMENT.
 - 2.5. MASONRY CONSTRUCTION IN ACCORDANCE WITH SECTION 1704.5
 - 2.5.1. SUBMIT MATERIAL CERTIFICATIONS OF MASONRY UNITS, CEMENT FOR MORTAR, SAND FOR MORTAR, GROUT, AND REINFORCEMENT
 - 2.5.2. SUBMIT REPORT OF TEST OF MORTAR AGGREGATE RATIO AND AIR CONTENT AND OBSERVATION OF MORTAR PROPORTIONING. TEST ONCE AT BEGINNING OF PROJECT AND ONCE EVERY 5,000 SF OF WALL THEREAFTER.
 - 2.5.3. SUBMIT REPORT OF PLACEMENT OF MASONRY, REINFORCEMENT AND GROUT PRIOR TO AND DURING EACH PLACEMENT OF GROUT.
 - 2.5.4. SUBMIT REPORT OF INSTALLATION OF CHEMICAL ADHESIVE ANCHORAGE IN CONCRETE AT EDGES OF MASONRY WALLS. INSPECT INSTALLATION OF ALL OF ANCHORAGE INSTALLATIONS.
 3. THE TYPE AND EXTENT OF EACH TEST AND INSPECTION REQUIRED FOR EACH TYPE OF WORK SHALL BE AS INDICATED IN THE SPECIFICATIONS AND/OR THE BUILDING CODE AND THE REFERENCES INCORPORATED THEREIN.
 4. INSPECTION REPORTS SHALL INCLUDE THE FOLLOWING:
 - 4.1. NAME, ADDRESS, AND TELEPHONE NUMBER OF SPECIAL INSPECTOR PERFORMING THE INSPECTION AND MAKING THE REPORT.
 - 4.2. DATES AND LOCATIONS OF SAMPLES AND TESTS OR INSPECTIONS, DATE OF REPORT.
 - 4.3. RECORD OF TEMPERATURE AND WEATHER CONDITIONS AT TIME OF SAMPLE TAKING AND TESTING AND INSPECTING.
 - 4.4. DESCRIPTION OF THE WORK, IDENTIFICATION OF PRODUCTS, SPECIFICATION SECTION, TESTS, AND INSPECTION METHODS.
 - 4.5. PHOTOGRAPHS OF THE WORK INSPECTED FOR THAT REPORT
 - 4.6. COMPLETE TEST OR INSPECTION DATA.
 5. SPECIAL INSPECTION SHALL BE PERFORMED BY A QUALIFIED INSPECTION AND TESTING AGENCY APPROVED BY THE BUILDING OFFICIAL, THE ARCHITECT AND THE STRUCTURAL ENGINEER.
 6. WORK REQUIRING SPECIAL INSPECTION SHALL BE INSPECTED BY THE SPECIAL INSPECTOR FOR CONFORMANCE WITH THE APPROVED DRAWINGS AND SPECIFICATIONS. INSPECTION REPORTS INDICATING THE RESULTS OF SPECIAL INSPECTIONS SHALL BE PROMPTLY SUBMITTED TO THE CONTRACTOR, THE ARCHITECT, THE STRUCTURAL ENGINEER.
 7. THE SPECIAL INSPECTOR MAY USE REVIEWED SHOP DRAWINGS ONLY AS AN AID TO INSPECTION.
 8. THE SPECIAL INSPECTOR SHALL OBSERVE ACTIVITIES, ACTIONS, AND PROCEDURES PERFORMED BEFORE AND DURING EXECUTION OF THE WORK TO GUARD AGAINST DEFECTS AND DEFICIENCIES AND SUBSTANTIATE THAT PROPOSED CONSTRUCTION WILL COMPLY WITH REQUIREMENTS.
 9. ALL SPECIAL INSPECTIONS INDICATING NON-CONFORMING WORK SHALL BE REPORTED IMMEDIATELY TO THE CONTRACTOR, THE ARCHITECT AND THE STRUCTURAL ENGINEER. IMPENDING CONSTRUCTION WORK THAT WOULD IMPEDE ECONOMICAL CORRECTION OF NON-CONFORMING WORK SHALL NOT PROCEED WITHOUT WRITTEN APPROVAL. THE CONTRACTOR SHALL MAINTAIN A DISCREPANCY LOG ON THE SITE. LOG SHALL LIST EACH DISCREPANCY DOCUMENTED BY THE SPECIAL INSPECTOR, STATE THE DATE OF DISCOVERY AND SPECIAL INSPECTOR'S REPORT NUMBER, AND ROOM FOR THE SPECIAL INSPECTOR TO SIGN AND DATE WHEN SAID DISCREPANCY IS CORRECTED. COST OF ADDITIONAL RETESTING THAT ARE REQUIRED DUE TO NON-CONFORMING WORK MAY BE CHARGED TO THE CONTRACTOR.
 10. A FINAL REPORT CERTIFYING COMPLETION OF ALL REQUIRED SPECIAL INSPECTIONS AND CORRECTION OF ANY NON-CONFORMING WORK NOTED IN THE INSPECTIONS SHALL BE SUBMITTED BY THE SPECIAL INSPECTOR AT THE COMPLETION OF THE PROJECT, OR IF NOT, DETAILING NON-INSPECTED AND/OR UNRESOLVED NON-CONFORMANCES.
 11. THE CONTRACTOR SHALL INCLUDE A CASH ALLOWANCE IN THEIR BASE BID CONTRACT PRICE TO COVER THE COSTS OF SPECIAL INSPECTION, SUCH INSPECTION BEING DIRECTED BY THE OWNER. THE AMOUNT OF THIS ALLOWANCE IS INDICATED IN DIVISION 01 SECTION "ALLOWANCES" OF THE SPECIFICATIONS.
 12. THE CONTRACTOR SHALL NOTIFY THE INSPECTOR WHEN CONSTRUCTION IS READY TO BE INSPECTED. CONTRACTOR SHALL GIVE TIMELY AND ADEQUATE NOTICE TO THE SPECIAL INSPECTOR.
 13. THE CONTRACTOR SHALL PROVIDE THE SPECIAL INSPECTOR ACCESS TO PLANS, SHOP DRAWINGS, AND CHANGE ORDERS AT THE JOBSITE.
 14. THE CONTRACTOR SHALL PROVIDE STORAGE SPACE FOR STRUCTURAL TESTING/INSPECTION AGENCY'S EXCLUSIVE USE, SUCH AS FOR STORING AND CURING CONCRETE TEST SAMPLES.
 15. THE CONTRACTOR SHALL RETAIN AT THE JOBSITE ALL SPECIAL INSPECTION RECORDS SUBMITTED BY THE SPECIAL INSPECTOR AND PROVIDE THESE RECORDS FOR REVIEW BY THE ENGINEER/ARCHITECT AND BUILDING INSPECTOR UPON REQUEST.

GRW PROJECT NO. 4384

CLIENT PROJECT NO.

ALL RIGHTS RESERVED. NO PART OF THIS DOCUMENT IS TO BE REPRODUCED IN WHOLE OR IN PART BY ANY MEANS, ELECTRONIC OR MECHANICAL, INCLUDING PHOTOCOPYING, RECORDING, OR BY ANY INFORMATION STORAGE AND RETRIEVAL SYSTEM, WITHOUT WRITTEN PERMISSION.



engineering | architecture | geospatial

www.grwinc.com

BELT FILTER PRESS REPLACEMENT
GENERAL NOTES

TAYLOR MILL TREATMENT PLANT
NORTHERN KENTUCKY WATER DISTRICT

DESIGNED	MWC
DRAWN	MWC
REVIEWED	
APPROVED	

NO.	DESCRIPTION	DATE	BY

SCALE CHECK: _____ THIS MARK SHOULD MEASURE EXACTLY 1" WHEN PLOTTED

THIS RECORD DOCUMENT HAS BEEN PREPARED BASED ON INFORMATION PROVIDED BY THE CONSTRUCTION CONTRACTOR GRW ENGINEERS, INC. HAS ATTEMPTED TO VERIFY THE ACCURACY AND/OR COMPLETENESS OF THIS INFORMATION BUT SHALL NOT BE RESPONSIBLE FOR ANY ERRORS OR OMISSIONS, WHICH MAY BE INCORPORATED HEREIN AS A RESULT.

engineering | architecture | geospatial
www.grwinc.com

ENGINEER/ARCHITECT: David C. Osborne


CONSTRUCTION COMPANY: Dugan & Meyers

DATE: 4/23/19

DATE: APRIL, 2019

SCALE: AS NOTED

SHEET NO. S-002

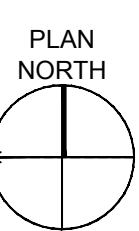


CRANE FRAMING & PRESS FOUNDATION PLAN


SCALE: 1/2"=1'-0"

PLAN NOTES:

1. VERIFY ALL DIMENSIONS OF EXISTING AND ENSURE THAT NEW CONSTRUCTION WILL FIT PRIOR TO PRODUCING SHOP DRAWINGS. NOTIFY ENGINEER IF DISCREPANCIES ARE FOUND.



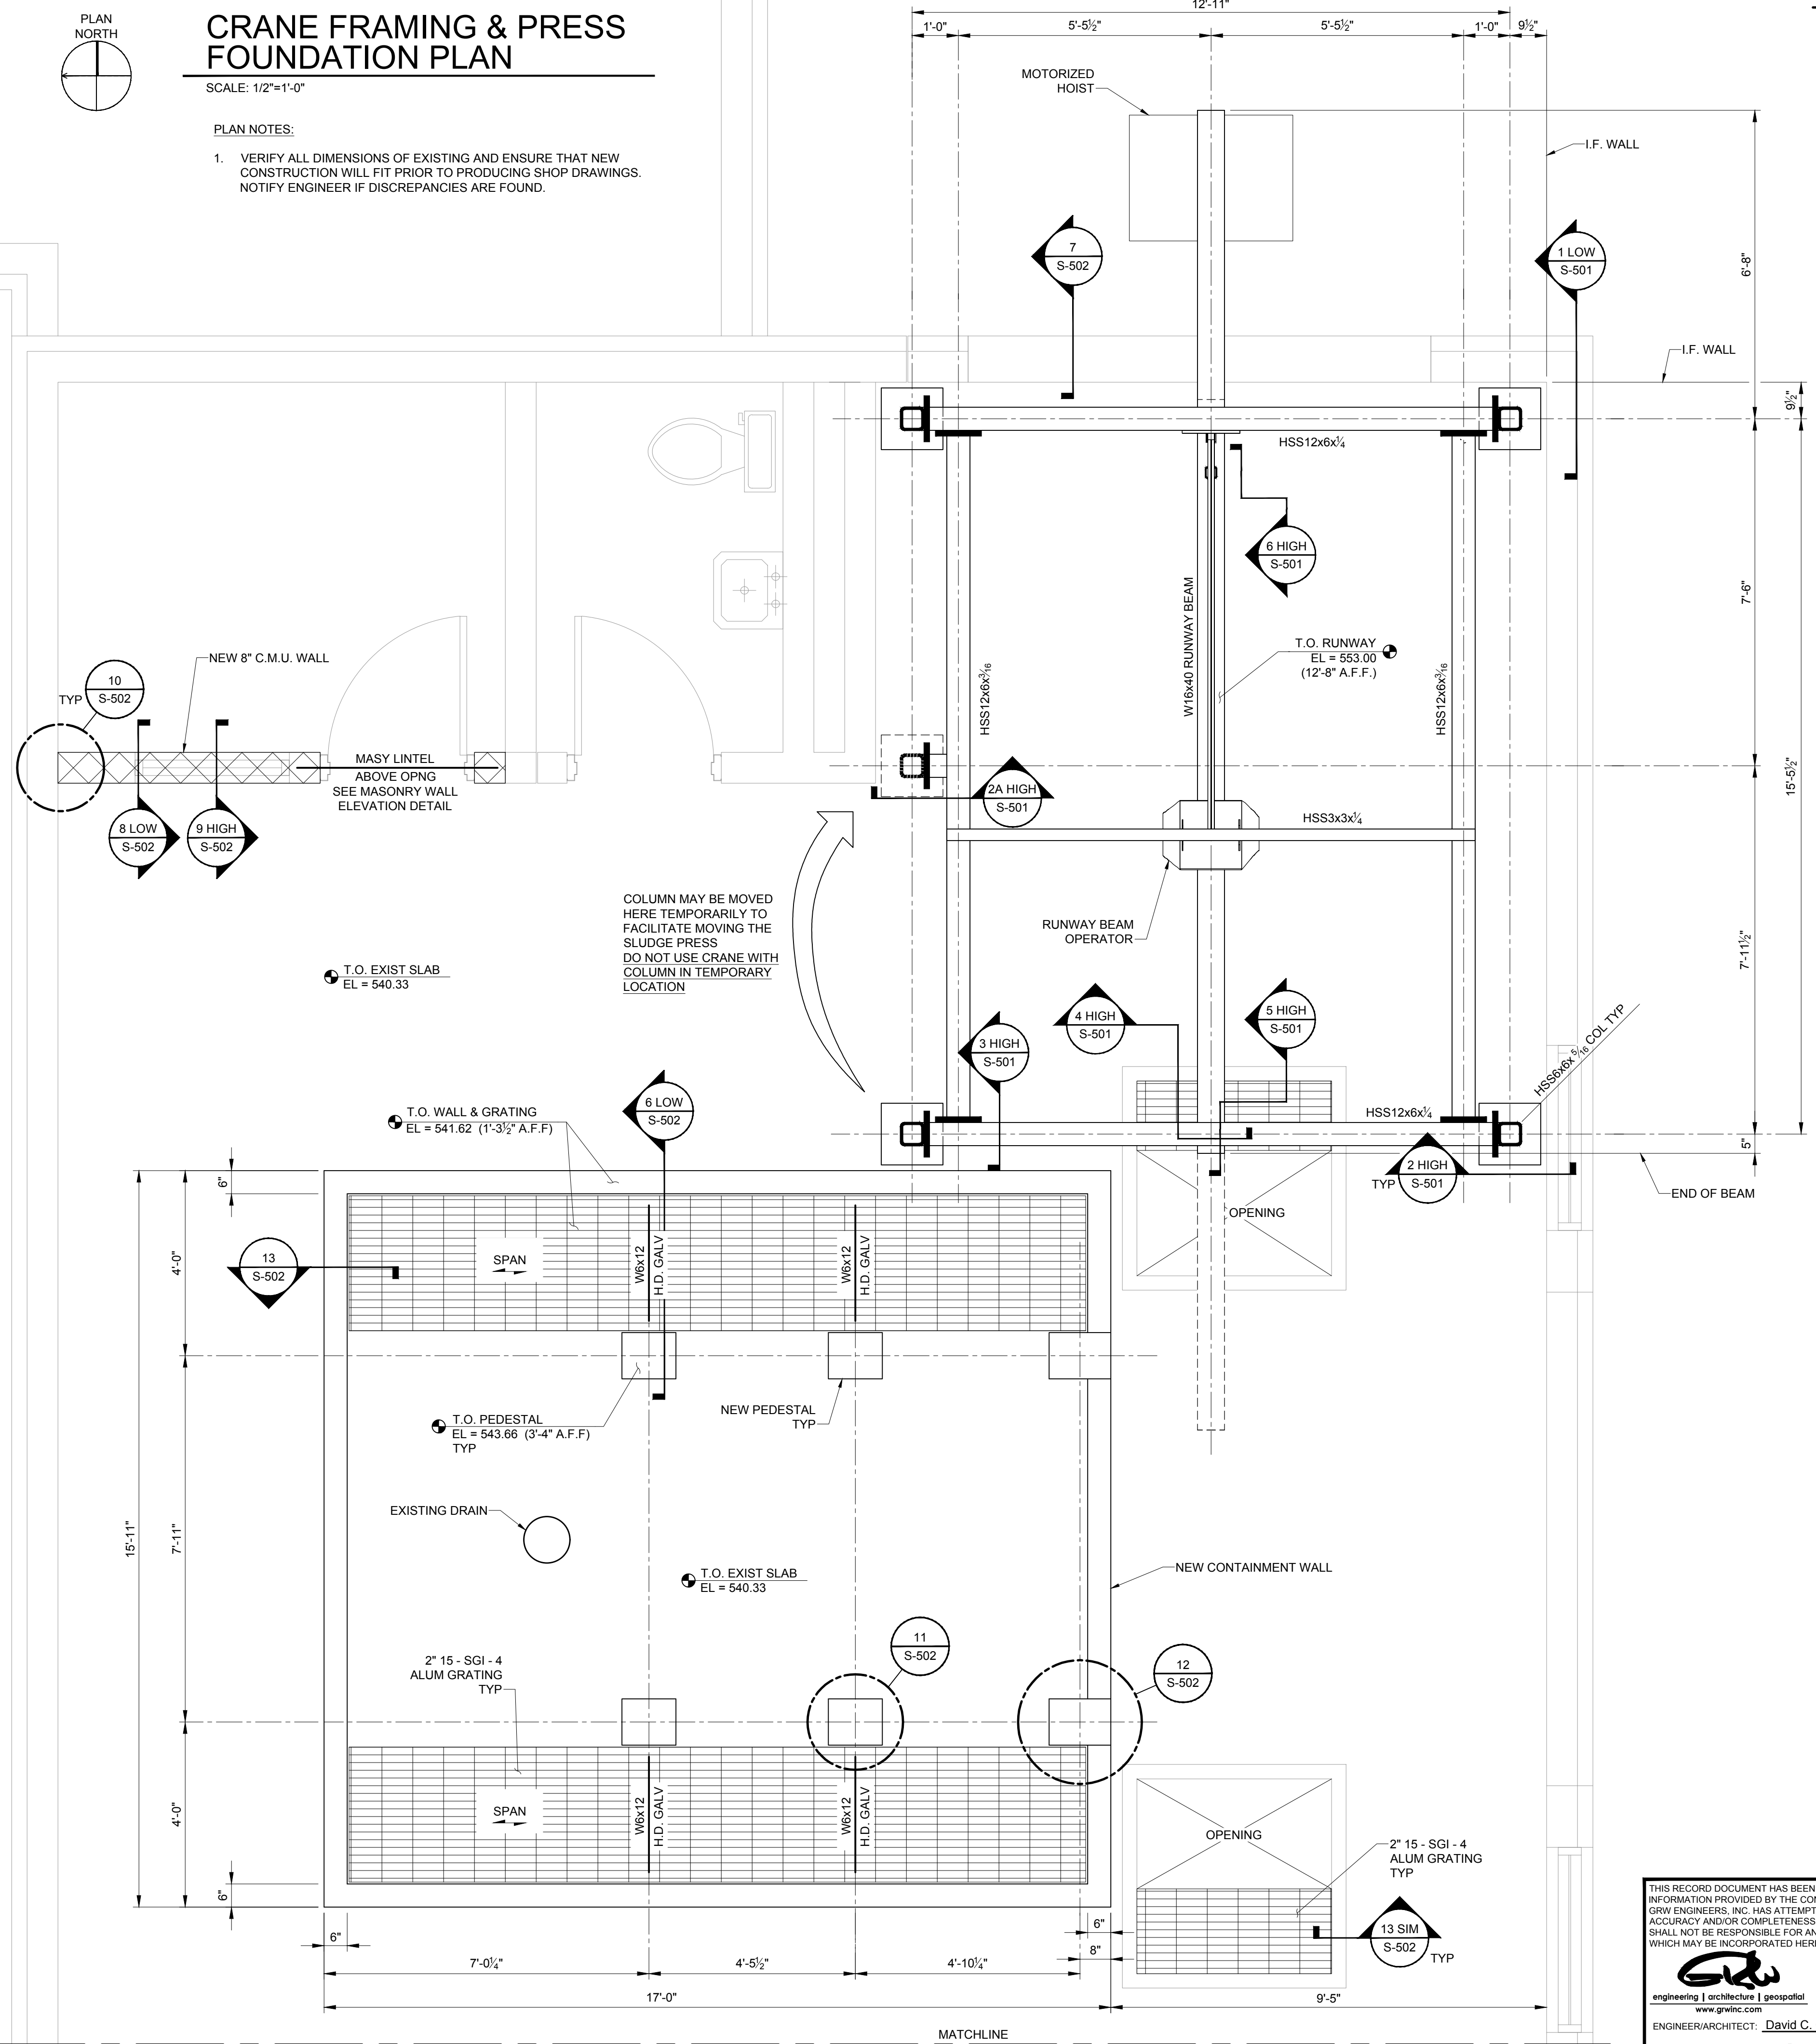


COLUMN MAY BE MOVED HERE TEMPORARILY TO FACILITATE MOVING THE SLUDGE PRESS. DO NOT USE CRANE WITH COLUMN IN TEMPORARY LOCATION.

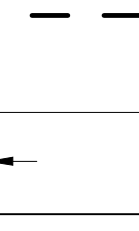

POLYMER MIXING TANK CONTAINMENT FOUNDATION PLAN

SCALE: 1/2"=1'-0"

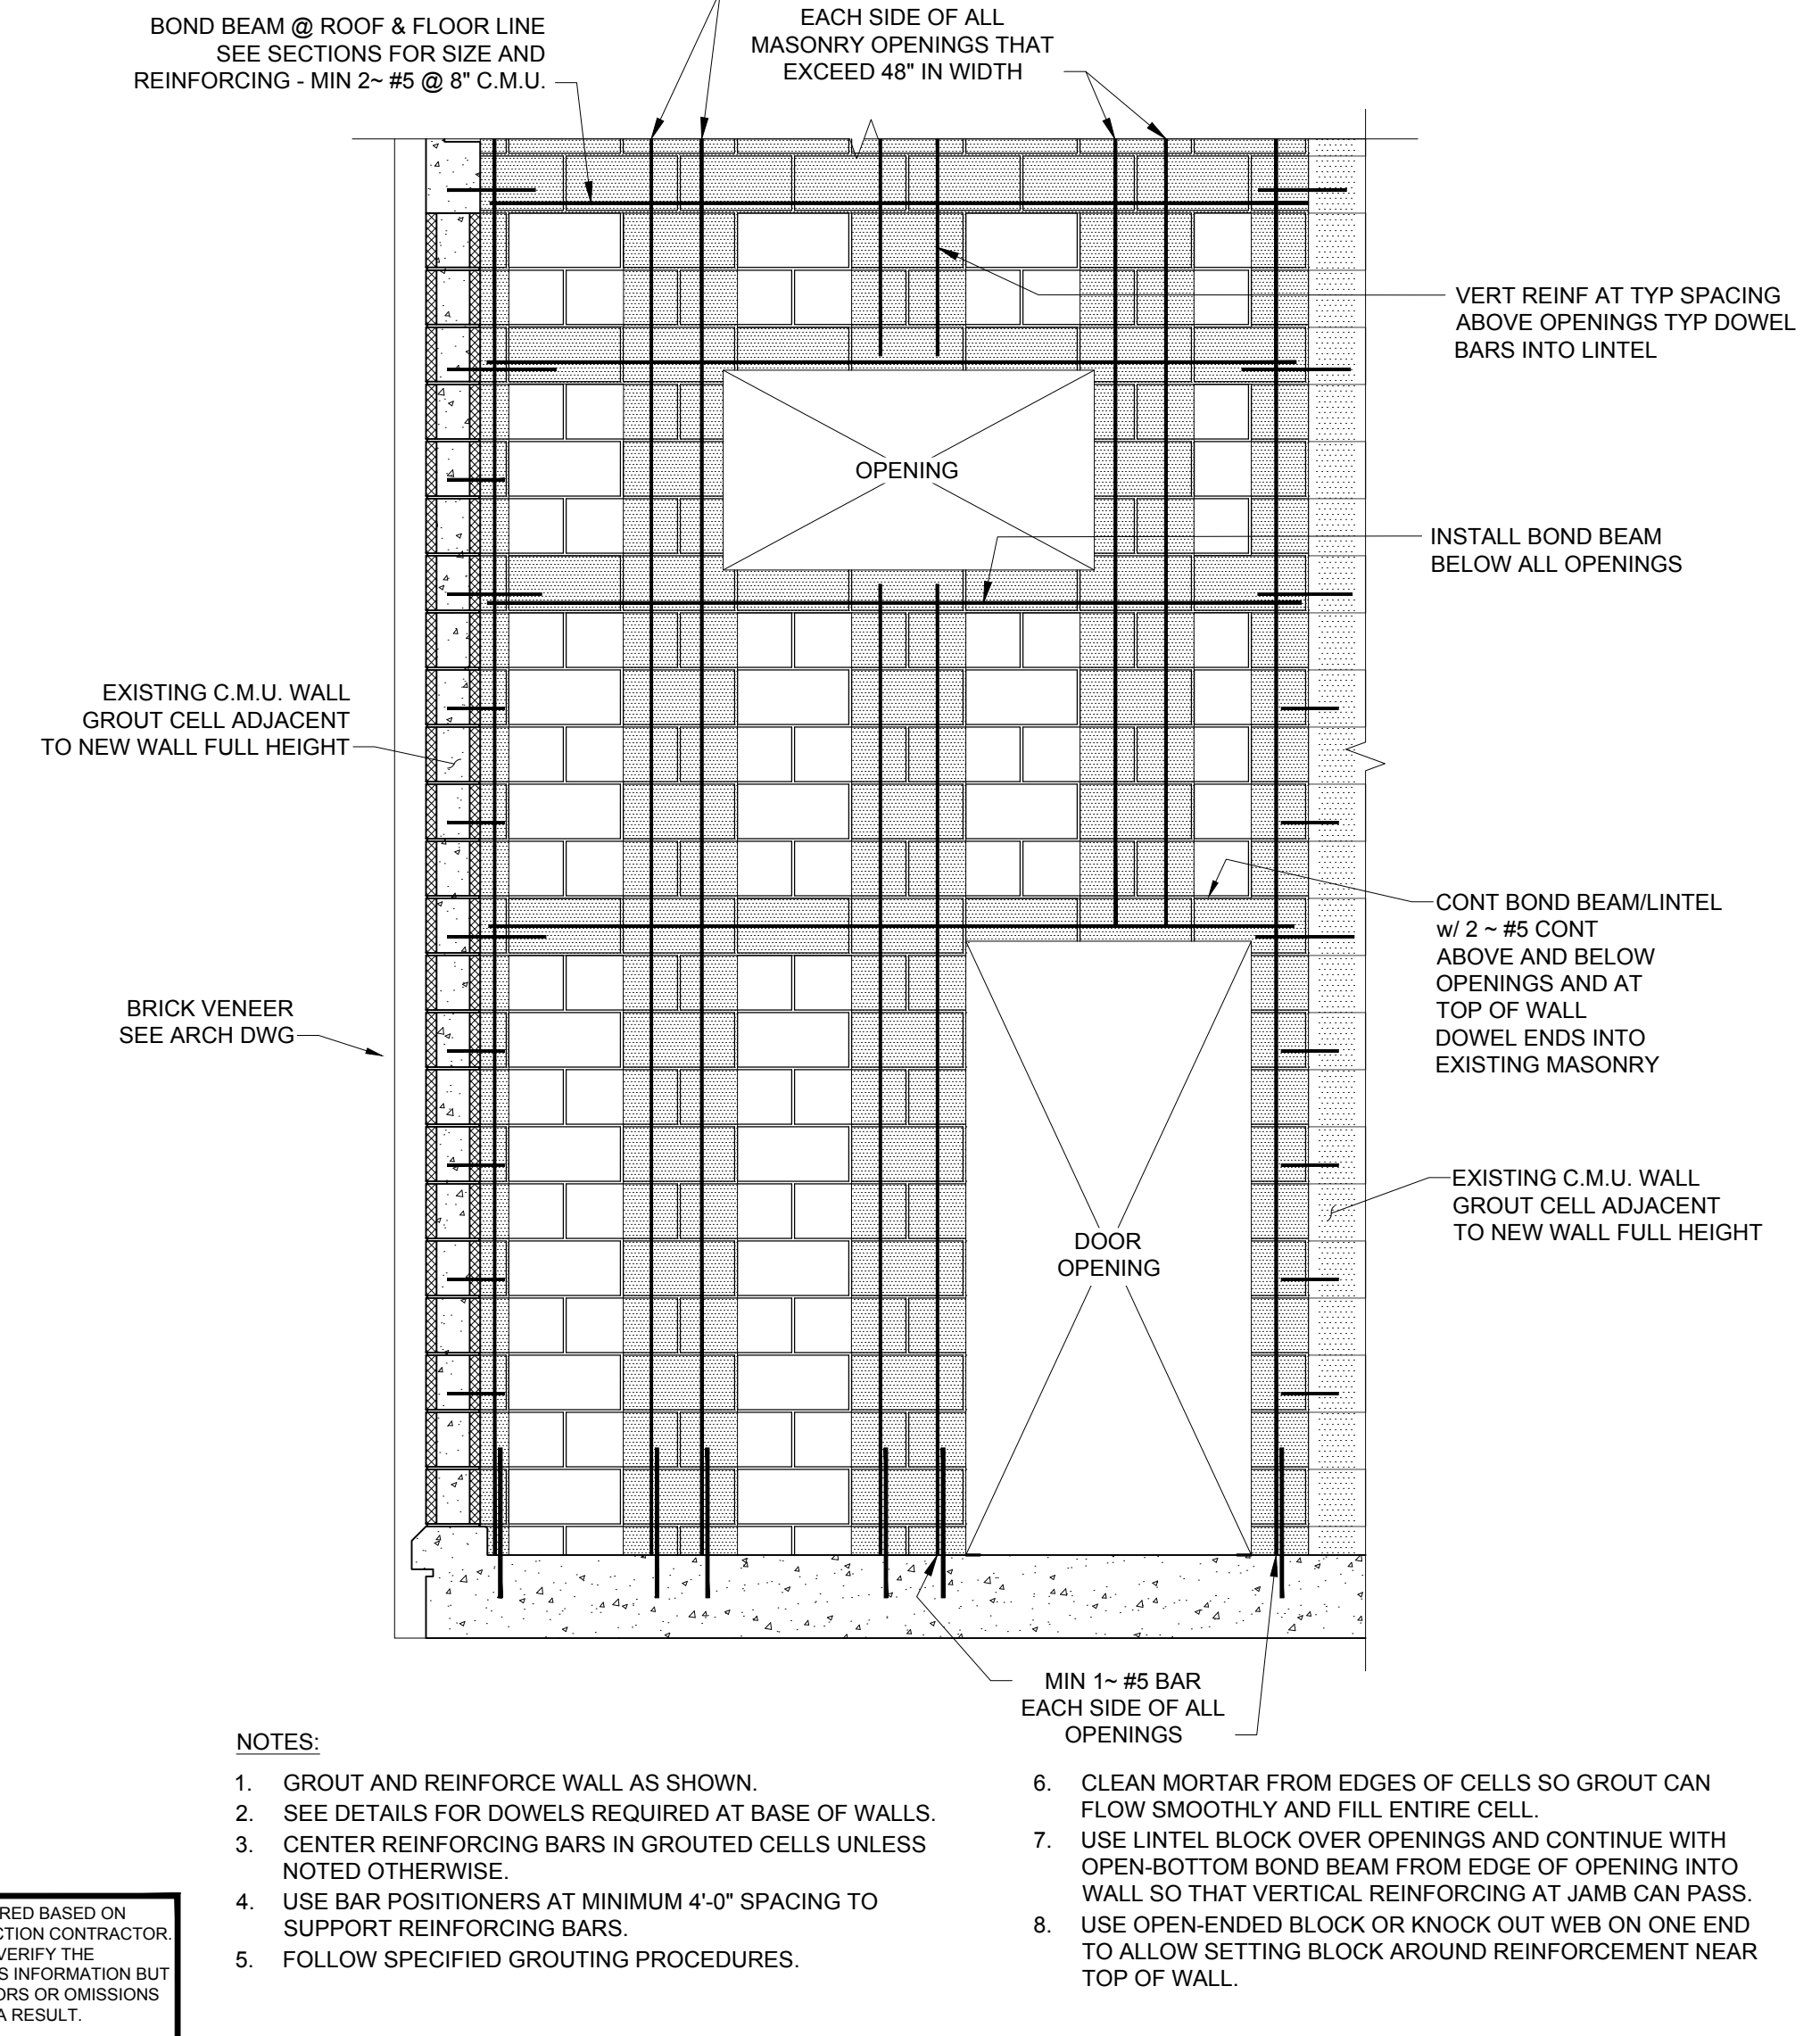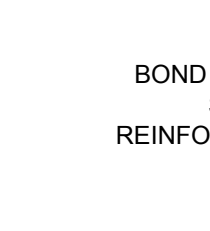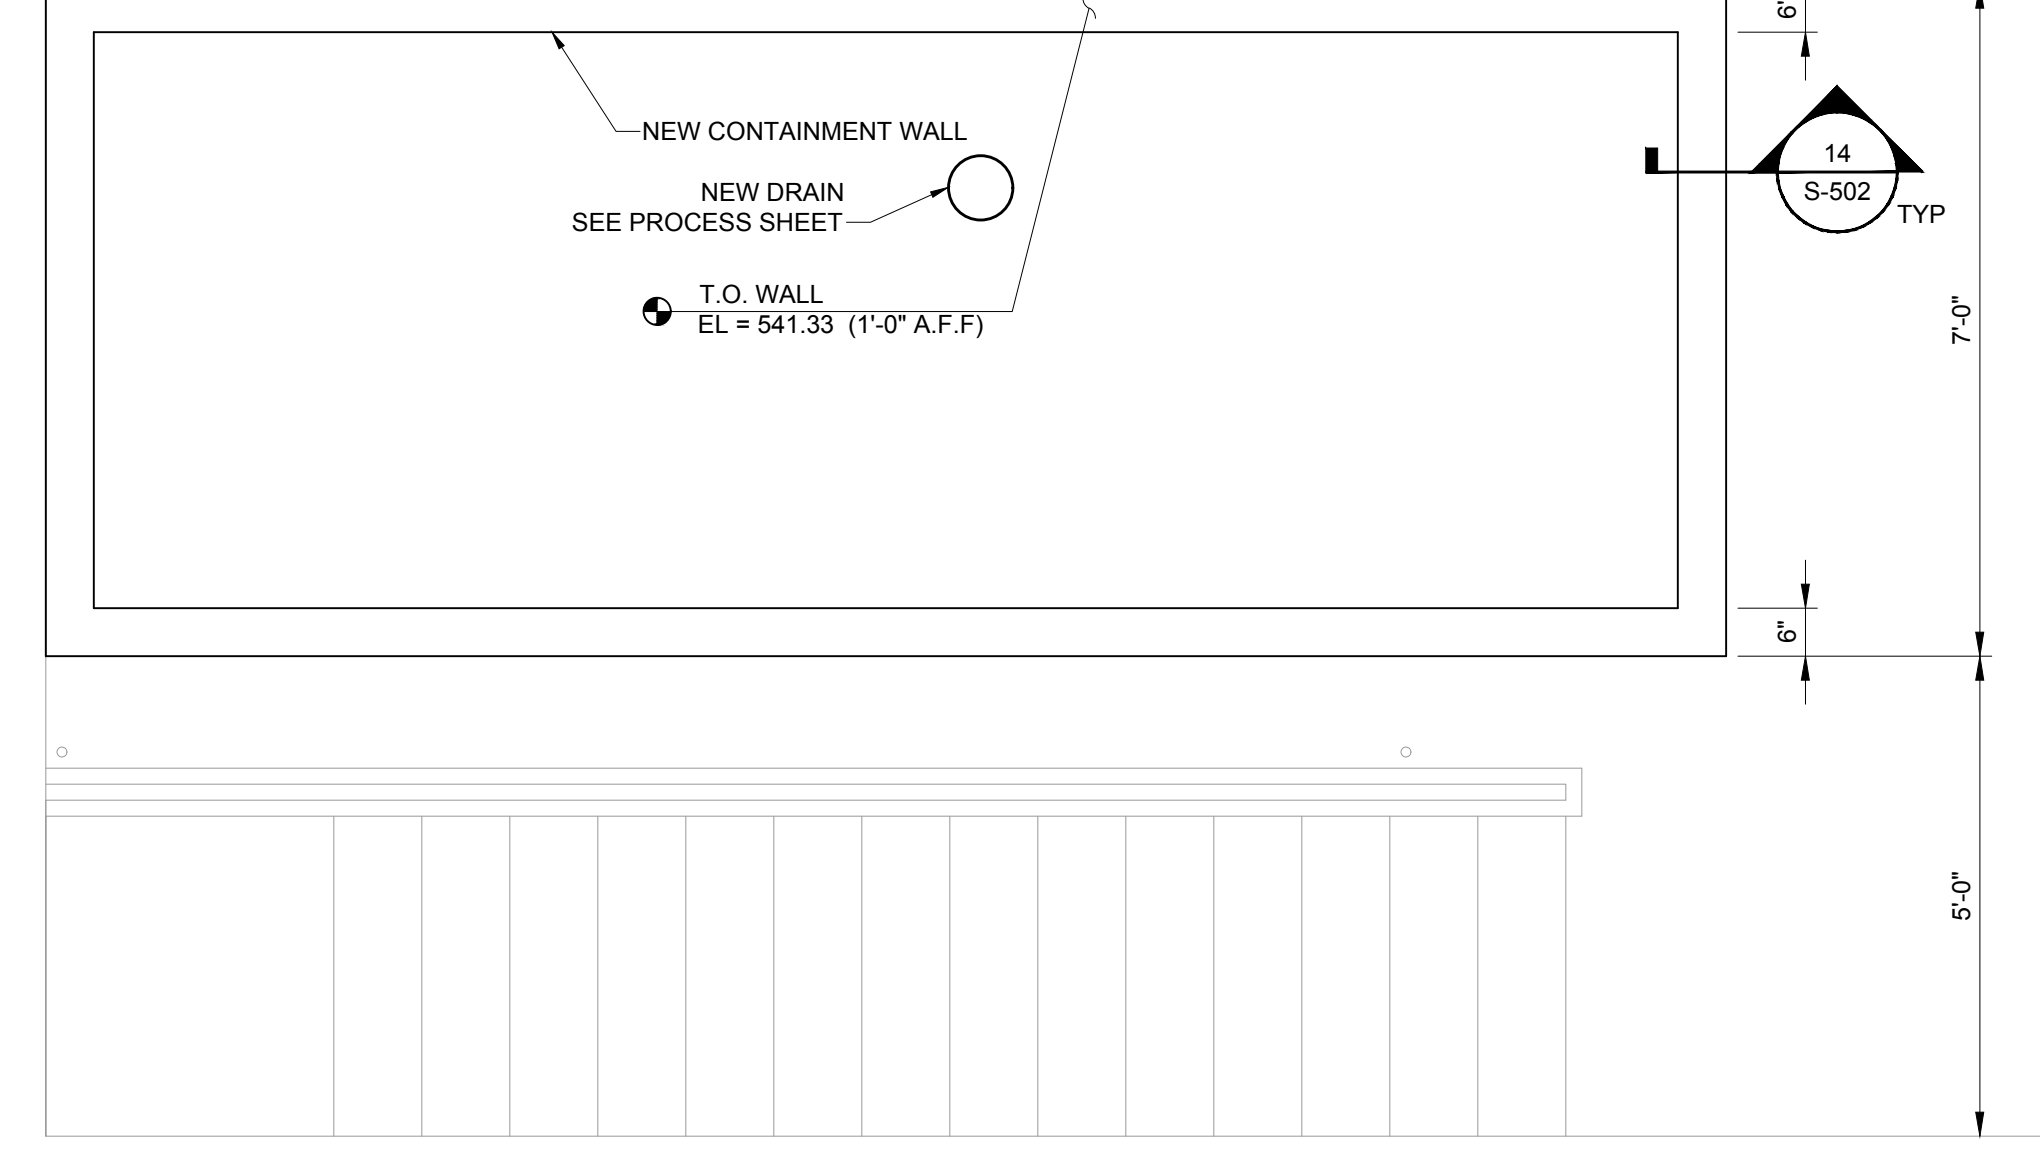

NOTES:

1. GROUT AND REINFORCE WALL AS SHOWN.
2. SEE DETAILS FOR DOWELS REQUIRED AT BASE OF WALLS.
3. CENTER REINFORCING BARS IN GROUDED CELLS UNLESS NOTED OTHERWISE.
4. USE BAR POSITIONERS AT MINIMUM 4'-0" SPACING TO SUPPORT REINFORCING BARS.
5. FOLLOW SPECIFIED GROUTING PROCEDURES.
6. CLEAN MORTAR FROM EDGES OF CELLS SO GROUT CAN FLOW SMOOTHLY AND FILL ENTIRE CELL.
7. USE LINTEL BLOCK OVER OPENINGS AND CONTINUE WITH OPEN-BOTTOM BOND BEAM FROM EDGE OF OPENING INTO WALL SO THAT VERTICAL REINFORCING AT JAMB CAN PASS.
8. USE OPEN-ENDED BLOCK OR KNOCK OUT WEB ON ONE END TO ALLOW SETTING BLOCK AROUND REINFORCEMENT NEAR TOP OF WALL.

THIS RECORD DOCUMENT HAS BEEN PREPARED BASED ON INFORMATION PROVIDED BY THE CONSTRUCTION CONTRACTOR. GRW ENGINEERS, INC. HAS ATTEMPTED TO VERIFY THE ACCURACY AND/OR COMPLETENESS OF THIS INFORMATION BUT SHALL NOT BE RESPONSIBLE FOR ANY ERRORS OR OMISSIONS WHICH MAY BE INCORPORATED HEREIN AS A RESULT.

GRW engineering | architecture | geospatial
www.grwinc.com
ENGINEER/ARCHITECT: David C. Osborne
CONSTRUCTION COMPANY: Dugan & Meyers
DATE: 4/23/19

MASONRY WALL ELEVATION DETAIL

SCALE: 1/2"=1'-0"

FILE NAME: U:\4384-NKVD\TMT\BPTP\Working Drawings\AutoCAD\4384-S-101.dwg
PRINTED: 4/23/2019 @ 2:41 PM
PLOTTED BY: mwilliamson

GRW PROJECT NO. 4384
CLIENT PROJECT NO.
ALL RIGHTS RESERVED. NO PART OF THIS DOCUMENT SHALL BE REPRODUCED OR TRANSMITTED IN ANY FORM OR BY ANY MEANS, ELECTRONIC OR MECHANICAL, WITHOUT THE WRITTEN PERMISSION OF GRW ENGINEERS, INC. AND SHALL NOT BE REPRODUCED IN WHOLE OR IN PART FOR ANY OTHER PROJECT OTHER THAN THIS SPECIFIC PROJECT.

GRW engineering | architecture | geospatial
www.grwinc.com

BELT FILTER PRESS REPLACEMENT FRAMING PLAN

TAYLOR MILL TREATMENT PLANT NORTHERN KENTUCKY WATER DISTRICT

REVISIONS	DATE	BY	DESCRIPTION	DESIGNED	MWC	DRAWN	MWC	REVIEWED	APPROVED

DATE: APRIL, 2019
SCALE: AS NOTED
SHEET NO.









S-101

RECORD DOCUMENTS

FILE NAME: U:\4384-NKVD\TMT\BFP\Working Drawings\AutoCAD\4384-S-501.dwg

PRINTED: 4/23/2019 @ 2:41PM

PLOTTED BY: mwilliamson

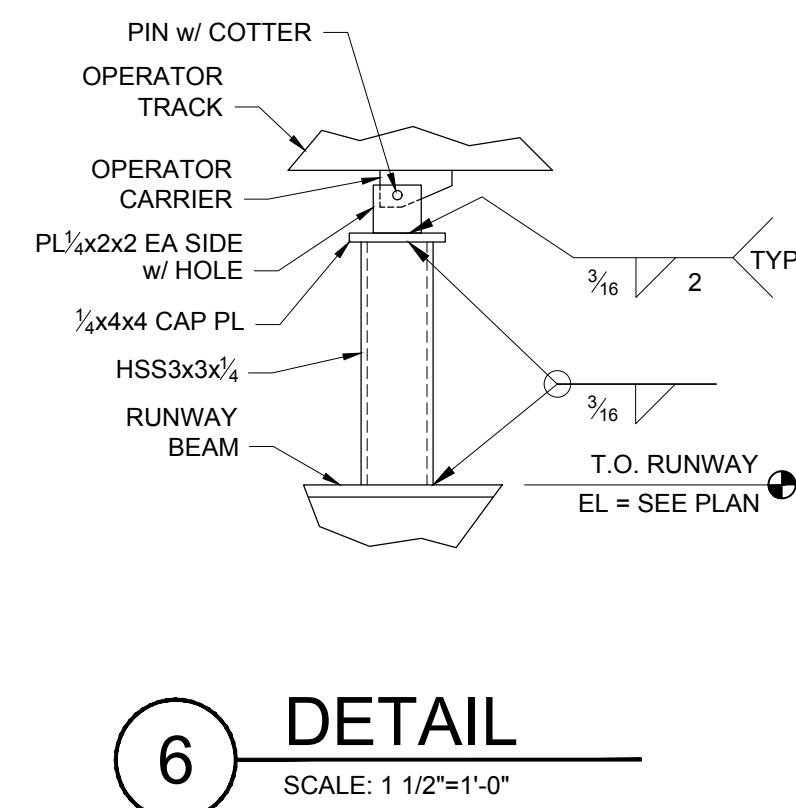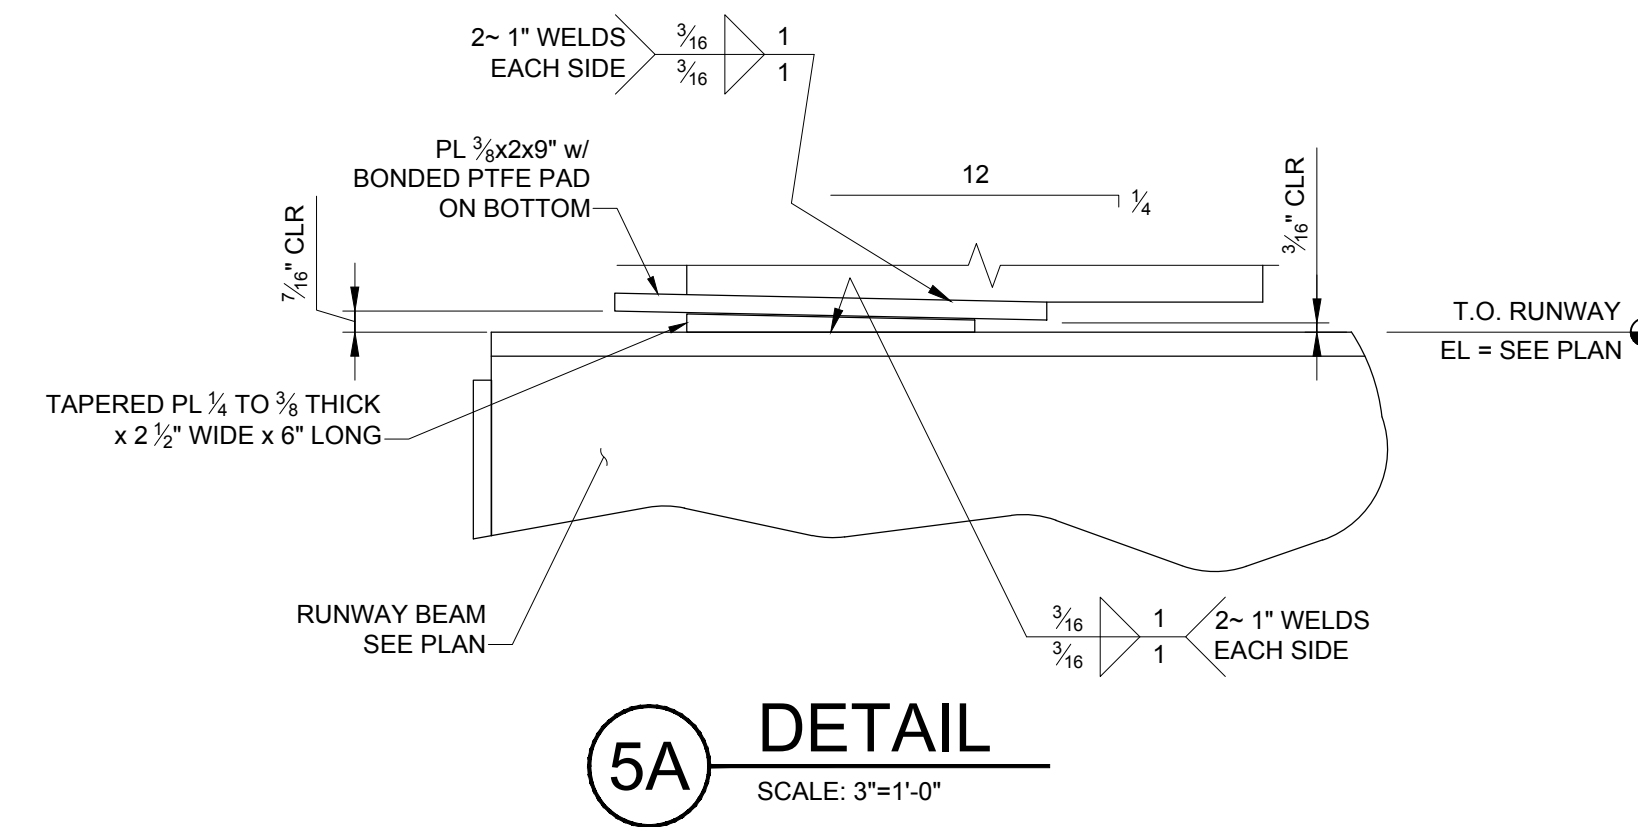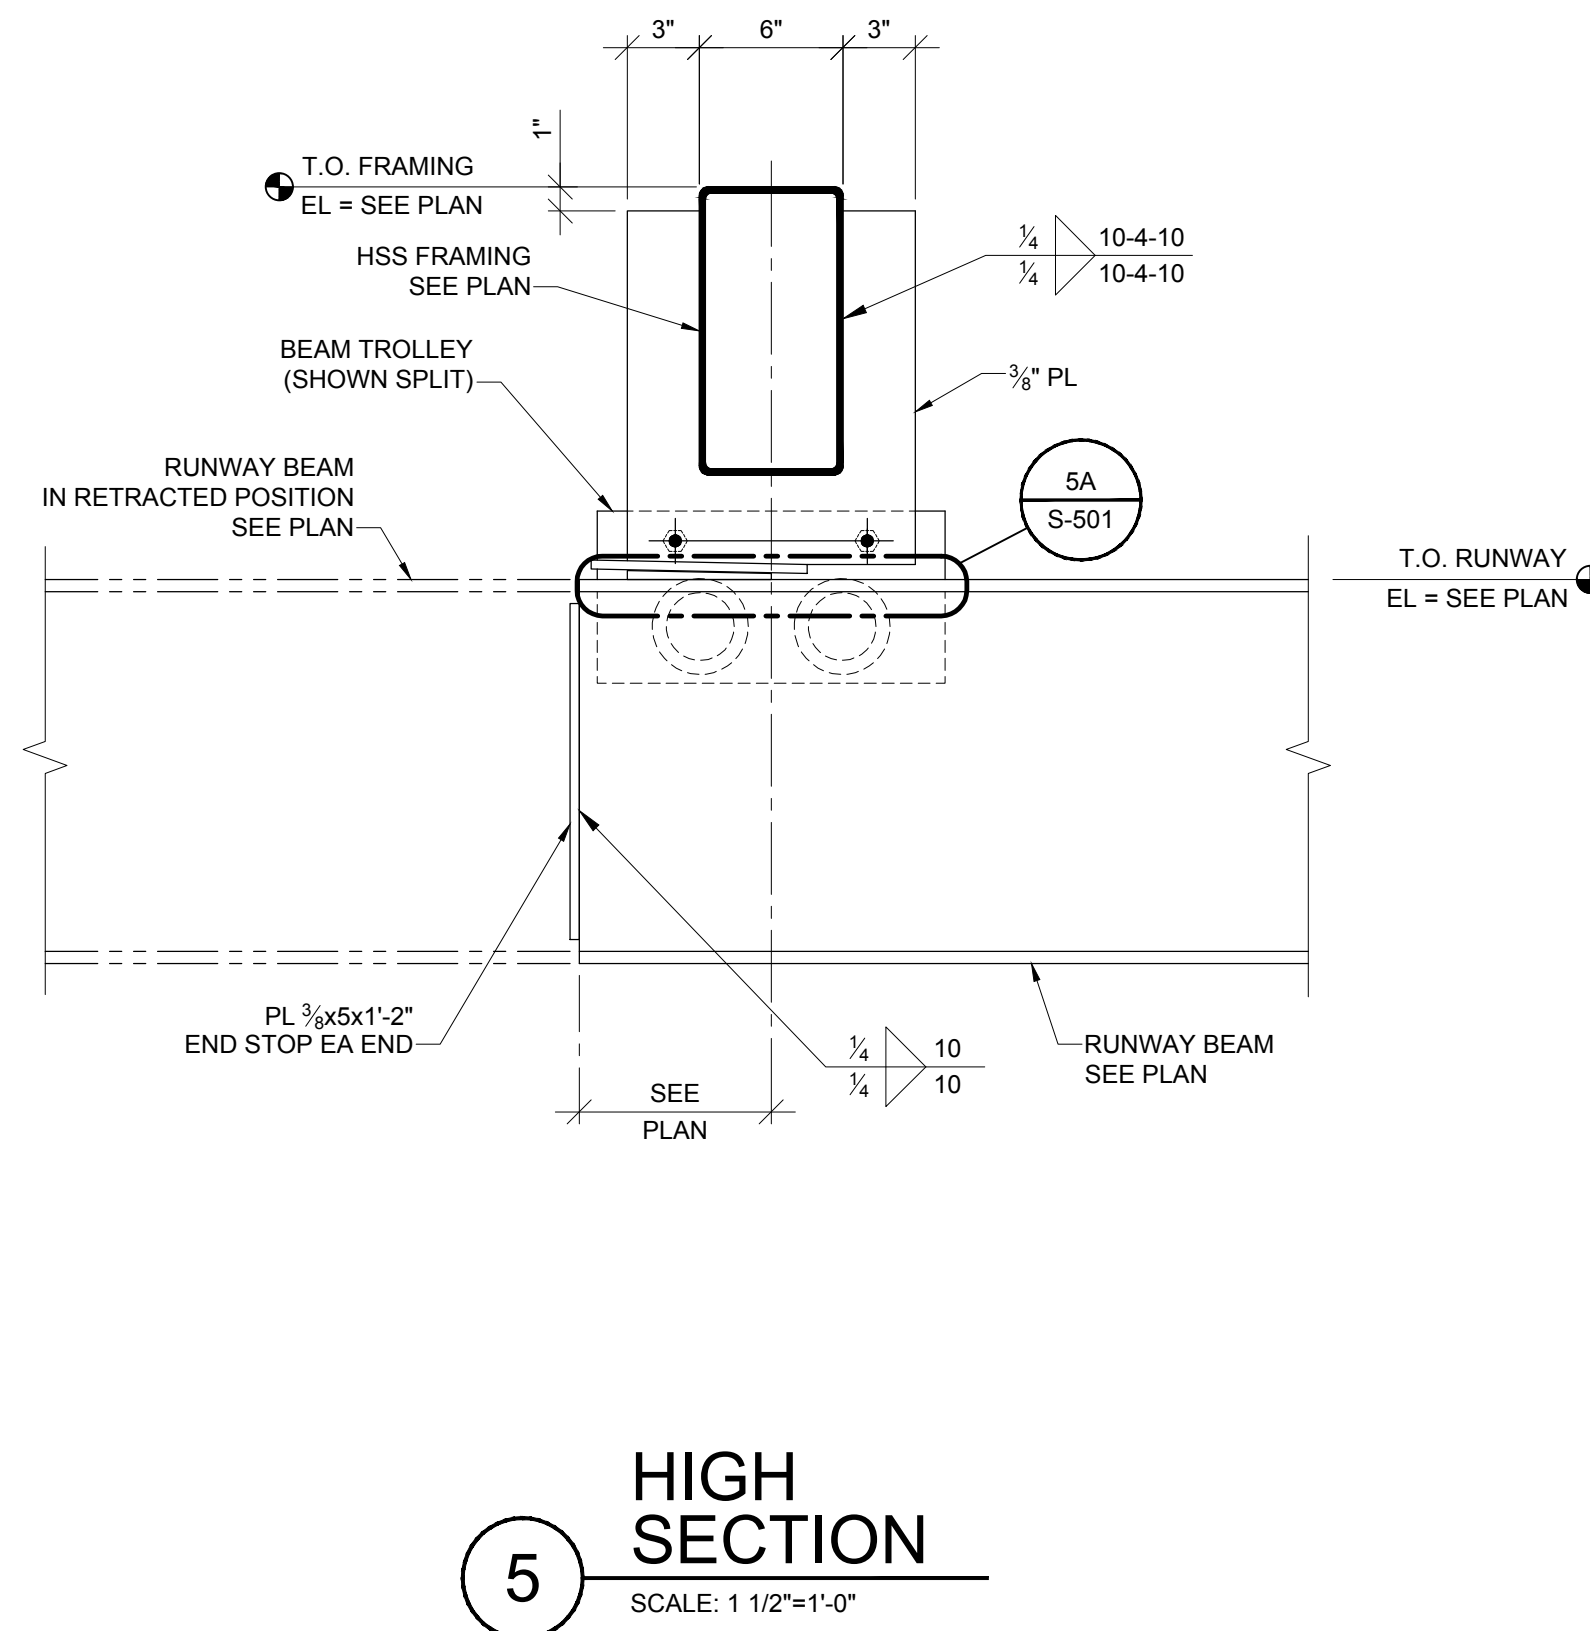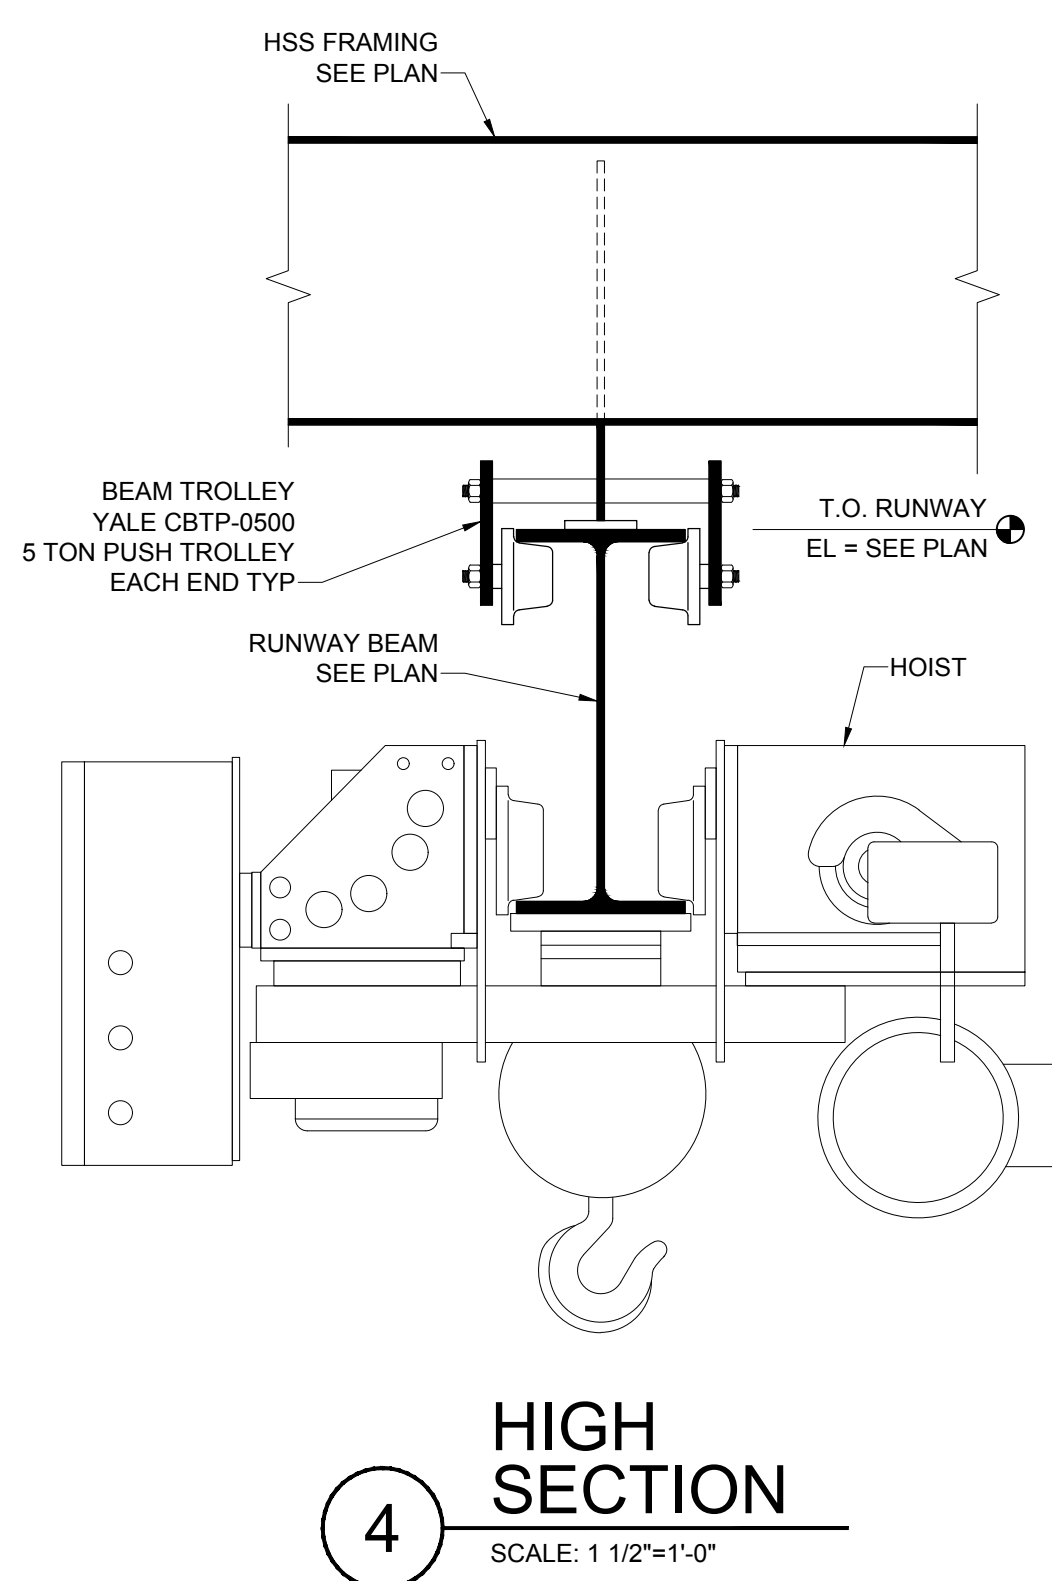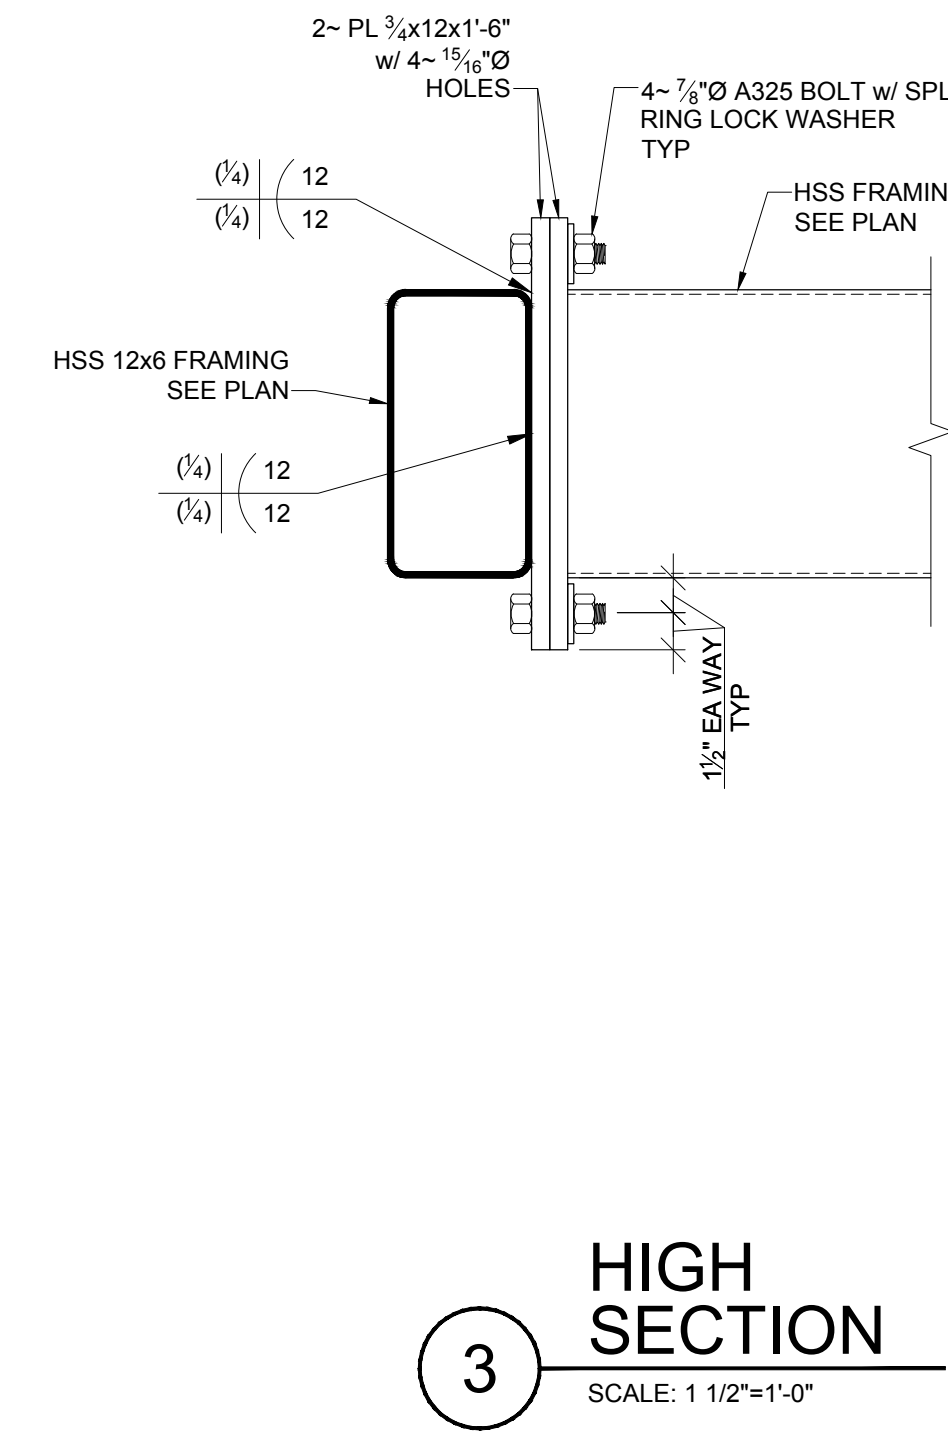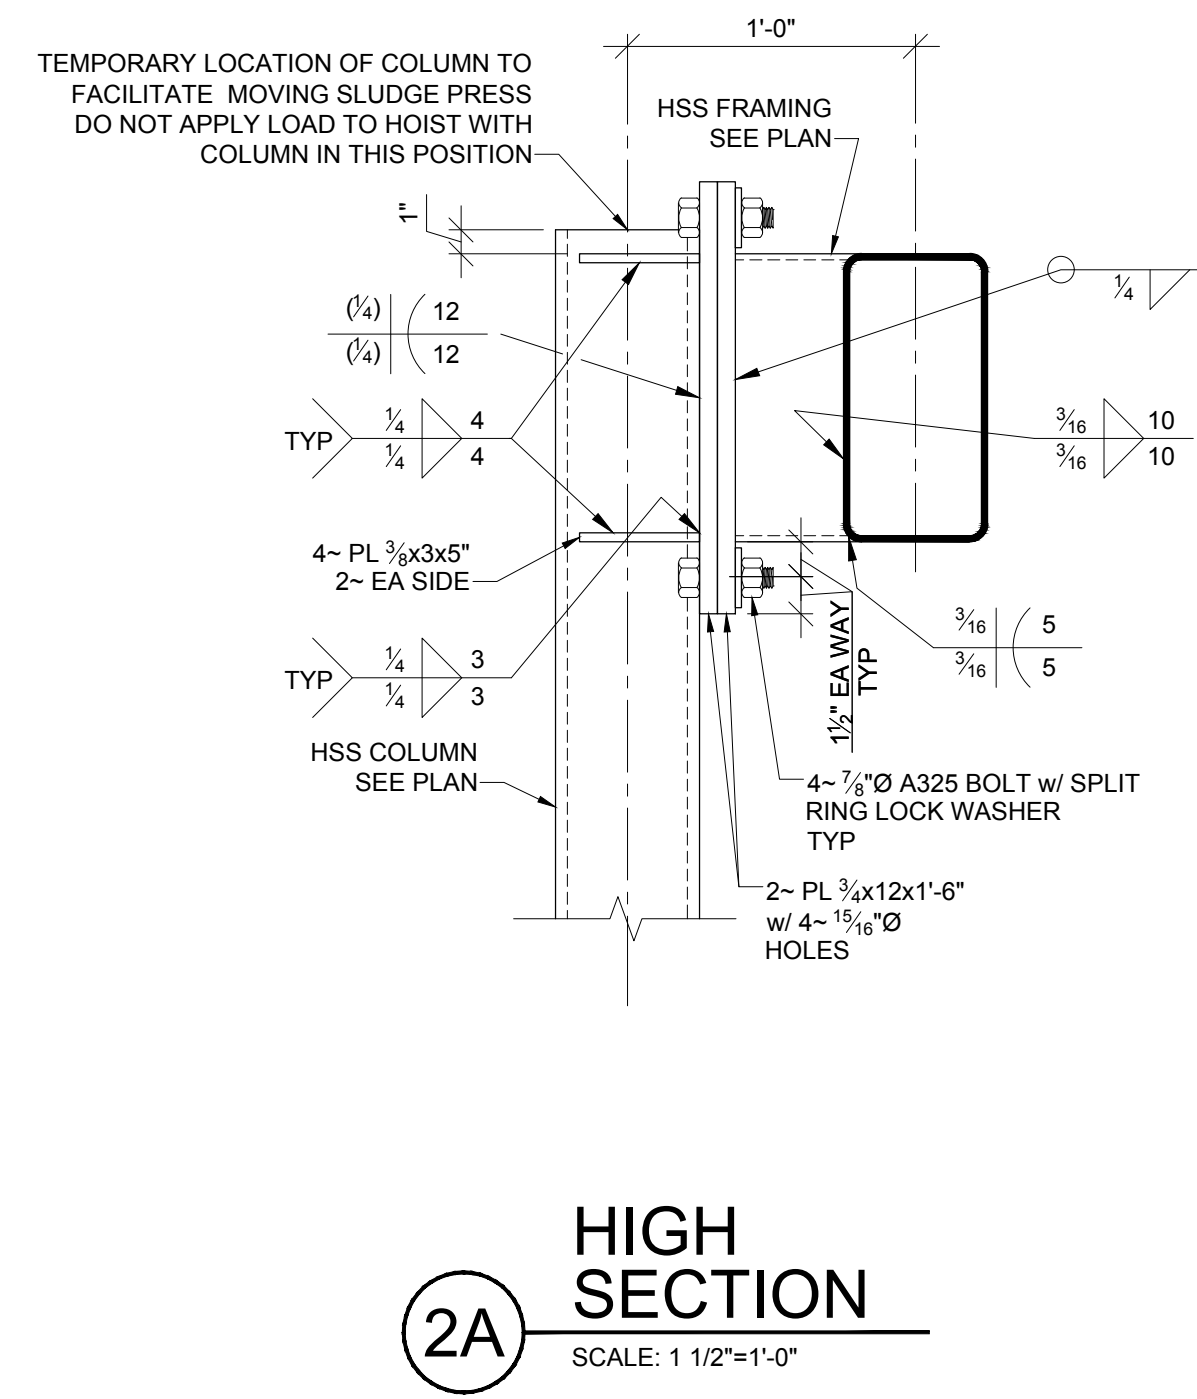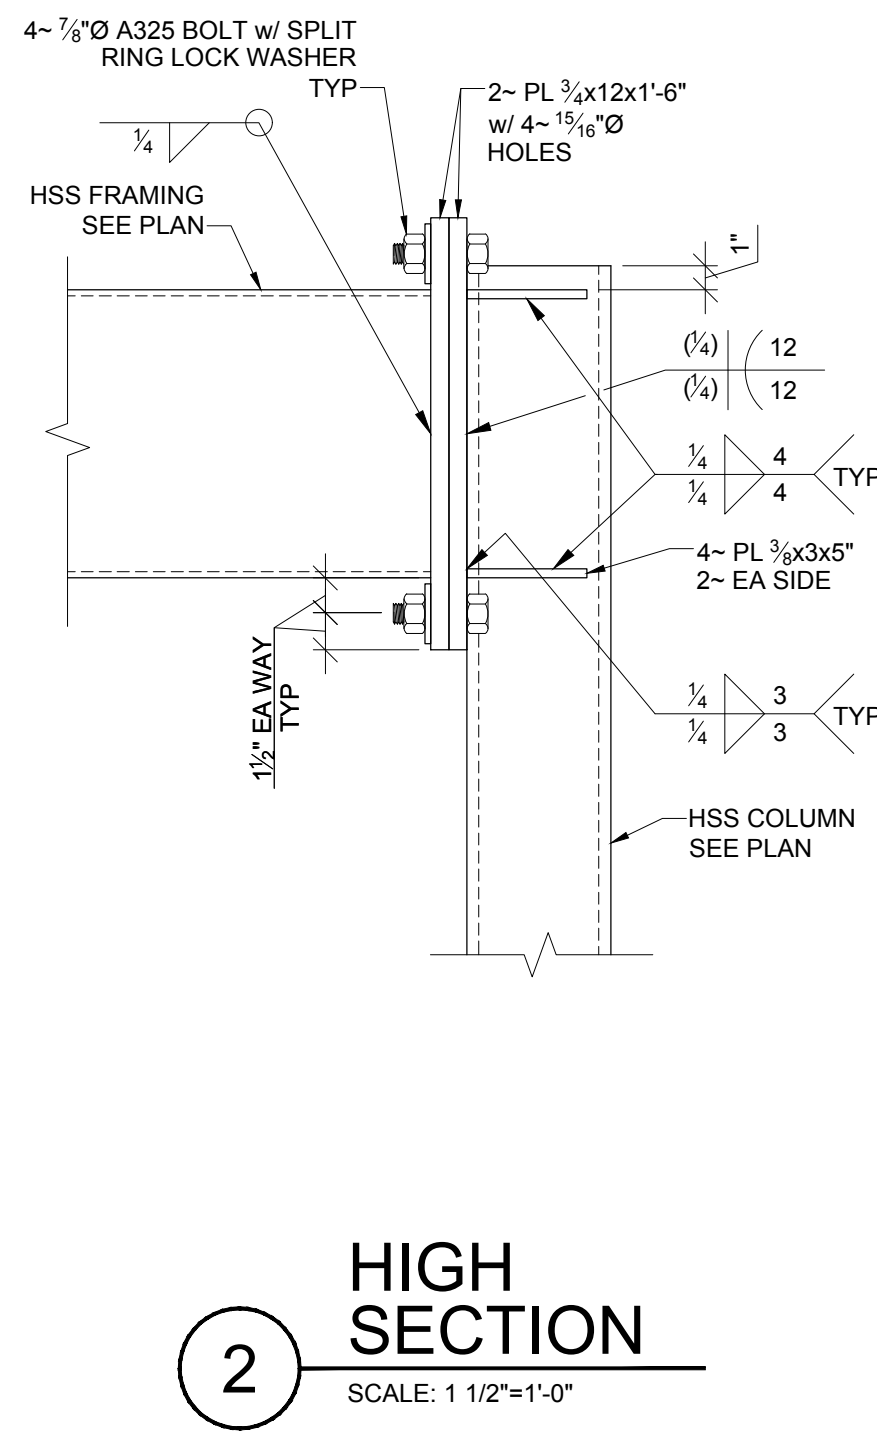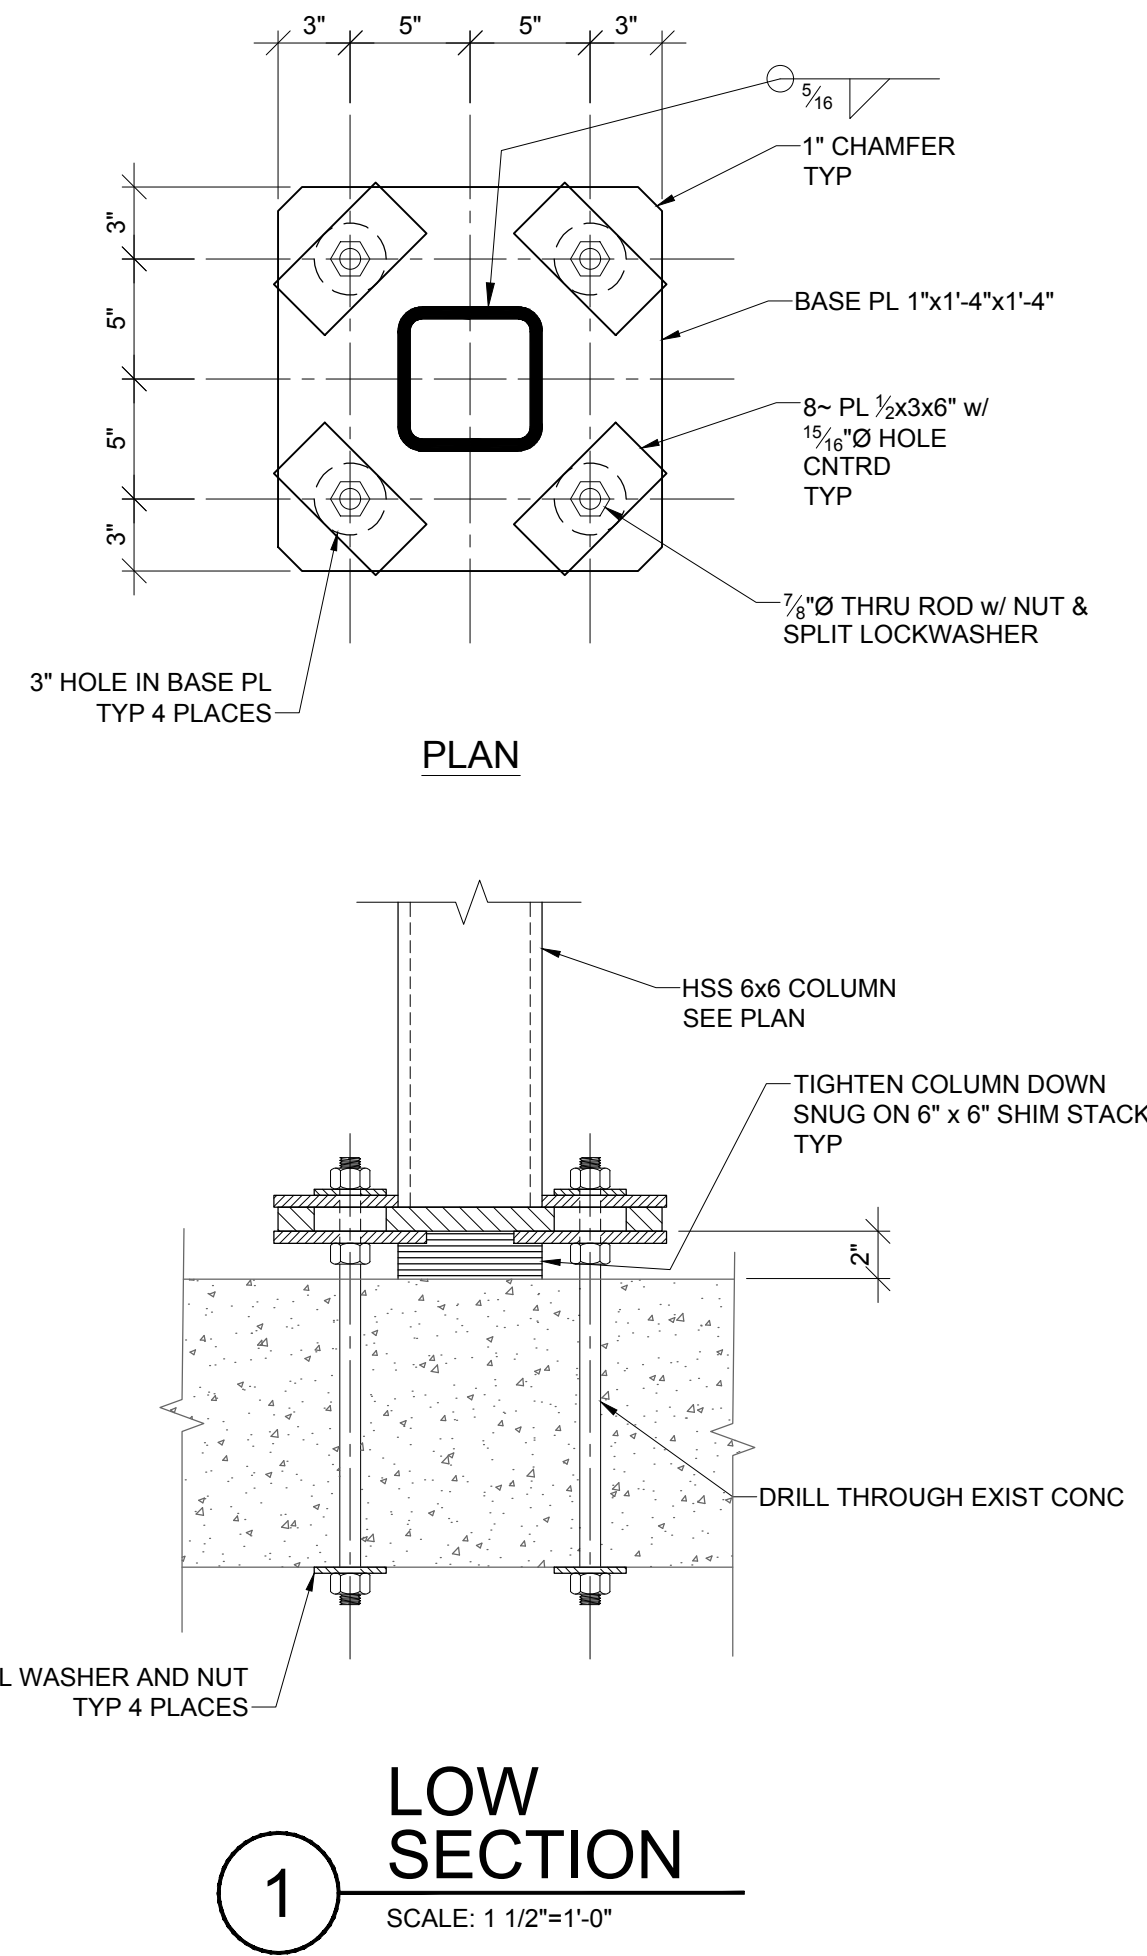

THIS RECORD DOCUMENT HAS BEEN PREPARED BASED ON INFORMATION PROVIDED BY THE CONSTRUCTION CONTRACTOR, GRW ENGINEERS, INC. HAS ATTEMPTED TO VERIFY THE ACCURACY AND/OR COMPLETENESS OF THIS INFORMATION BUT SHALL NOT BE RESPONSIBLE FOR ANY ERRORS OR OMISSIONS WHICH MAY BE INCORPORATED HEREIN AS A RESULT.

GRW
engineering | architecture | geospatial
www.grwinc.com
ENGINEER/ARCHITECT: David C. Osborne
CONSTRUCTION COMPANY: Dugan & Meyers
DATE: 4/23/19

NO.	DATE	DESCRIPTION	DESIGNED	BY	MWC	DRAWN	BY	MWC	REVIEWED	BY	APPROVED	BY

SCALE CHECK: _____ THIS MARK SHOULD MEASURE EXACTLY 1" WHEN PLOTTED

DATE: APRIL, 2019
SCALE: AS NOTED
SHEET NO. **S-501**

BELT FILTER PRESS REPLACEMENT SECTIONS
TAYLOR MILL TREATMENT PLANT
NORTHERN KENTUCKY WATER DISTRICT

GRW PROJECT NO. 4384
CLIENT PROJECT NO. _____
ALL RIGHTS RESERVED. NO PART OF THIS DOCUMENT SHALL BE REPRODUCED IN WHOLE OR IN PART WITHOUT THE WRITTEN PERMISSION OF GRW ENGINEERS, INC. AND SHALL NOT BE USED FOR ANY OTHER PROJECT OTHER THAN THIS SPECIFIC PROJECT WITHOUT WRITTEN PERMISSION.


GRW
engineering | architecture | geospatial
www.grwinc.com

RECORD DOCUMENTS


PLOTTED BY: mwilliamson

PRINTED: 4/23/2019 @ 2:41 PM


FILE NAME: U:\4384-NKVD-TXTP-BFP-Working Drawings\AutoCAD\4384-S-502.dwg

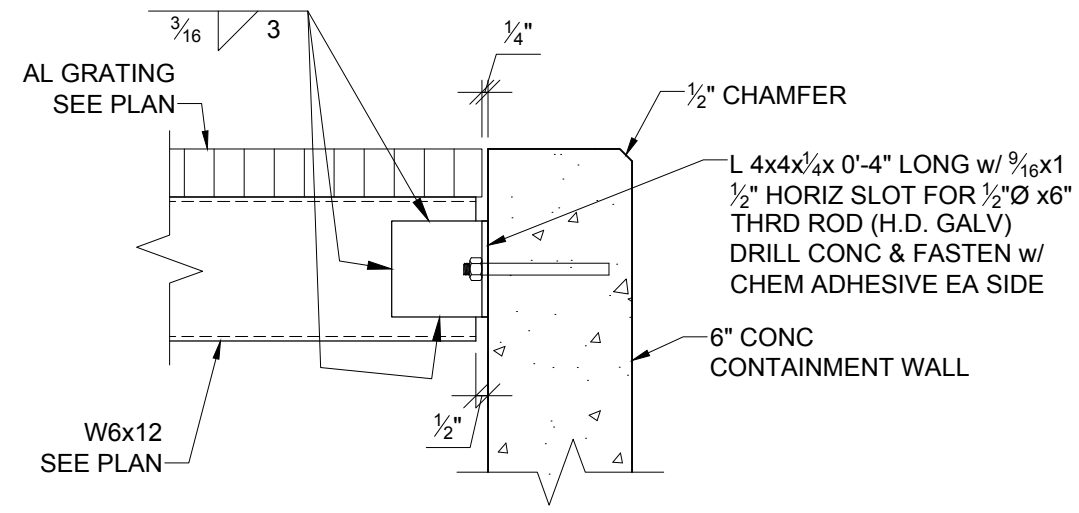


6A DETAIL
SCALE: 1 1/2"=1'-0"

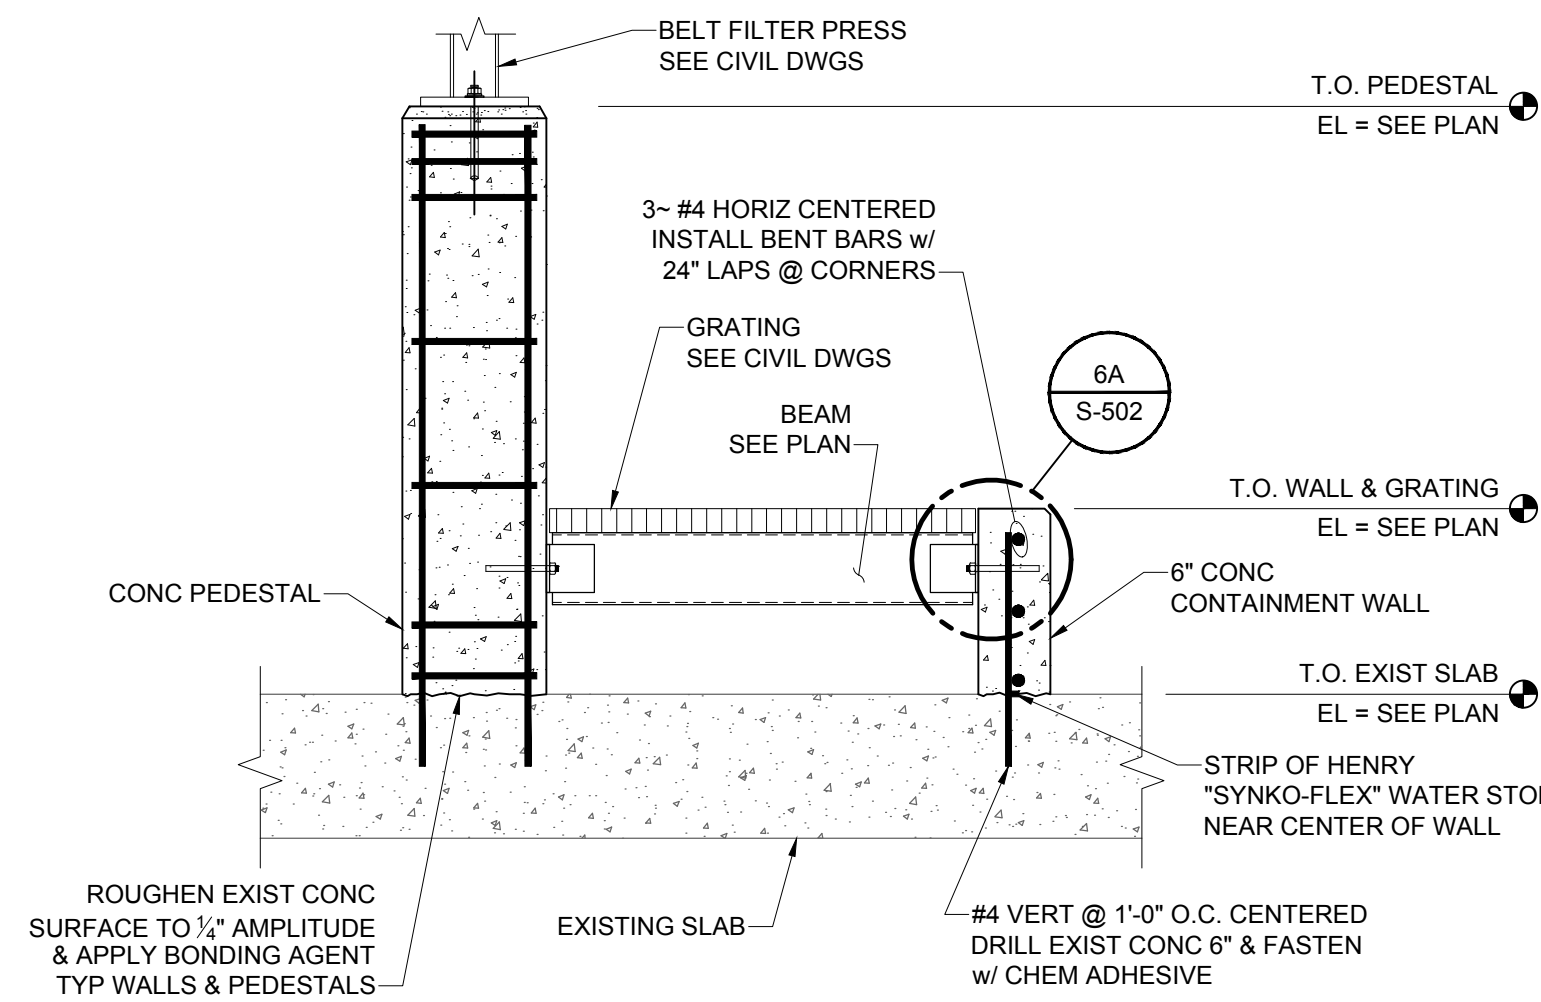


6 LOW SECTION
SCALE: 3/4"=1'-0"

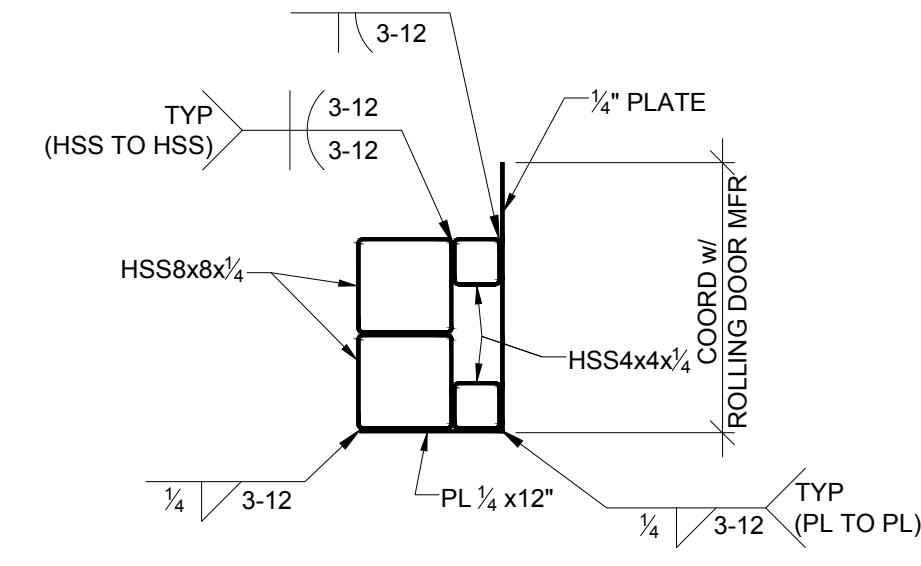


SECTION A

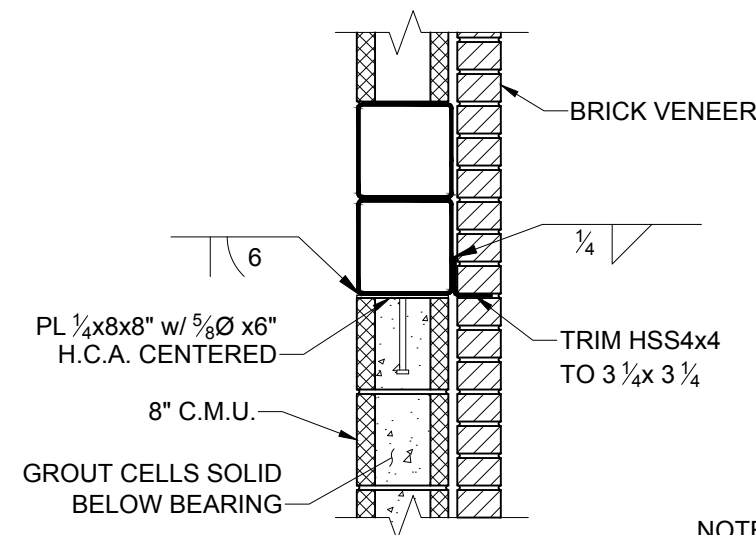


SECTION B

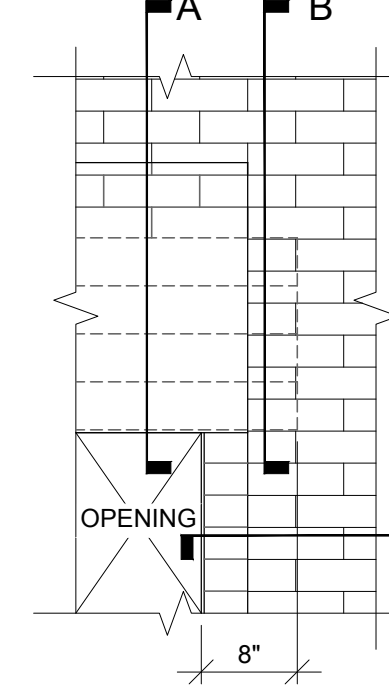


ELEVATION

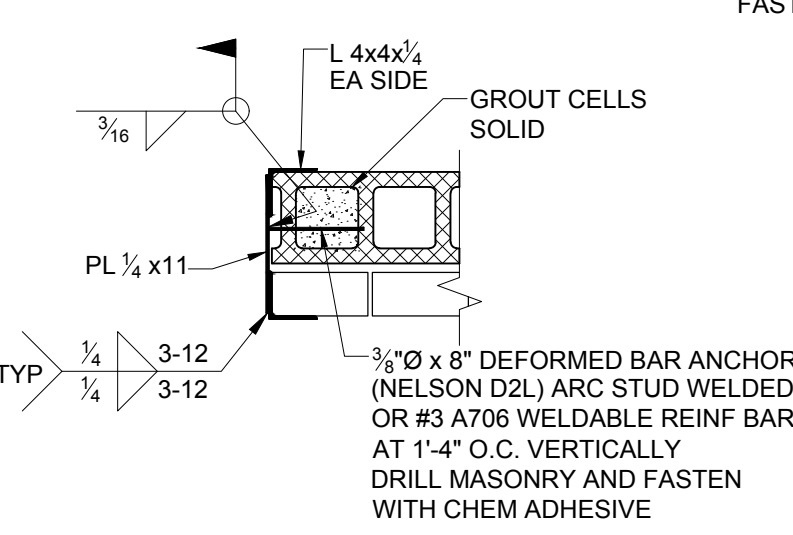


SECTION C

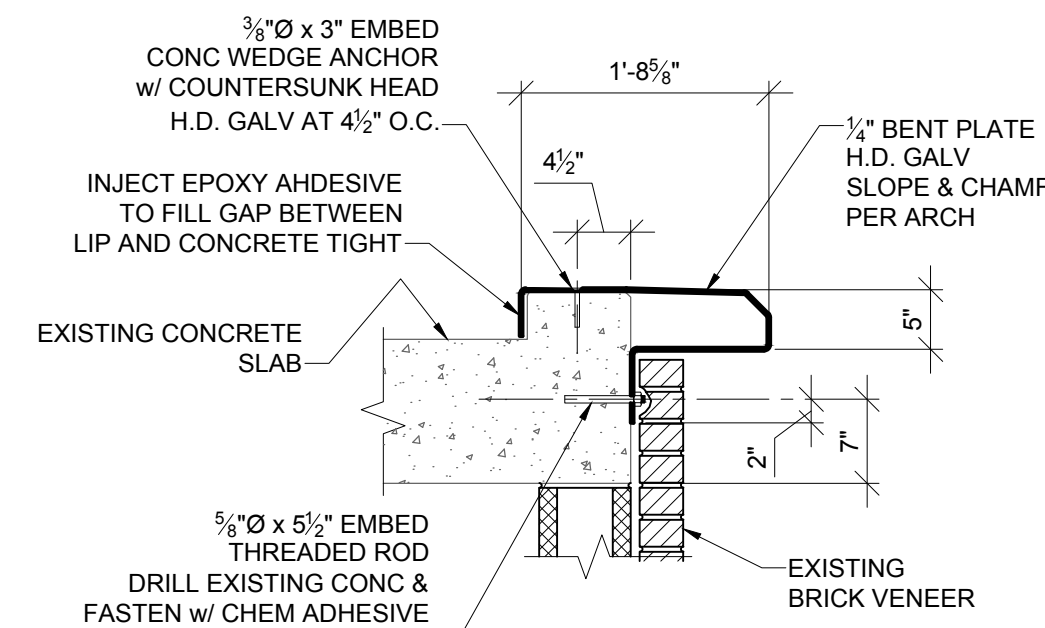

SECTION AT SILL

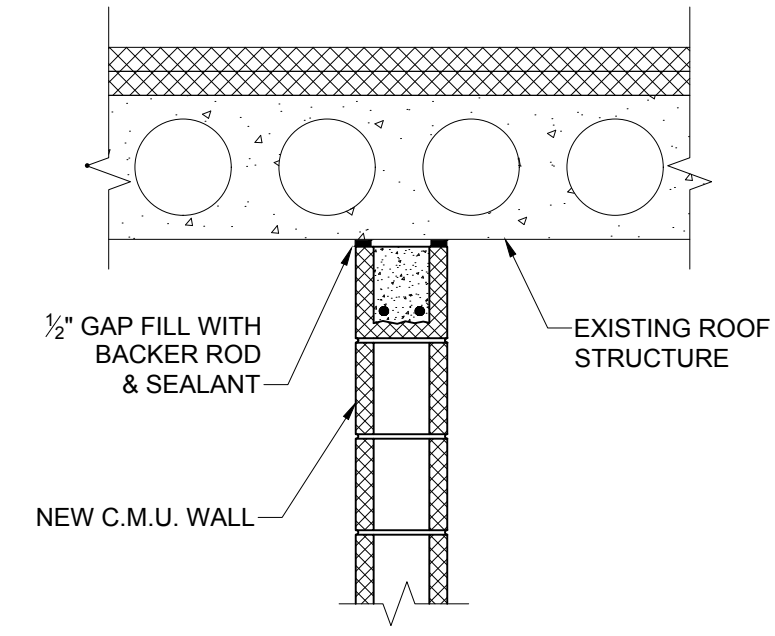


9 HIGH SECTION
SCALE: 3/4"=1'-0"

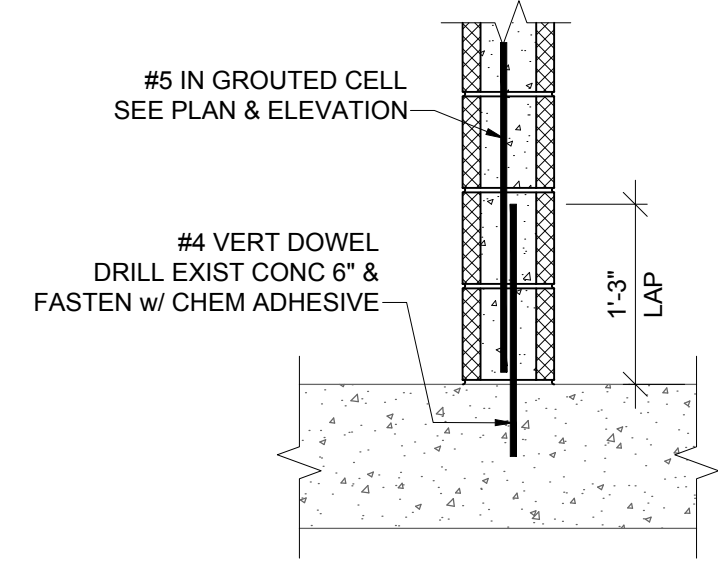


8 LOW SECTION
SCALE: 3/4"=1'-0"


7 SECTION
SCALE: 3/4"=1'-0"

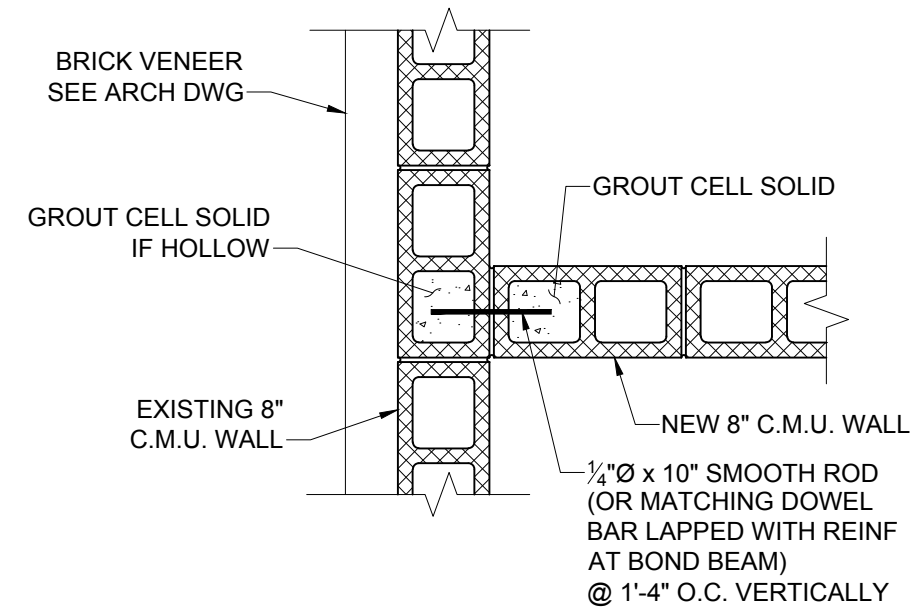


10 DETAIL
SCALE: 3/4"=1'-0"

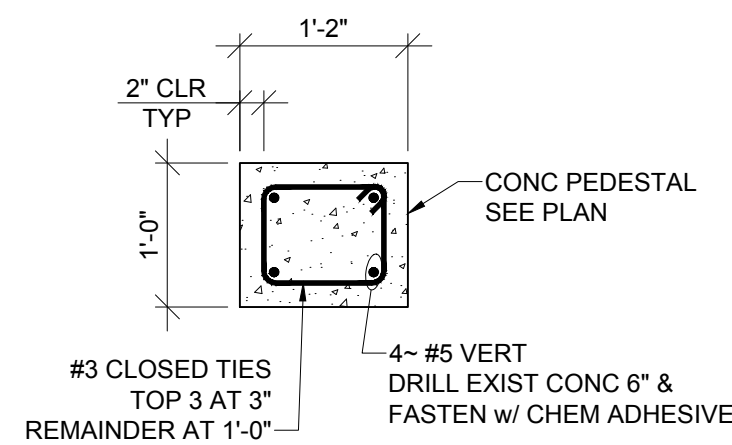


11 DETAIL
SCALE: 3/4"=1'-0"

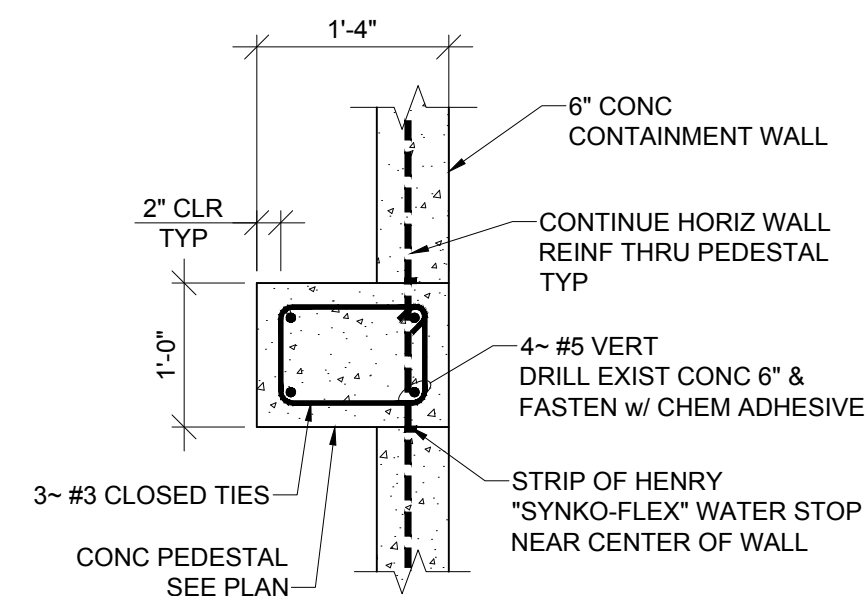

12 DETAIL
SCALE: 3/4"=1'-0"

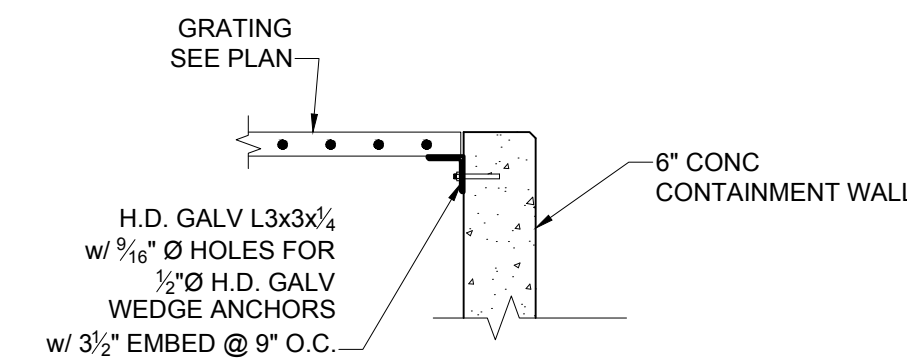

13 SECTION
SCALE: 3/4"=1'-0"

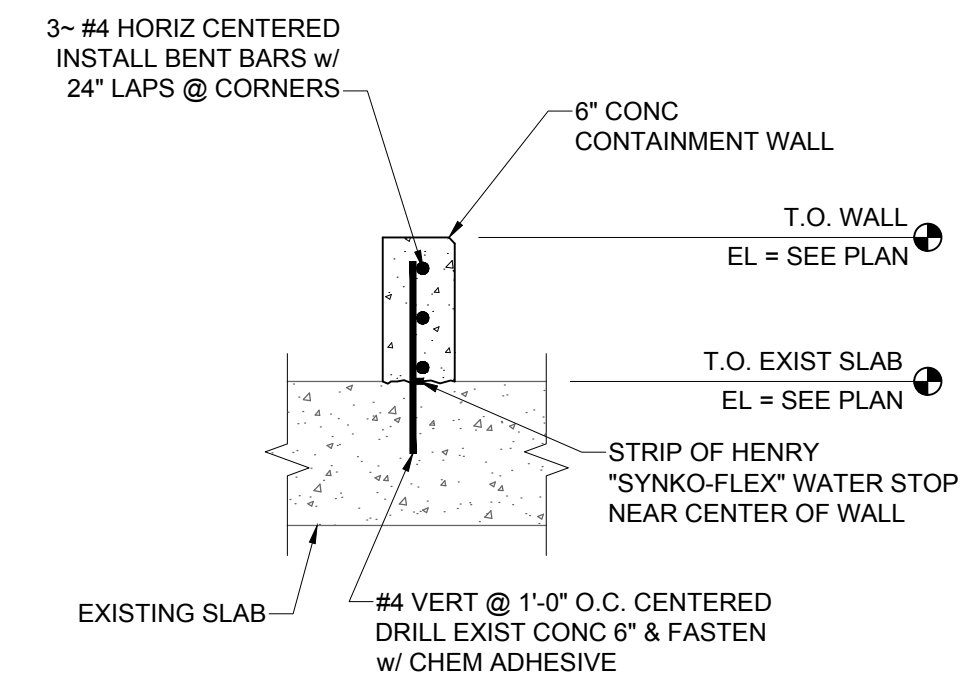

14 SECTION
SCALE: 3/4"=1'-0"

THIS RECORD DOCUMENT HAS BEEN PREPARED BASED ON INFORMATION PROVIDED BY THE CONSTRUCTION CONTRACTOR. GRW ENGINEERS, INC. HAS ATTEMPTED TO VERIFY THE ACCURACY AND/OR COMPLETENESS OF THIS INFORMATION BUT SHALL NOT BE RESPONSIBLE FOR ANY ERRORS OR OMISSIONS WHICH MAY BE INCORPORATED HEREIN AS A RESULT.


Grw
engineering | architecture | geospatial
www.grwinc.com

ENGINEER/ARCHITECT: David C. Osborne
CONSTRUCTION COMPANY: Dugan & Meyers
DATE: 4/23/19

GRW PROJECT NO. 4384

CLIENT PROJECT NO.

ALL RIGHTS RESERVED. NO PART OF THIS DOCUMENT SHALL BE REPRODUCED IN WHOLE OR IN PART WITHOUT THE WRITTEN PERMISSION OF GRW ENGINEERS, INC. AND SHALL NOT BE USED FOR ANY OTHER PROJECT OTHER THAN THIS SPECIFIC PROJECT WITHOUT WRITTEN PERMISSION.

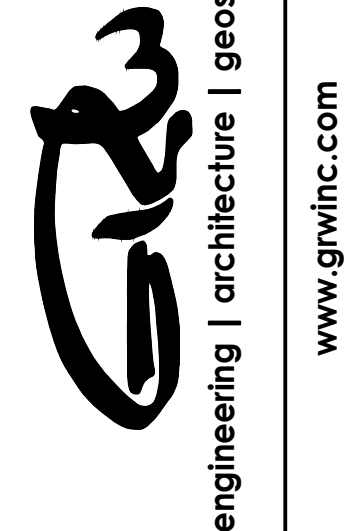

BELT FILTER PRESS REPLACEMENT SECTIONS
TAYLOR MILL TREATMENT PLANT
NORTHERN KENTUCKY WATER DISTRICT

DESIGNED	MWC
DRAWN	MWC
REVIEWED	
APPROVED	

NO.	REVISIONS	DESCRIPTION	DATE	BY

DATE: APRIL, 2019
SCALE: AS NOTED
SHEET NO.


S-502

RECORD DOCUMENTS

GENERAL ARCHITECTURAL NOTES:

- DIMENSIONS THAT ARE NOT STATED AS "MAXIMUM" OR "MINIMUM" ARE ABSOLUTE.
- CONTRACTOR SHALL NOT SCALE DRAWINGS FOR DIMENSIONAL USE. USE ONLY WRITTEN DIMENSIONS.
- CONTRACTOR SHALL INSTALL ALL BUILDING COMPONENTS WITHIN CURRENT DIMENSIONAL REQUIREMENTS OF THE ABA ACCESSIBILITY GUIDELINES FOR BUILDINGS AND FACILITIES.
- ALL EQUIPMENT SHOWN IN THE DRAWINGS IS TO BE CONTRACTOR FURNISHED AND INSTALLED UNLESS NOTED "NIC".
- CONTRACTOR AND SUB-CONTRACTORS TO VERIFY ALL DIMENSIONS IN THE FIELD PRIOR TO BEGINNING CONSTRUCTION OR ORDERING MATERIALS. INQUIRIES AND DISCREPANCIES SHOULD BE DIRECTED TO THE DESIGNER OF RECORD.
- CONTRACTOR SHALL COMPLY WITH ALL LAWS, ORDINANCES, RULES, AND REGULATIONS OF FEDERAL, STATE, REGIONAL, AND LOCAL AUTHORITIES REGARDING HANDLING, STORING, TRANSPORTING, AND DISPOSING OF HAZARDOUS MATERIALS. IF THE CONTRACTOR ENCOUNTERS MATERIALS WHICH HAVE NOT BEEN REMOVED OR RENDERED HARMLESS, THEY SHALL STOP WORK IN THE AREA AFFECTED AND REPORT THE CONDITION TO THE CONTRACTING OFFICERS REPRESENTATIVE AND PROPER AUTHORITIES IN WRITING.
- ALL ROOM NUMBERS ARE FOR CONSTRUCTION PURPOSES ONLY.
- PROPERLY SEAL ALL CONDUITS, PIPES, DUCTS & OTHER ITEMS OR SYSTEMS THAT PENETRATE FIRE-RATED PARTITIONS, WALLS, AND FLOORS. PROVIDE CLASSIFIED SEALANT SYSTEMS BY UNDERWRITERS LABORATORIES, INC.
- DETAILS NOT SHOWN ARE SIMILAR IN CHARACTER TO THOSE SHOWN. WHERE SPECIFIC DIMENSIONS, DETAILS, OR DESIGN INTENT CANNOT BE DETERMINED, CONSULT THE DESIGNER OF RECORD PRIOR TO PROCEEDING WITH WORK.
- SEPARATE ALL DISSIMILAR METALS TO PREVENT CORROSION CAUSED BY ELECTROLYSIS ACTION OR OTHER CAUSES AS RECOMMENDED BY THE RESPECTIVE PRODUCT MANUFACTURER OR SUPPLIER.
- THE CONTRACTOR SHALL PROVIDE DUST AND SOUND BARRIERS AS REQUIRED TO REASONABLY CONTAIN DIRT AND NOISE WITHIN THE CONSTRUCTION SITE.

ARCHITECTURAL SYMBOL KEY:

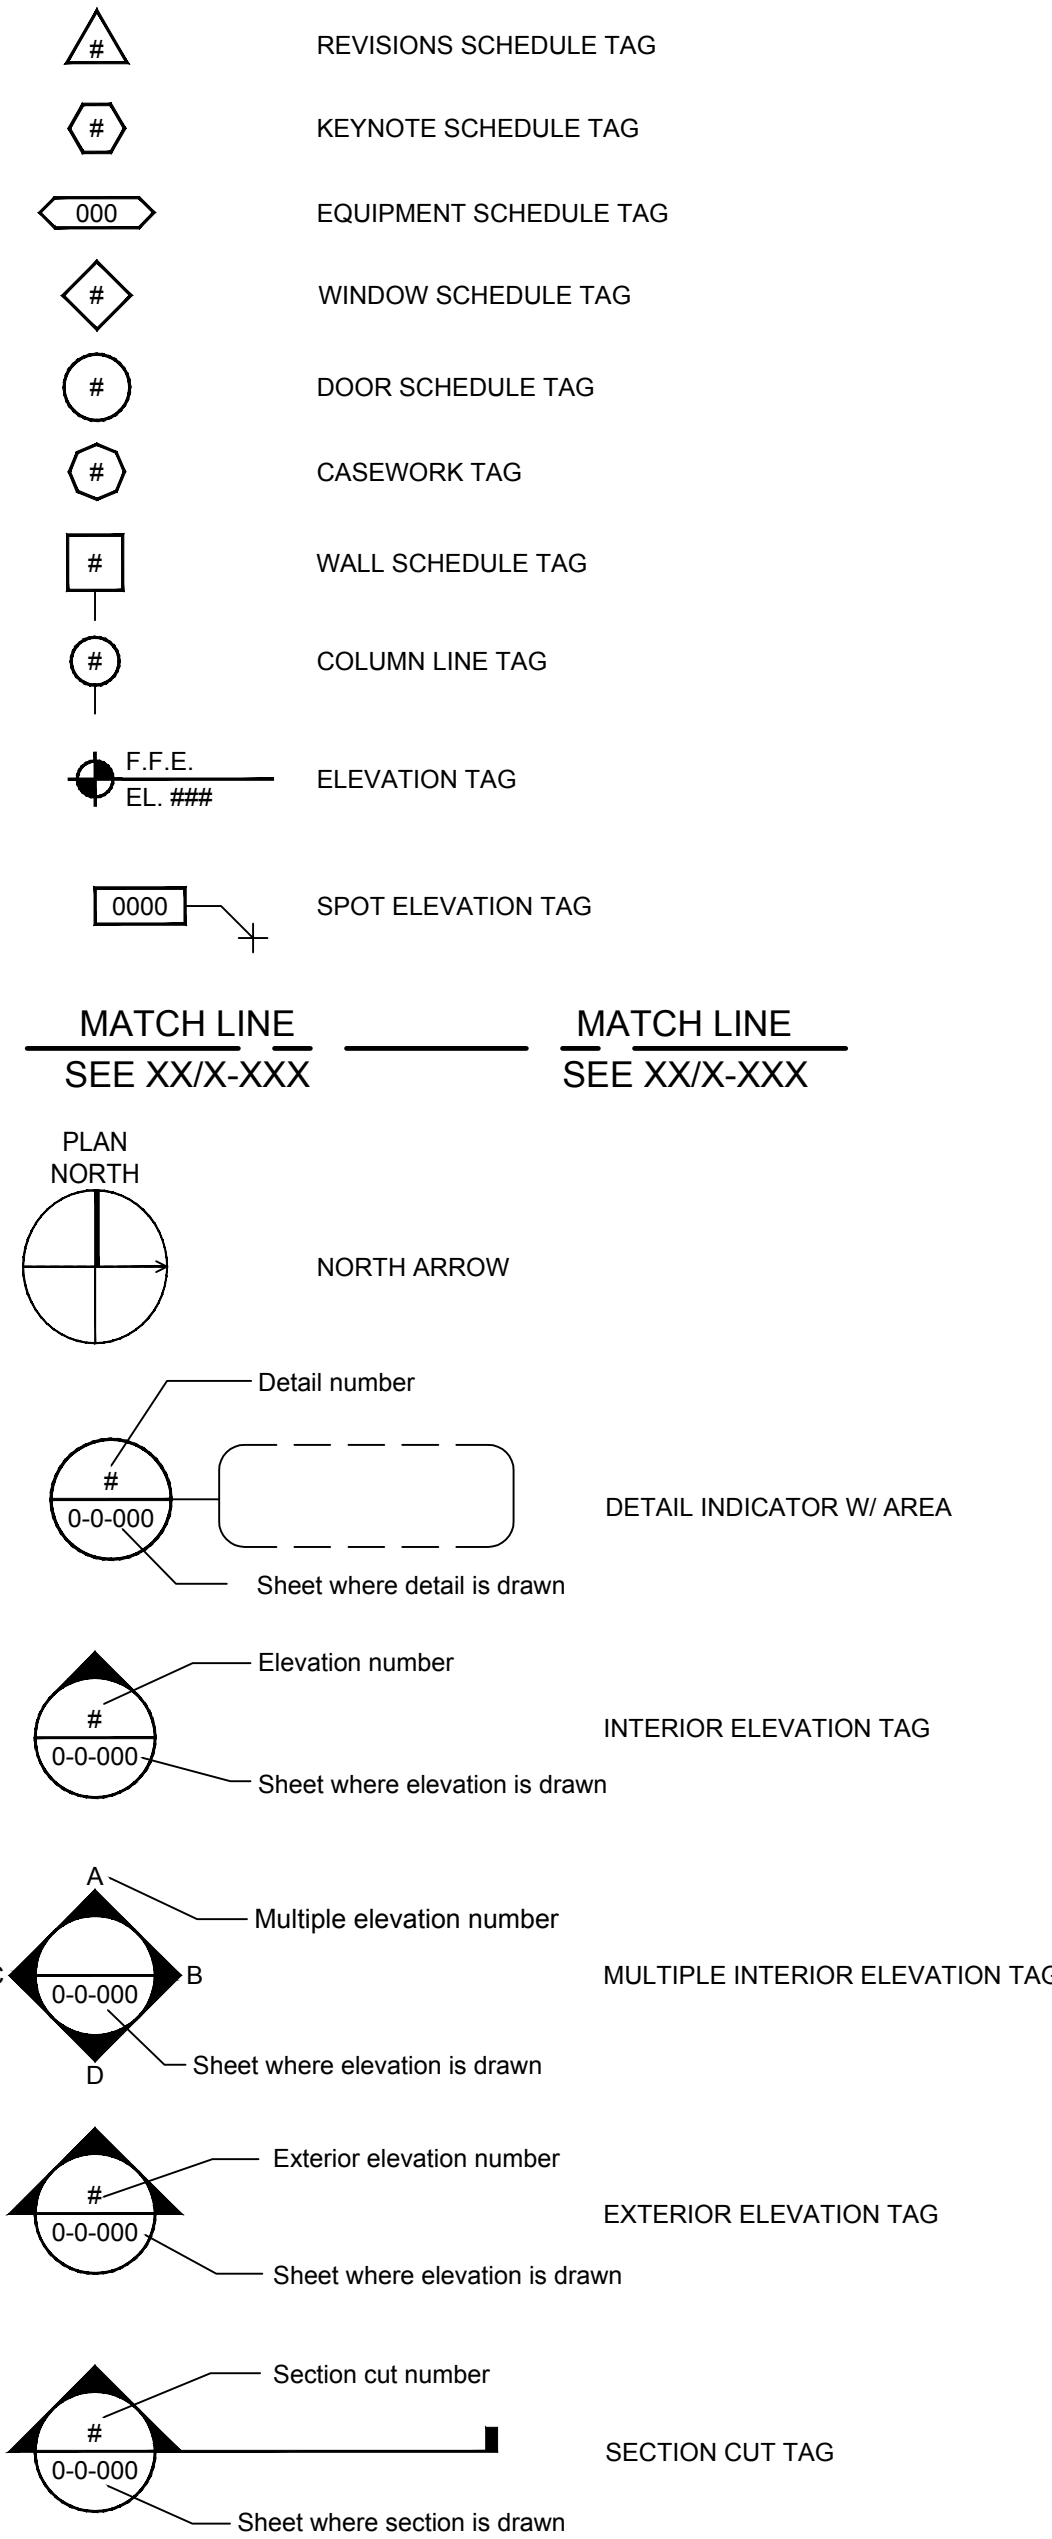

ABBREVIATIONS

A	AIR CONDITIONED	D (CONTD.)	DIFF.	DIFFUSER	I	INSIDE DIAMETER	P (CONTD.)	PSF	POUNDS/SQUARE FOOT
A.C.	ACOUSTIC TILE CEILING	DIFF.	DIMENSION	DISC.	DISCONNECT	I.E.	INVERT ELEVATION	PSI	POUNDS/SQUARE INCH
ACOUST / P	ACOUSTIC WALL PANEL	D.J.	DUMMY JOINT	DN.	DOWN	IN.	INCHES	PT.	POINT
ACOUST / S	ACOUSTIC TEXTURED SPRAY FINISH	D.S.	DRAIN	DR.	DRAIN	INCAND.	INCANDESCENT	PWD	PRE-ENGINEERED WOOD
A.D.	AREA DRAIN	D.S.	DOWN SPOUT	DR.	DRAIN	INSUL.	INSULATION	Q	QUARRY TILE
ADA	AMERICANS WITH DISABILITIES ACT	DWG.(S)	DRAWING(S)	D.S.	DRAIN	INT.	INTERIOR	QT	QUARRY TILE BASE
ADDIT.	ADDITIONAL	E	EACH	E.A.	EACH	INTL.	INTERNATIONAL	QTB	QUARTER
A.H.U.	AIR HANDLING UNIT	E.A.	EMPTY CONDUIT	E.C.	EXHAUST FAN	J.	JANITOR	QTR.	QUANTITY
ALT	ALTERNATE	E.C.	EXHAUST FAN	E.F.	EXPANSION JOINT	J.B.	JUNCTION BOX	QUAN.	QUANTITY
ALUM.	ALUMINUM	E.E.	ACCESS OPENING	E.J.	ELECTRIC	JCT.	JUNCTION		
AMP., A.	AMPERES	ELEC.	ELECTRIC	ELEV.	ELEVATION	JT.	JOINT		
ANSI	AMERICAN NATIONAL STANDARDS INSTITUTE	ELEV.	ELEVATION	ENG.	ENGINEER	K	KILOVOLT AMPERE		
APPROX.	APPROXIMATELY	ENG.	EPOXY PAINT	EP	EQUIPMENT	KW	KILOWATT		
A.O.	ACCESS OPENING	EQUIP.	EQUIPMENT	E.W.C.	ELECTRIC WATER COOLER	L	LONG		
ARCH.	ARCHITECTURAL	E.XH.	EXHAUST	EXT.	EXTERIOR	L.#	POUND		
ARGB	ABUSE-RESISTANT GYP. BD.	EXIST.	EXISTING	EXIST.	EXISTING	L.P.	LIGHTING PANEL		
A.T.	ASPHALT TILE	F	FIRE ALARM	F.A.	FIRE ALARM	LTG.	LIGHTING		
AV	AUDIO VISUAL	F.A.	FIRE ALARM	F.C.	FLEXIBLE CONNECTION	M	MOISTURE-RESISTANT GYP.BD.		
B	BALANCE	F.C.	FLOOR DRAIN	F.D.	FLOOR DRAIN	MAINT.	MAINTENANCE		
BAL.	BOARD	F.D.	FIRE EXTINGUISHER CABINET	F.F.C.	FINISH FLOOR ELEVATION	MAX.	MAXIMUM		
BDG.	BUILDING	F.F.E.	FACE OF	F.O.	FINISH	M.D.P.	MAIN DISTRIBUTION PANEL		
BLK.	BLANK	F.O.	FINISH	FIN.	FLOOR	MECH.	MECHANICAL		
BM.	BEAM	FLR.	FLOOR	FT.	FOOT, FEET	MIN.	MINIMUM		
BOT.	BOTTOM	FTG.	FOOTING	F.V.	FIELD VERIFY	MISC.	MISCELLANEOUS		
B.O.	BOTTOM OF	G	GAGE	GA.	GALLON	M.O.	MASONRY OPENING		
BRG.	BEARING	GA.	GALLON	GALV.	GALVANIZED	M.T.	METAL THRESHOLD		
B.T.U.H.	BRITISH THERMO UNIT/HOUR	GALV.	GALVANIZED	GEN.	GENERAL	MTD.	MOUNTED		
C	CENTER LINE	GEN.	GENERAL	GL.	GLASS	MTG.	MOUNTING		
CL	CLOSET	GLAZ.	GLAZING	GND.	GROUND	MTL.	METAL		
CLG.	CEILING	GND.	GROUND	G.P.H.	GALLONS/HOUR	M.V.	MECHANICAL VENTILATION		
CMD	CORRUGATED METAL DECKING	G.P.H.	GALLONS/HOUR	G.P.M.	GALLONS/MINUTE	M.G.T.	MATT GLAZE TILE		
C.M.U.	CONCRETE MASONRY UNIT	G.W.B.	GYPSON WALL BOARD	GYP.	GYPSON	N	NOT APPLICABLE		
C.O.	COLUMN	H	HIGH	H.	HIGH	N.A.	NOT IN CONTRACT		
COL.	COLUMN	H.&V.	HEATING AND VENTILATING	H.B.	HOSE BIBB	NO.	NUMBER		
CONC.	CONCRETE	H.C.	HOLLOW CORE	H.C.	HARDWARE	O	ON CENTER		
COND.	CONDENSATE	H.C.	HOLLOW CORE	H.C.	HARDWARE	O.C.	OUTSIDE DIAMETER		
CONN.	CONNECTION	H.C.	HOLLOW CORE	H.C.	HARDWARE	O.D.	OVERHEAD		
CONSTR.	CONSTRUCTION	H.C.	HOLLOW CORE	H.C.	HARDWARE	OH.	OPENING		
CONT.	CONTINUOUS	H.C.	HOLLOW CORE	H.C.	HARDWARE	OPNG.	OPPOSITE		
CONTR. JT.	CONTRACTION JOINT	H.C.	HOLLOW CORE	H.C.	HARDWARE	O.S.D.	OPEN SIGHT DRAIN		
COORD.	COORDINATE	H.C.	HOLLOW CORE	H.C.	HARDWARE	P	PAINT		
CT	CERAMIC TILE	H.C.	HOLLOW CORE	H.C.	HARDWARE	P	PARTITION		
CTB	CERAMIC TILE BASE	H.C.	HOLLOW CORE	H.C.	HARDWARE	P	PERIMETER		
D	DEMOLISH / DEMOLITION	H.C.	HOLLOW CORE	H.C.	HARDWARE	P.I.	POINT OF INTERSECTION		
DET.	DETAIL	H.C.	HOLLOW CORE	H.C.	HARDWARE	PL	PLATE		
DF	DRINKING FOUNTAIN	H.C.	HOLLOW CORE	H.C.	HARDWARE	PLBG.	PLUMBING		
DIA.	DIAMETER	H.C.	HOLLOW CORE	H.C.	HARDWARE	PLY. WD.	PLYWOOD		
		H.C.	HOLLOW CORE	H.C.	HARDWARE	PNL.	PANEL		
		H.C.	HOLLOW CORE	H.C.	HARDWARE	P.O.T.	POINT ON TANGENT		
		H.C.	HOLLOW CORE	H.C.	HARDWARE	PRE	PREFINISHED		
		H.C.	HOLLOW CORE	H.C.	HARDWARE	PRESS.	PRESSURE		
		H.C.	HOLLOW CORE	H.C.	HARDWARE	PRB	PROFILED RUBBER BASE		

PLOTTED BY: mwilliamson

PRINTED: 4/23/2019 @ 2:30PM

FILE NAME: U:\4384-NKVD\TMT\BFP\Working Drawings\AutoCAD\4384 A-001.dwg

GRW PROJECT NO. 4384

CLIENT PROJECT NO.

ALL RIGHTS RESERVED. NO PART OF THIS DOCUMENT IS TO BE REPRODUCED IN WHOLE OR IN PART WITHOUT THE WRITTEN PERMISSION OF GRW ENGINEERS, INC. AND SHALL NOT BE USED FOR ANY OTHER PROJECT OTHER THAN THIS SPECIFIC PROJECT WITHOUT WRITTEN PERMISSION.

**BELT FILTER PRESS REPLACEMENT
GENERAL NOTES & SYMBOLS**

TAYLOR MILL TREATMENT PLANT
NORTHERN KENTUCKY WATER DISTRICT

NO.	REVISIONS DESCRIPTION	DATE	DESIGNED BY	DRAWN BY	REVIEWED BY	APPROVED BY
			JDR	JDR	JKP	JKP

SCALE CHECK: _____ THIS MARK SHOULD MEASURE EXACTLY 1" WHEN PLOTTED

DATE: APRIL, 2019

SCALE: 1/4" = 1'-0"

SHEET NO. A-001


THIS RECORD DOCUMENT HAS BEEN PREPARED BASED ON INFORMATION PROVIDED BY THE CONSTRUCTION CONTRACTOR GRW ENGINEERS, INC. HAS ATTEMPTED TO VERIFY THE ACCURACY AND/OR COMPLETENESS OF THIS INFORMATION BUT SHALL NOT BE RESPONSIBLE FOR ANY ERRORS OR OMISSIONS WHICH MAY BE INCORPORATED HEREIN AS A RESULT.

ENGINEER/ARCHITECT: David C. Osborne


CONSTRUCTION COMPANY: Dugan & Meyers

DATE: 4/23/19

RECORD DOCUMENTS

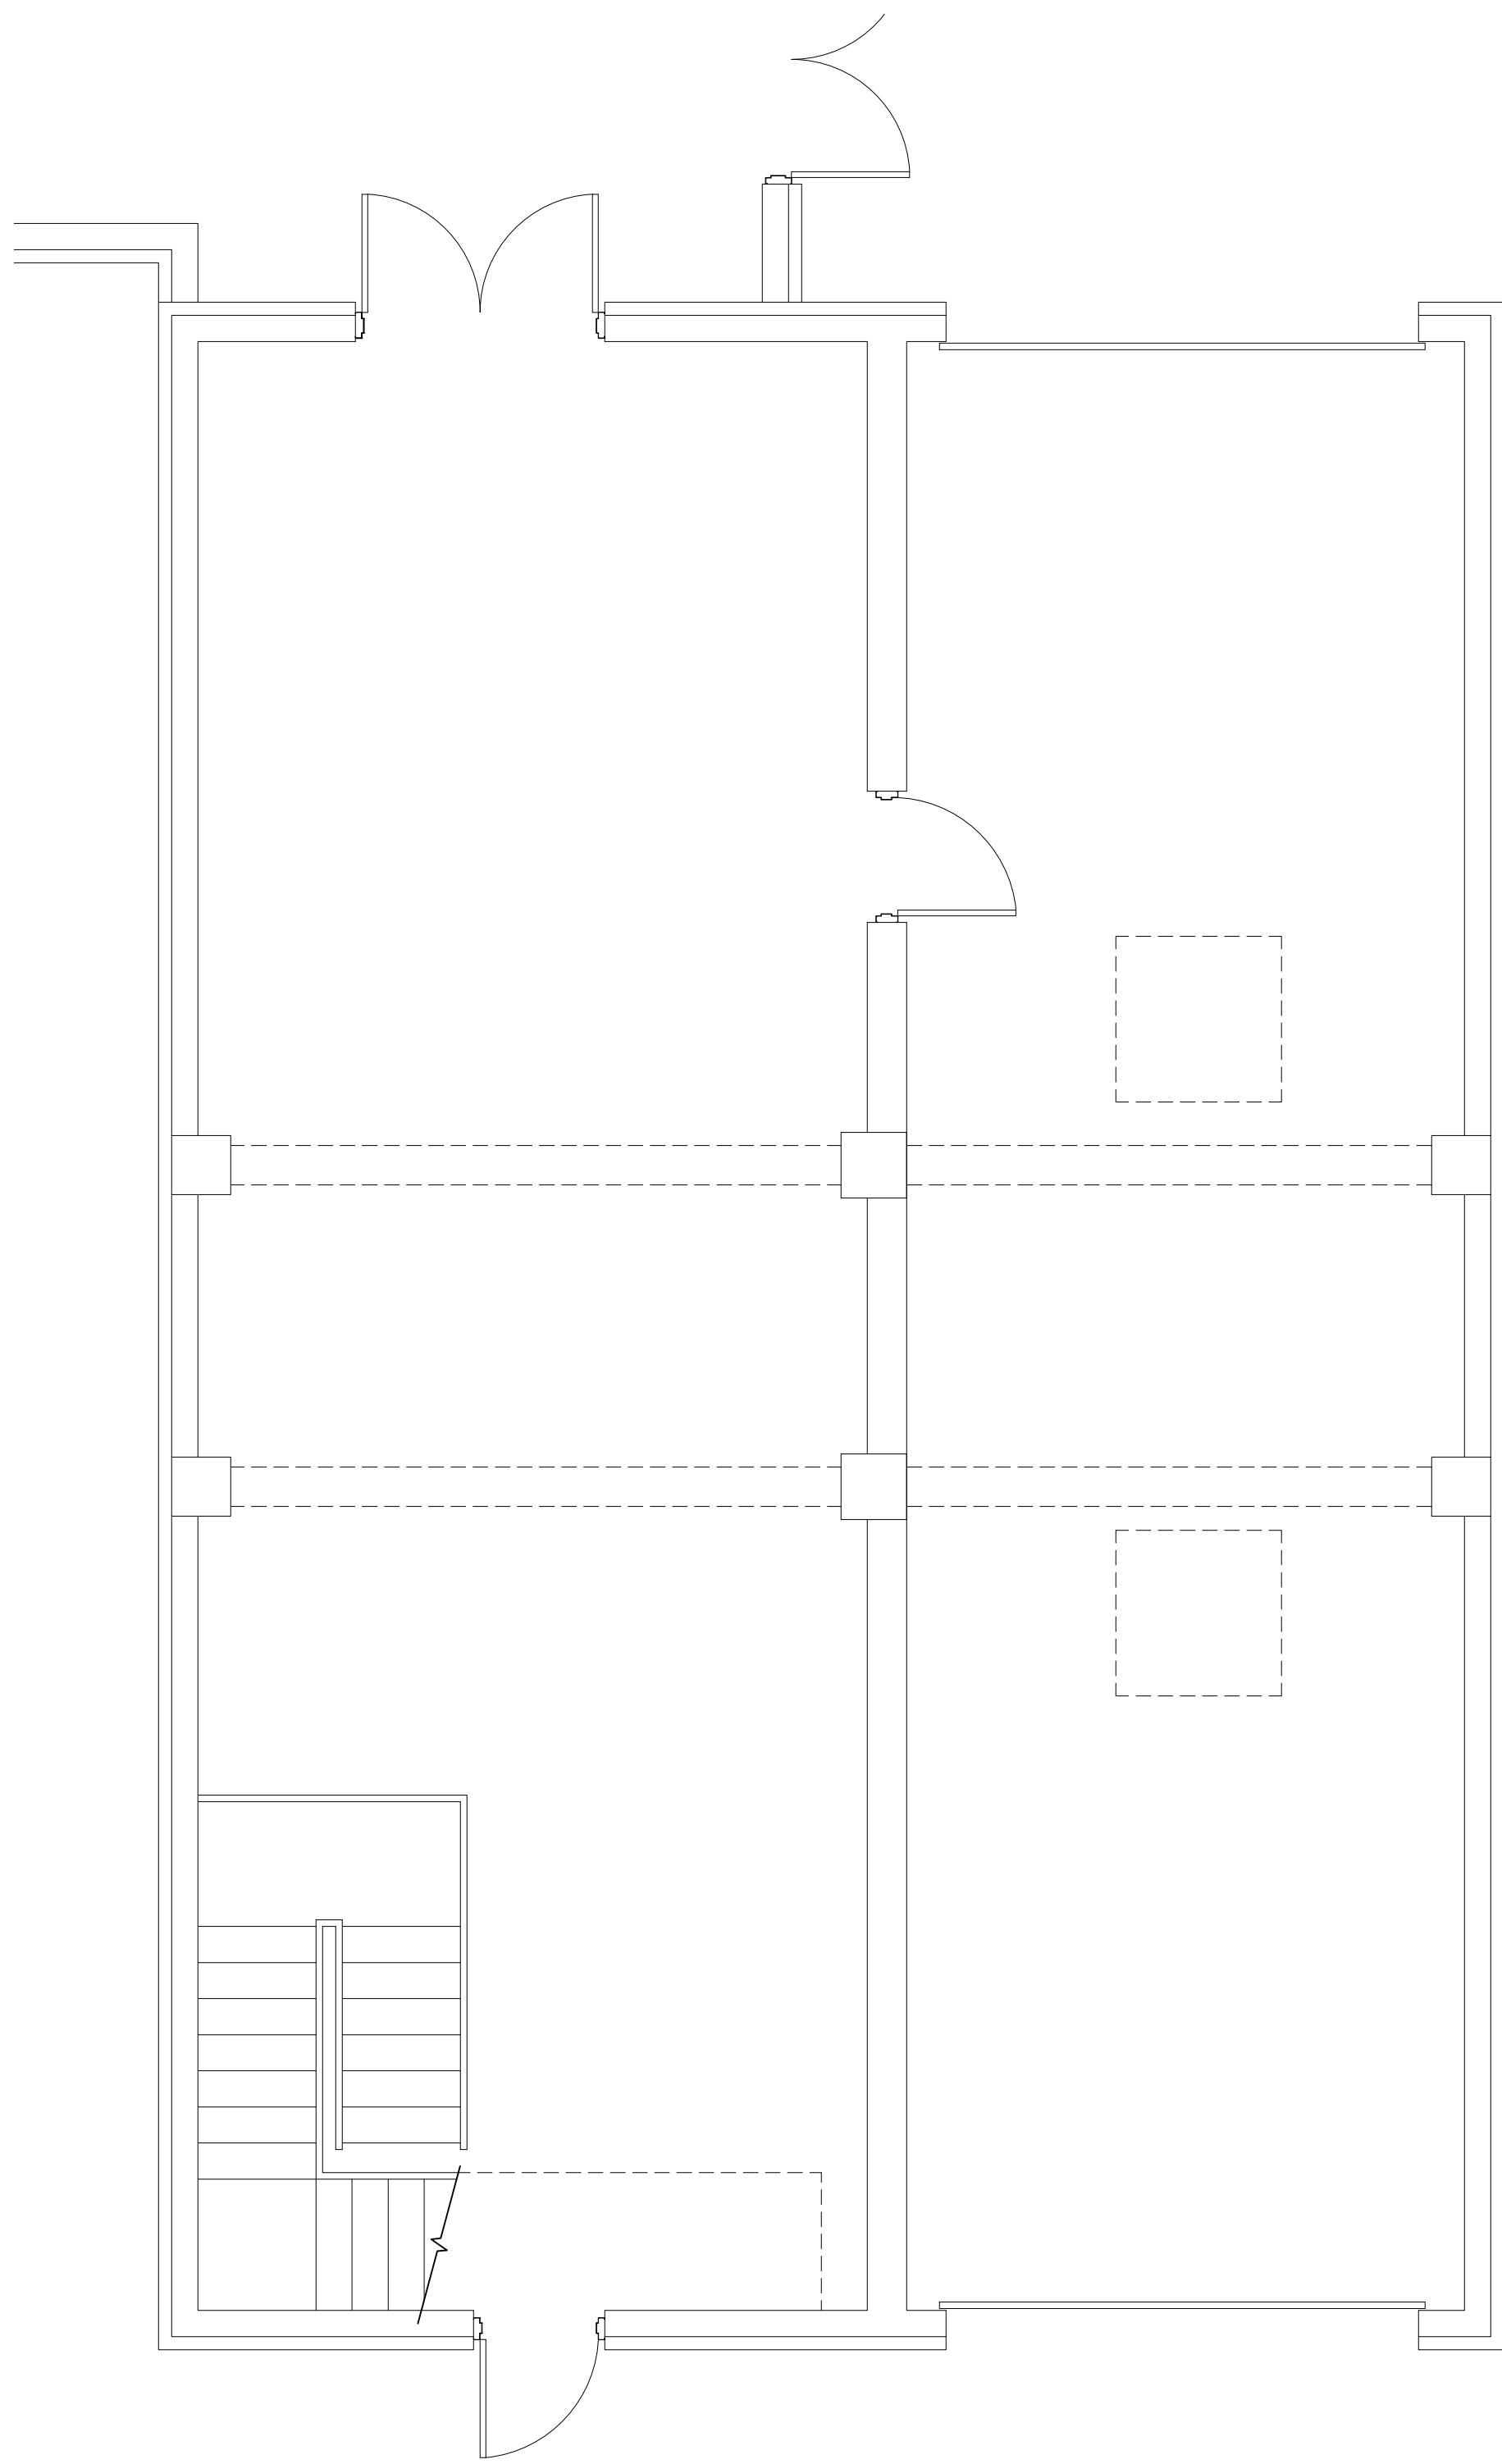

1 1st FLOOR DEMO PLAN
 SCALE: 1/4"=1'-0"
 0 2' 4' 8'
 PLAN NORTH

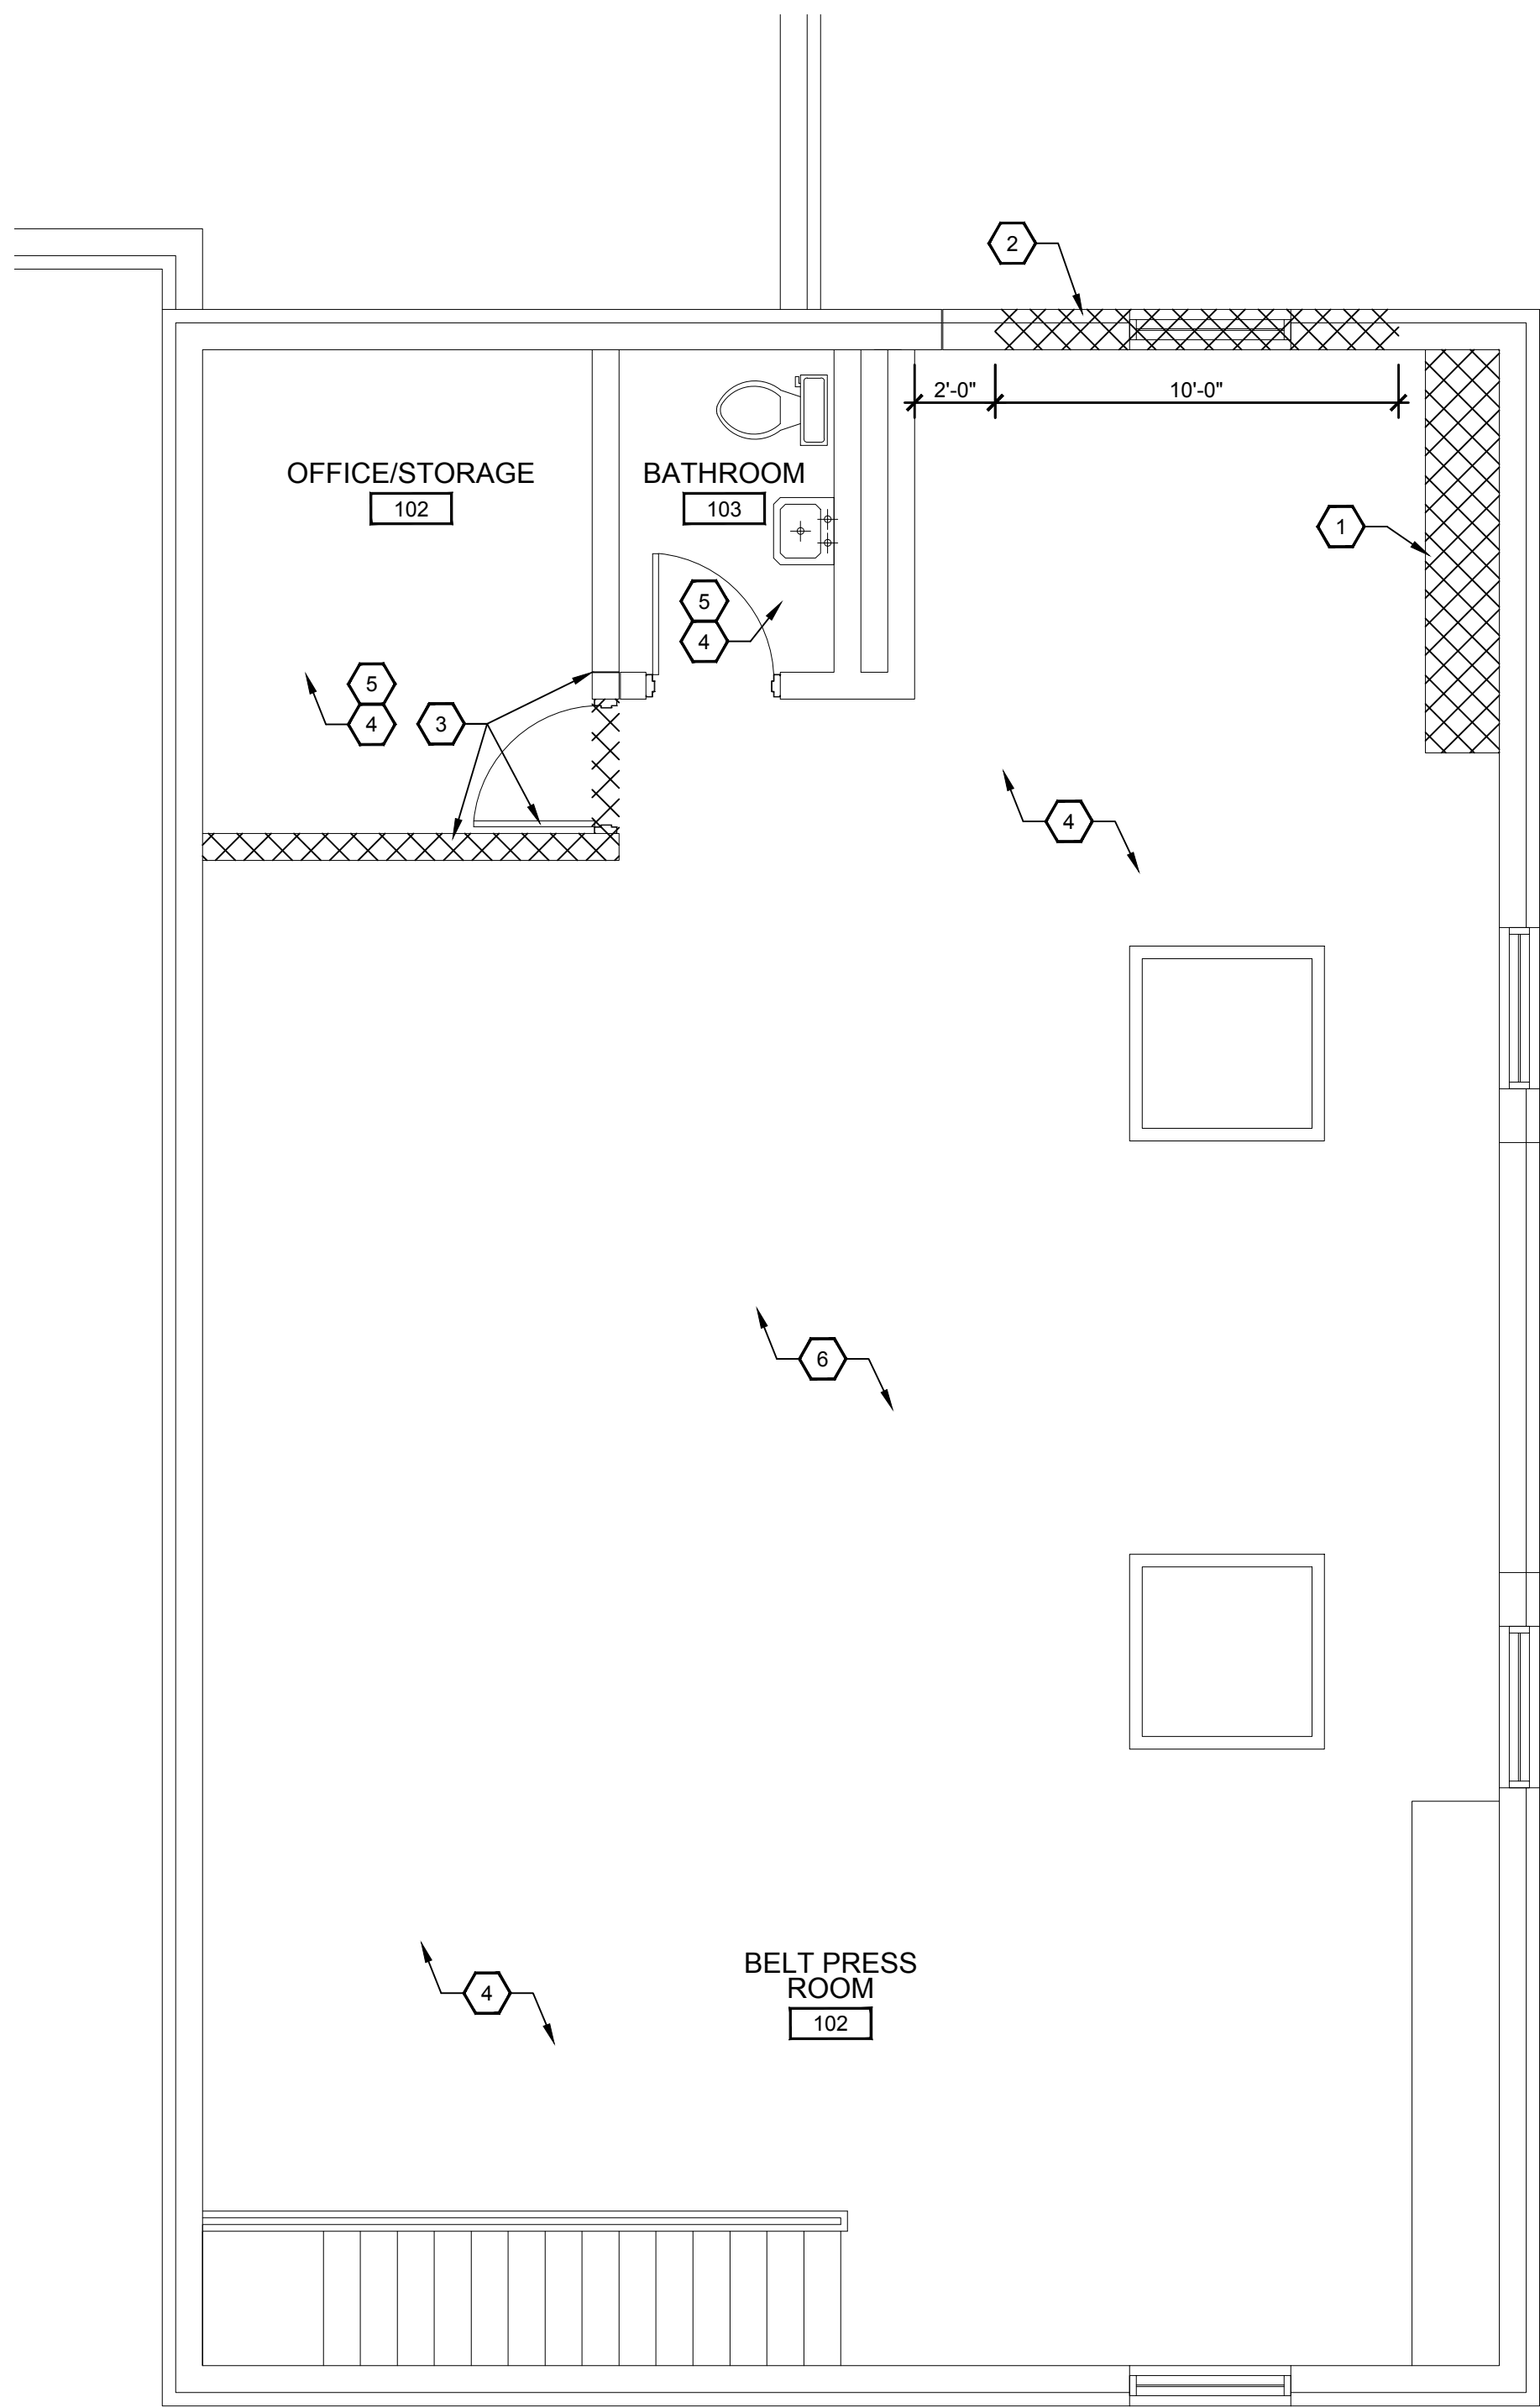

2 2nd FLOOR DEMO PLAN
 SCALE: 1/4"=1'-0"
 0 2' 4' 8'
 PLAN NORTH


- DEMOLITION KEYNOTES:**
- 1 REMOVE CONCRETE PAD.
 - 2 REMOVE PORTION OF THE WALL FOR INSTALLATION OF NEW OVERHEAD DOOR.
 - 3 REMOVE STORAGE DOOR AND WALL. TOOTH EXISTING CMU TO RECEIVE NEW.
 - 4 EXISTING CONCRETE FLOORS AND EDGE CURB TO BE COMMERCIAL BLAST CLEANED (SSPC-SP6). ALL EXISTING PAINT/FINISH TO BE REMOVED.
 - 5 REMOVE VCT FLOORING.
 - 6 SEE OTHER DISCIPLINES FOR ADDITIONAL DEMOLITION ITEMS.

- DEMOLITION GENERAL NOTES:**
1. DIMENSIONS ON DRAWINGS WERE GATHERED BY EXISTING DRAWINGS OR FIELD MEASUREMENTS - ACTUAL DIMENSIONS MAY VARY FROM THOSE INDICATED - CONTRACTOR SHALL FIELD VERIFY.
 2. THE CONDITION OF EACH KEYNOTED ITEM WAS GENERALLY SURVEYED. WORK REQUIRED IS GENERALLY INDICATED BUT DOES NOT INCLUDE ALL CONDITIONS EITHER SEEN OR UNSEEN. IT SHALL BE THE RESPONSIBILITY OF THE CONTRACTOR TO VISIT THE JOBSITE TO DETERMINE THE ACTUAL SCOPE OF EACH ITEM, ITEMS NOT LISTED, AND THE TOTAL WORK REQUIRED TO COMPLETE WORK TO A FINISHED CONDITION.
 3. ALL REMOVAL AND DEMOLITION SHALL BE COORDINATED WITH THE CONSTRUCTION SEQUENCING SCHEDULE. SEE SPECIFICATION SECTION 013213.
 4. SALVAGE OF EQUIPMENT AS INDICATED IN SPECIFICATION SECTION 024100.
 5. CONTRACTOR SHALL COORDINATE DEMOLITION WITH OWNER DURING SCHEDULED PLANT SHUTDOWN UNLESS OTHERWISE APPROVED BY OWNER.
 6. ROOM NUMBERS NOTED ON DRAWING ARE FOR DOCUMENT COORDINATION ONLY. ROOM NUMBERS NOTED ON DRAWINGS MAY NOT REFLECT THE ROOM NUMBERS ON SITE.
 7. CONTRACTOR TO COORDINATE WORK WITH OTHER TRADES. PATCH AND REPAIR WORK TO COMMENCE ONLY AFTER INSTALLATION WORK HAS BEEN COMPLETED.
 8. CONTRACTOR TO ASSUME RESPONSIBILITY FOR EXISTING PROJECT CONDITIONS.
 9. PROVIDE AND MAINTAIN TEMPORARY WEATHER PROTECTION DURING INTERVAL BETWEEN DEMOLITION ON EXTERIOR SURFACES AND NEW CONSTRUCTION TO PREVENT WATER INFILTRATION AND DAMAGE TO STRUCTURE AND INTERIOR AREAS.
 10. PROVIDE AND MAINTAIN SHORING, BRACING, AND STRUCTURAL SUPPORTS AS REQUIRED TO PRESERVE STABILITY AND TO PREVENT MOVEMENT, SETTLEMENT, OR COLLAPSE OF CONSTRUCTION TO REMAIN AND TO PREVENT UNEXPECTED OR UNCONTROLLED MOVEMENT OF CONSTRUCTION BEING DEMOLISHED.
 11. PROCEED WITH DEMOLITION SYSTEMATICALLY FROM HIGHER TO LOWER LEVEL. COMPLETE REMOVAL OPERATIONS ABOVE FLOOR LEVEL, SUCH AS REMOVAL OF ITEMS ABOVE CEILINGS AND CEILING REMOVAL BEFORE DISTURBING SUPPORTING MEMBERS BELOW.
 12. PROTECT AND MAINTAIN FLOOR AND WALL FINISHES TO REMAIN FOR REUSE.
 13. DO NOT USE CUTTING TORCHES UNTIL WORK AREA IS CLEARED OF FLAMMABLE MATERIALS AT CONCEALED SPACES. VERIFY CONDITION AND CONTENTS OF HIDDEN SPACES - MAINTAIN FIRE WATCH AND PORTABLE FIRE SUPPRESSION DEVICES.
 14. VERIFY ELECTRICAL CIRCUITS ARE DE-ENERGIZED PRIOR TO COMMENCEMENT OF DEMOLITION WORK.
 15. VERIFY WATER SERVICE IS SHUT OFF. DISCONNECT AND CAP LINES PRIOR TO BEGINNING DEMOLITION WORK. DO NOT ALLOW WATER SERVICE TO FREEZE DURING THE PROCESS OF SHUTTING DOWN UTILITIES.
 16. VERIFY GAS SERVICE IS SHUT OFF.
 17. COMPLY WITH HAULING AND DISPOSAL REGULATIONS OF AUTHORITIES HAVING JURISDICTION.


THIS RECORD DOCUMENT HAS BEEN PREPARED BASED ON INFORMATION PROVIDED BY THE CONSTRUCTION CONTRACTOR. GRW ENGINEERS, INC. HAS ATTEMPTED TO VERIFY THE ACCURACY AND/OR COMPLETENESS OF THIS INFORMATION BUT SHALL NOT BE RESPONSIBLE FOR ANY ERRORS OR OMISSIONS WHICH MAY BE INCORPORATED HEREIN AS A RESULT.

GRW
 engineering | architecture | geospatial
 www.grwinc.com
 ENGINEER/ARCHITECT: David C. Osborne
 CONSTRUCTION COMPANY: Dugan & Meyers
 DATE: 4/23/19

GRW PROJECT NO. 4384	CLIENT PROJECT NO.	ALL RIGHTS RESERVED. THE LIABILITY OF GRW ENGINEERS, INC. AND SHALL NOT BE REPRODUCED IN WHOLE OR IN PART WITHOUT WRITTEN PERMISSION FROM GRW ENGINEERS, INC.	
		www.grwinc.com	
BELT FILTER PRESS REPLACEMENT DEMOLITION PLAN			
TAYLOR MILL TREATMENT PLANT NORTHERN KENTUCKY WATER DISTRICT			
DESIGNED	JDR	DRAWN	JDR
REVIEWED	JKP	APPROVED	JKP
NO.	DATE	DESCRIPTION	SCALE CHECK
DATE: APRIL, 2019			SCALE: 1/4" = 1'-0"
SHEET NO. A-101			THIS MARK SHOULD MEASURE EXACTLY 1" WHEN PLOTTED

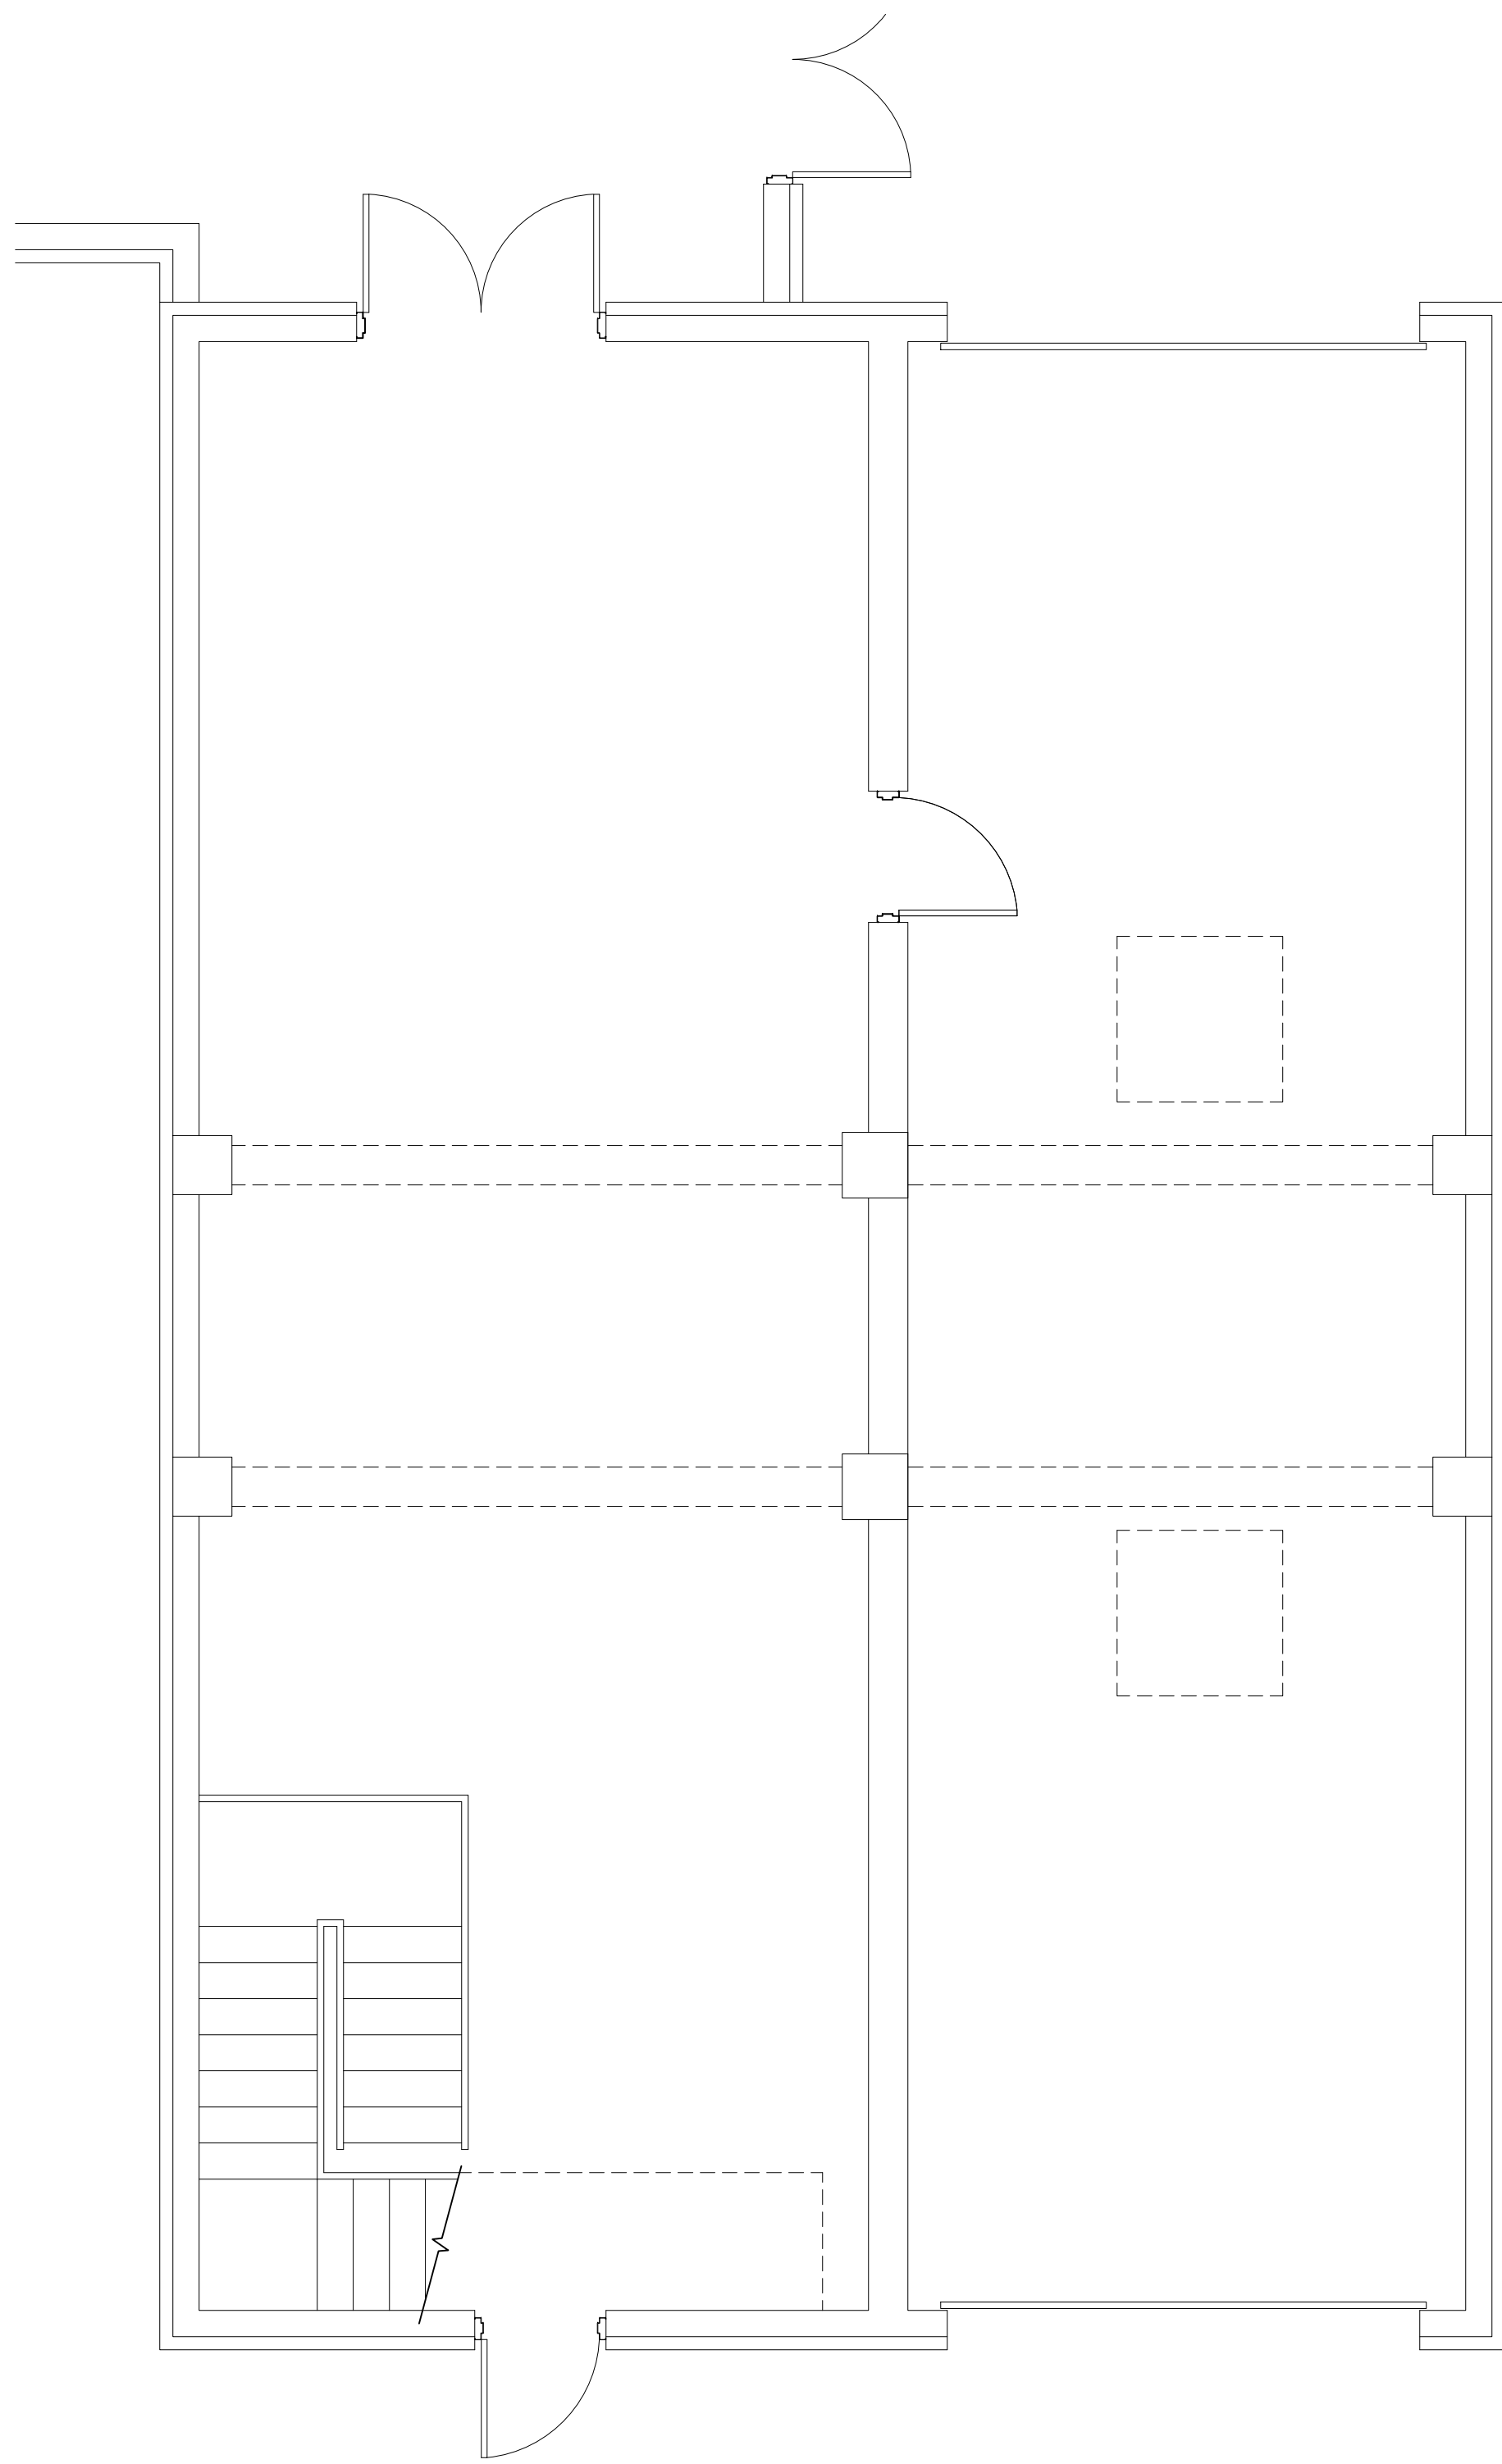

1 1st FLOOR CONST. PLAN
SCALE: 1/4"=1'-0"
PLAN NORTH

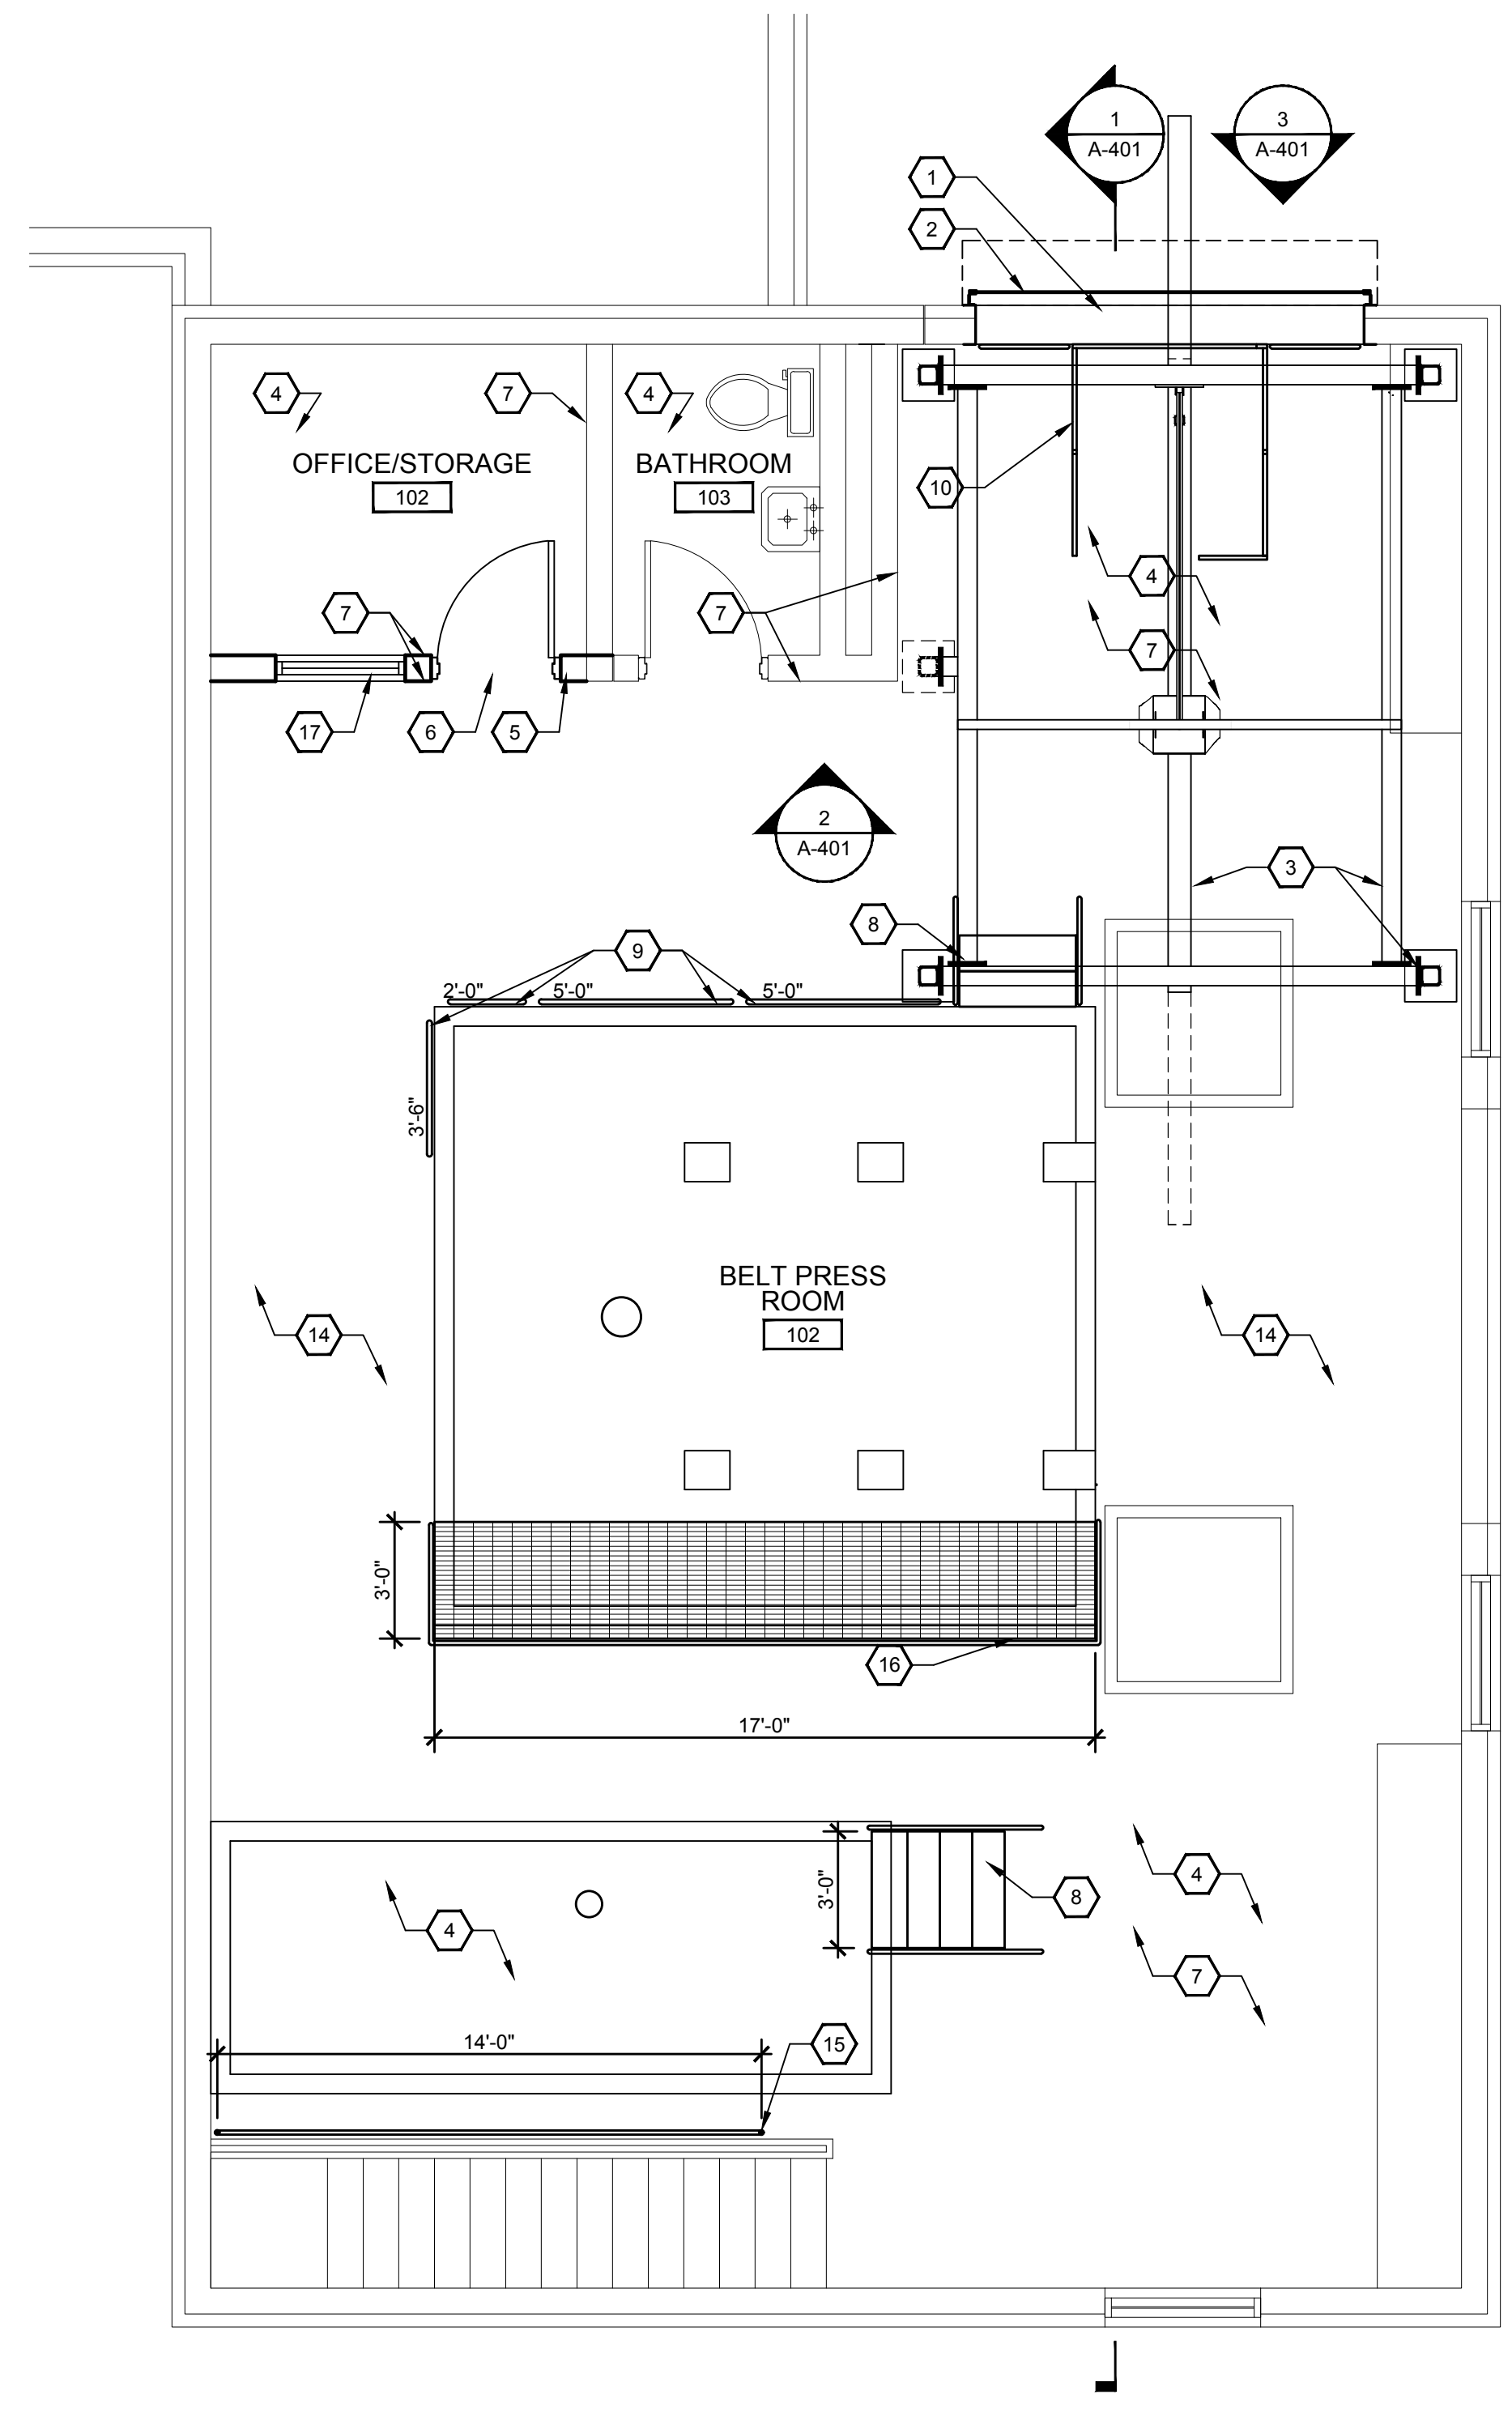

2 2nd FLOOR CONST. PLAN
SCALE: 1/4"=1'-0"
PLAN NORTH

- CONSTRUCTION KEYNOTES:**
- 1 OPENING FOR OVERHEAD DOOR.
 - 2 10'W x 12'-8"H OVERHEAD COILING DOOR.
 - 3 HOIST SYSTEM - SEE STRUCTURAL.
 - 4 ALL EXISTING FLOORS AND CONCRETE CURB AREAS TO BE FINISHED IN ACCORDANCE WITH SPECIFICATION SECTION 099600.
 - 5 NEW 8" CMU WALL. TOOTH NEW CMU INTO EXISTING WALL. PROVIDE 2'-0"x4'-0" ALUMINUM LOUVERED OPENING NEAR TOP. SEE 2/A-401.
 - 6 NEW 3'-0" x 7'-0" PAINTED METAL DOOR AND FRAME. PROVIDE LEVER HANDLE WITH PASSAGE TYPE HARDWARE. SEE DETAILS ON A-501.
 - 7 PAINT WALLS & PROVIDE TOUCH-UP PAINTING TO MATCH ADJACENT PAINT WHERE FINISH IS DAMAGED OR EQUIPMENT HAS BEEN REMOVED.
 - 8 ALUMINUM STAIRS AND HANDRAILS - SEE DETAIL 4/A-401.
 - 9 REMOVABLE RAILING - SEE DETAIL 7&8/A-501.
 - 10 MZ SERIES CLEAR HEIGHT MEZZANINE SAFETY GATES
 - 11 RELOCATE EXISTING HEATER TO AVOID HOIST STRUCTURE.
 - 12 RETRACTABLE BEAM OPERATOR - SEE SPECIFICATION 083610 - CHAIN DRIVE OPENER.
 - 13 PALLET LIFT - LOW-HEIGHT 'H' FRAME 4 POINT PALLET LIFTING BEAM WITH PALLET LIFTING BARS AND CABLES.
 - 14 PATCH & PAINT ANY PENETRATIONS CREATED FROM REMOVAL OF DEMO'D ITEMS - TYPICAL. REFER TO SPECIFICATION 017329-CUTTING AND PATCHING.
 - 15 ALUMINUM POST AND CHAIN LINK SAFETY FENCE. SECURE TO CONCRETE FLOOR AND CEILING WITH MESH TO RUN FULL HEIGHT.
 - 16 * ALUMINUM MEZZANINE AND LADDER.
 - 17 3'-4"Wx3'-0"H METAL FRAMED WINDOW. SEE A-401 FOR DETAILS.

- CONSTRUCTION GENERAL NOTES:**
1. NOTES, DIMENSIONS, ETC. TAKEN FROM EXISTING AS-BUILT PLANS. CONTRACTOR SHALL FIELD VERIFY.
 2. ROOM NUMBERS NOTED ON DRAWING ARE FOR DOCUMENT COORDINATION ONLY. ROOM NUMBERS NOTED ON DRAWINGS MAY NOT REFLECT THE ROOM NUMBERS ON SITE.
 3. THE CONDITION OF EACH KEYNOTED ITEM WAS GENERALLY SURVEYED. WORK REQUIRED IS GENERALLY INDICATED BUT DOES NOT INCLUDE ALL CONDITIONS EITHER SEEN OR UNSEEN. IT SHALL BE THE RESPONSIBILITY OF THE CONTRACTOR TO VISIT THE JOBSITE TO DETERMINE THE ACTUAL SCOPE OF EACH ITEM, ITEMS NOT LISTED, AND THE TOTAL WORK REQUIRED TO COMPLETE WORK TO A FINISHED CONDITION.
 4. CONTRACTOR TO COORDINATE WORK WITH OTHER TRADES. PATCH AND REPAIR WORK TO COMMENCE ONLY AFTER INSTALLATION WORK HAS BEEN COMPLETED.
 5. FIRST FLOOR PLAN SHOWN FOR REFERENCE ONLY. NO ARCHITECTURAL FINISHES WORK THIS FLOOR.
- * MEZZANINE - 3'Wx17'Lx5'-10"H ALUMINUM CONSTRUCTION, DESIGNATED DESIGN BY MANUFACTURER. REFER TO SPEC SECTIONS 055202-ALUMINUM HANDRAILS AND RAILINGS AND 055300-ALUMINUM GRATING FOR MATCHING MATERIAL TYPES TO BE INCLUDED. CONSTRUCTION TO BE COMPLIANT WITH ALL APPLICABLE CODES.

RECORD DOCUMENTS

GRW PROJECT NO. 4384

CLIENT PROJECT NO.

ALL RIGHTS RESERVED. THIS DOCUMENT IS THE PROPERTY OF GRW ENGINEERS, INC. AND SHALL NOT BE REPRODUCED IN WHOLE OR IN PART WITHOUT WRITTEN PERMISSION FROM GRW ENGINEERS, INC.

www.grwinc.com

engineering | architecture | geospatial

Belt Filter Press Replacement Construction Plan

Taylor Mill Treatment Plant

Northern Kentucky Water District

DESIGNED	JDR
DRAWN	JDR
REVIEWED	JKP
APPROVED	JKP

NO.	DATE	DESCRIPTION

DATE: APRIL, 2019


SCALE: 1/4" = 1'-0"

SHEET NO. A-102

DATE: 4/23/19

THIS RECORD DOCUMENT HAS BEEN PREPARED BASED ON INFORMATION PROVIDED BY THE CONSTRUCTION CONTRACTOR. GRW ENGINEERS, INC. HAS ATTEMPTED TO VERIFY THE ACCURACY AND/OR COMPLETENESS OF THIS INFORMATION BUT SHALL NOT BE RESPONSIBLE FOR ANY ERRORS OR OMISSIONS WHICH MAY BE INCORPORATED HEREIN AS A RESULT.

engineering | architecture | geospatial
www.grwinc.com
ENGINEER/ARCHITECT: David C. Osborne
CONSTRUCTION COMPANY: Dugan & Meyers

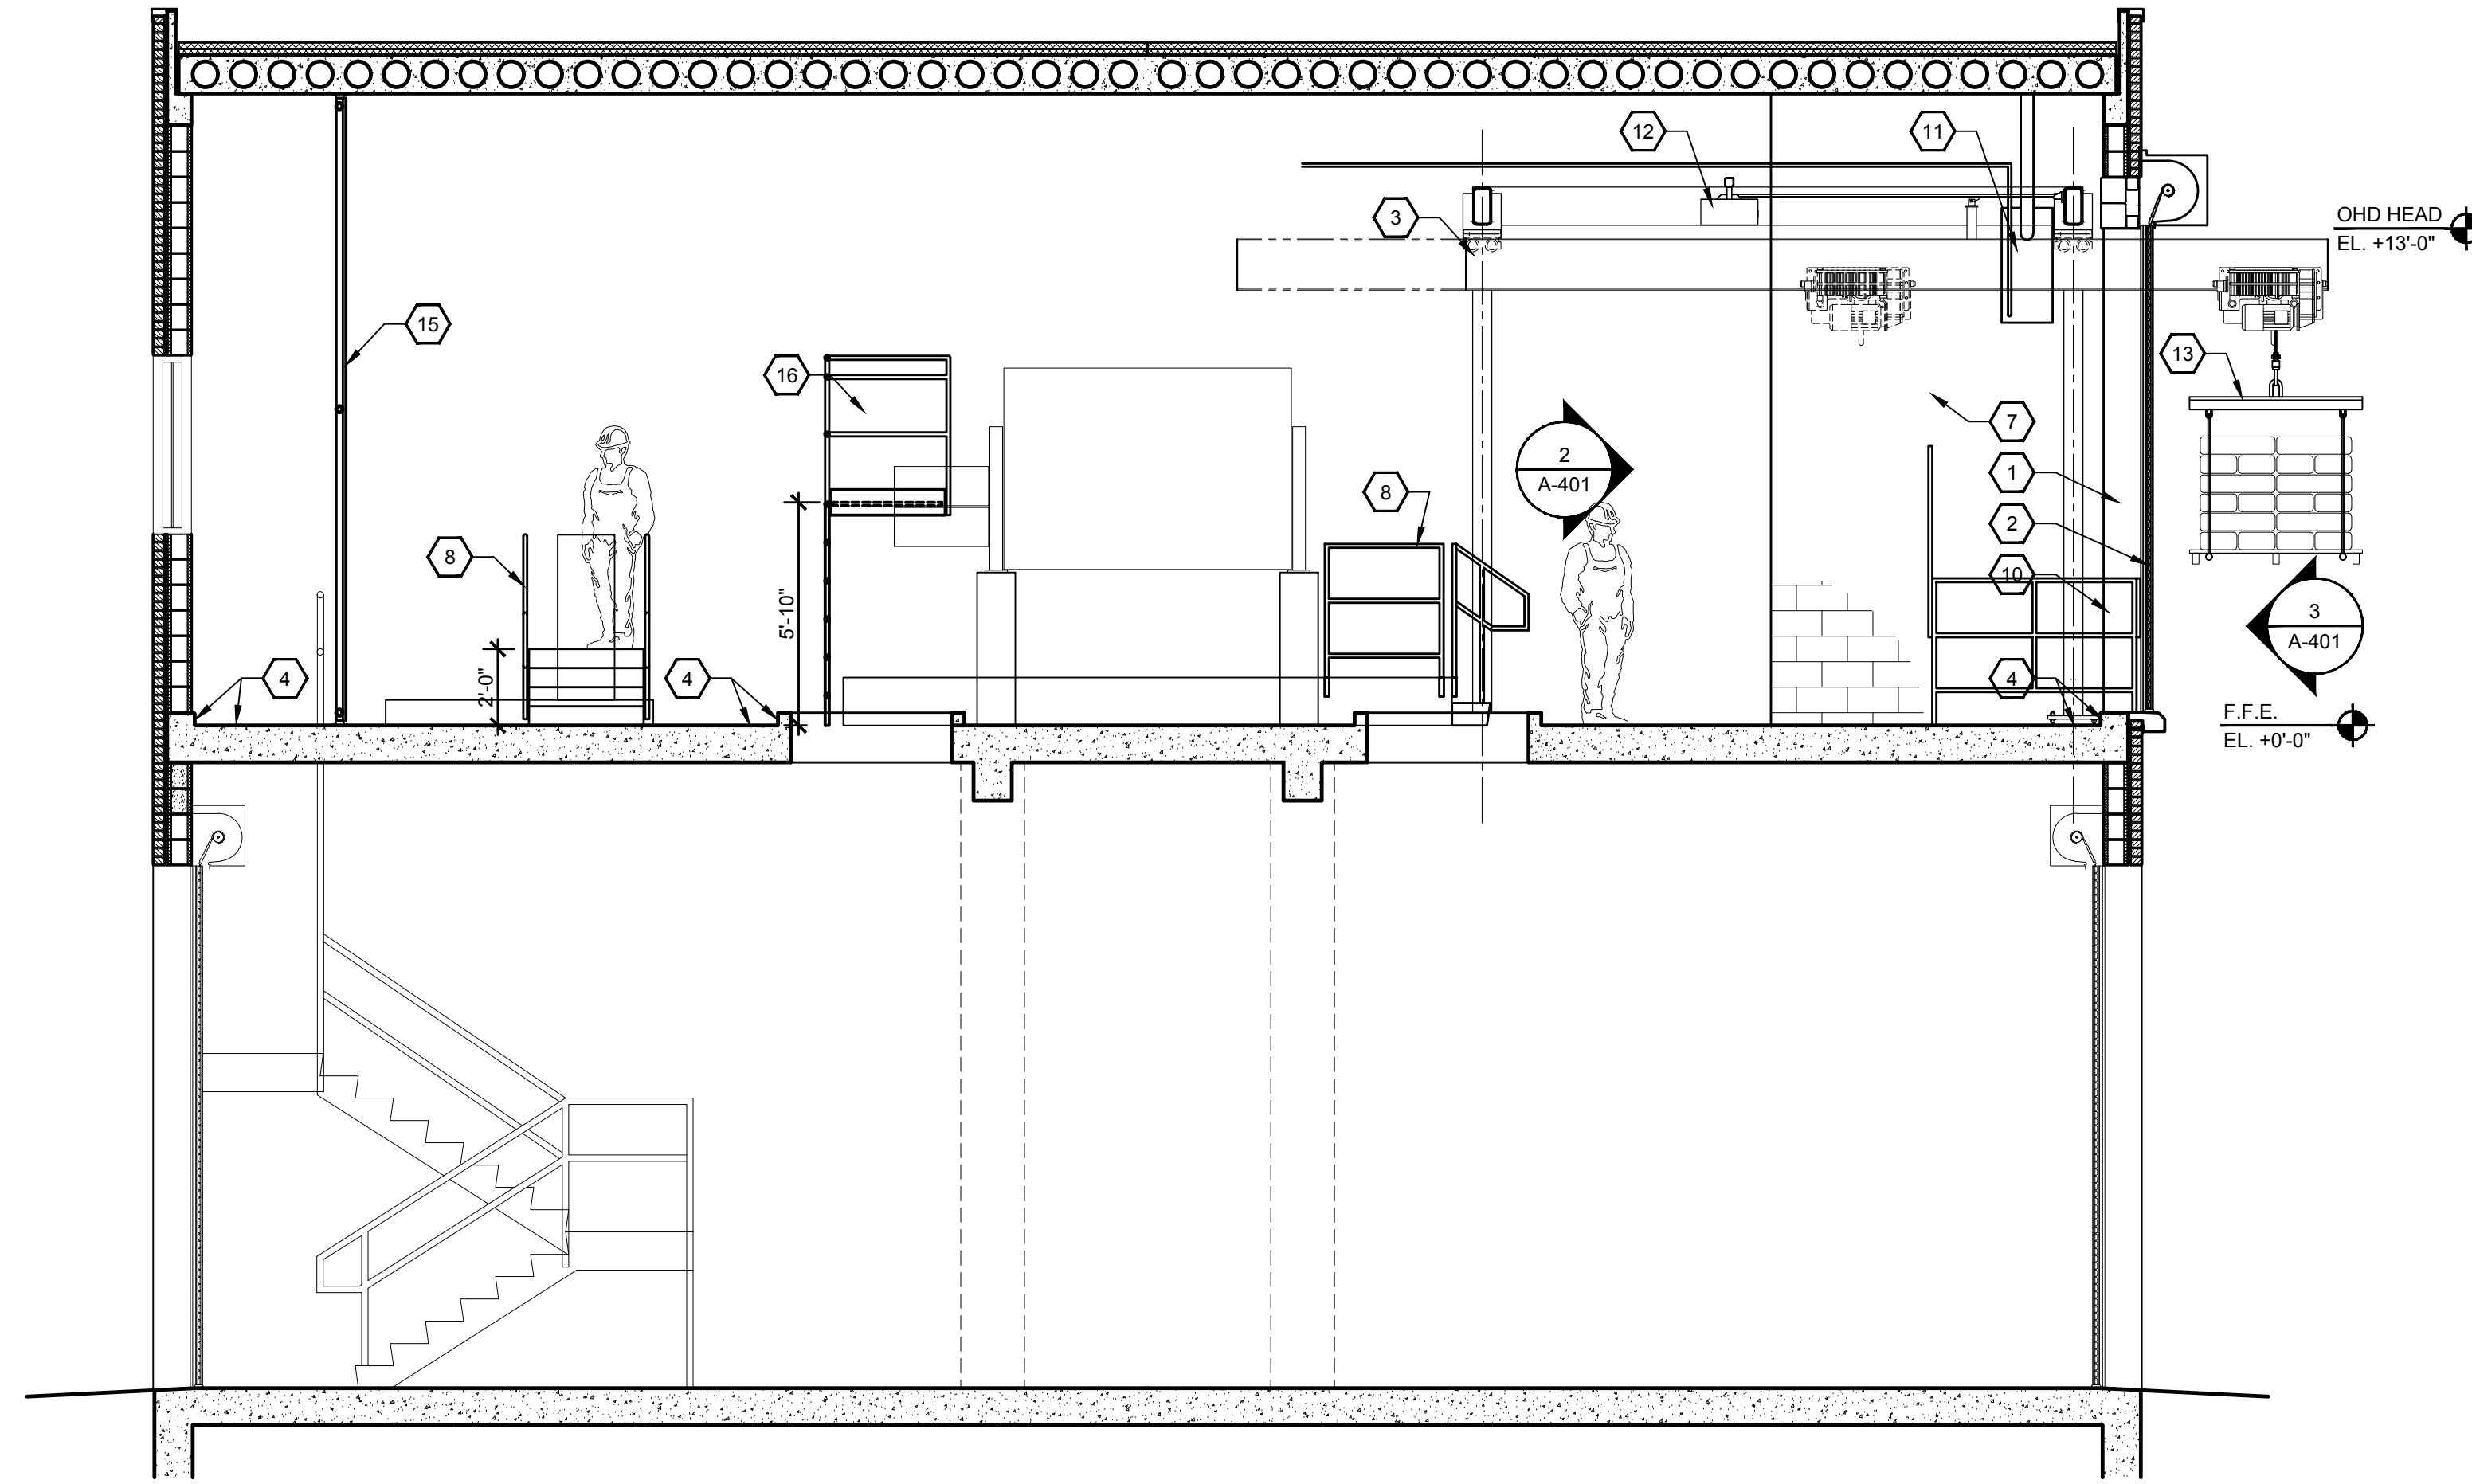


1 BUILDING SECTION
SCALE: 1/4"=1'-0"


- CONSTRUCTION KEYNOTES:**
- 1 OPENING FOR OVERHEAD DOOR.
 - 2 10'W x 12'-8"H OVERHEAD COILING DOOR.
 - 3 HOIST SYSTEM - SEE STRUCTURAL.
 - 4 ALL EXISTING FLOORS AND CONCRETE CURB AREAS TO BE FINISHED IN ACCORDANCE WITH SPECIFICATION SECTION 099600.
 - 5 NEW 8" CMU WALL. TOOTH NEW CMU INTO EXISTING WALL. PROVIDE 2'-0"x4'-0" ALUMINUM LOUVERED OPENING NEAR TOP. SEE 2/A-401.
 - 6 NEW 3'-0" x 7'-0" PAINTED METAL DOOR AND FRAME. PROVIDE LEVER HANDLE WITH PASSAGE TYPE HARDWARE. SEE DETAILS ON A-501.
 - 7 PAINT WALLS & PROVIDE TOUCH-UP PAINTING TO MATCH ADJACENT PAINT WHERE FINISH IS DAMAGED OR EQUIPMENT HAS BEEN REMOVED.
 - 8 ALUMINUM STAIRS AND HANDRAILS - SEE DETAIL 4/A-401.
 - 9 REMOVABLE RAILING - SEE DETAIL 7&8/A-501.
 - 10 MZ SERIES CLEAR HEIGHT MEZZANINE SAFETY GATES
 - 11 RELOCATE EXISTING HEATER TO AVOID HOIST STRUCTURE.
 - 12 RETRACTABLE BEAM OPERATOR - SEE SPECIFICATION 083610 - CHAIN DRIVE OPENER.
 - 13 PALLET LIFT - LOW-HEIGHT "H" FRAME 4 POINT PALLET LIFTING BEAM WITH PALLET LIFTING BARS AND CABLES.
 - 14 PATCH & PAINT ANY PENETRATIONS CREATED FROM REMOVAL OF DEMO'D ITEMS - TYPICAL. REFER TO SPECIFICATION 017329-CUTTING AND PATCHING.
 - 15 ALUMINUM POST AND CHAIN LINK SAFETY FENCE. SECURE TO CONCRETE FLOOR AND CEILING WITH MESH TO RUN FULL HEIGHT.
 - 16 * ALUMINUM MEZZANINE AND LADDER.
 - 17 3'-4"Wx3'-0"H METAL FRAMED WINDOW. SEE A-401 FOR DETAILS.

- CONSTRUCTION GENERAL NOTES:**
1. NOTES, DIMENSIONS, ETC. TAKEN FROM EXISTING AS-BUILT PLANS. CONTRACTOR SHALL FIELD VERIFY.
 2. ROOM NUMBERS NOTED ON DRAWING ARE FOR DOCUMENT COORDINATION ONLY. ROOM NUMBERS NOTED ON DRAWINGS MAY NOT REFLECT THE ROOM NUMBERS ON SITE.
 3. THE CONDITION OF EACH KEYNOTED ITEM WAS GENERALLY SURVEYED. WORK REQUIRED IS GENERALLY INDICATED BUT DOES NOT INCLUDE ALL CONDITIONS EITHER SEEN OR UNSEEN. IT SHALL BE THE RESPONSIBILITY OF THE CONTRACTOR TO VISIT THE JOBSITE TO DETERMINE THE ACTUAL SCOPE OF EACH ITEM, ITEMS NOT LISTED, AND THE TOTAL WORK REQUIRED TO COMPLETE WORK TO A FINISHED CONDITION.
 4. CONTRACTOR TO COORDINATE WORK WITH OTHER TRADES. PATCH AND REPAIR WORK TO COMMENCE ONLY AFTER INSTALLATION WORK HAS BEEN COMPLETED.
 5. FIRST FLOOR PLAN SHOWN FOR REFERENCE ONLY. NO ARCHITECTURAL FINISHES WORK THIS FLOOR.


* MEZZANINE - 3"Wx17'Lx5'-10"H ALUMINUM CONSTRUCTION. DESIGNATED DESIGN BY MANUFACTURER. REFER TO SPEC SECTIONS 055202-ALUMINUM HANDRAILS AND RAILINGS AND 055300-ALUMINUM GRATING FOR MATCHING MATERIAL TYPES TO BE INCLUDED. CONSTRUCTION TO BE COMPLIANT WITH ALL APPLICABLE CODES.

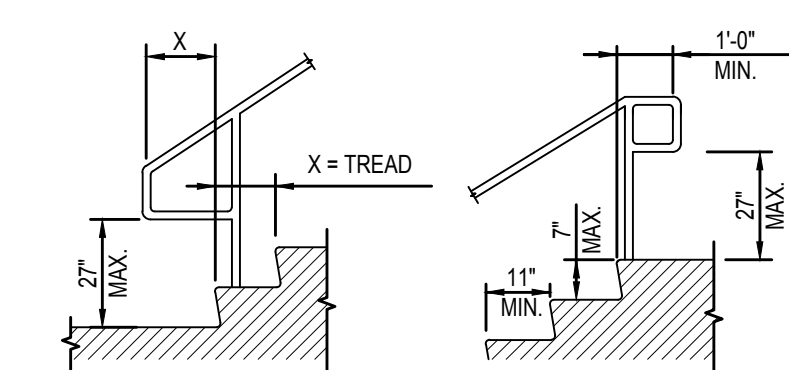

4 STAIR DETAILS
NOT TO SCALE

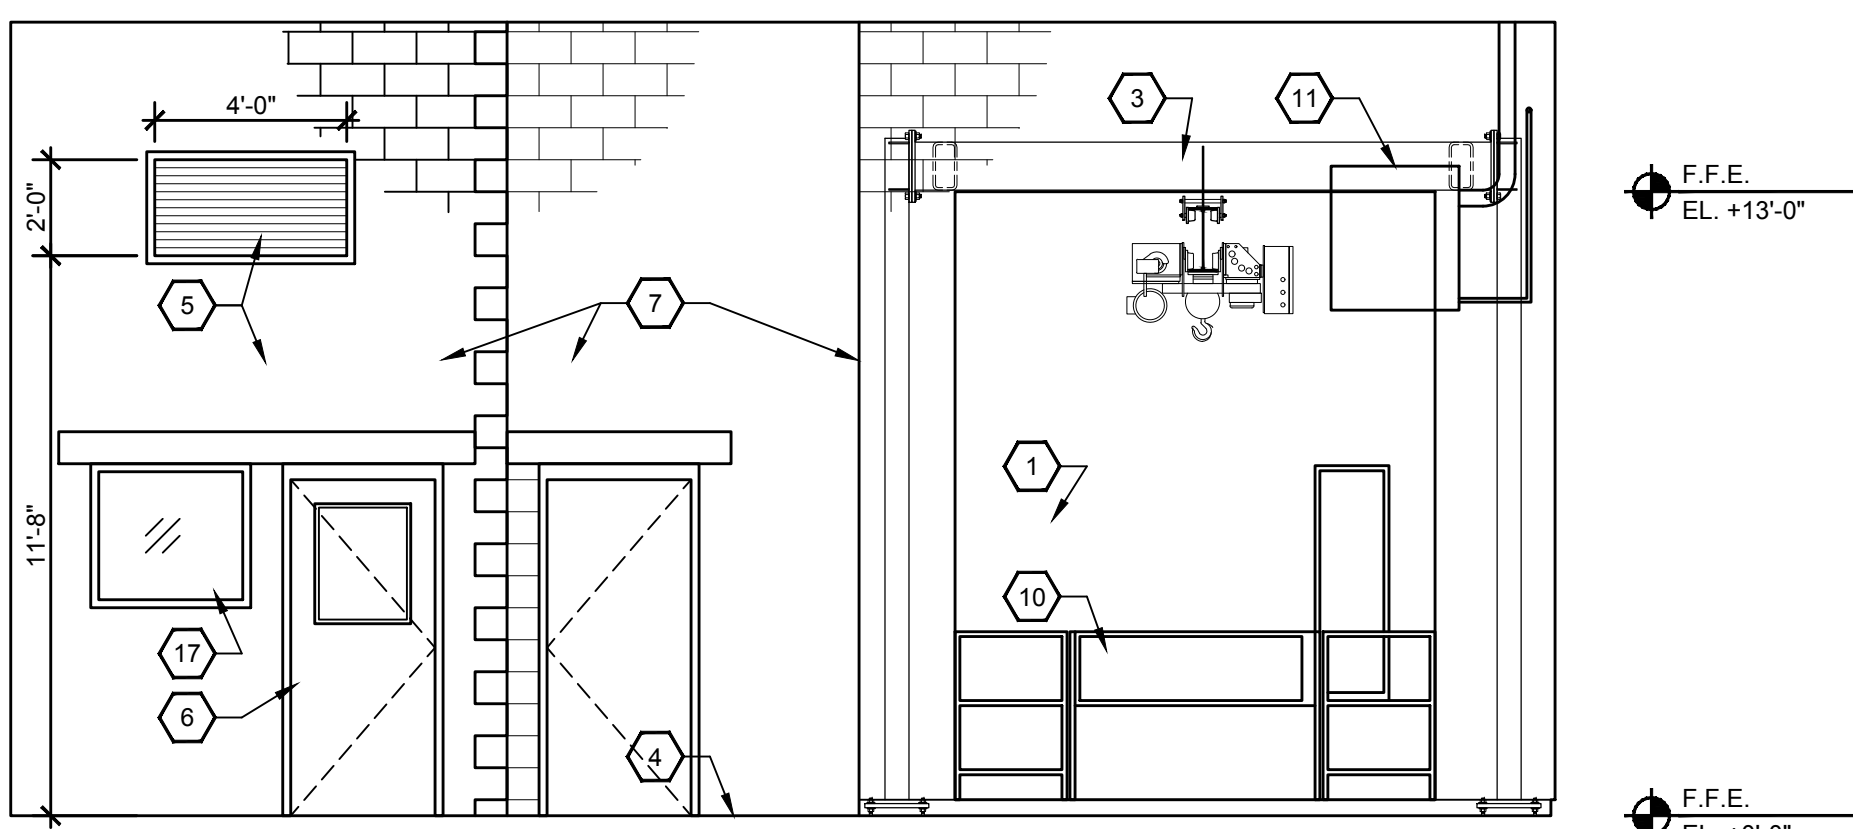


2 INTERIOR ELEVATION
SCALE: 1/4"=1'-0"

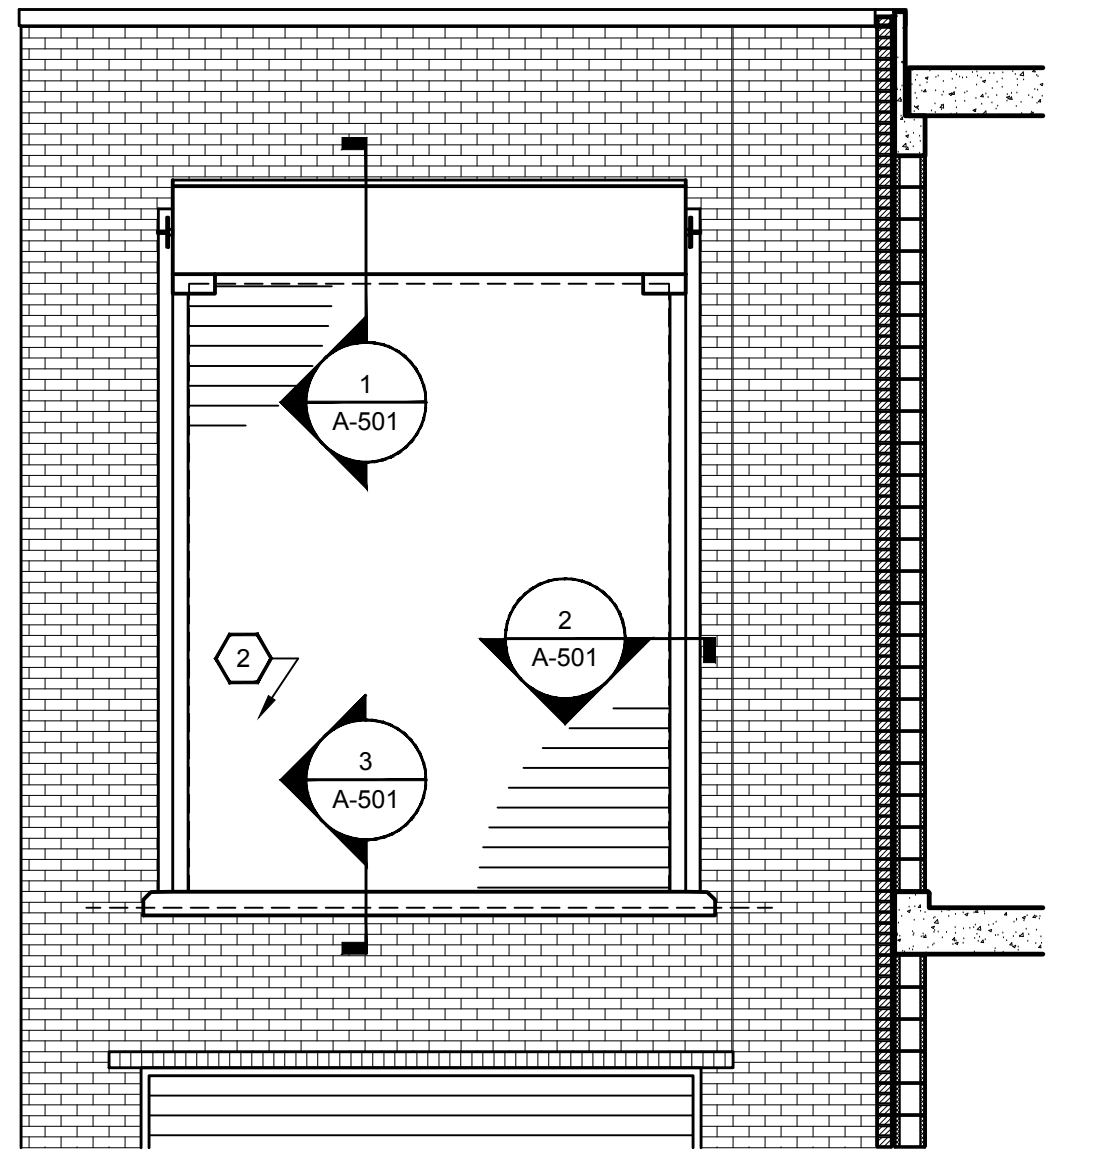


3 EXTERIOR ELEVATION
SCALE: 1/4"=1'-0"

THIS RECORD DOCUMENT HAS BEEN PREPARED BASED ON INFORMATION PROVIDED BY THE CONSTRUCTION CONTRACTOR. GRW ENGINEERS, INC. HAS ATTEMPTED TO VERIFY THE ACCURACY AND/OR COMPLETENESS OF THIS INFORMATION BUT SHALL NOT BE RESPONSIBLE FOR ANY ERRORS OR OMISSIONS WHICH MAY BE INCORPORATED HEREIN AS A RESULT.


engineering | architecture | geospatial
www.grwinc.com
ENGINEER/ARCHITECT: David C. Osborne
CONSTRUCTION COMPANY: Dugan & Meyers
DATE: 4/23/19

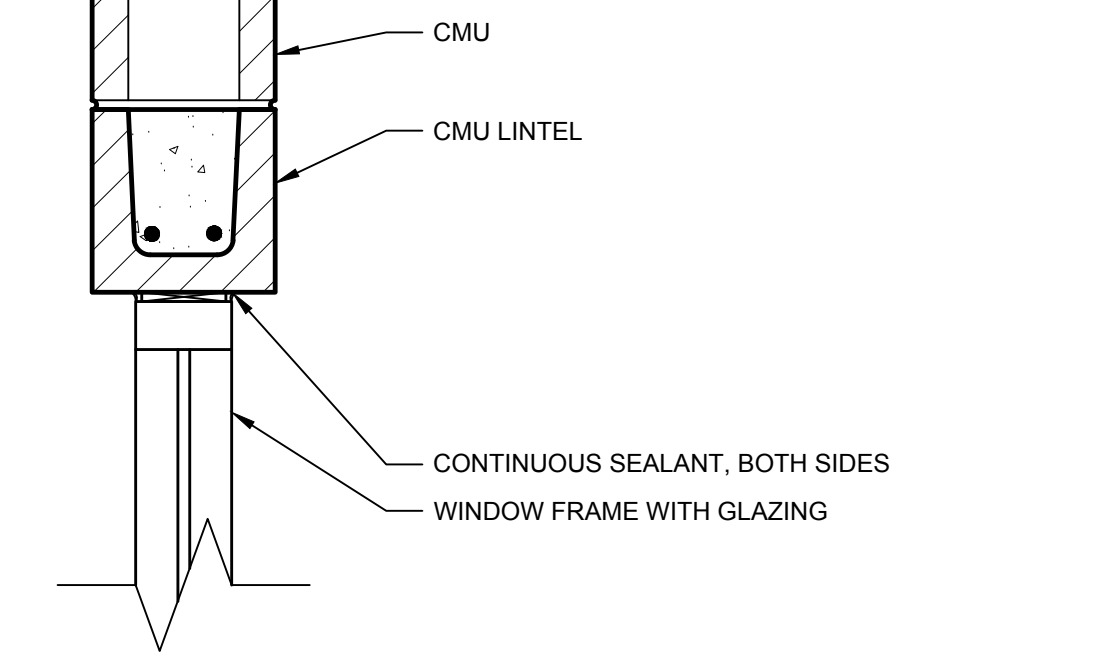

5 INTERIOR CMU WALL WINDOW HEAD DETAIL
SCALE: 1 1/2"=1'-0"

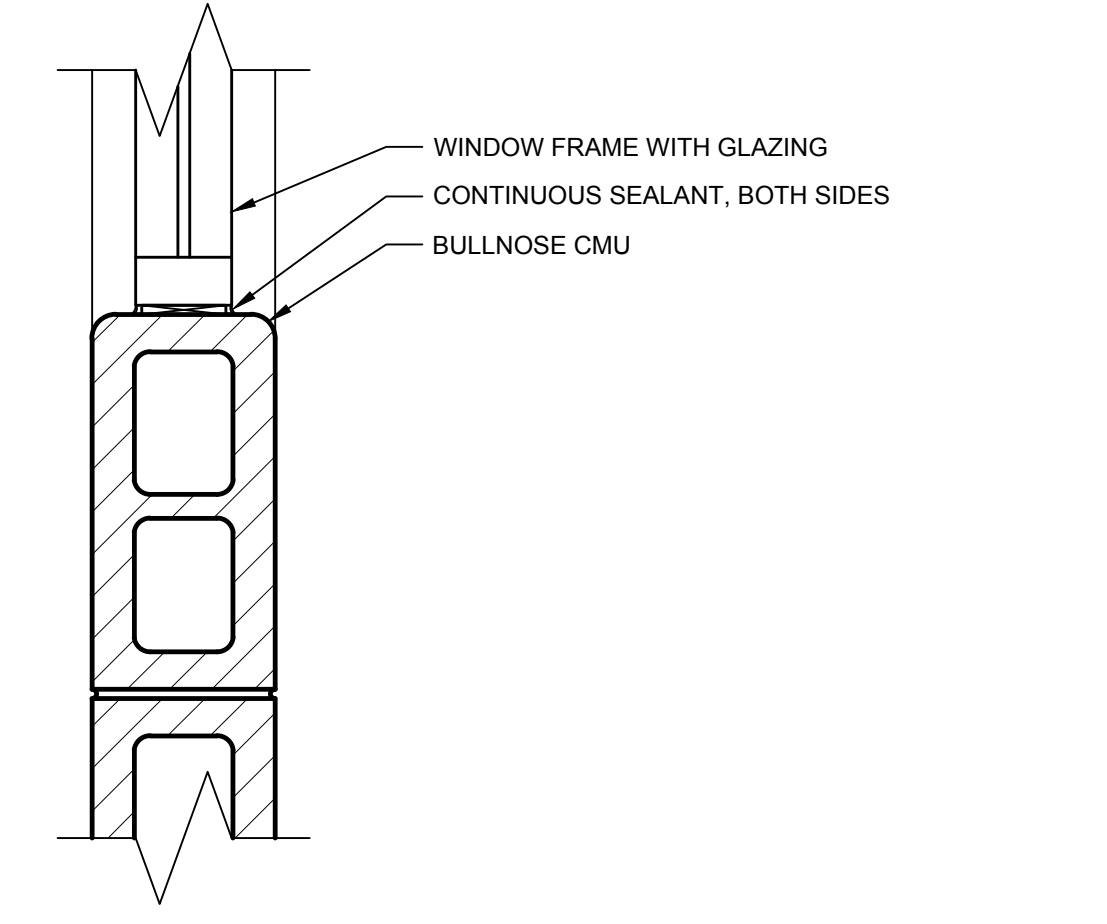

6 INTERIOR CMU WALL WINDOW JAMB DETAIL
SCALE: 1 1/2"=1'-0"

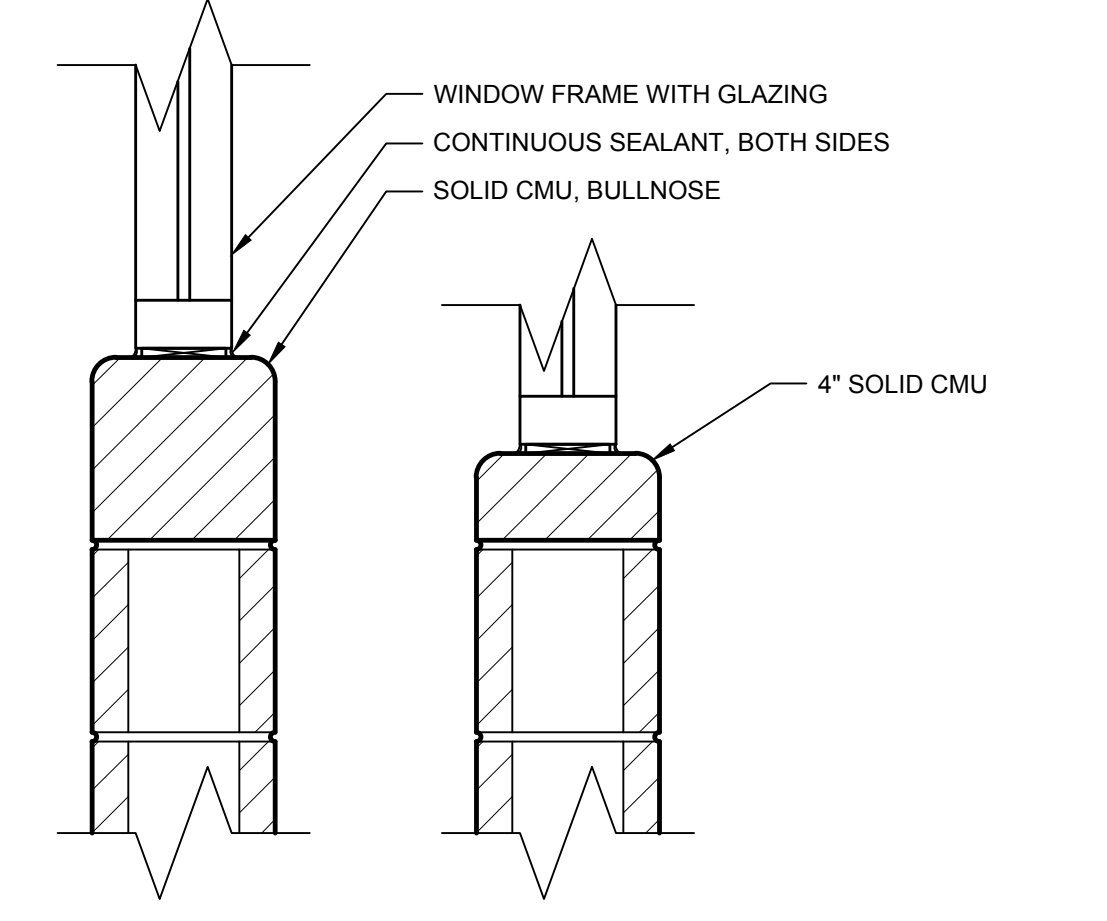

7 INTERIOR CMU WALL WINDOW SILL DETAIL
SCALE: 1 1/2"=1'-0"

RECORD DOCUMENTS

GRW PROJECT NO. 4384

CLIENT PROJECT NO.

ALL RIGHTS RESERVED. NO PART OF THIS DOCUMENT IS TO BE REPRODUCED IN WHOLE OR IN PART WITHOUT THE WRITTEN PERMISSION OF GRW ENGINEERS, INC. AND SHALL NOT BE USED FOR ANY OTHER PROJECT OTHER THAN THIS SPECIFIC PROJECT WITHOUT WRITTEN PERMISSION.

engineering | architecture | geospatial
www.grwinc.com

BELT FILTER PRESS REPLACEMENT SECTIONS AND ELEVATIONS

TAYLOR MILL TREATMENT PLANT
NORTHERN KENTUCKY WATER DISTRICT

DESIGNED	JDR	DRAWN	JDR	REVIEWED	JKP	APPROVED	JKP
DATE		DATE		DATE		DATE	

REVISIONS

NO.	DESCRIPTION	DATE	BY


SCALE CHECK: THIS MARK SHOULD MEASURE EXACTLY 1" WHEN PLOTTED

DATE: APRIL, 2019
SCALE: 1/4" = 1'-0"
SHEET NO. **A-401**


PLOTTED BY: mwilliamson

PRINTED: 4/23/2019 @ 2:30PM


FILE NAME: U:\4384-NKWD-TMTP-BFP-Working Drawings\AutoCAD\4384-A-501.dwg

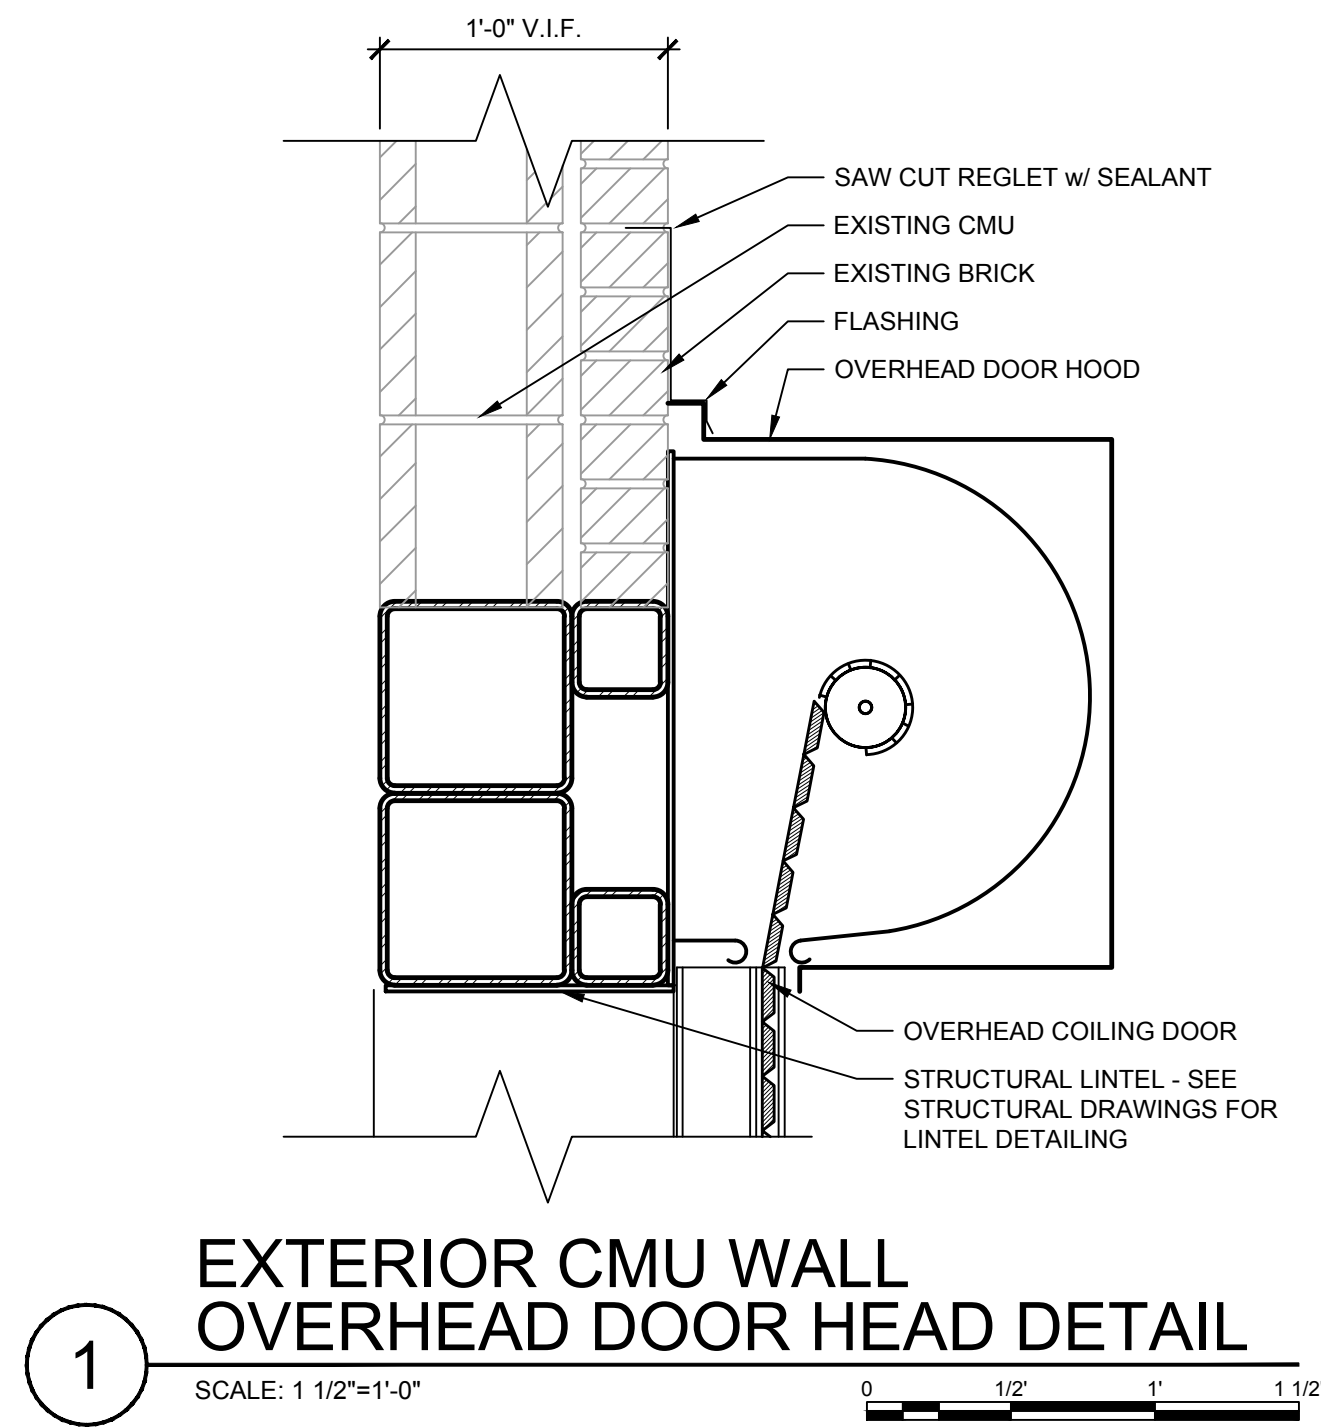


1 EXTERIOR CMU WALL OVERHEAD DOOR HEAD DETAIL
SCALE: 1 1/2"=1'-0"

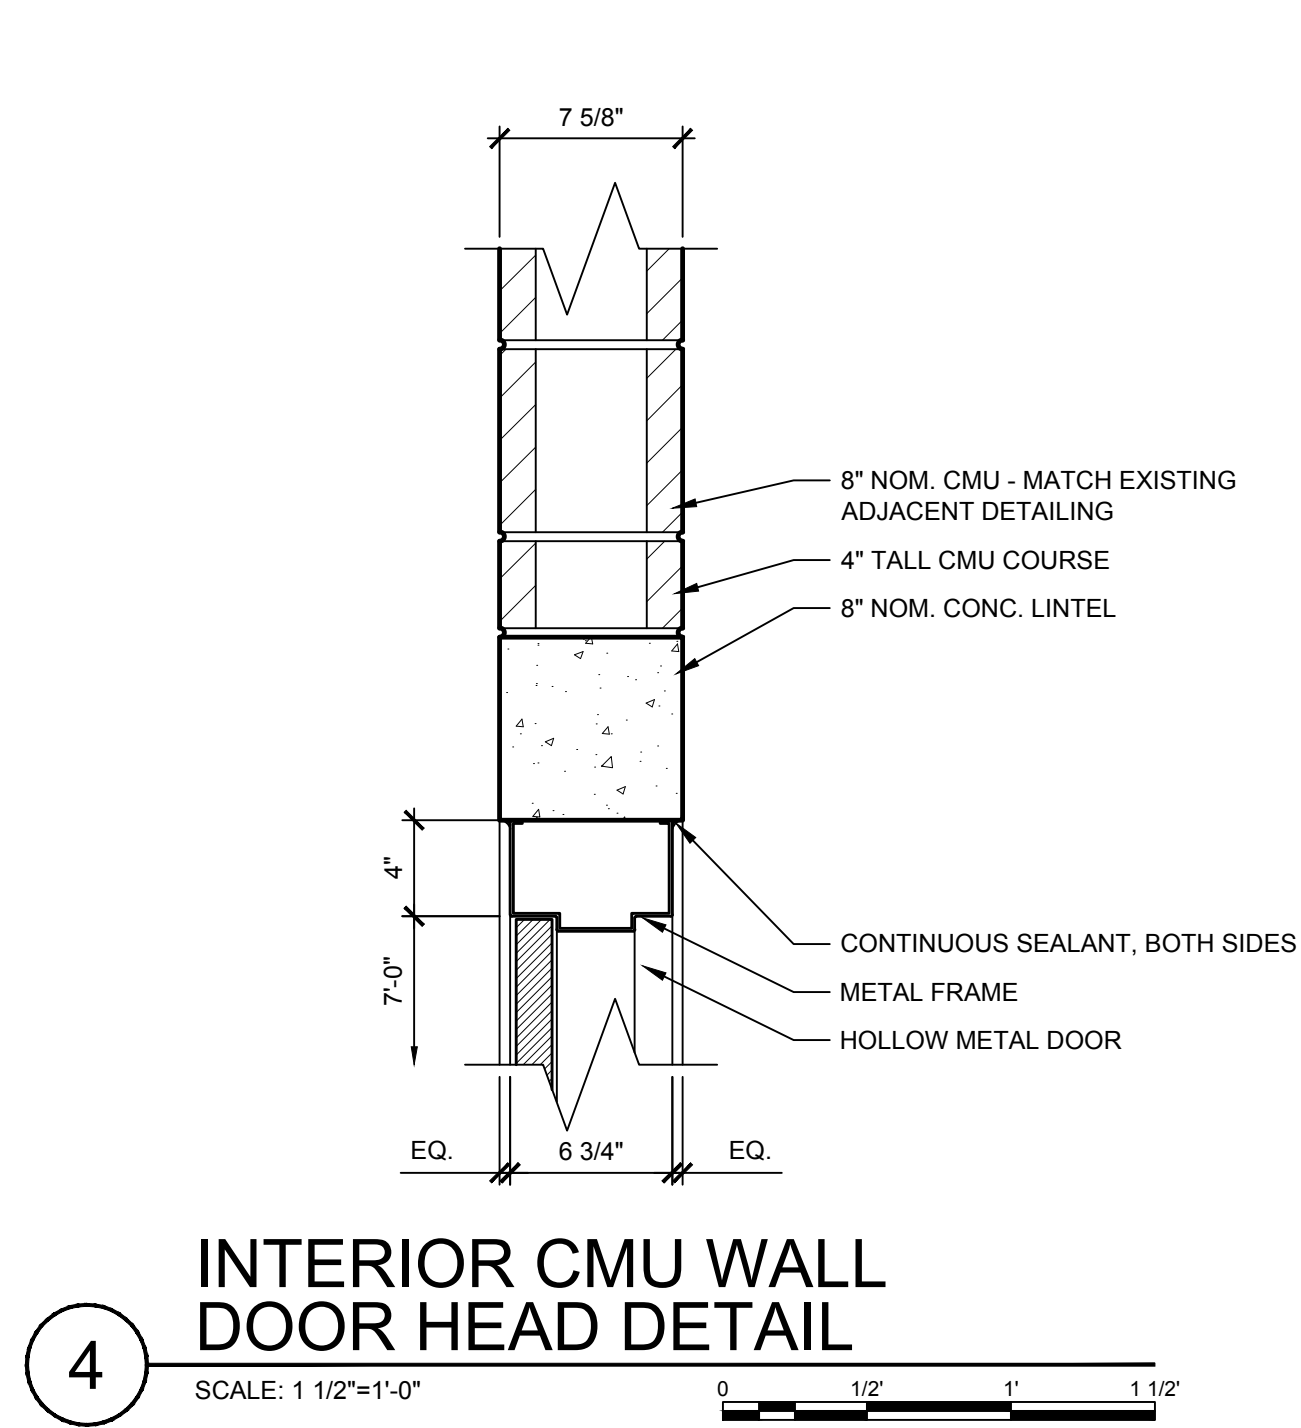


4 INTERIOR CMU WALL DOOR HEAD DETAIL
SCALE: 1 1/2"=1'-0"

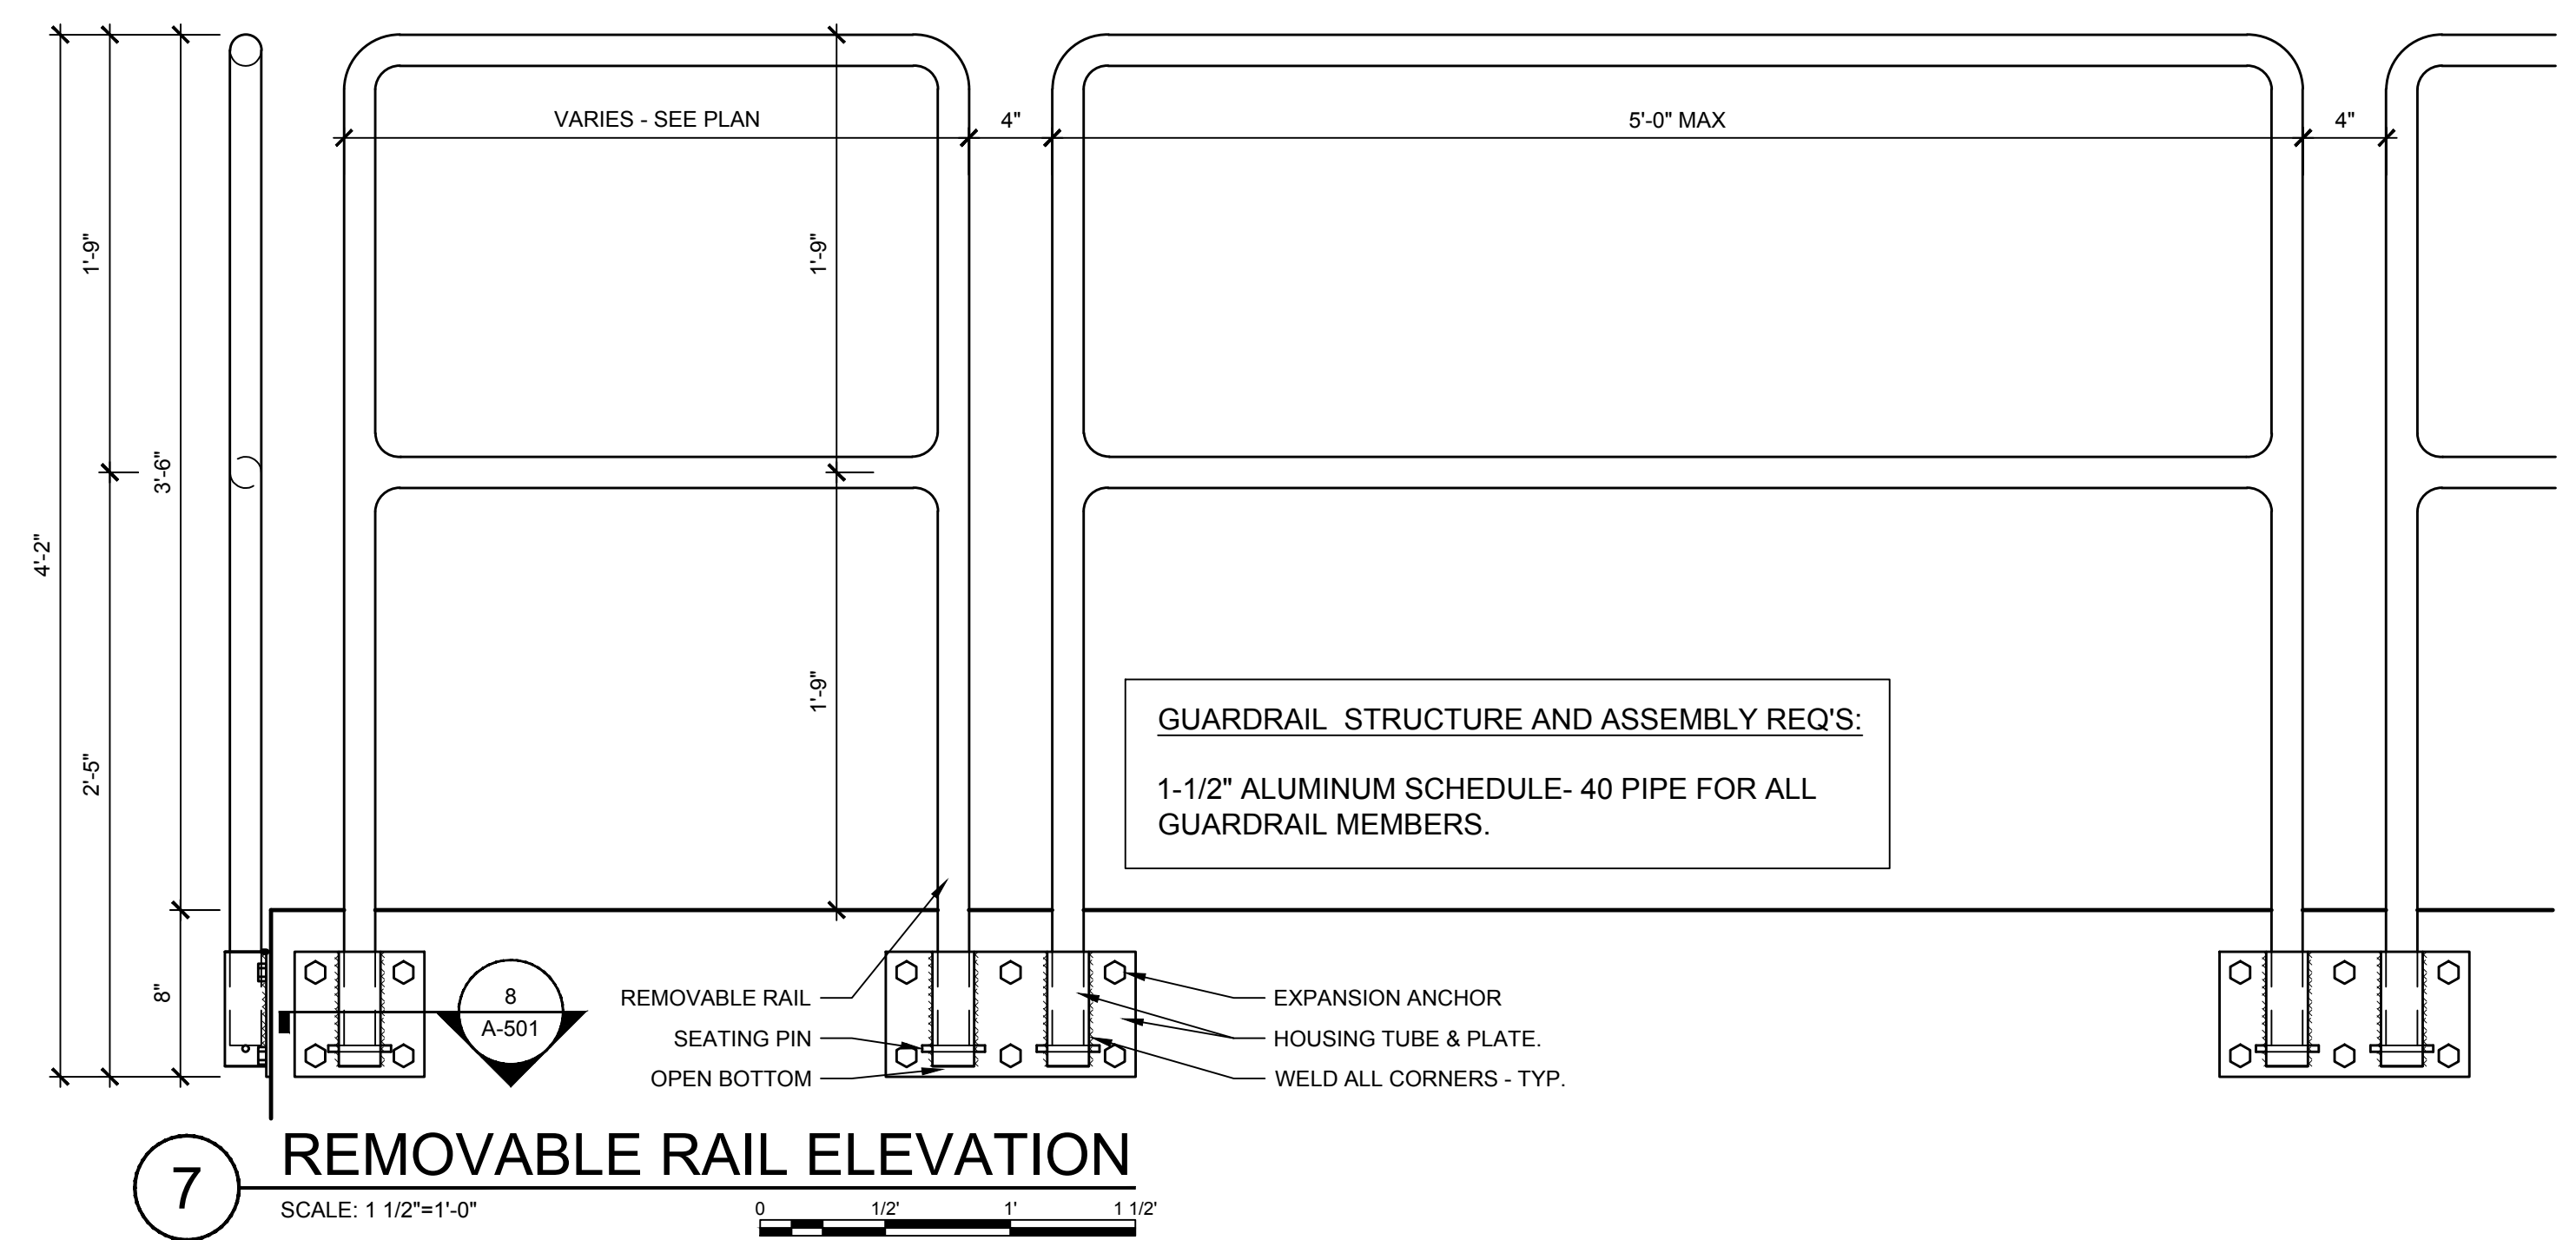


7 REMOVABLE RAIL ELEVATION
SCALE: 1 1/2"=1'-0"

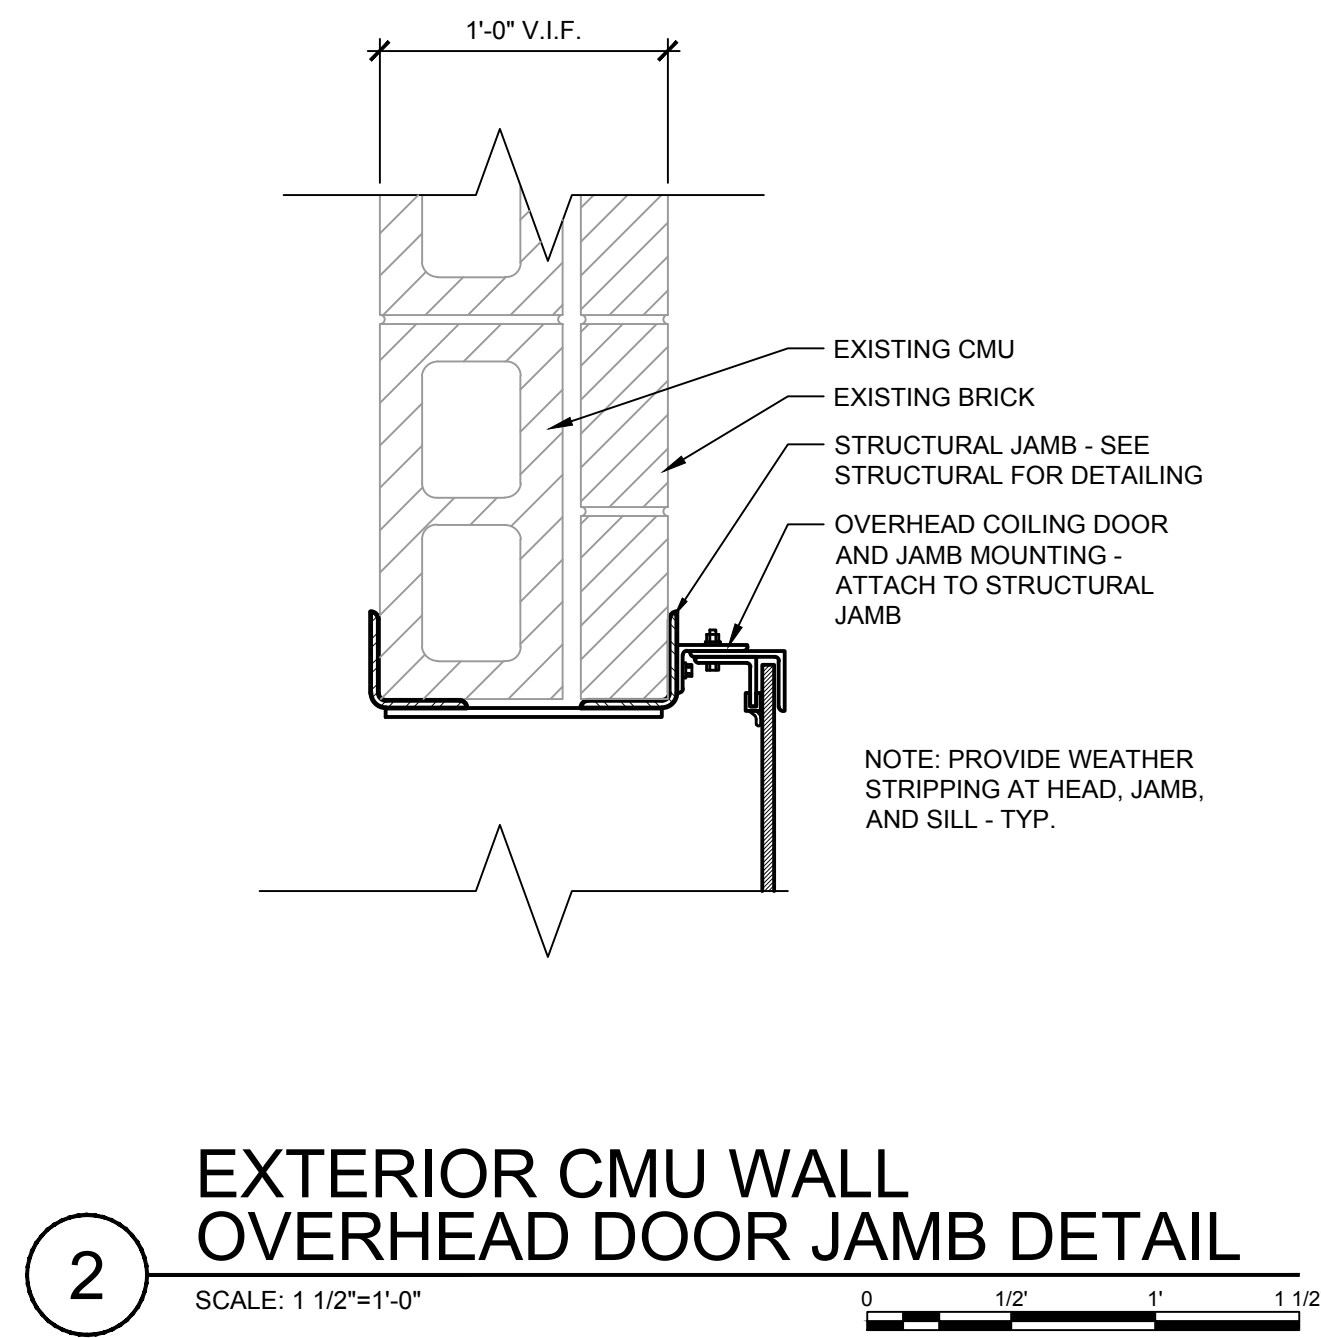


2 EXTERIOR CMU WALL OVERHEAD DOOR JAMB DETAIL
SCALE: 1 1/2"=1'-0"

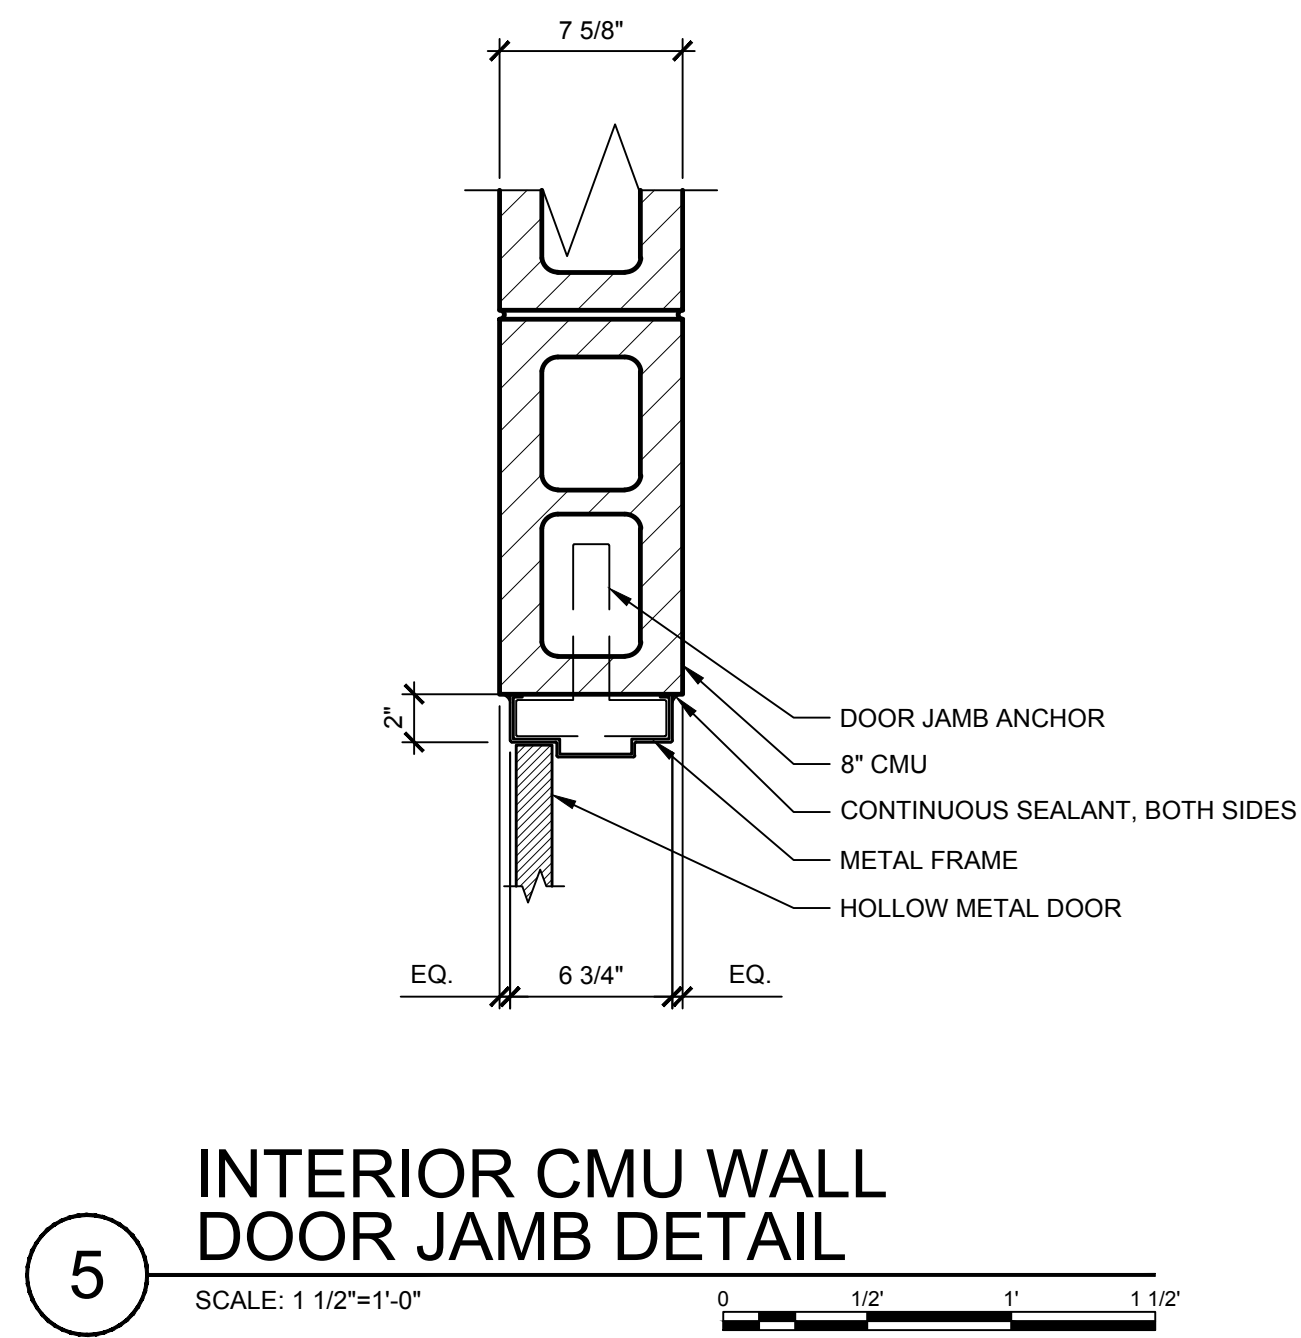


5 INTERIOR CMU WALL DOOR JAMB DETAIL
SCALE: 1 1/2"=1'-0"

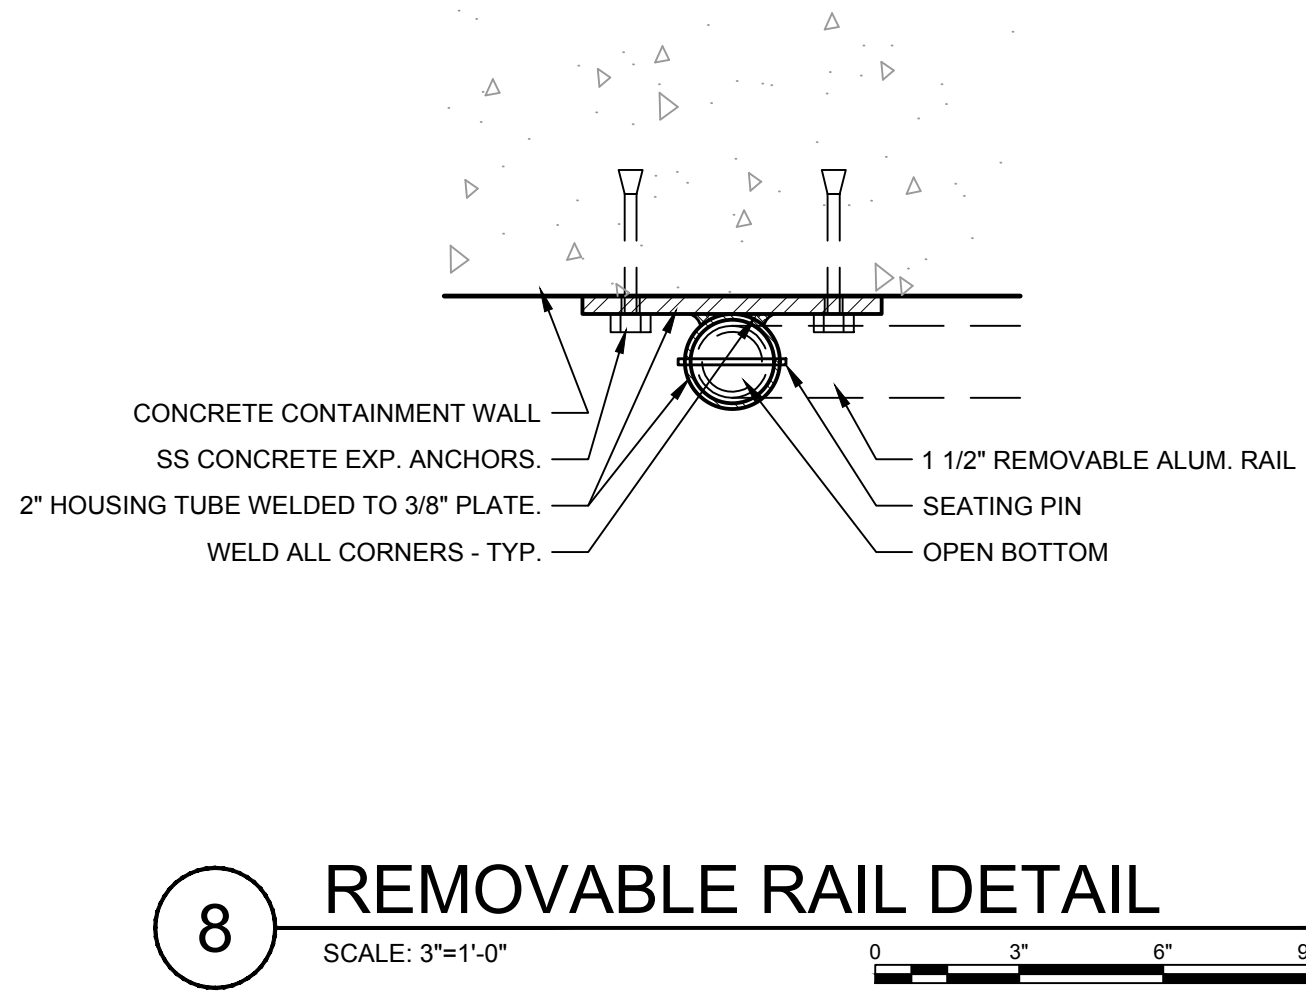


8 REMOVABLE RAIL DETAIL
SCALE: 3"=1'-0"

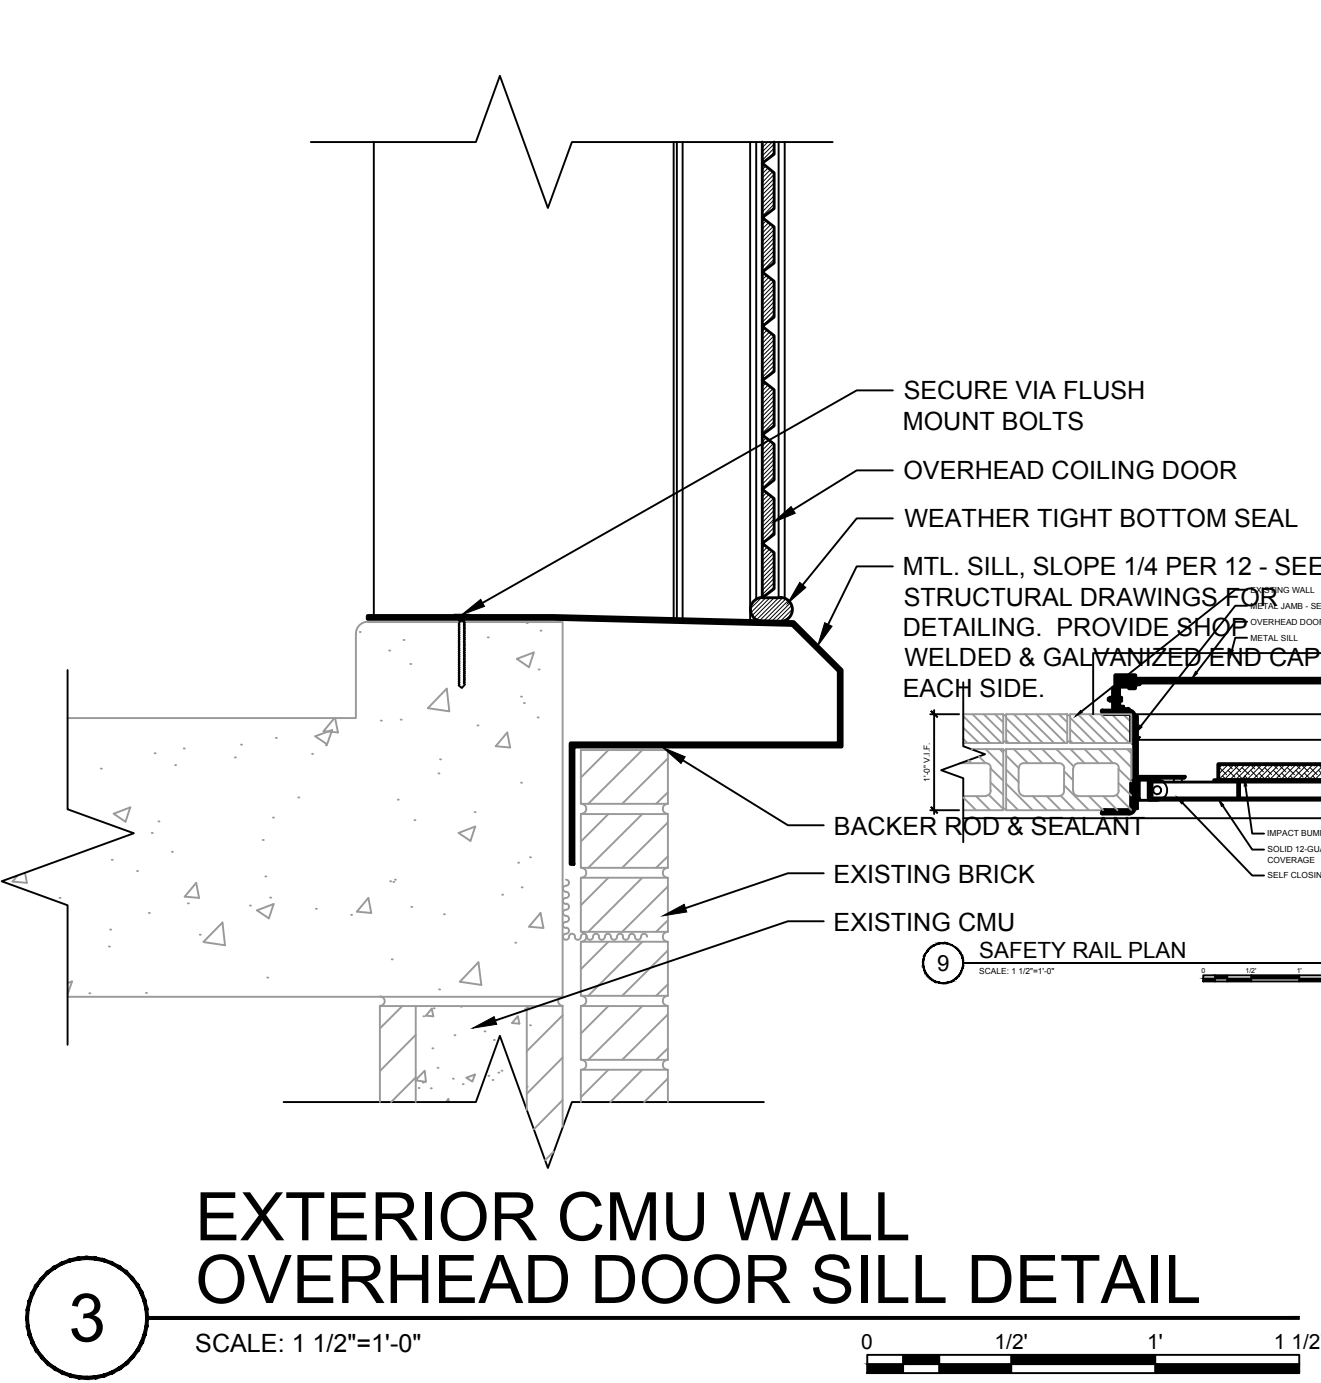

3 EXTERIOR CMU WALL OVERHEAD DOOR SILL DETAIL
SCALE: 1 1/2"=1'-0"

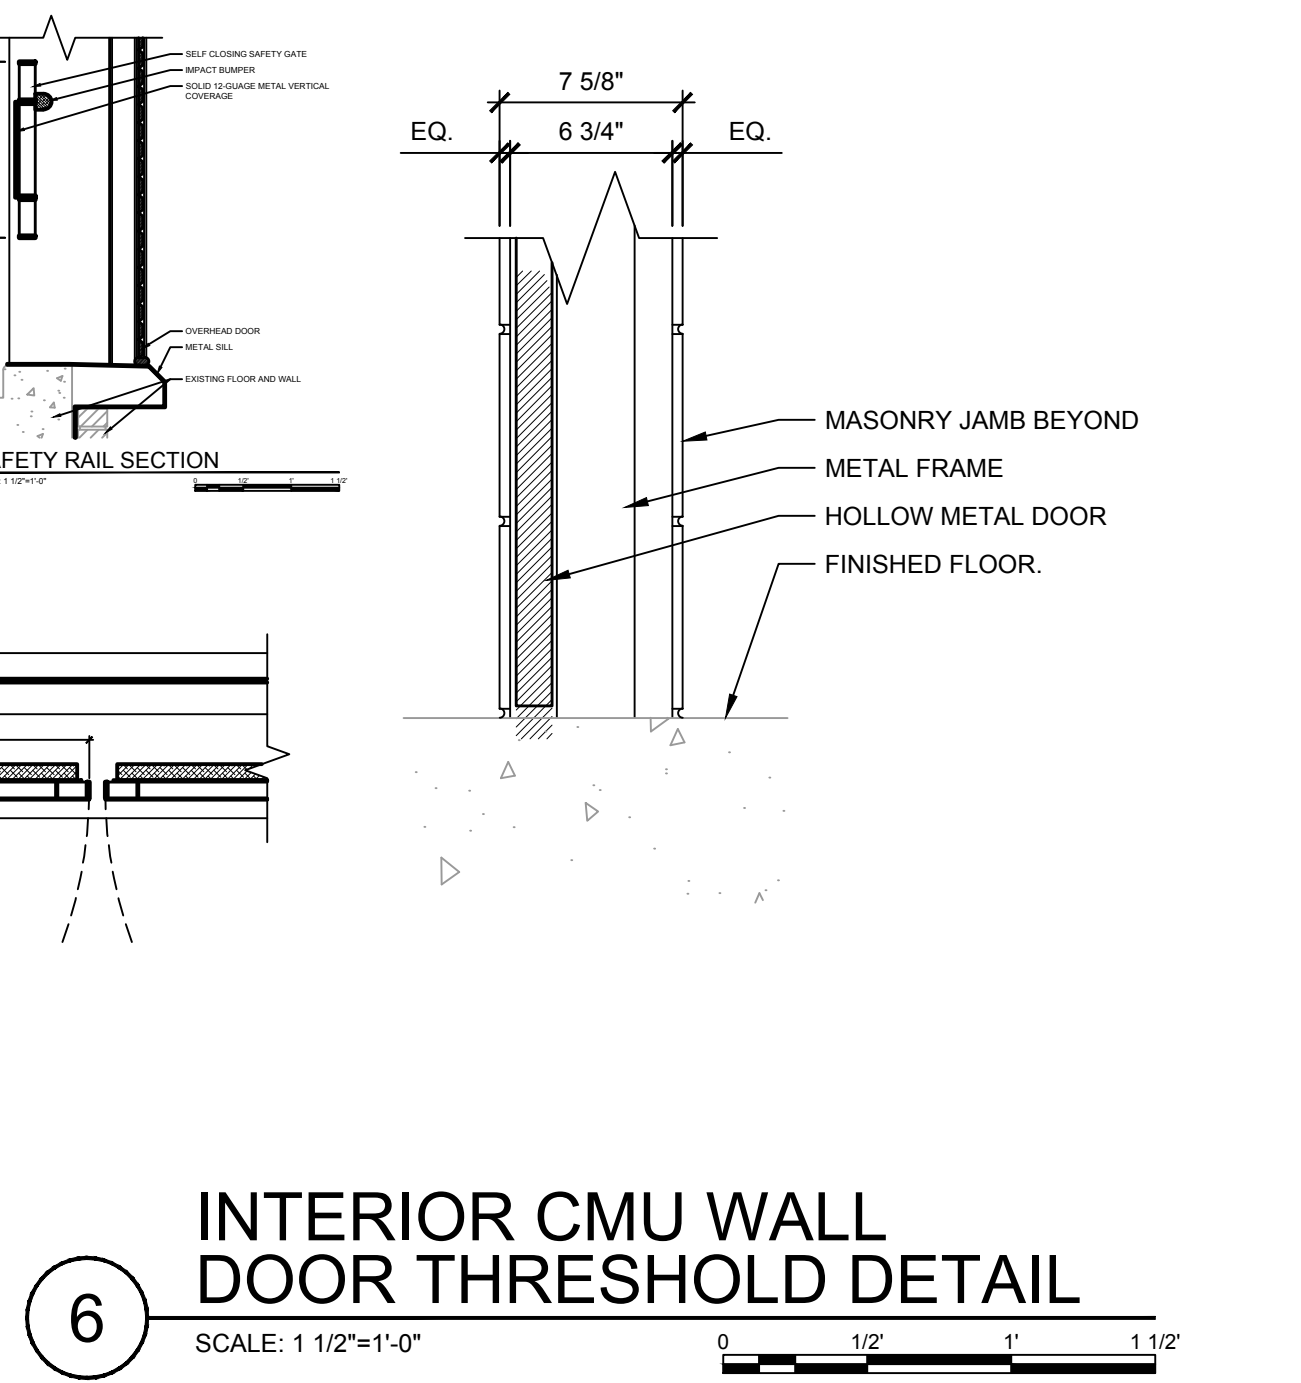

6 INTERIOR CMU WALL DOOR THRESHOLD DETAIL
SCALE: 1 1/2"=1'-0"

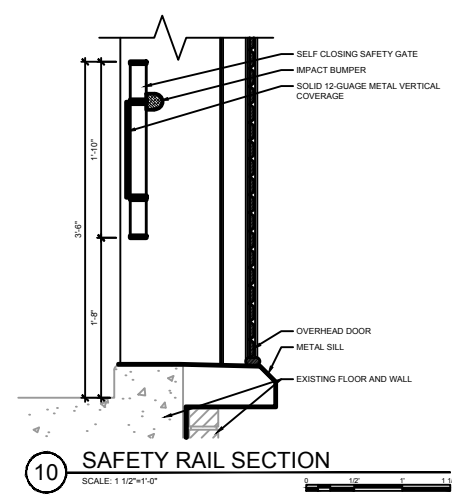

10 SAFETY RAIL SECTION



9 SAFETY RAIL PLAN

THIS RECORD DOCUMENT HAS BEEN PREPARED BASED ON INFORMATION PROVIDED BY THE CONSTRUCTION CONTRACTOR. GRW ENGINEERS, INC. HAS ATTEMPTED TO VERIFY THE ACCURACY AND/OR COMPLETENESS OF THIS INFORMATION BUT SHALL NOT BE RESPONSIBLE FOR ANY ERRORS OR OMISSIONS WHICH MAY BE INCORPORATED HEREIN AS A RESULT.

engineering | architecture | geospatial
www.grwinc.com

ENGINEER/ARCHITECT: David C. Osborne
CONSTRUCTION COMPANY: Dugan & Meyers
DATE: 4/23/19

GRW PROJECT NO. 4384
CLIENT PROJECT NO.
ALL RIGHTS RESERVED. NO PART OF THIS DOCUMENT SHALL BE REPRODUCED IN WHOLE OR IN PART WITHOUT THE WRITTEN PERMISSION OF GRW ENGINEERS, INC.

engineering | architecture | geospatial
www.grwinc.com

BELT FILTER PRESS REPLACEMENT DETAILS
TAYLOR MILL TREATMENT PLANT
NORTHERN KENTUCKY WATER DISTRICT

DESIGNED	JDR	DATE	DESCRIPTION
BY	JDR		
DATE	JDR		
REVISIONS	JKP		
NO.	JKP		
	JKP		
	JKP		

SCALE CHECK: THIS MARK SHOULD MEASURE EXACTLY 1" WHEN PLOTTED



DATE: APRIL, 2019
SCALE: 1/4" = 1'-0"
SHEET NO. A-501

RECORD DOCUMENTS

PLOTTED BY: mwilliamson

PRINTED: 4/23/2019 @ 2:37PM

FILE NAME: U:\4384-NKVD-TMTP-BFP\Working Drawings\AutoCAD\4384-LS-101.dwg

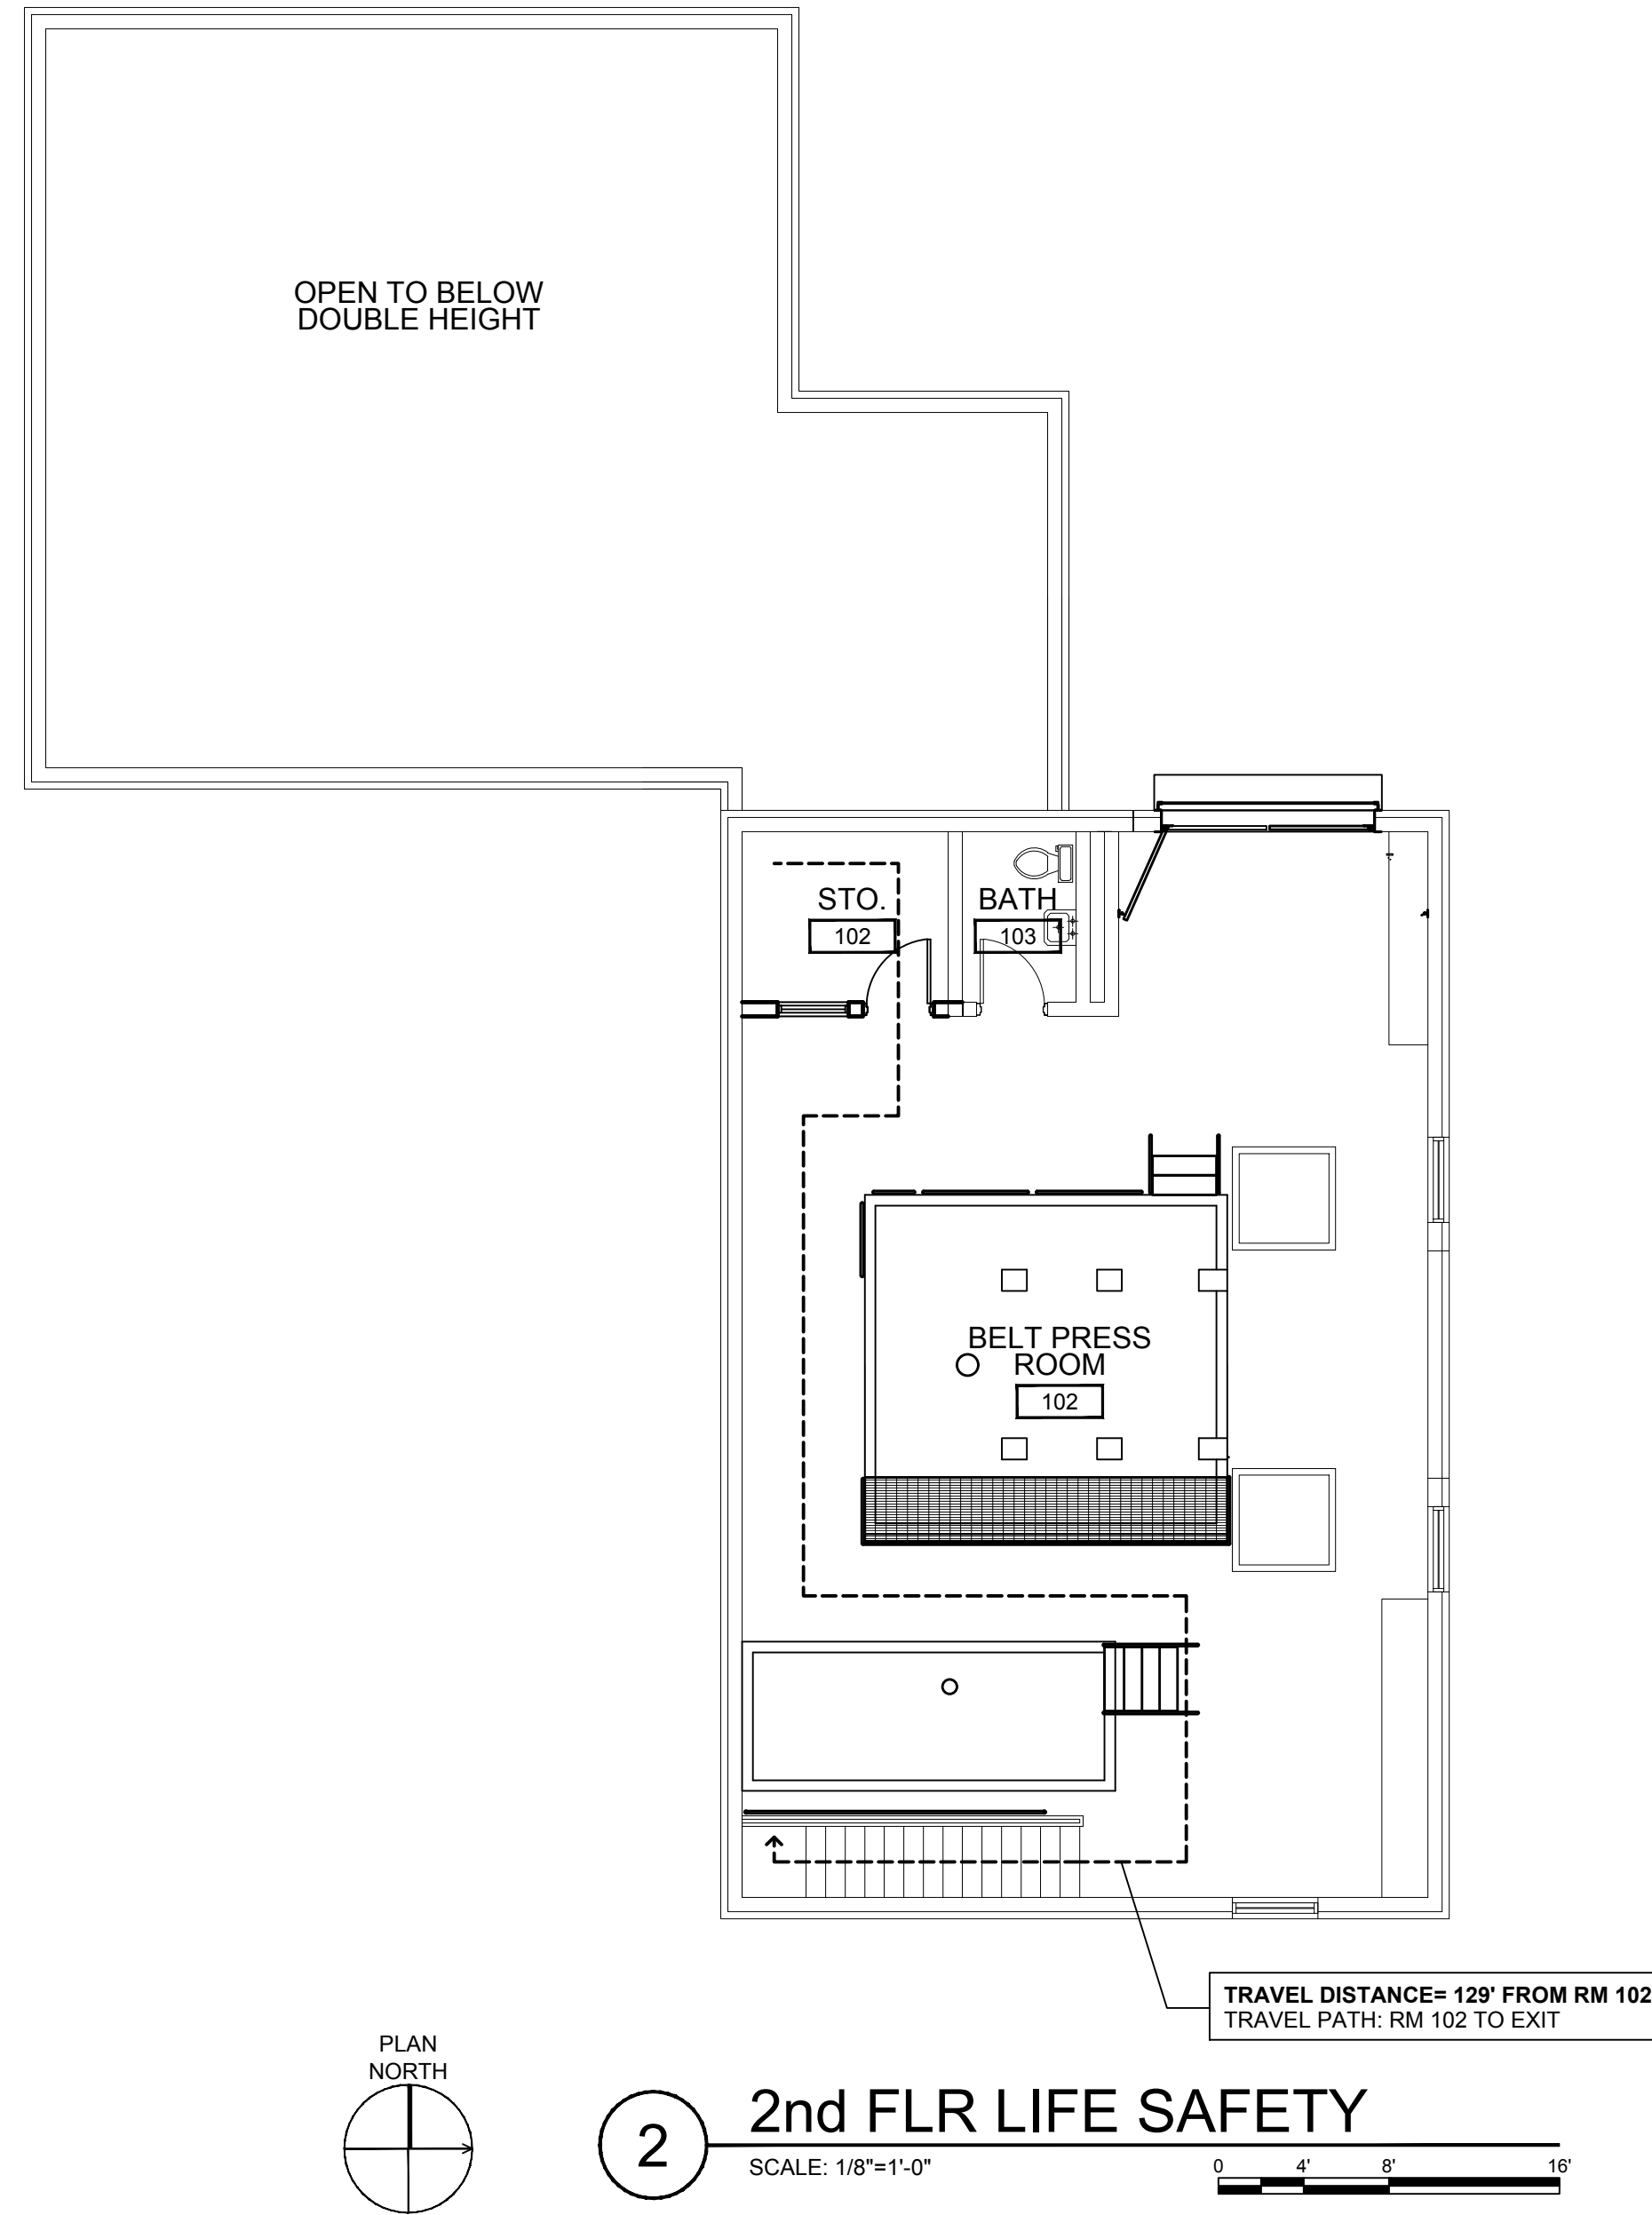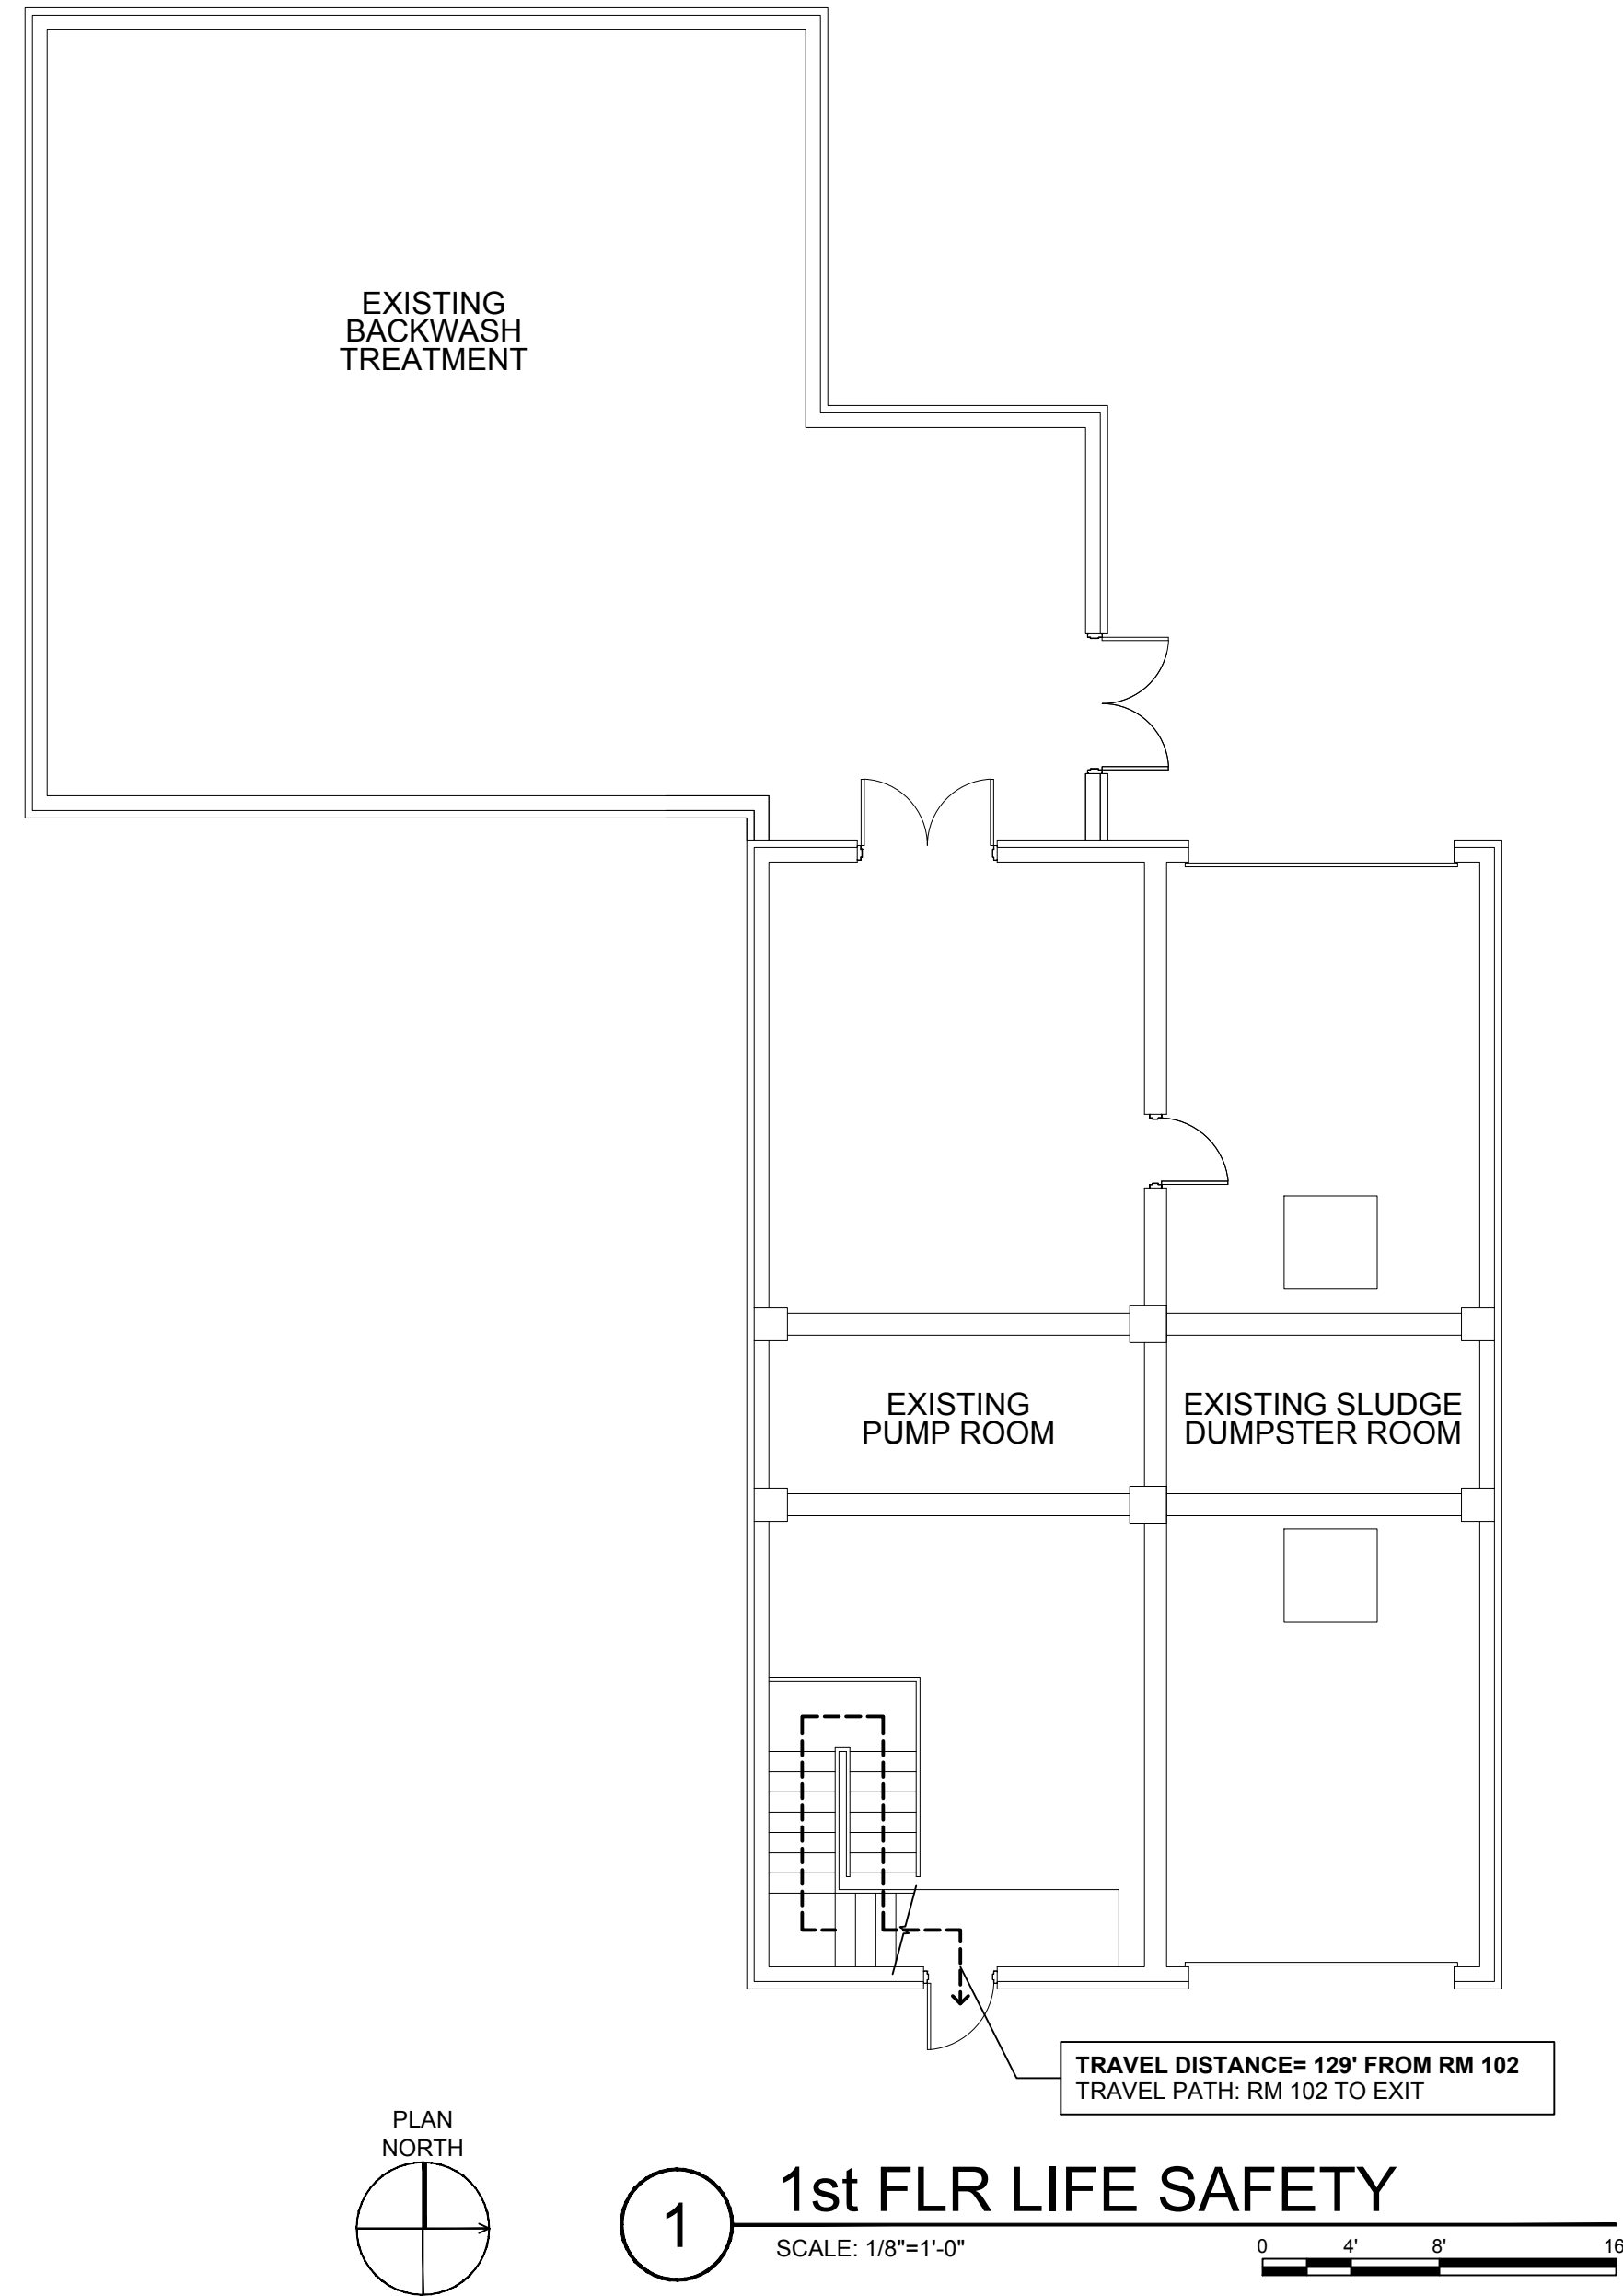

KENTUCKY BUILDING CODE 2013 / LIFE SAFETY

EXISTING BUILDING ALTERATION		
USE AND OCCUPANCY CLASSIFICATION, EXISTING AND AS ALTERED : F-2 LOW HAZARD FACTORY INDUSTRIAL		
THE ROOMS BELOW CONTAIN CHEMICAL INDICATED IN AMOUNTS LESS THAN THE THRESHOLD INDICATED IN IBC TABLE 307.1		
BACKWASH TREATMENT: SODIUM BISULFATE SOLUTION / CORROSIVE / LESS THAN 500 GAL STORED, 500 GAL CLOSED SYSTEM.		
PUMP RM. CLARIFLOC C-3223 POLYMER: NON HAZARDOUS PER MFR. / (2) 200 GAL STORAGE TANKS.		
BELT PRESS RM.: CLARIFLOC A-3333P POLYMER / NON HAZARDOUS PER MFR. / (1) PALLET OF 40 X 50LB BAGS DRY POWDER.		
CONSTRUCTION TYPE, EXISTING AND AS ALTERED: TYPE IIB		
ALLOWABLE AREA:	23,000 S.F. PER STORY	
SPRINKLER INCREASE:	NOT REQUIRED	
ALLOWABLE STORIES:	3 STORIES	
TOTAL ALLOWABLE AREA:	23,000 S.F. PER STORY	
ALLOWABLE HEIGHT:	55'	
EXISTING AREA / STORIES / HT:	1ST FLR. 3,361 S.F. / 2ND FLR. 1,776 S.F. / 2 STORIES 34'-4"	
FIRE RESISTANCE RATINGS: REQUIRED & EXIST. TYPICAL		
EXTERIOR / INTERIOR BEARING WALLS: 0 HRS.		
EXTERIOR / INTERIOR NON-BEARING WALLS: 0 HR.		
PRIMARY STRUCTURAL FRAME: 0 HR.		
ROOF / FLOOR CONSTRUCTION AND SECONDARY MEMBERS: 0 HR.		
EGRESS		
CALCULATED OCCUPANT LOAD:		
1ST FLR. 3,361 GROSS S.F. / 100 S.F. PER PERSON = 34 PERSONS		
2ND FLR. 1,776 GROSS S.F. / 100 S.F. PER PERSON = 18 PERSONS		
TOTAL (CALCULATED): 55 PERSONS		
NUMBER OF EXITS REQUIRED:		
TABLE 1021.2(2) ALLOWS SECOND FLOOR TO HAVE ONE MEANS OF EGRESS		
1009.3 EXCEPTION 1. ALLOWS THE EXISTING STAIR TO BE OPEN TO BOTH FLOORS		
*3404 / 3412.2.4 ALTERED BLDGS. CODE COMPLIANCE NOT REQUIRED IF NOT LESS SAFE AFTER ALTERATIONS THAN BEFORE ALTERATIONS.		
NUMBER OF EXITS REQUIRED & EXIST.:		
1ST FLR.: 2	2ND FLR.: 1	
EGRESS COMPONENTS		
EXIT TRAVEL DISTANCE:	MAX. 1ST FLR.: 300'	EXIST. 1ST FLR.: 85'
	MAX. 2ND FLR.: 75'	*EXIST. 2ND FLR.: 129'
COMMON PATH OF TRAVEL DISTANCE:	MAXIMUM: 75'	EXIST.: NA
CORRIDOR WIDTH:	MINIMUM: 44"	EXIST.: NA
DOOR CLEAR WIDTH (1008.1.1):	MINIMUM: 32"	EXIST.: 36"
STAIR CLEAR WIDTH (1009.4, EXCEPTION 1.):	MINIMUM: 36"	EXIST.: 36"

GENERAL NOTES

- LIFE SAFETY ANALYSIS BASED ON 2012 IBC W/ 2013 KBC AMENDMENTS.

REVIEW NOTE:

- * EXISTING STAIR: IBC TABLE 1021.2(2) ALLOWS THE SECOND FLOOR TO HAVE ONE MEANS OF EGRESS SINCE OCCUPANCY LOAD IS LESS THAN 49 PERSONS. IBC 1009.3 EXCEPTION 1. ALLOWS A STAIR IN A 2 STORY BUILDING TO BE OPEN TO BOTH FLOORS. IBC TABLE 1021.2(2) ALSO REDUCES THE MAX. EGRESS DISTANCE FROM THE SECOND FLOOR TO 75' THE EXISTING ACTUAL MAX. EGRESS DISTANCE IS 129'. IBC 3404 / 3412.2.4 ALLOWS ALTERED BUILDINGS TO NOT COMPLY WITH CURRENT BUILDING CODE IF THE ALTERED BUILDING IS NOT LESS SAFE THAN THE EXISTING BUILDING.

THIS RECORD DOCUMENT HAS BEEN PREPARED BASED ON INFORMATION PROVIDED BY THE CONSTRUCTION CONTRACTOR. GRW ENGINEERS, INC. HAS ATTEMPTED TO VERIFY THE ACCURACY AND/OR COMPLETENESS OF THIS INFORMATION BUT SHALL NOT BE RESPONSIBLE FOR ANY ERRORS OR OMISSIONS WHICH MAY BE INCORPORATED HEREIN AS A RESULT.

GRW
engineering | architecture | geospatial
www.grwinc.com

ENGINEER/ARCHITECT: David C. Osborne
CONSTRUCTION COMPANY: Dugan & Meyers
DATE: 4/23/19

GRW PROJECT NO. 4384

CLIENT PROJECT NO.

ALL RIGHTS RESERVED. NO PART OF THIS DOCUMENT SHALL BE REPRODUCED IN WHOLE OR IN PART WITHOUT THE WRITTEN PERMISSION OF GRW ENGINEERS, INC. AND SHALL NOT BE USED FOR ANY OTHER PROJECT OTHER THAN THIS SPECIFIC PROJECT WITHOUT WRITTEN PERMISSION.

GRW
engineering | architecture | geospatial
www.grwinc.com

**BELT FILTER PRESS REPLACEMENT
LIFE SAFETY PLAN**

TAYLOR MILL TREATMENT PLANT
NORTHERN KENTUCKY WATER DISTRICT

DESIGNED	JAB
DRAWN	JAB
REVIEWED	RCC
APPROVED	RCC

NO.	DATE	DESCRIPTION

SCALE CHECK: _____ THIS MARK SHOULD MEASURE EXACTLY 1" WHEN PLOTTED





DATE: **APRIL, 2019**

SCALE: **1/4" = 1'-0"**

SHEET NO. **LS-101**

RECORD DOCUMENTS

GENERAL LEGEND

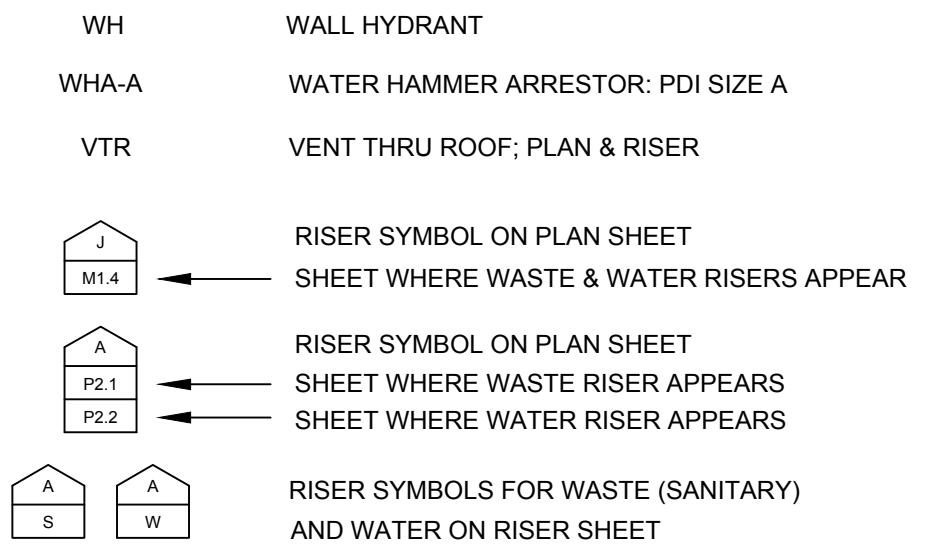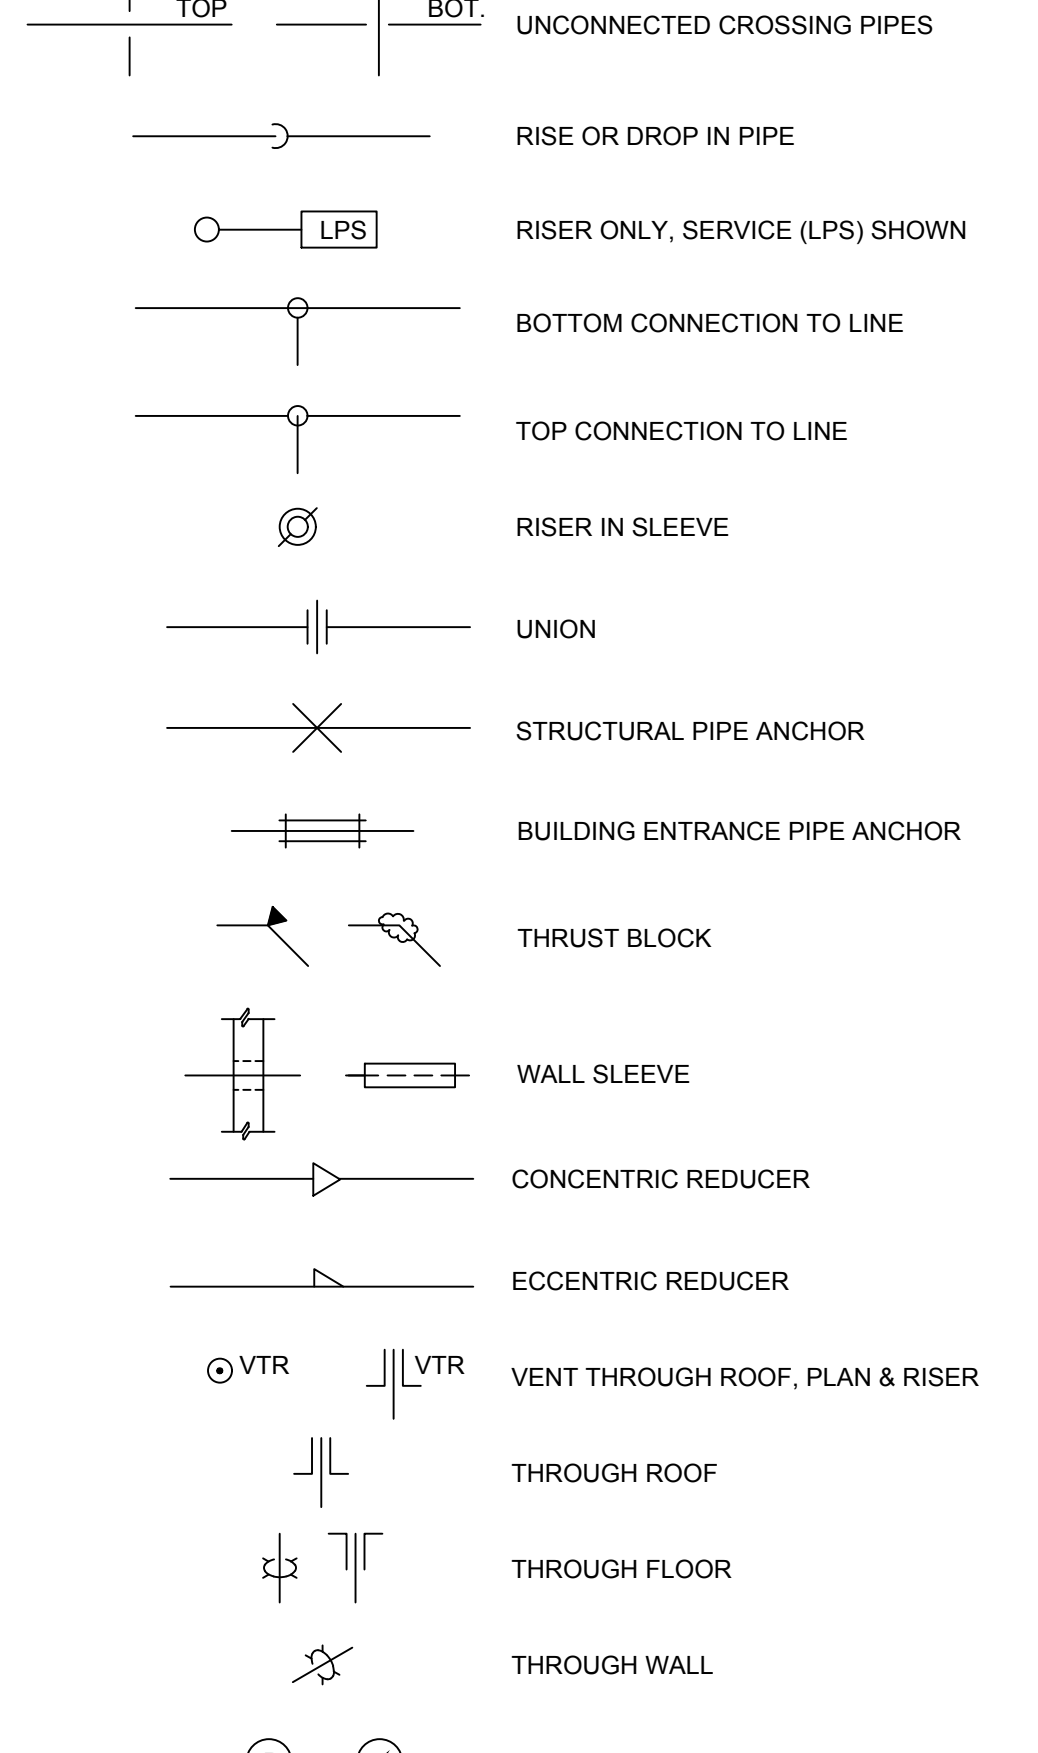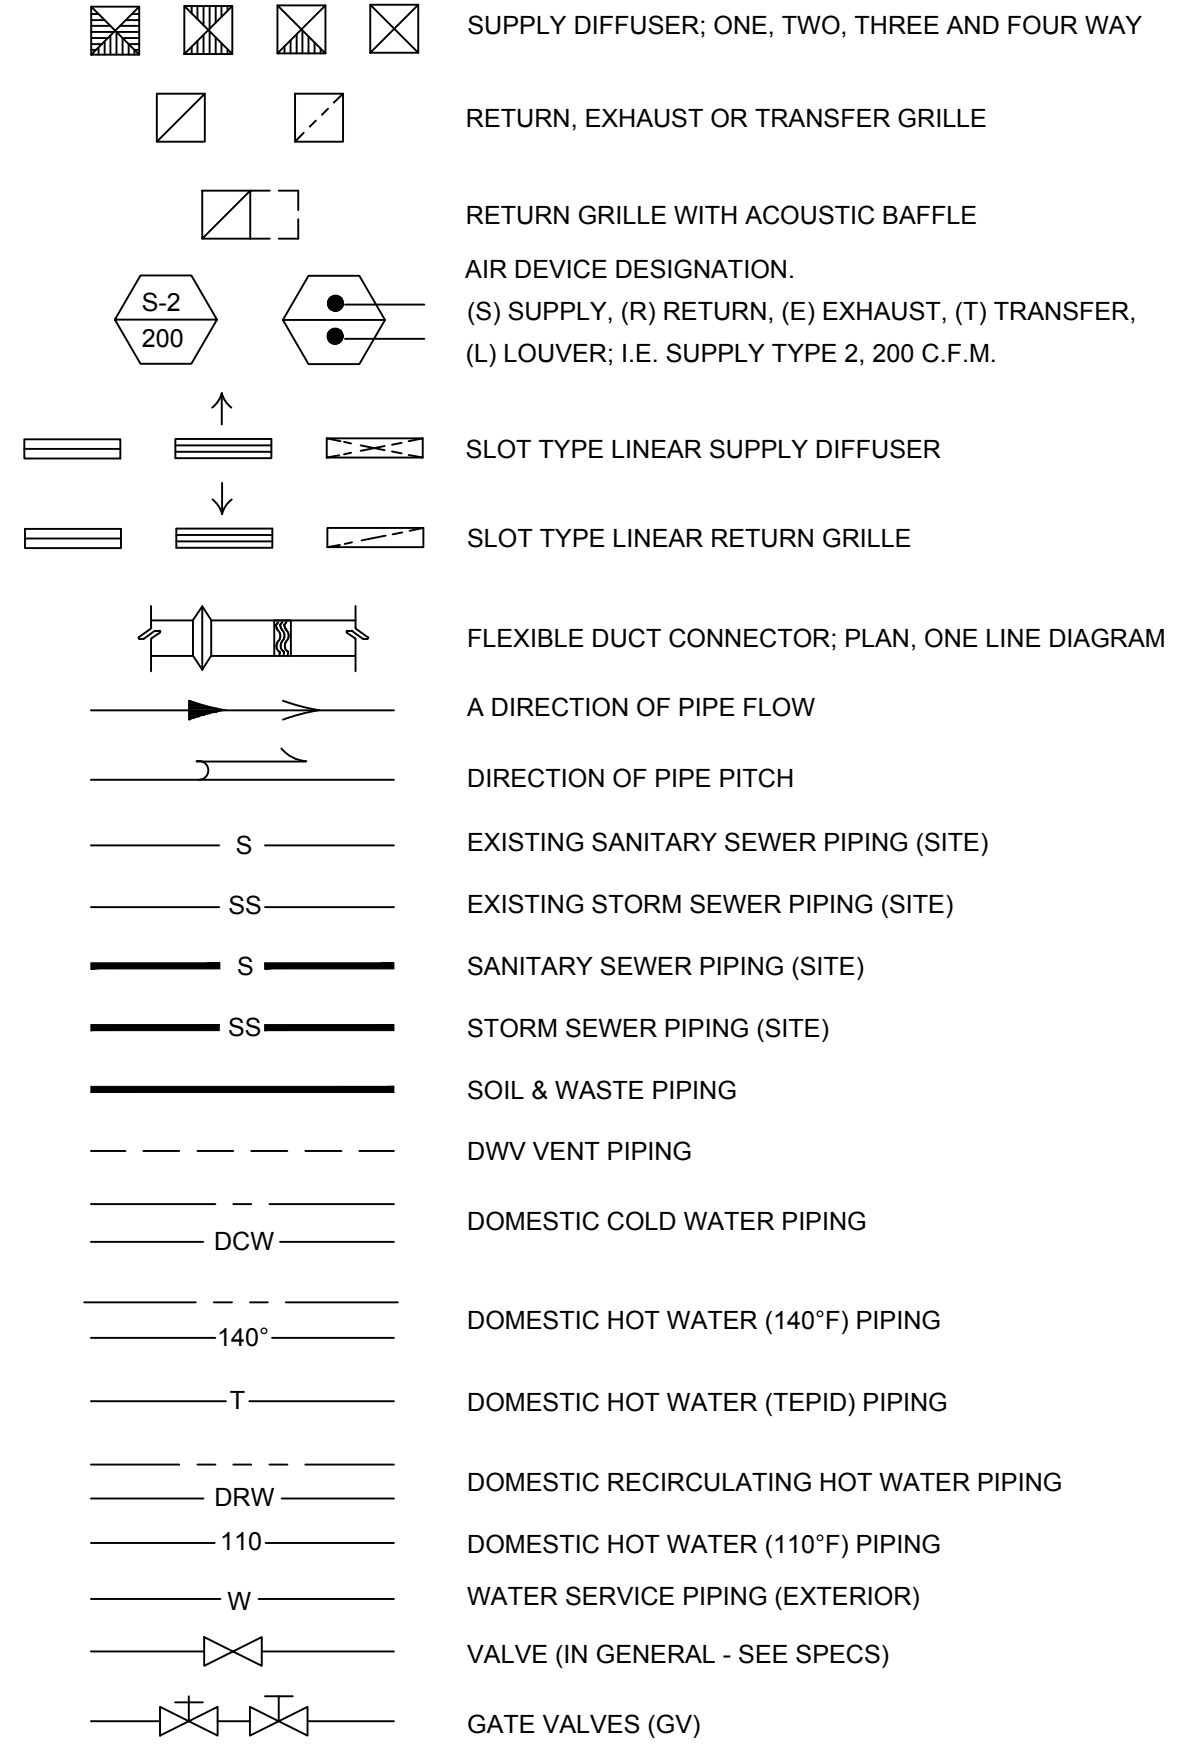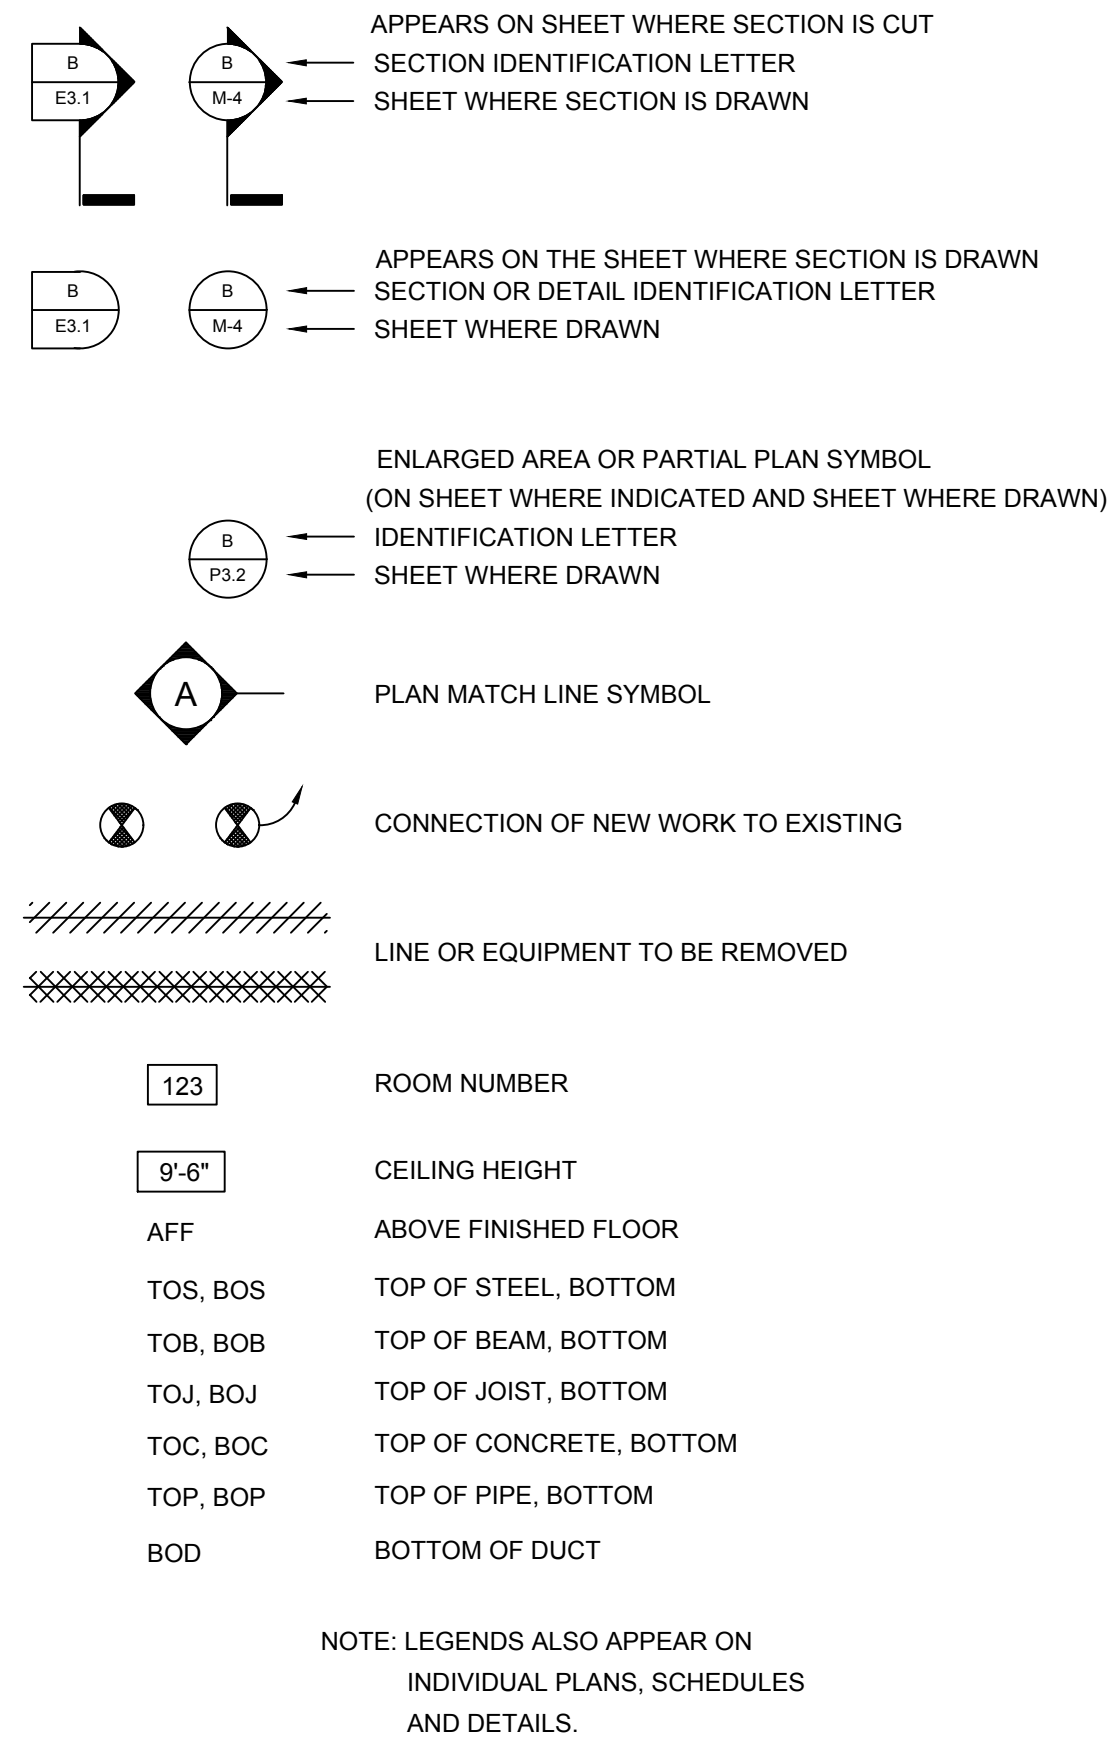


GENERAL NOTES

- GENERAL NOTES, WHEREVER THEY ARE FOUND, APPLY TO ALL WORK IN THE PROJECT, UNLESS OTHERWISE INDICATED. SHEET NOTES, UTILIZING NOTE SYMBOLS, APPLY ONLY TO THE SHEET ON WHICH THEY ARE FOUND, UNLESS OTHERWISE STATED. THE MEANING OF NOTE SYMBOLS AND NUMBERS VARIES FROM SHEET TO SHEET.
- CONTRACTOR SHALL UTILIZE ALL INFORMATION IN THE CONTRACT DOCUMENTS FOR PROVIDING THE WORK. CONTRACTOR SHALL UTILIZE DETAILS AND FLOW DIAGRAMS FOR THE WORK WHERE APPROPRIATE, WHETHER OR NOT THEY ARE SPECIFICALLY REFERENCED ON THE PLANS OR SUPPORTING DRAWINGS.
- CONTRACTOR SHALL FIELD VERIFY ALL EXISTING CONDITIONS. ANY DISCREPANCIES BETWEEN EXISTING CONDITIONS AND CONTRACT DOCUMENTS ARE TO BE BROUGHT TO THE ATTENTION OF THE ENGINEER BEFORE ANY WORK RELATING TO THOSE CONDITIONS IS PERFORMED.
- LEGENDS OR LISTS OF SYMBOLS AND ABBREVIATIONS ARE GENERAL IN NATURE AND MAY CONTAIN ITEMS NOT USED IN THE CONTRACT DOCUMENTS. IF ANY SUCH ITEMS ARE FOUND WHICH ARE NOT DEFINED ON THE PLANS OR IN THE SPECIFICATIONS, THE ENGINEER SHALL BE CONTACTED FOR CLARIFICATION BEFORE THE BID.
- CONTRACTOR SHALL MAINTAIN A SET OF PROJECT RECORD DRAWINGS AT THE JOB SITE AND SHALL BE RESPONSIBLE FOR MAKING CLEAR, NEAT CHANGES TO THE DRAWINGS, REFLECTING CHANGES TO THE WORK AND VARIANCE IN EXISTING CONDITIONS.
- PROVIDE ALL MISCELLANEOUS STEEL, AS REQUIRED, TO SUPPORT ALL MECHANICAL DUCT AND PIPING SYSTEMS AND EQUIPMENT, HANG ALL EQUIPMENT FROM STRUCTURE WITH MINIMUM OF TWO TRAPEZE ASSEMBLIES OR FOUR INTEGRAL MOUNTING POINTS WITH VIBRATION ISOLATORS ON ALL FOUR SUPPORTS. DO NOT HANG ANYTHING FROM STEEL, COMPOSITION OR WOODEN DECKS. NON-ROOF CONCRETE DECKS MAY BE USED ONLY WITH PERMISSION OF THE ENGINEER. DO NOT HANG ANYTHING FROM MECHANICAL OR ELECTRICAL ITEMS.
- NO CONCRETE RISERS OR JOISTS SHALL BE CUT WITHOUT SPECIFIC PERMISSION FROM THE ENGINEER. ALL ROOF OR FLOOR DECK PENETRATIONS IN WAFFLE STRUCTURE SHALL BE IN THE THIN-SLAB DEPRESSIONS IN THE STRUCTURE UNLESS OTHERWISE SHOWN.
- NO STEEL STRUCTURAL MEMBERS SHALL BE CUT, BURNED, WELDED OR DRILLED WITHOUT SPECIFIC PERMISSION OF THE ENGINEER.
- NO WOODEN STRUCTURAL MEMBERS SHALL BE CUT OR DRILLED EXCEPT AS INDICATED IN THE CONTRACT DOCUMENTS OR AS APPROVED BY THE ENGINEER.
- CONSULT ARCHITECTURAL PLANS FOR DIMENSIONING AND POSITIONS OF WALL LOUVERS.
- ALL EQUIPMENT, DUCT, PIPING AND ACCESSORIES INSTALLED OUTSIDE OR OTHERWISE EXPOSED TO THE ELEMENTS SHALL BE ADEQUATELY WEATHERPROOFED, IN KEEPING WITH THE SPECIFICATIONS. ALL FERROUS METAL FRAMING COMPONENTS SHALL BE STAINLESS STEEL OR HOT-DIP GALVANIZED.
- DO NOT CHANGE PATH OF PIPING OR DUCT RUNS, ADD TURNS OR OFFSETS OR CHANGE DUCT DIMENSIONS OR PIPE SIZE WITHOUT FIRST CONSULTING THE ENGINEER. PIPE SIZES SHOWN ON DRAWINGS ARE NOMINAL UNLESS OTHERWISE INDICATED. ALL DUCT SIZES SHOWN ON PLANS ARE CLEAR INSIDE DIMENSIONS FOR SHOP OR FIELD-FABRICATED DUCT AND NOMINAL SIZES FOR FACTORY FABRICATED DUCT.
- SEE ALSO RISER DIAGRAMS OR FLOW/CONTROL DIAGRAMS FOR SIZES NOT SHOWN ON PLANS.
- ALL COPPER PIPING SHALL BE ASSEMBLED WITH WROUGHT COPPER OR CAST COPPER ALLOY FITTINGS AND 95/5 TIN ANTIMONY SOLDER OR SILVER BRAZING. NO SOLDER CONTAINING LEAD SHALL BE USED.
- ALL EXTERIOR MECHANICAL UTILITIES SHALL BE IN GENERAL COMPLIANCE WITH APPROPRIATE DIVISIONS 22 AND 23 SPECIFICATION SECTION (FOR CORRESPONDING INTERIOR UTILITIES).
- CONTRACTOR SHALL CERTIFY AT THE TIME OF OWNER OCCUPANCY THAT ALL BELT-DRIVEN EQUIPMENT HAS BEEN CHECKED FOR BELT TIGHTNESS AFTER WEAR-IN PERIOD.
- ALL EXISTING EQUIPMENT SHUTDOWNS OR INTERRUPTIONS OF UTILITY SERVICE REQUIRED FOR COMPLETION OF THE WORK SHALL BE SCHEDULED IN ADVANCE, AS REQUIRED BY THE OWNER.
- PROVIDE LINTELS AS REQUIRED FOR ALL NEW OPENINGS GREATER THAN 12" WIDE IN MASONRY OR LOAD-BEARING WALLS, MATERIAL TO BE APPROVED BY ENGINEER.
- ANY AND ALL DAMAGE TO DEMOLITION OR CONSTRUCTION IS TO BE REPAIRED OR REPLACED AS APPROPRIATE, SUBJECT TO ENGINEER'S APPROVAL, AND AT NO ADDITIONAL COST TO THE OWNER.
- ALL DUCTWORK AND SHEET METAL SHALL BE PROVIDED AS INDICATED AND SHALL BE MANUFACTURED AND SHOP-OR-FIELD-FABRICATED, AS A MINIMUM, IN ACCORDANCE WITH THE RECOMMENDATIONS AND DETAILS OF SMACNA, UNLESS SPECIFICALLY INDICATED OTHERWISE.
- FANS SHALL BE PROVIDED AS INDICATED BY GREENHECK, CARNES, COOK OR APPROVED EQUAL. LOUVERS SHALL BE PROVIDED AS INDICATED BY GREENHECK, AIRSTREAM, LOUVERS AND DAMPERS, CARNES, RUSKIN OR APPROVED EQUAL.
- PROVIDE ALL HVAC EQUIPMENT AND ACCESSORIES AS INDICATED. INSTALL IN COMPLIANCE WITH ALL REQUIREMENTS OF THE KENTUCKY BUILDING CODE.
- MOUNT ALL ROOM THERMOSTATS OR ADJUSTABLE SENSORS AT HEIGHTS ABOVE FINISHED FLOOR, AS DIRECTED BY THE ENGINEER.
- USE TURNING VANES, PER SMACNA CONSTRUCTION GUIDELINES, FOR ALL MITERED RECTANGULAR TURNS OF 45 DEGREES OR MORE.
- CONTRACTOR SHALL MAKE MINOR OFFSETS AND LOCATION CHANGES IN PIPE AND DUCT AND IN DUCT ASPECT RATIO AS REQUIRED IN CONGESTED CEILING OR MECHANICAL SPACES. GENERALLY, THESE WILL BE AT NO COST TO THE OWNER AND APPROVED BY THE ENGINEER WITHOUT FORMAL DOCUMENTS. MAJOR REROUTING OF LINES OR MAJOR ADDITION OF FITTINGS WILL BE REVIEWED AND APPROVED AS A CHANGE ORDER OR A FORMAL DIRECTIVE. ENGINEER ALONE SHALL CLASSIFY CHANGES AS MAJOR OR MINOR.
- ALL EQUIPMENT PROVIDED WITH FILTERS SHALL HAVE FILTERS IN PLACE AT THE TIME OF STARTUP. ALL NEW FILTERS SHALL BE INSTALLED AT THE TIME OF OWNER OCCUPANCY, AND A COMPLETE SET OF EXTRA FILTERS SHALL BE TURNED OVER TO THE OWNER AT THIS TIME. IN THE EVENT THAT CARE IS NOT TAKEN DURING INITIAL OPERATION TO PREVENT CONTAMINATION OF THE FILTERS WITH CONSTRUCTION DUST, ADDITIONAL SETS OF FILTERS SHALL BE PROVIDED TO PROTECT THE EQUIPMENT.
- PROVIDE ALL CONTROLS NECESSARY TO OPERATE EQUIPMENT AS SHOWN OR DESCRIBED, INCLUDING ACTUATORS, THERMOSTATS, DAMPERS, ALL ACCESSORY DEVICES, POWER AND/OR PNEUMATIC SERVICE.
- PROVIDE ALL PLUMBING CONNECTIONS, PIPING, FIXTURES AND EQUIPMENT AS INDICATED, NOTED AND SCHEDULED, FOR A COMPLETE WORKING SYSTEM. WORK SHALL BE PROVIDED BY A LICENSED PLUMBING CONTRACTOR, IN ACCORDANCE WITH THE KENTUCKY STATE PLUMBING CODE AND THE KENTUCKY BUILDING CODE, AND SHALL BE ACCOMPANIED BY A CERTIFICATE OF INSPECTION AND APPROVAL. ALL WATER PIPING SHALL BE TYPE L COPPER. ALL DWV PIPING SHALL BE DWV COPPER OR NO-HUB SOIL PIPE ABOVE AND HUB AND SPIGOT SOIL PIPE BELOW GROUND.
- PROVIDE DISCONNECTS AND MAGNETIC STARTERS (OR RELAYS WITH OVERLOAD PROTECTION FOR SINGLE PHASE) FOR ALL EQUIPMENT SUPPLIED UNDER DIVISION 22 & 23 WHICH IS SPECIFIED TO HAVE FACTORY CONTROL PANEL. POWER WIRING AND CONDUIT TO THESE DEVICES AND BETWEEN THESE DEVICES AND MECHANICAL EQUIPMENT, IF REQUIRED, SHALL BE SUPPLIED UNDER DIVISION 26.

MECHANICAL LEGEND

HVAC, PLUMBING & FIRE PROTECTION

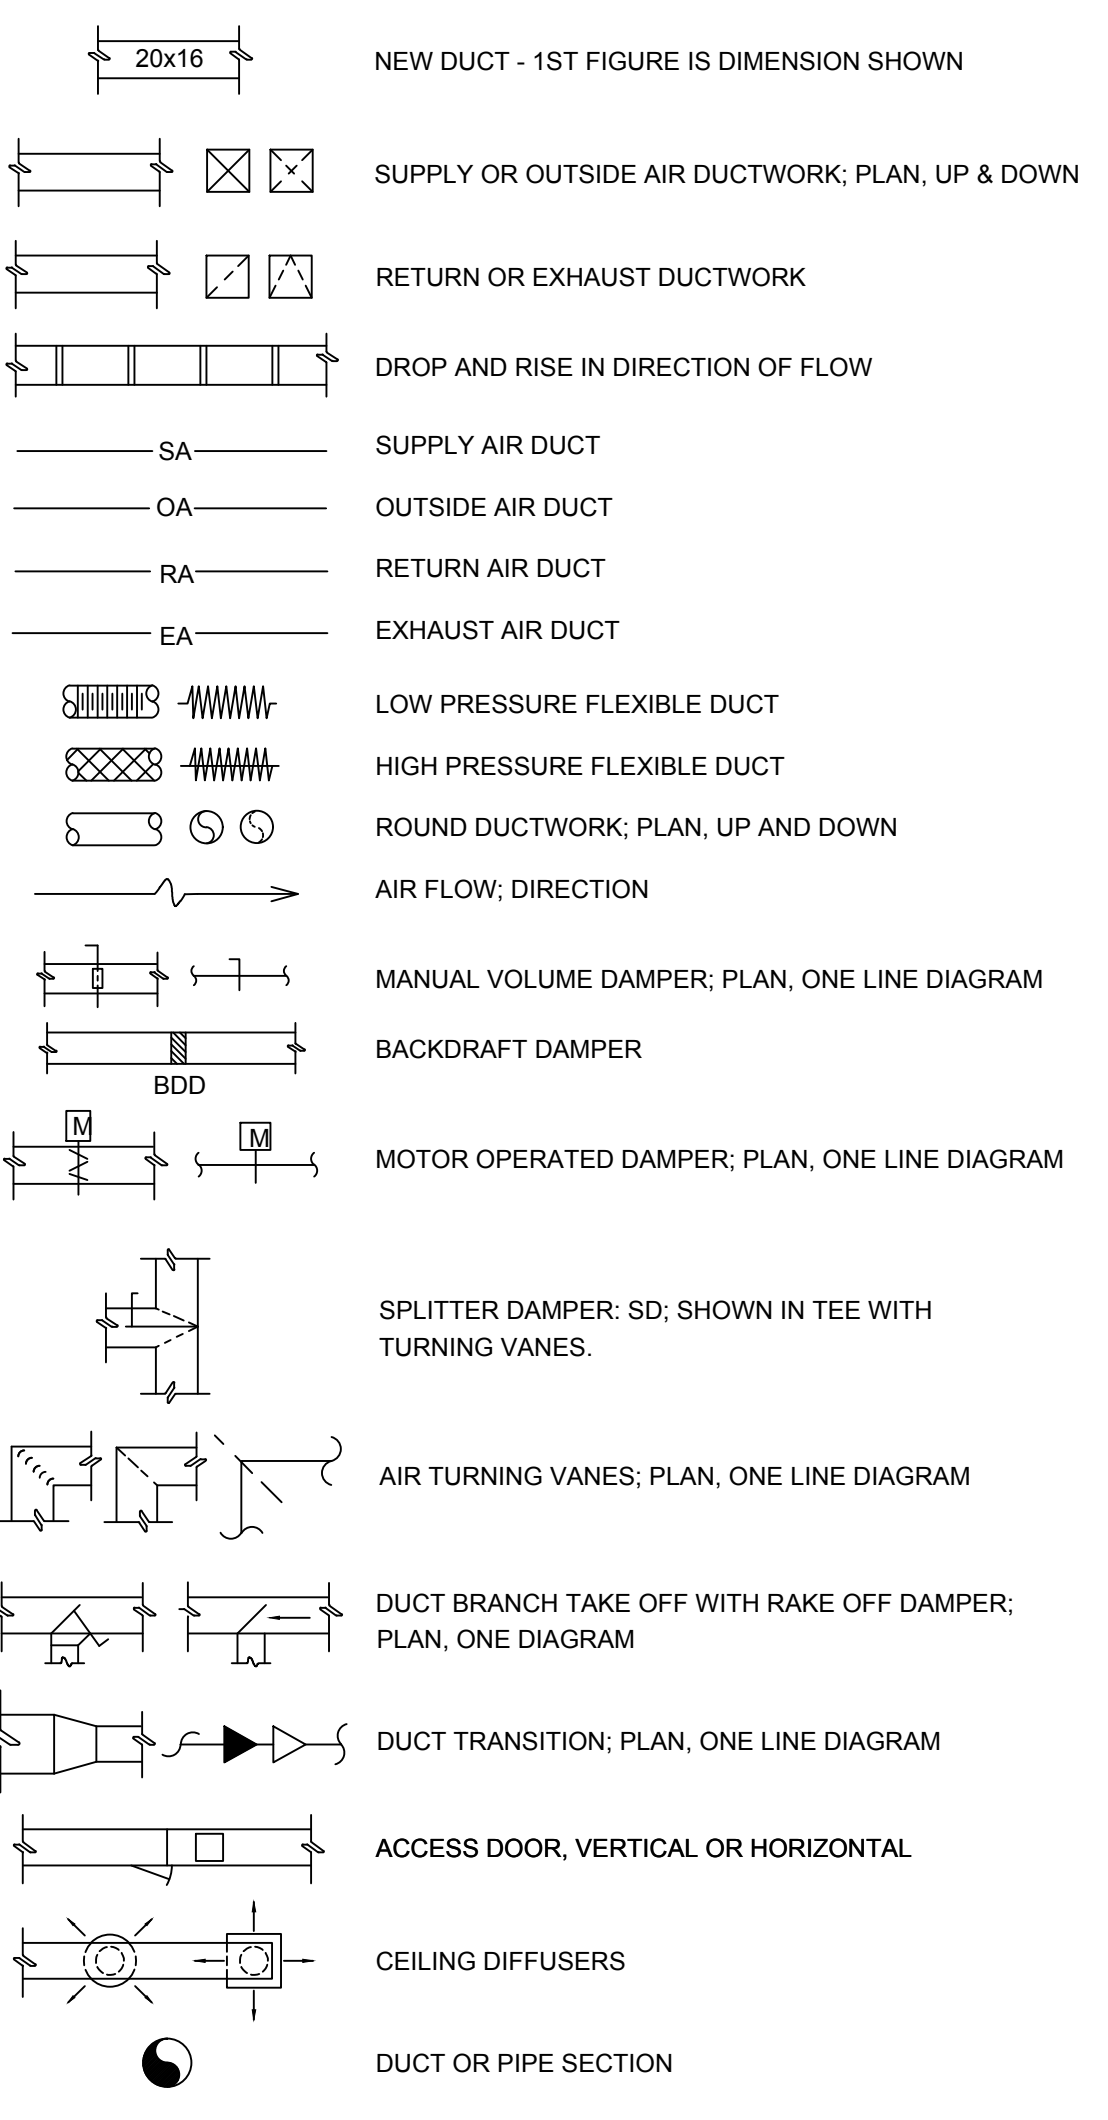

RECORD DOCUMENTS

GRW PROJECT NO. 4384

CLIENT PROJECT NO.

ALL RIGHTS RESERVED. NO PART OF THIS DOCUMENT SHALL BE REPRODUCED IN WHOLE OR IN PART WITHOUT THE WRITTEN PERMISSION OF GRW ENGINEERS, INC. AND SHALL NOT BE USED FOR ANY OTHER PROJECT OTHER THAN THIS SPECIFIC PROJECT WITHOUT WRITTEN PERMISSION.

engineering | architecture | geospatial

www.grwinc.com

BELT FILTER PRESS REPLACEMENT

MECHANICAL LEGEND AND GENERAL NOTES

TAYLOR MILL TREATMENT PLANT
NORTHERN KENTUCKY WATER DISTRICT

REVISIONS	NO.	DATE	DESCRIPTION	DESIGNED	DRAWN	REVIEWED	APPROVED
	MAS						
	MAS						
	AAT						
	AAT						

DATE: APRIL, 2019

SCALE: NOT TO SCALE

SHEET NO. M-001

THIS RECORD DOCUMENT HAS BEEN PREPARED BASED ON INFORMATION PROVIDED BY THE CONSTRUCTION CONTRACTOR GRW ENGINEERS, INC. HAS ATTEMPTED TO VERIFY THE ACCURACY AND/OR COMPLETENESS OF THIS INFORMATION BUT SHALL NOT BE RESPONSIBLE FOR ANY ERRORS OR OMISSIONS WHICH MAY BE INCORPORATED HEREIN AS A RESULT.

engineering | architecture | geospatial

www.grwinc.com

ENGINEER/ARCHITECT: David C. Osborne

CONSTRUCTION COMPANY: Dugan & Meyers

DATE: 4/23/19

SCALE CHECK: THIS MARK SHOULD MEASURE EXACTLY 1" WHEN PLOTTED

PRINTED: 4/23/2019 @ 2:37PM

PLOTTED BY: mwilliamson


FILE NAME: U:\4384-NKWD-TMTP-BFP\Working Drawings\AutoCAD\4384-M-001.dwg

GENERAL NOTES:

- SEE SHEET M-001 FOR LEGEND AND ADDITIONAL GENERAL NOTES.
- NATURAL GAS PIPING, VENTS, CONNECTIONS AND TERMINATIONS PER NFPA 54 AND THE INTERNATIONAL MECHANICAL CODE (IMC). DEMOLISH BRANCH LINE NATURAL GAS PIPING AND VENTS BACK TO MAIN, CAP AND SEAL.
- SEE SPECIFICATION SECTION 017329 FOR CUTTING AND PATCHING.


SHEET KEYNOTES:

- DISCONNECT UNIT HEATER FROM NATURAL GAS PIPING, UNIT SUPPORTS AND VENTS AND PREPARE FOR REINSTALLATION.
- DEMOLISH UNIT HEATER AND ASSOCIATED NATURAL GAS PIPING, SUPPORTS AND VENTS INCLUDING VENT EXTENDING DOWN TO UNIT HEATER ON FIRST FLOOR. MAIN VENT ABOVE BRANCH TEE TO REMAIN. PATCH/REPAIR FLOOR WITH IN KIND MATERIAL TO MATCH EXISTING.
- PROVIDE AND INSTALL MATCHING VENT FROM UNIT HEATER BELOW ON FIRST FLOOR UP TO MAIN VENT ABOVE. CORE DRILL FLOOR SIZED TO ACCEPT VENT AND ASSOCIATED FIRE STOPPING. SEE DETAIL, THIS SHEET. (NOT TO CONFLICT WITH AIR COMPRESSOR)
- PROVIDE AND INSTALL TRANSFER GRILLES APPROXIMATELY 8'-0" AFF TO BOTTOM OF GRILLES.
- REINSTALL EXISTING UNIT HEATER AND ASSOCIATED NATURAL GAS PIPING, SUPPORTS AND VENTS PER MANUFACTURER'S REQUIREMENTS MAINTAINING MINIMUM CLEARANCES FROM COMBUSTIBLES. MAINTAIN BOTTOM OF UNIT HEATER CLEAR OF MONORAIL, ROLL-UP DOOR, LIGHTING AND STRUCTURAL COMPONENTS.
- PROVIDE AND INSTALL VENT FROM FLOOR PENETRATION BELOW UP TO MAIN VENT ABOVE, INCLUDING OFFSET.

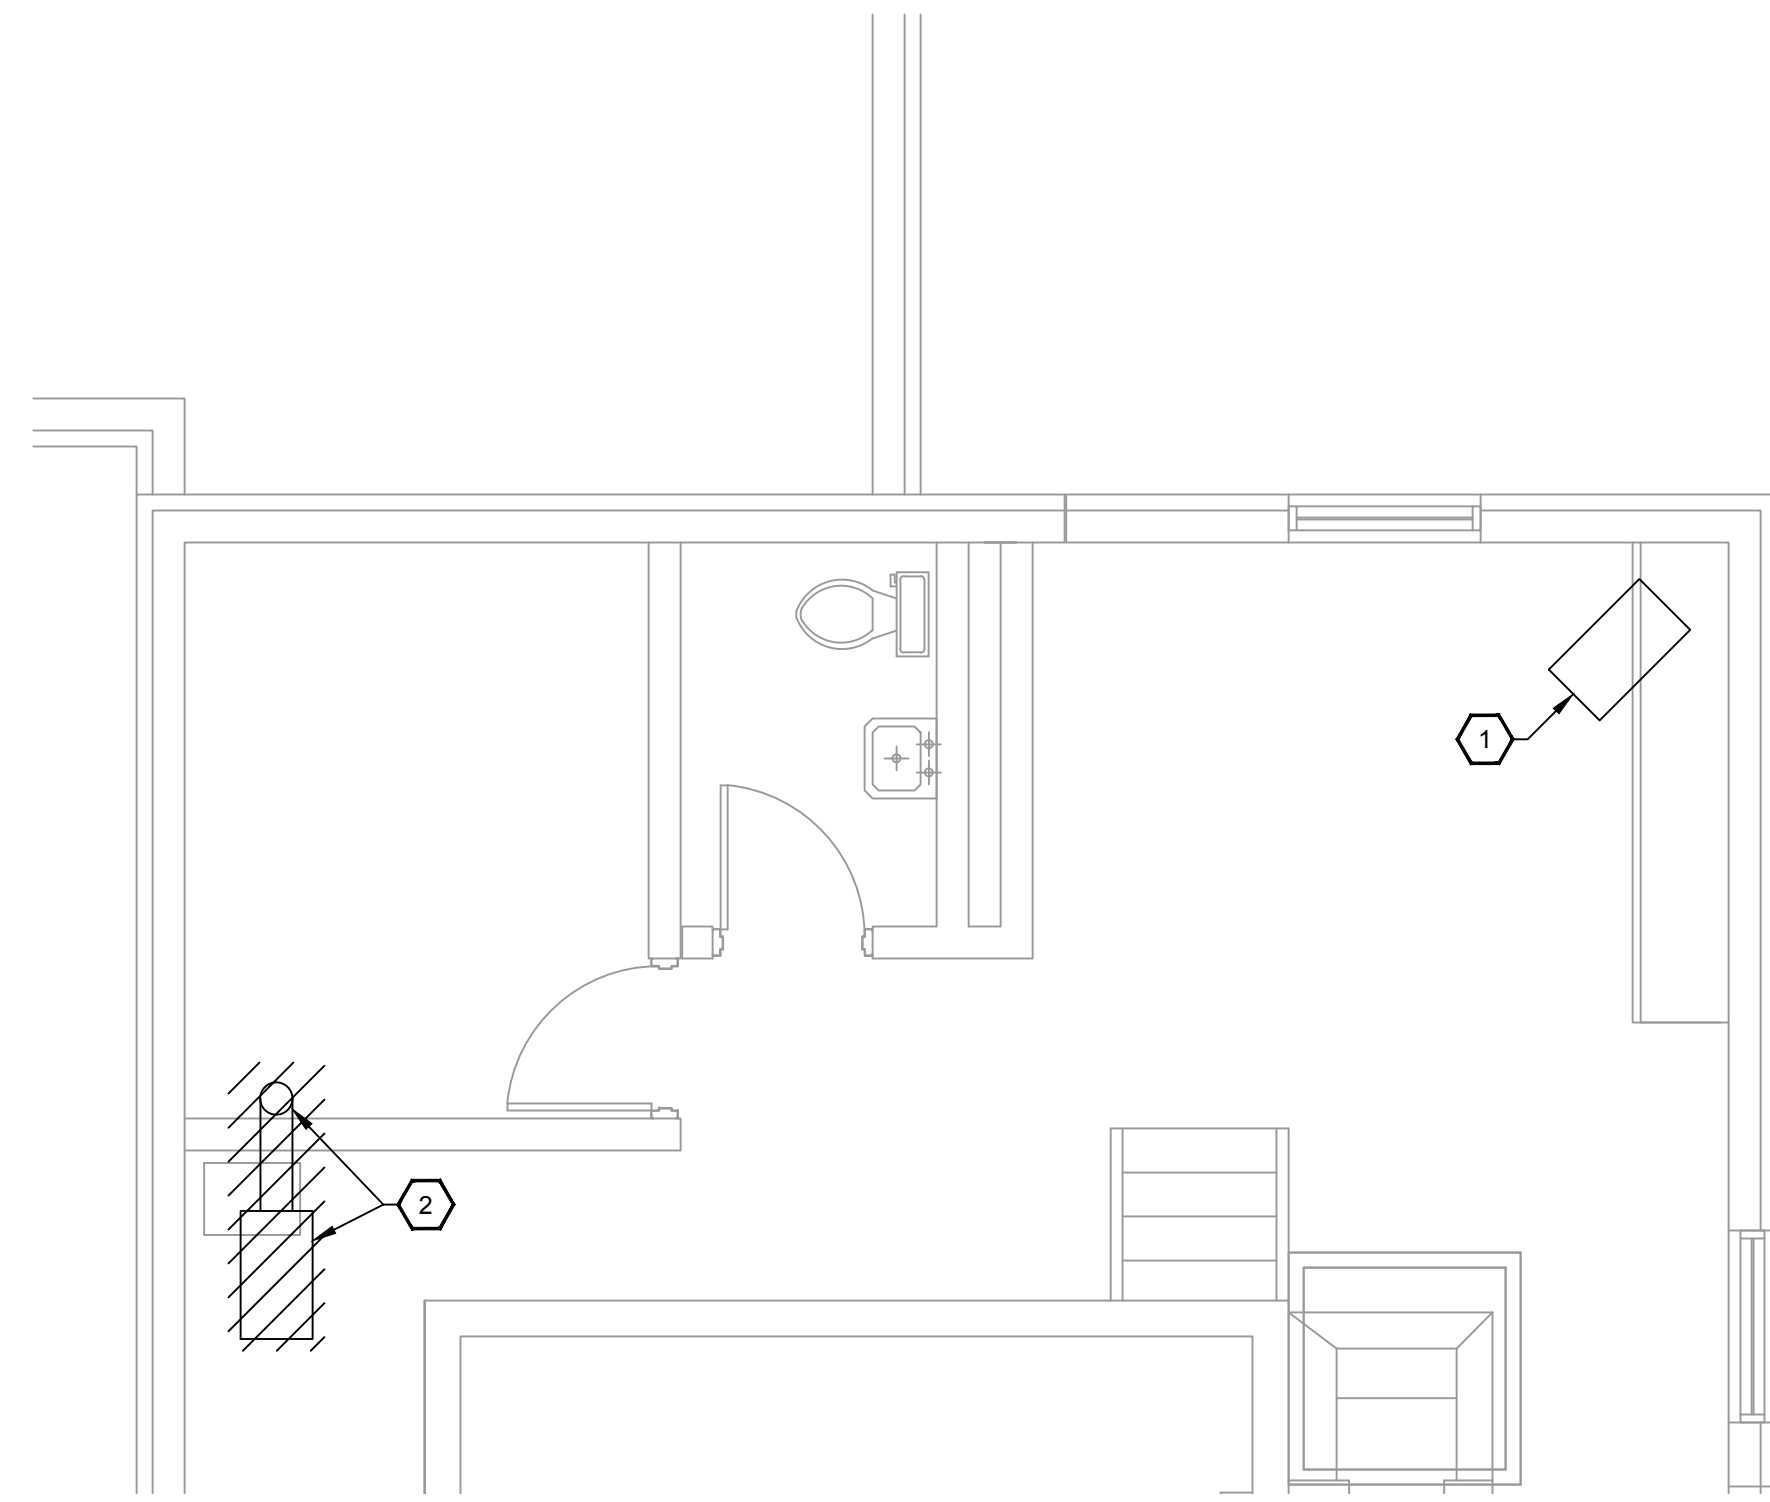


BELT FILTER PRESS - SECOND FLOOR HVAC DEMOLITION PLAN

SCALE: 1/4"=1'-0"

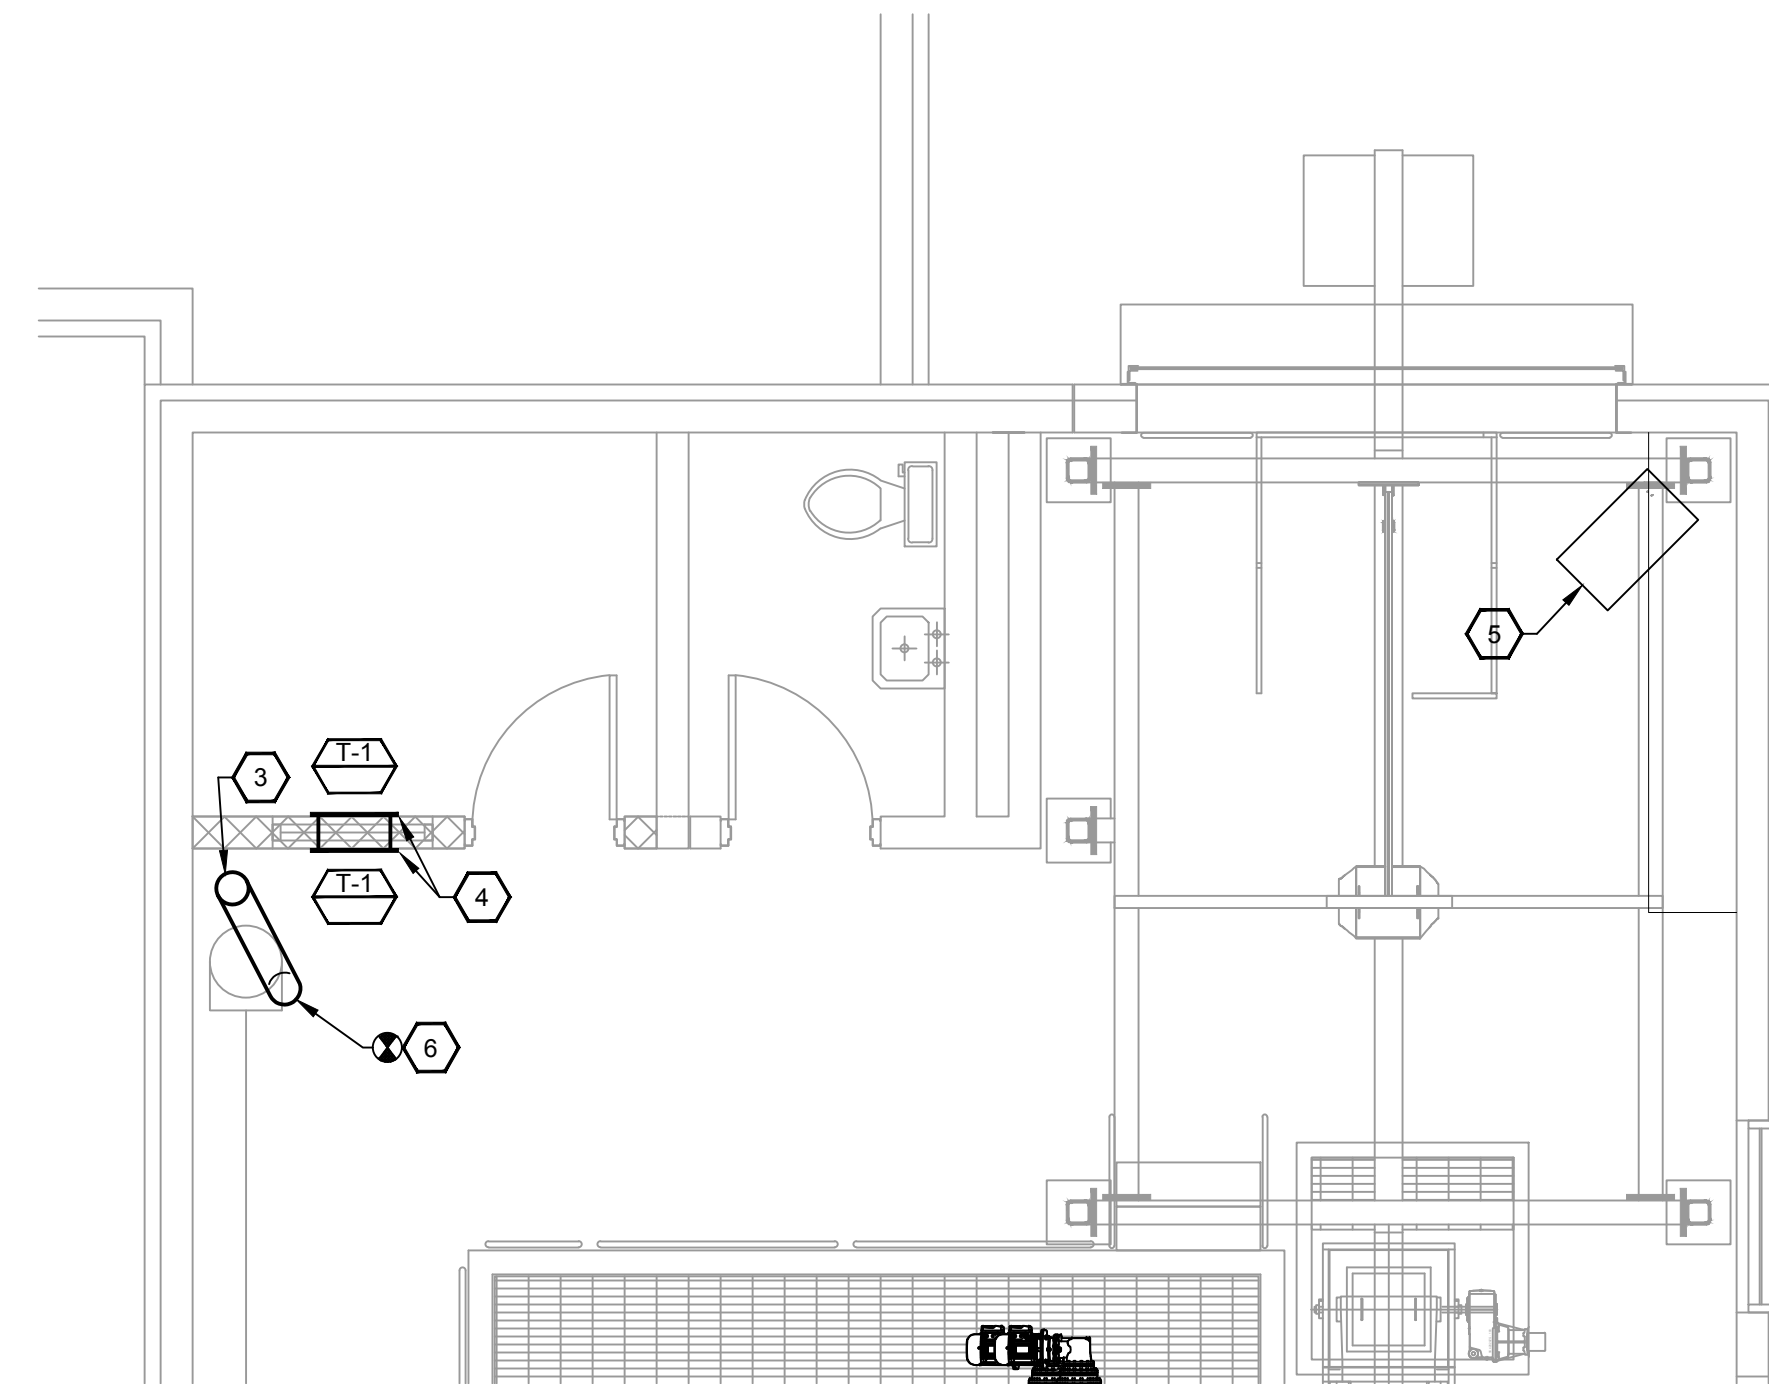


BELT FILTER PRESS - SECOND FLOOR HVAC NEW WORK PLAN

SCALE: 1/4"=1'-0"

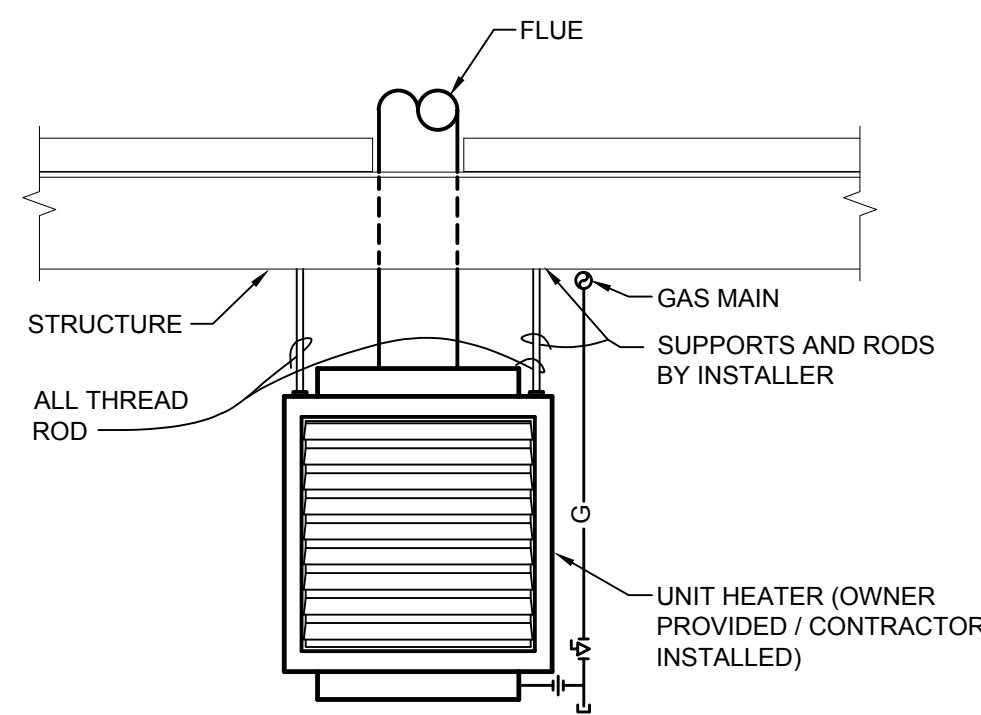

1 TYPICAL GAS UNIT HEATER DETAIL
NOT TO SCALE

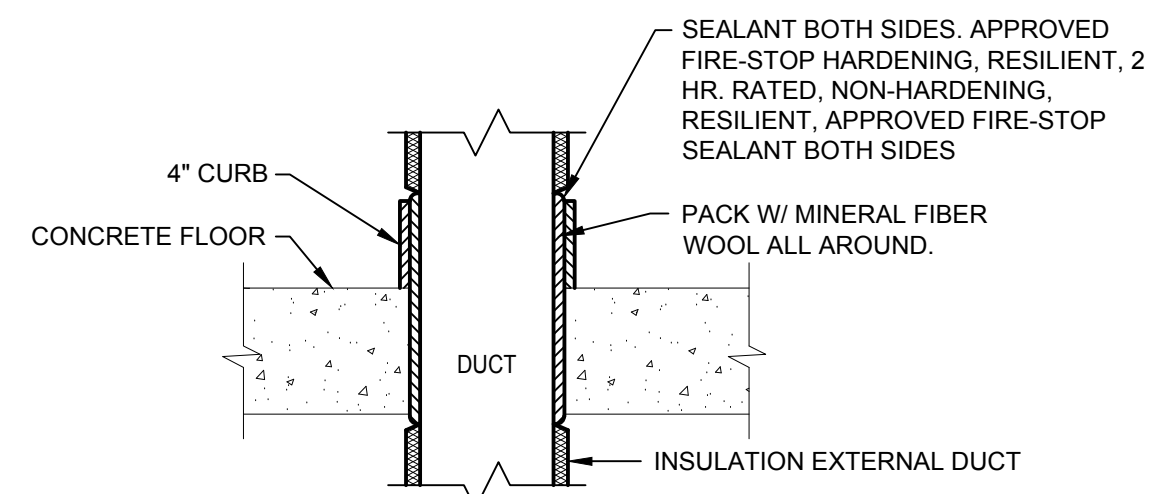

2 FIRE/SMOKE RATED DUCT FLOOR PENETRATION DETAIL
NOT TO SCALE

AIR DEVICES SCHEDULE												
MARK	SERVICE	TYPE	MODULE SIZE IN	MAX. AIR PD IN WG	MAX. NC	THROW FT @ 50 FPM	PATTERN	MATERIAL	MAX. CFM	MAX. CONNECT SIZE IN (DIM)	MOUNTING	REMARKS
T-1	TRANSFER	1	24x24	0.10	30	---	GRILLE	ALUMINUM	250	22x22	SURFACE	1, 2


TYPE:
1. EGG CRATE GRILLES, 1/2" X 1/2" X 1" DEEP CORE

REMARKS:
1. EGG CRATE GRILLE BASIS OF DESIGN: TITUS MODEL 50F
2. BRONZ-GLOW SPC CLEAR F-860 COATED OR APPROVED EQUAL

GRW PROJECT NO. 4384

CLIENT PROJECT NO.

ALL RIGHTS RESERVED. NO PART OF THIS DOCUMENT IS TO BE REPRODUCED IN WHOLE OR IN PART WITHOUT THE WRITTEN PERMISSION OF GRW ENGINEERS, INC. ANY OTHER THAN THIS SPECIFIC PROJECT WITHOUT WRITTEN PERMISSION.

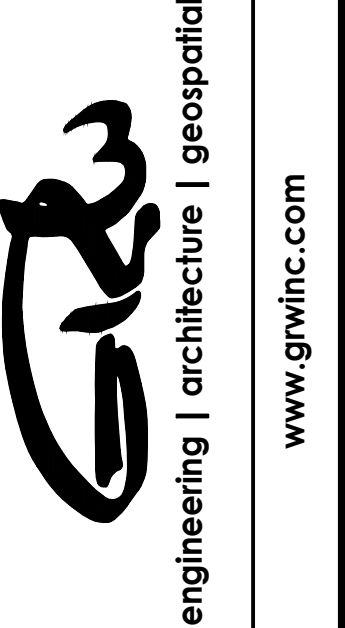

BELT FILTER PRESS REPLACEMENT HVAC PLANS
TAYLOR MILL TREATMENT PLANT
NORTHERN KENTUCKY WATER DISTRICT

NO.	DATE	DESCRIPTION	DESIGNED	BY	DATE	DESCRIPTION
			AAT	DATE	DESCRIPTION	
1						

DATE: APRIL, 2019
SCALE: AS SHOWN
SHEET NO.

THIS RECORD DOCUMENT HAS BEEN PREPARED BASED ON INFORMATION PROVIDED BY THE CONSTRUCTION CONTRACTOR GRW ENGINEERS, INC. HAS ATTEMPTED TO VERIFY THE ACCURACY AND/OR COMPLETENESS OF THIS INFORMATION BUT SHALL NOT BE RESPONSIBLE FOR ANY ERRORS OR OMISSIONS WHICH MAY BE INCORPORATED HEREIN AS A RESULT.


ENGINEER/ARCHITECT: David C. Osborne
CONSTRUCTION COMPANY: Dugan & Meyers
DATE: 4/23/19

M-101

PLOTTED BY: mwilliamson


PRINTED: 4/23/2019 @ 2:39PM

FILE NAME: U:\4384-NK\VD T\TTP BFP\Working Drawings\AutoCAD\4384 P-101.dwg

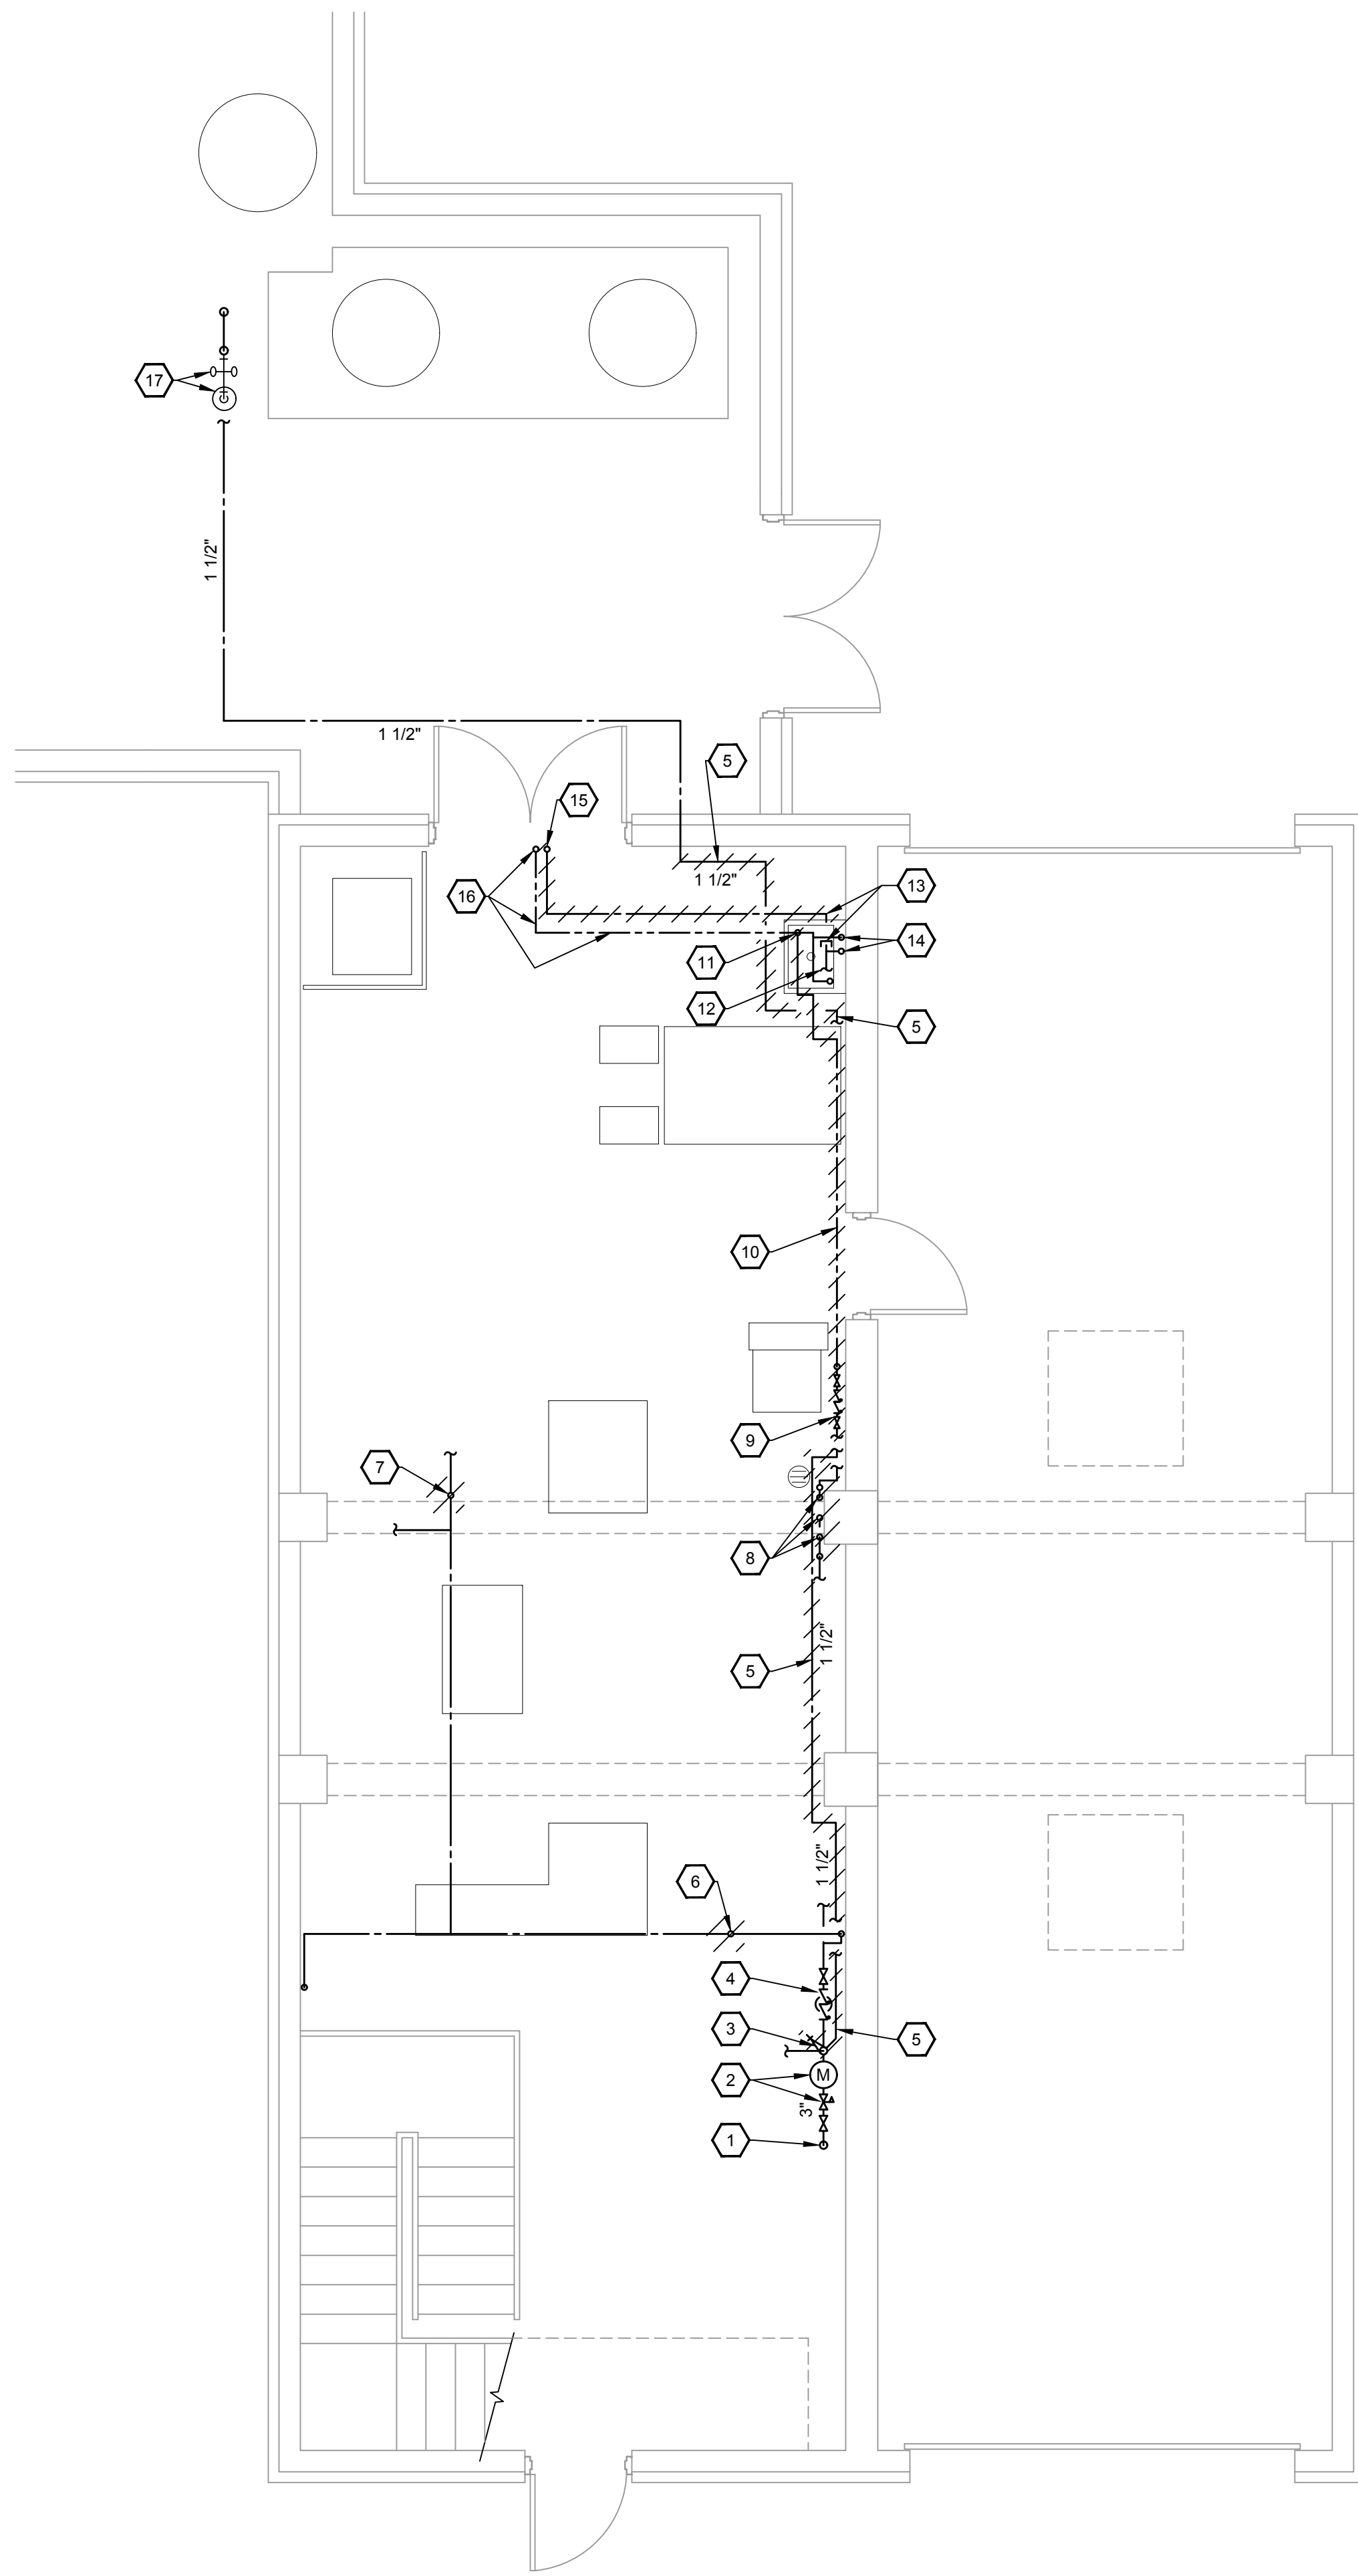

**BELT FILTER PRESS - FIRST FLOOR
PLUMBING DEMOLITION PLAN**

SCALE: 1/4"=1'-0"

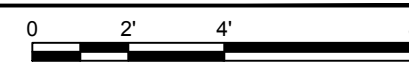


GENERAL NOTES:

1. SEE SHEET M-001 FOR LEGEND AND ADDITIONAL GENERAL NOTES.
2. SEE SPECIFICATION SECTION 017329 FOR CUTTING AND PATCHING.
3. ALL WATER PIPE BEING DEMOLISHED SHALL BE REMOVED TO POINT OF ACTIVE USE AND CAPPED. NO WATER FILLED DEAD ENDS ARE TO REMAIN.
4. SALVAGE OF PIPE AND EQUIPMENT AS INDICATED IN SPECIFICATION 024100.


KEYNOTE SHEET KEYNOTES:

1. EXISTING 3" DOMESTIC WATER SERVICE ENTRANCE.
2. EXISTING PRV AND WATER METER.
3. REMOVE EXISTING 1 1/2" POTABLE WATER PIPE WITH SHUT-OFF VALVE AND PRV IN RISER. SEE NEW PLAN FOR RECONNECTIONS.
4. EXISTING BACKFLOW PREVENTER FOR PROCESS WATER.
5. REMOVE EXISTING 1 1/2" POTABLE WATER PIPE.
6. REMOVE EXISTING WATER PIPE UP TO SECOND FLOOR HOSE BIBBS AND SAFETY STATION. CAP PIPE AT BRANCH TAKE-OFF.
7. REMOVE EXISTING WATER PIPE UP TO SECOND FLOOR BELT FILTER PRESS. CAP PIPE AT BRANCH TAKE-OFF.
8. REMOVE ALL ABANDONED/UNUSED WATER PIPE AND ALL ASSOCIATED APPURTENANCES.
9. REMOVE EXISTING ABANDONED/UNUSED BACKFLOW PREVENTER.
10. REMOVE EXISTING ABANDONED/UNUSED HOT WATER PIPE.
11. CAP EXISTING HOT WATER PIPE AT BRANCH TAKE-OFF TO EXISTING POLYMER SYSTEM. HOT WATER PIPE TO JANITOR SINK AND SECOND FLOOR LAVATORY TO REMAIN IN USE.
12. REMOVE EXISTING POTABLE DW PIPE BEYOND POINT OF CONNECTION TO JANITOR SINK AND PIPE UP TO TOILET ROOM PLUMBING CHASE. SEE NEW WORK PLAN FOR RECONNECTION.
13. CAP EXISTING POTABLE CW PIPE DOWNSTREAM OF LAST PLUMBING FIXTURE BEING SERVED. REMOVE PIPE BEYOND CAP.
14. EXISTING POTABLE CW & HW PIPING TO REMAIN.
15. REMOVE EXISTING POTABLE CW PIPE UP TO WATER HEATER IN SECOND FLOOR STORAGE ROOM.
16. EXISTING HW PIPE TO REMAIN IN USE.
17. EXISTING SAFETY STATION TO REMAIN.
18. EXISTING WATER HEATER AND EXPANSION TANK TO REMAIN.
19. REMOVE EXISTING POTABLE CW PIPE DOWN TO FIRST FLOOR.
20. EXISTING HW PIPE DOWN TO FIRST FLOOR TO REMAIN.
21. REMOVE EXISTING 3/4" WATER PIPE UP TO BELOW CEILING AND ASSOCIATED SHUT-OFF VALVE. REMOVE PIPE ONLY AS REQUIRED FOR NEW WORK. SEE NEW WORK PLAN FOR RECONNECTIONS.
22. REMOVE EXISTING HW PIPE TO DEMOLISHED TANK. SEE NEW WORK PLAN FOR RECONNECTION.
23. REMOVE EXISTING BALL VALVE, HOSE BIBB AND ALL ASSOCIATED PIPING.
24. REMOVE EXISTING PRV's, BFP AND PIPE DOWN TO FIRST FLOOR.
25. REMOVE EXISTING SAFETY STATION, ASSOCIATED STORAGE TANK, ALL ASSOCIATED PIPES AND APPURTENANCES.
26. EXISTING FLOOR DRAIN TO REMAIN.
27. REMOVE EXISTING CW PIPE INSTALLED ALONG BELT FILTER PRESS RETAINING WALL.
28. REMOVE EXISTING CW PIPE SERVING THE BELT FILTER PRESS AND ALL ASSOCIATED APPURTENANCES. REMOVE PIPE DOWN TO THE FIRST FLOOR.

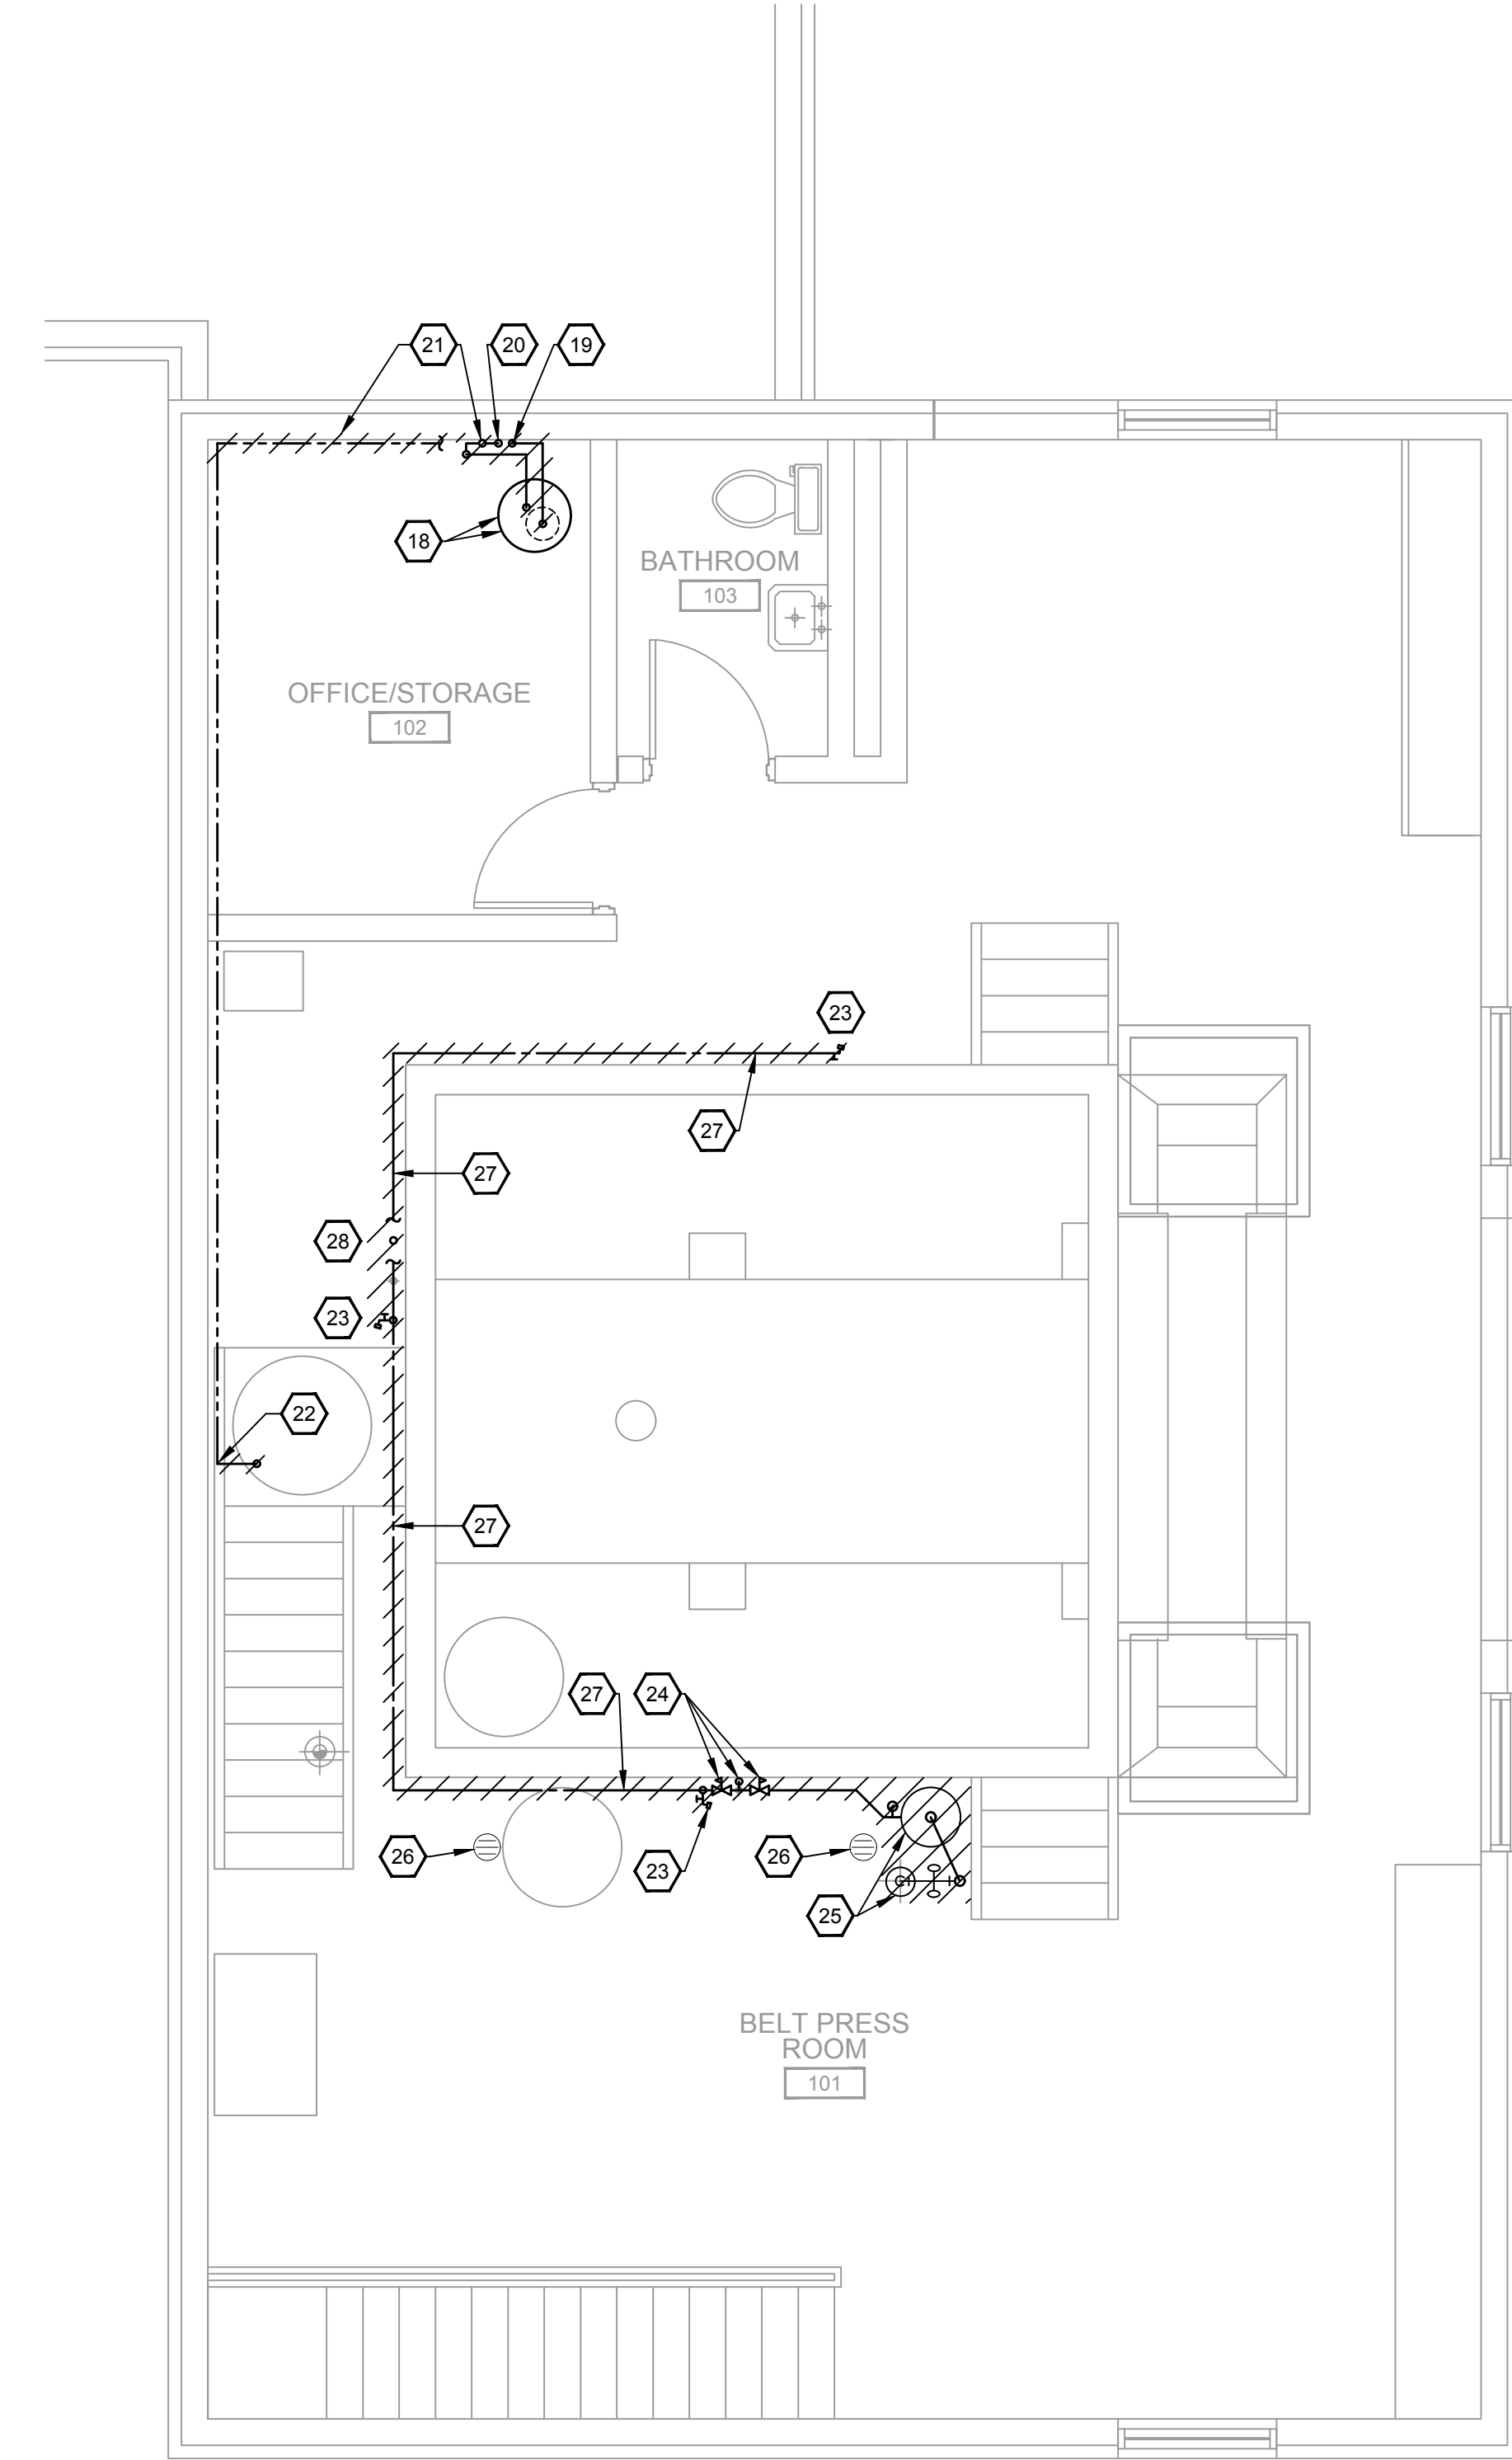

**BELT FILTER PRESS - SECOND FLOOR
PLUMBING DEMOLITION PLAN**

SCALE: 1/4"=1'-0"

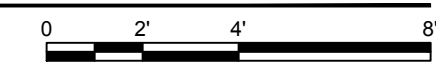

THIS RECORD DOCUMENT HAS BEEN PREPARED BASED ON INFORMATION PROVIDED BY THE CONSTRUCTION CONTRACTOR GRW ENGINEERS, INC. HAS ATTEMPTED TO VERIFY THE ACCURACY AND/OR COMPLETENESS OF THIS INFORMATION BUT SHALL NOT BE RESPONSIBLE FOR ANY ERRORS OR OMISSIONS WHICH MAY BE INCORPORATED HEREIN AS A RESULT.


GRW
engineering | architecture | geospatial
www.grwinc.com

ENGINEER/ARCHITECT: David C. Osborne
CONSTRUCTION COMPANY: Dugan & Meyers
DATE: 4/23/19

GRW PROJECT NO. 4384

CLIENT PROJECT NO.

ALL RIGHTS RESERVED. NO PART OF THIS DOCUMENT SHALL BE REPRODUCED IN WHOLE OR IN PART WITHOUT THE WRITTEN PERMISSION OF GRW ENGINEERS, INC. AND SHALL NOT BE USED FOR ANY OTHER PROJECT OTHER THAN THIS SPECIFIC PROJECT WITHOUT WRITTEN PERMISSION.

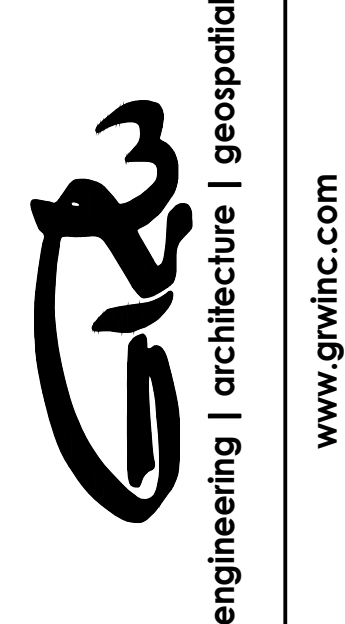

**BELT FILTER PRESS REPLACEMENT
PLUMBING DEMOLITION PLANS**
TAYLOR MILL TREATMENT PLANT
NORTHERN KENTUCKY WATER DISTRICT

DESIGNED	MAS
DRAWN	MAS
REVIEWED	AAT
APPROVED	AAT

NO.	DATE	DESCRIPTION

SCALE CHECK: THIS MARK SHOULD MEASURE EXACTLY 1" WHEN PLOTTED

DATE: APRIL, 2019
SCALE: 1/4" = 1'-0"
SHEET NO.


P-101

RECORD DOCUMENTS

PLOTTED BY: mwilliamson

PRINTED: 4/26/2019 @ 10:58PM

FILE NAME: U:\4384-NKWD\T\1TP BFP\Working Drawings\AutoCAD\4384 P-102.dwg

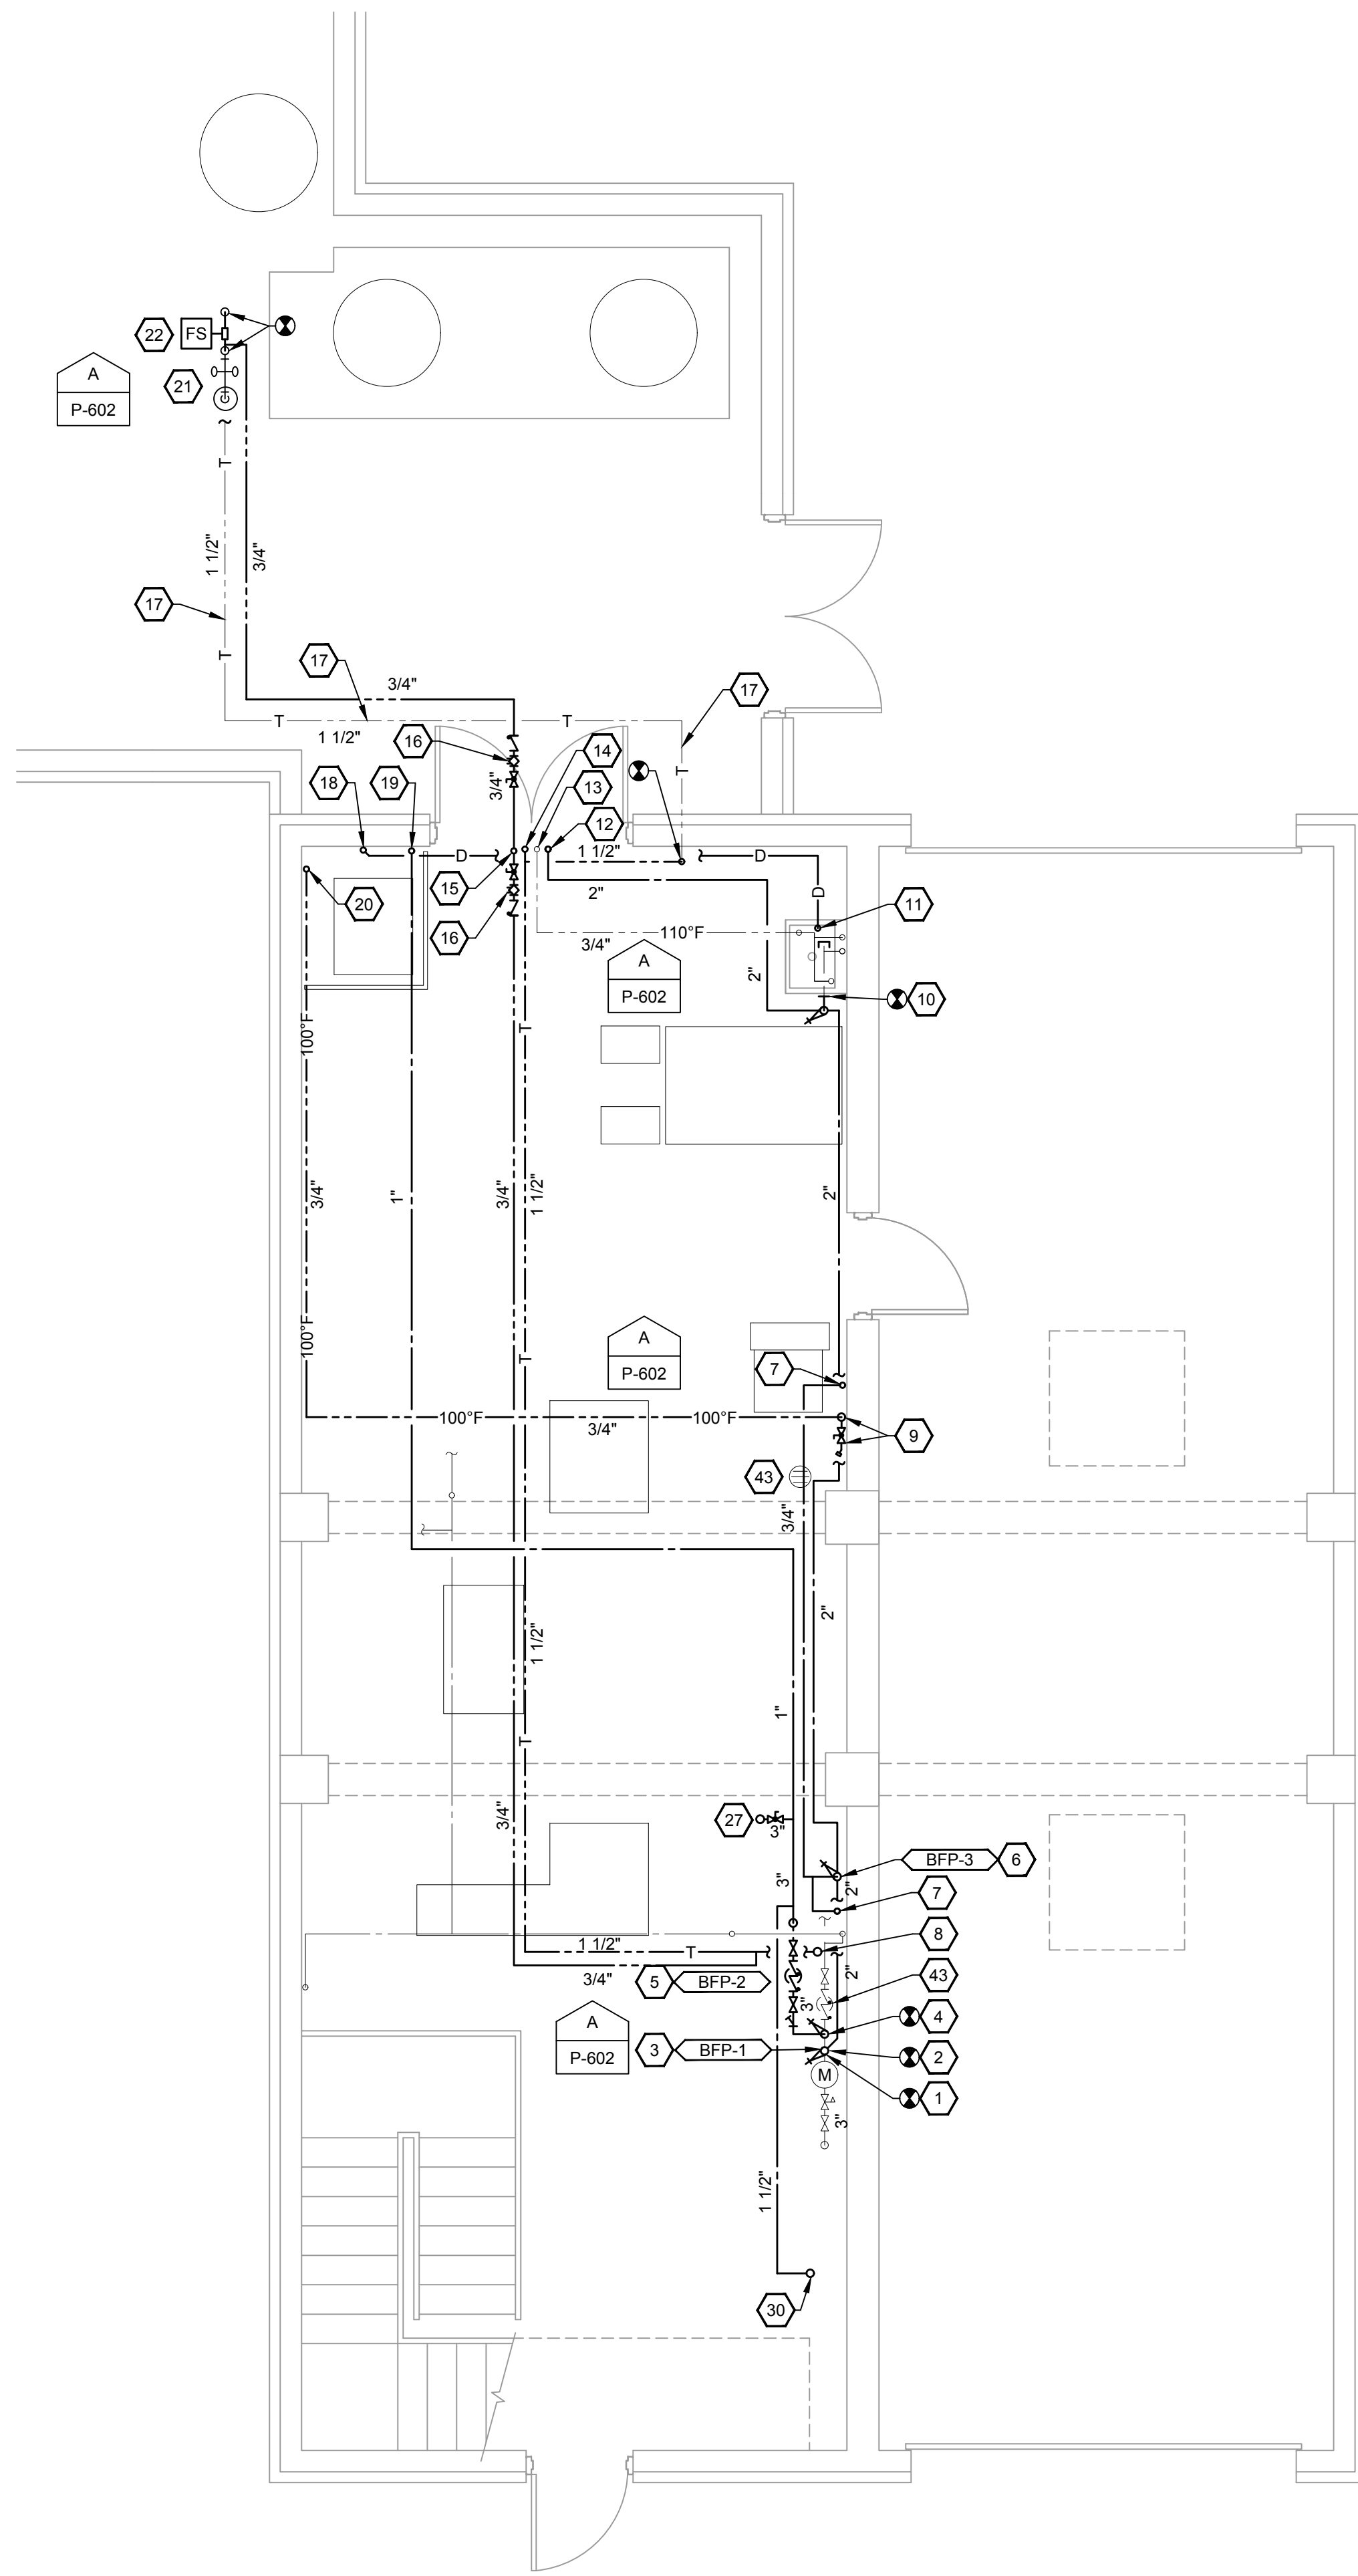

**BELT FILTER PRESS - FIRST FLOOR
PLUMBING NEW WORK PLAN**


SCALE: 1/4"=1'-0" 0 2 4 8

GENERAL NOTES:

1. SEE SHEET M-001 FOR LEGEND AND ADDITIONAL GENERAL NOTES.
2. SEE SPECIFICATION SECTION 017329 FOR CUTTING AND PATCHING.
3. SEE DETAILS AND RISER DIAGRAMS FOR VALVES AND APPURTENANCES REQUIRED FOR PUMP, TMV's, BACKFLOW PREVENTERS AND WATER HEATER.

SHEET KEYNOTES:

1. PROVIDE 2" POTABLE WATER RISER AND CONNECT TO EXISTING 3" POTABLE CW HEADER. PROVIDE SHUT-OFF VALVE AND PRV IN RISER.
2. CONNECT TO EXISTING 1 1/4" POTABLE WATER PIPE AS REQUIRED TO SUPPLY REMAINING EXISTING FIXTURES/SPECIALTIES.
3. PROVIDE BFP-1 WITH STRAINER IN RISER. EXTEND DRAIN FROM AIR GAP FITTING TO EXISTING FLOOR DRAIN.
4. PROVIDE 3" CW RISER FOR BELT PRESS FILTER SYSTEM AND POLYMER SYSTEMS. CONNECT TO EXISTING 3" CW HEADER. PROVIDE SHUT-OFF VALVE AND PRV IN RISER. COORDINATE PRV SETTING WITH BELT FILTER MANUFACTURER'S REQUIREMENTS.
5. PROVIDE BFP-2 WITH STRAINER (SHOWN HERE FOR CLARITY) ABOVE EXISTING BFP. INSTALL TO RETAIN ACCESS TO EXISTING BFP. EXTEND DRAIN FROM AIR GAP FITTING TO EXISTING FLOOR DRAIN.
6. PROVIDE SHUT-OFF VALVE AND BFP IN RISER. EXTEND DRAIN PIPE FROM AIR GAP FITTING TO EXISTING FLOOR DRAIN.
7. PROVIDE 3/4" POTABLE CW UP TO HOSE REEL. CORE DRILL FLOOR TO ACCOMMODATE PIPE AND FIRE STOPPING. SEE DETAIL, SHEET P-601.
8. PROVIDE 1 1/2" TEPID WATER PIPE UP TO SAFETY STATION ON SECOND FLOOR.
9. PROVIDE 3/4" HW DOWN TO EXISTING POLYMER SYSTEM. PROVIDE WITH BALL VALVE AND 3/4" HOSE CONNECTION.
10. CONNECT TO EXISTING 1 1/4" POTABLE CW PIPE.
11. PROVIDE 1" DRAIN PIPE FROM BACKFLOW PREVENTERS DOWN TO JANITOR'S SINK.
12. PROVIDE 2" POTABLE CW PIPE UP TO SECOND FLOOR STORAGE ROOM. CORE DRILL AND ENLARGE EXISTING FLOOR OPENING AS REQUIRED TO ACCOMMODATE LARGER PIPE AND FIRE STOPPING. SEE DETAIL, SHEET P-601.
13. EXISTING HW PIPE UP TO SECOND FLOOR STORAGE ROOM.
14. PROVIDE 2" TEPID WATER PIPE UP TO SECOND FLOOR STORAGE ROOM. CORE DRILL FLOOR AS REQUIRED TO ACCOMMODATE PIPE AND FIRE STOPPING. SEE DETAIL, SHEET P-601.
15. PROVIDE 3/4" TEPID WATER RECIRCULATING PIPE UP TO SECOND FLOOR STORAGE ROOM. CORE DRILL OPENING AS REQUIRED TO ACCOMMODATE PIPE AND FIRE STOPPING. SEE DETAIL, SHEET P-601.
16. PROVIDE BALANCING VALVE.
17. REPURPOSE EXISTING POTABLE CW PIPE TO SAFETY STATION FOR TEPID WATER SUPPLY TO SAFETY STATION.
18. PROVIDE 1" DRAIN FROM BACKFLOW PREVENTERS UP TO SECOND FLOOR.
19. PROVIDE 1" CW PIPE UP TO BFP-4 IN SECOND FLOOR STORAGE ROOM.
20. PROVIDE 3/4" HOT WATER UP TO SECOND FLOOR STORAGE ROOM.
21. EXISTING SAFETY STATION.
22. PROVIDE FLOW SWITCH FOR SAFETY STATION.
23. PROVIDE 1 1/2" TEPID WATER PIPE DOWN TO FIRST FLOOR.
24. COORDINATE SAFETY STATION LOCATION WITH BELT PRESS MANUFACTURER'S ACCESSIBILITY REQUIREMENTS. COORDINATE LOCATION WITH OWNER.
25. PROVIDE HOSE REEL MOUNTED ON FLOOR.
26. PROVIDE 3/4" CW DOWN TO FIRST FLOOR. CORE DRILL FLOOR AS REQUIRED TO ACCOMMODATE PIPE AND FIRE STOPPING. SEE DETAIL, SHEET P-601.
27. PROVIDE 2" CW SERVING BELT PRESS SHOWER ASSEMBLY UP TO SECOND FLOOR. COORDINATE LOCATION WITH BELT PRESS MANUFACTURER. CORE DRILL FLOOR AS REQUIRED TO ACCOMMODATE PIPE AND FIRE STOPPING. SEE DETAIL, SHEET P-601.
28. PROVIDE 2" CW SERVING BELT PRESS SHOWER ASSEMBLY DOWN TO FIRST FLOOR. CORE DRILL FLOOR AS REQUIRED TO ACCOMMODATE PIPE AND FIRE STOPPING. INSTALL PIPE THROUGH CONTAINMENT WALL DIRECTLY BELOW GRATING. SEE DETAIL, SHEET P-601.
29. CONNECT TO EXISTING 3/4" HW PIPE.
30. PROVIDE 1 1/2" CW UP TO SECOND FLOOR.
31. EXISTING WATER HEATER AND EXPANSION TANK. RESET WATER HEATER'S OUTGOING TEMPERATURE TO 140°F.
32. PROVIDE 2" POTABLE CW DOWN TO FIRST FLOOR. CORE DRILL AND ENLARGE FLOOR OPENING AS REQUIRED TO ACCOMMODATE LARGER PIPE AND FIRE STOPPING. SEE DETAIL, SHEET P-601.
33. PROVIDE 1 10" F PIPE AND CONNECT TO EXISTING HW PIPE DOWN TO FIRST FLOOR. NEW PIPE SIZED TO MATCH EXISTING PIPE.
34. PROVIDE 2" TEPID WATER DOWN TO FIRST FLOOR. CORE DRILL FLOOR TO ACCOMMODATE PIPE AND FIRE STOPPING. SEE DETAIL, SHEET P-601.
35. PROVIDE 3/4" TEPID WATER RECIRCULATING PIPE DOWN TO FIRST FLOOR. CORE DRILL FLOOR AS REQUIRED TO ACCOMMODATE PIPE AND FIRE STOPPING. SEE DETAIL, SHEET P-601.
36. PROVIDE TEPID WATER RECIRCULATING PUMP MOUNTED TO WALL @ 4'-6" AFF.
37. PROVIDE TEMPERING VALVE MOUNTED TO WALL @ 4'-0" AFF.
38. PROVIDE 1" CW PIPE DOWN TO FIRST FLOOR. PROVIDE SHUT-OFF VALVE AND PRV IN RISER.
39. PROVIDE BFP-4 WITH STRAINER IN RISER. MOUNT PER MANUFACTURER'S REQUIREMENTS. SEE NOTE 41 FOR CONTINUATION OF DRAIN FROM AIR GAP FITTING.
40. PROVIDE BFP-5 WITH STRAINER. MOUNT PER MANUFACTURER'S REQUIREMENTS. SEE NOTE 41 FOR CONTINUATION OF DRAIN FROM AIR GAP FITTING.
41. COMBINE 3/4" DRAINS FROM BFP-4 & BFP-5 AIR GAP FITTINGS INTO 1" DRAIN AND EXTEND DOWN TO FIRST FLOOR (SHOWN HERE FOR CLARITY).
42. PROVIDE 3/4" 100°F WATER DOWN TO BELOW FIRST FLOOR CEILING AND UP TO BELOW SECOND FLOOR CEILING.
43. EXISTING FLOOR DRAIN.
44. PROVIDE MAINTENANCE VALVE (VALVE NORMALLY OPEN).
45. PROVIDE 3/4" HW AND CONNECT TO POLYMER FEED PIPE.
46. PROVIDE 1 1/2" CW PIPE DOWN TO FIRST FLOOR. CORE DRILL FLOOR AS REQUIRED TO ACCOMMODATE PIPE AND FIRE STOPPING. SEE DETAIL, SHEET P-601.
47. PROVIDE CW PIPE FASTENED TO TOP OF RETAINING WALL.
48. PROVIDE 1 1/2" CW PIPE AND CONNECT TO POLYMER UNIT.
49. PROVIDE 1 1/2" CW PIPE AND CONNECT TO POLYMER TANK.
50. PROVIDE SOLENOID VALVE.
51. CONTROL WIRING FOR SOLENOID VALVES. SEE ELECTRICAL SHEET E-702 FOR SEQUENCING.

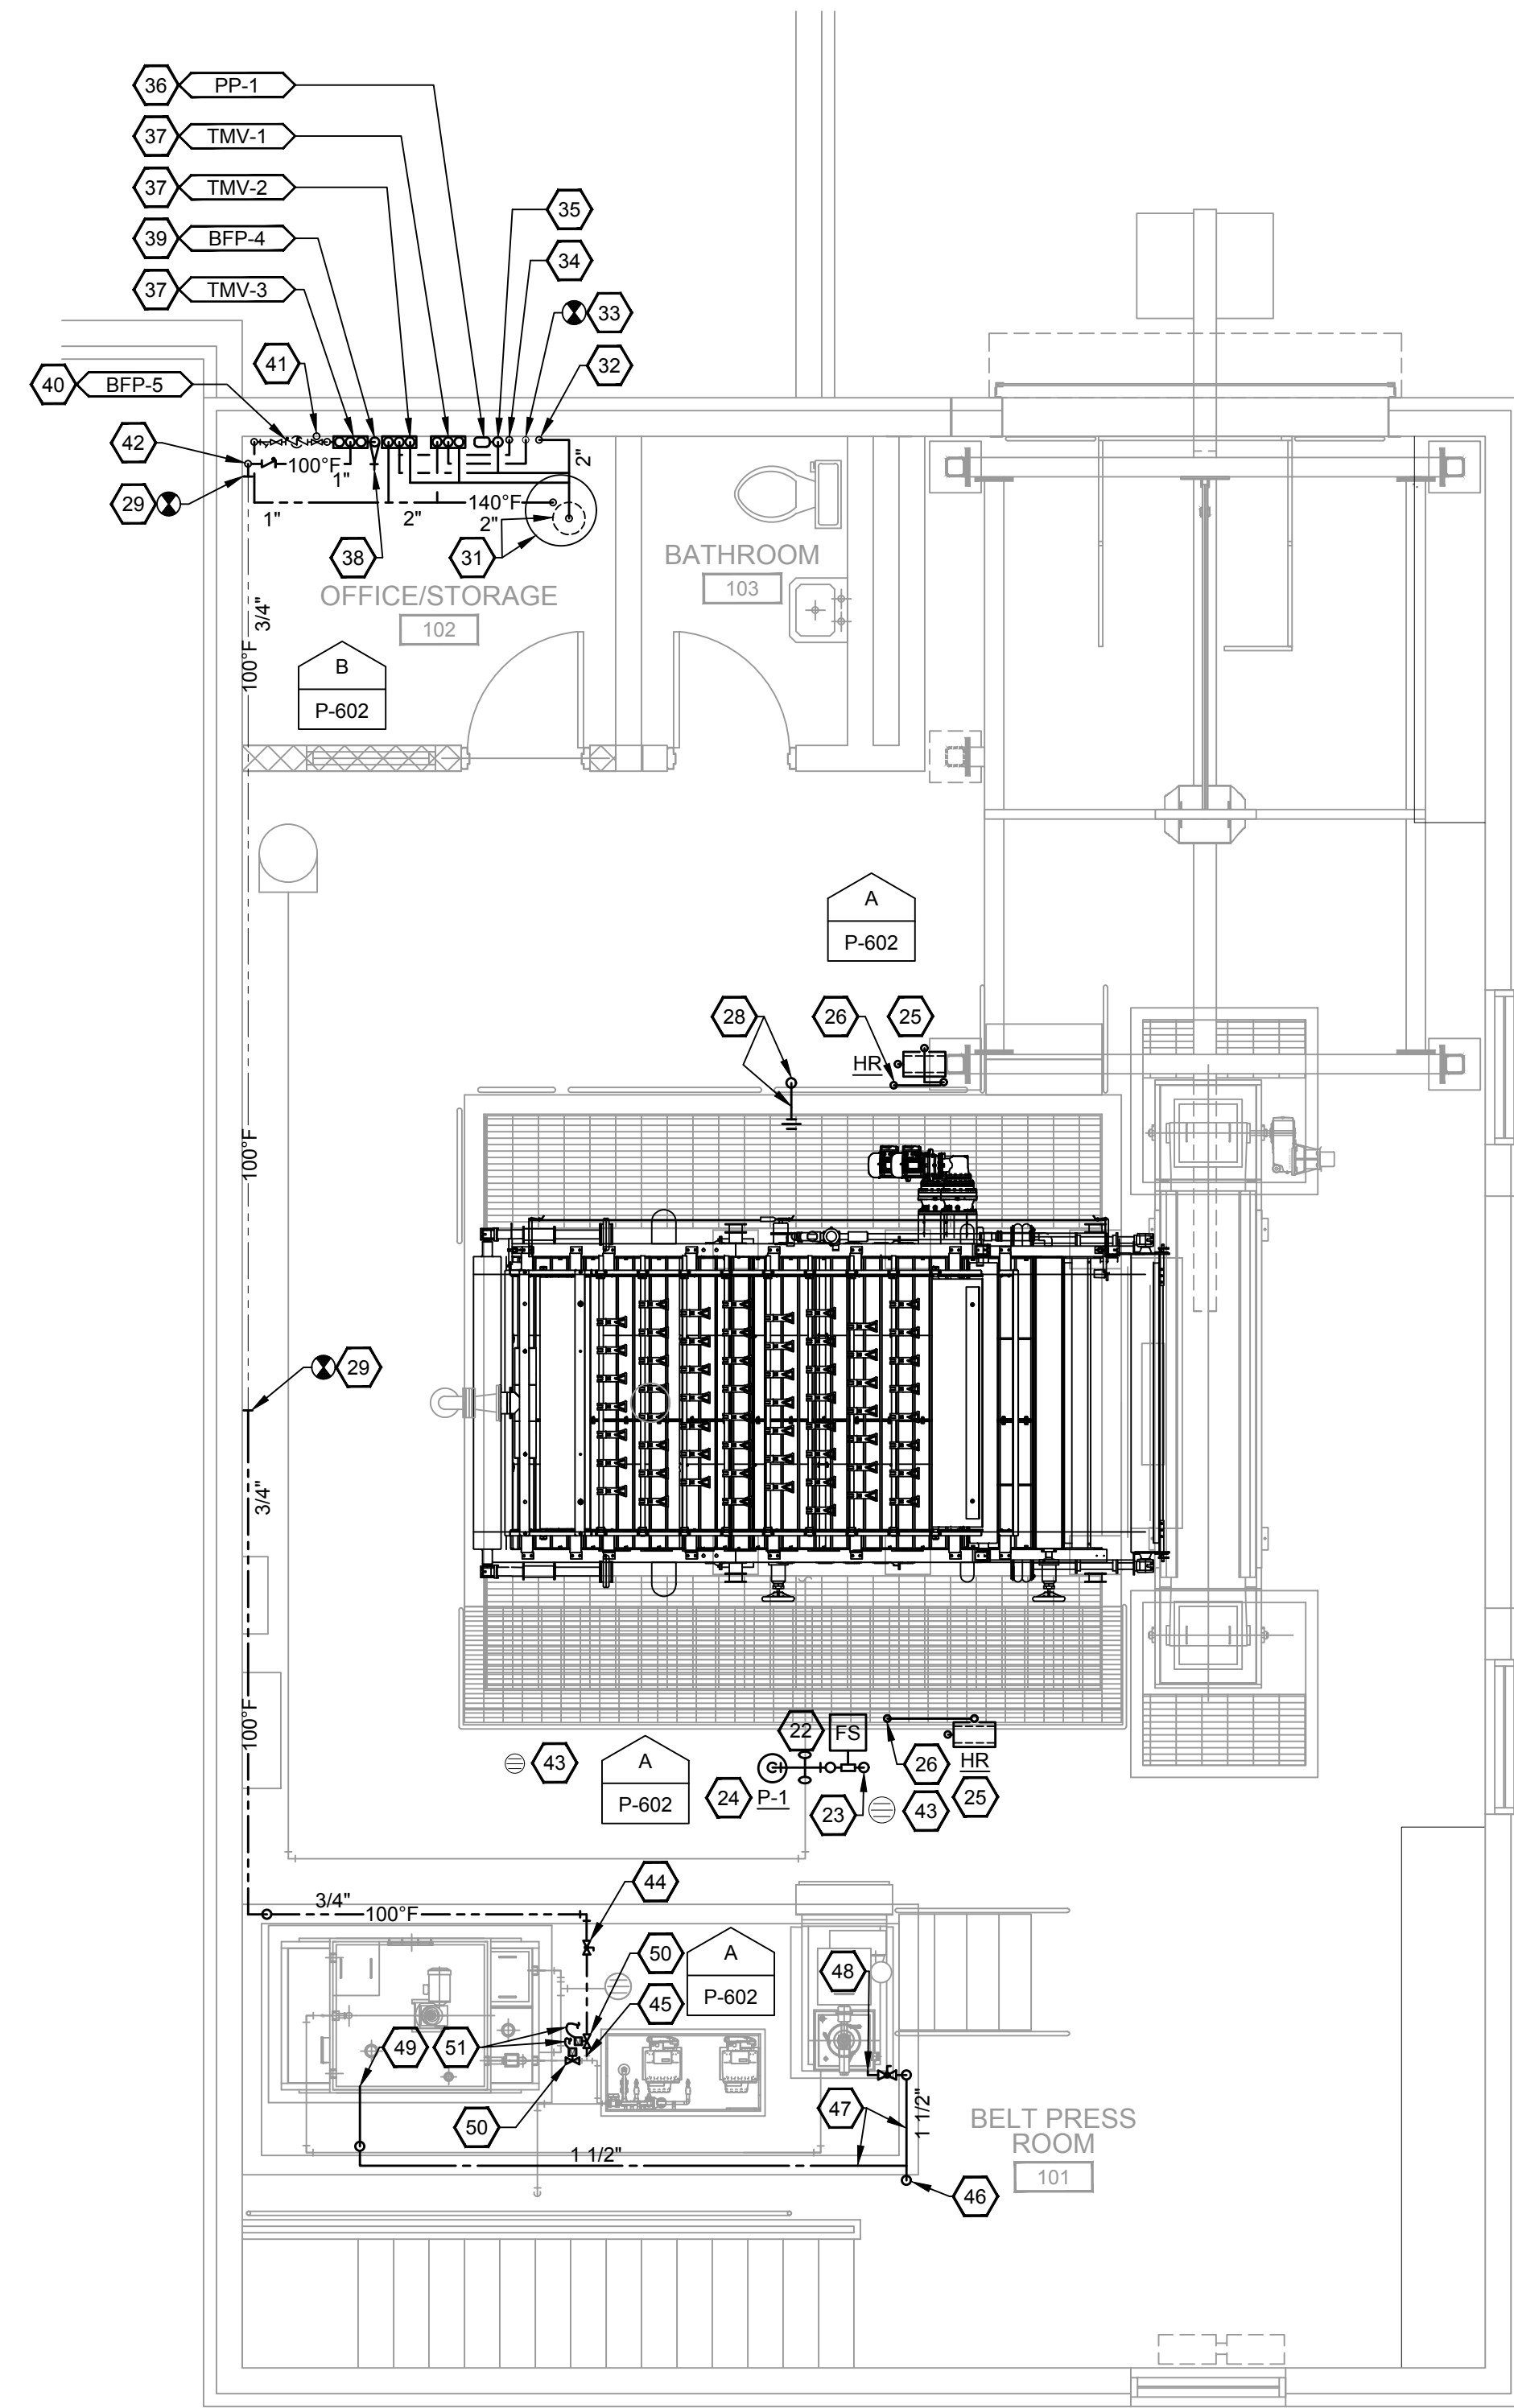

**BELT FILTER PRESS - SECOND FLOOR
PLUMBING NEW WORK PLAN**

SCALE: 1/4"=1'-0" 0 2 4 8


THIS RECORD DOCUMENT HAS BEEN PREPARED BASED ON INFORMATION PROVIDED BY THE CONSTRUCTION CONTRACTOR. GRW ENGINEERS, INC. HAS ATTEMPTED TO VERIFY THE ACCURACY AND/OR COMPLETENESS OF THIS INFORMATION BUT SHALL NOT BE RESPONSIBLE FOR ANY ERRORS OR OMISSIONS WHICH MAY BE INCORPORATED HEREIN AS A RESULT.

GRW
engineering | architecture | geospatial
www.grwinc.com

ENGINEER/ARCHITECT: David C. Osborne
CONSTRUCTION COMPANY: Dugan & Meyers
DATE: 4/23/19

GRW PROJECT NO. 4384

CLIENT PROJECT NO.

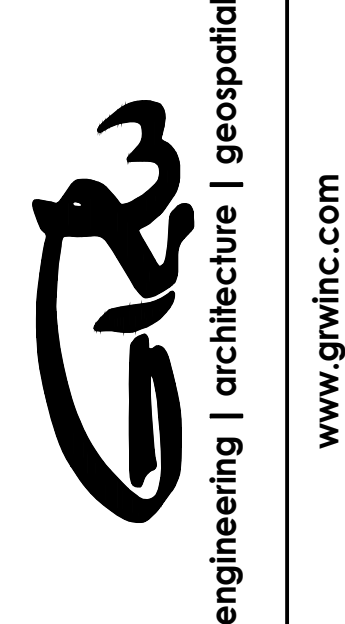

**BELT FILTER PRESS REPLACEMENT
PLUMBING NEW WORK PLANS**
TAYLOR MILL TREATMENT PLANT
NORTHERN KENTUCKY WATER DISTRICT

DESIGNED	MAS
DRAWN	MAS
REVIEWED	AAT
APPROVED	AAT

NO.	DATE	DESCRIPTION

SCALE CHECK: THIS MARK SHOULD MEASURE EXACTLY 1" WHEN PLOTTED

DATE: APRIL, 2019
SCALE: 1/4" = 1'-0"
SHEET NO.

PLUMBING FIXTURES

MARK NO.	FIXTURE	DESCRIPTION (BASIS OF DESIGN)	PIPE SIZES			
			HW SUPPLY	HW BRANCH	CW SUPPLY	CW BRANCH
P-1	SAFETY STATION	COMBINATION SHOWER AND WIDE AREA EYE/FACE WASH - CORROSION RESISTANT GALVANIZED STEEL COMBINATION SHOWER AND EYE/FACEWASH STATION, 10" ABS PLASTIC SHOWER HEAD AND BOWL, 4 POLYPROPYLENE EYE/FACE WASH LAMINAR FLOW SPRAY HEADS, IN-LINE STRAINER, STAINLESS STEEL STAY-OPEN VALVES, 1 1/4" IPS SUPPLY AND DRAIN, STAINLESS STEEL SHOWER PULL ROD, CAST ALUMINUM POWDER COATED FLAG HANDLE, ANSI COMPLIANT SIGN AND FLOW SWITCH (FLOW SWITCH TO BE FCI FLT 90 SERIES FLEXSWITCH, IFC EFFECTOR 300 SAXX OR APPROVED EQUAL)	1 1/2" TEPID	1 1/4" TEPID	-	-
HR	HOSE REEL	RETRACTABLE HOSE REEL WITH 50' HOSE - ALUMINUM BASE AND GUARD ARM, STEEL SPRING, FULLY PORTED SHAFT AND SWIVEL, SPOOL MOUNTED ON TWO PERMANENTLY LUBRICATED/SEALED BALL BEARINGS, SIX ROLLER GUIDE OUTLETS, HOSE GUIDE ARM, 50' LONG X 3/8" NPTM HOSE (MAXIMUM WORKING PRESSURE 2,400 PSI). SAMSON HOSE REEL 506-421 USED AS BASIS OF DESIGN.	-	-	3/8"	3/4"

PLUMBING PUMP (PP) SCHEDULE

MARK	LOCATION	SERVICE	FLUID			PUMP PERFORMANCE		MOTOR			REMARKS	
			FLUID	TEMP	SP GR	FLOW GPM	TOTAL HEAD	NOM HP	V/PH/Hz	NOM RPM		TYPE
PP-1	STORAGE RM 102	DOMESTIC	WATER	80°	1.0	3	6	1/12	115/1/60	1725	BOOSTER	1,2

REMARKS:
 1. SEE SPECIFICATIONS FOR EQUIPMENT STANDARDS AND MANUFACTURERS.
 2. BELL & GOSSETT - SERIES 100 - 3/4" - LEAD-FREE BRONZE BODY - USED AS BASIS OF DESIGN.

THERMOSTATIC MIXING VALVE (TMV) SCHEDULE

MARK	LOCATION	SERVICE	CAPACITY GPM	MIN. FLOW GPM	COLD WATER EWT (°F)	HOT WATER EWT (°F)	HOT WATER LWT (°F)	REMARKS
TMV-1	STORAGE RM 102	HOT WATER SERVICE	5	.5	40	140	110	1,2,5
TMV-2	STORAGE RM 102	SAFETY STATIONS	40	3	40	140	53	1,3,5
TMV-3	STORAGE RM 102	POLYMER UNITS	20	.5	40	140	100	1,4,5

REMARKS:
 1. SEE SPECIFICATIONS FOR EQUIPMENT STANDARDS AND MANUFACTURERS.
 2. LEONARD MODEL 170-LF THERMOSTATIC MIXING VALVE USED AS BASIS OF DESIGN.
 3. LEONARD TM-5125-LF EMERGENCY MIXING VALVE FOR MULTIPLE SAFETY SHOWERS.
 4. WATTS MODEL LF1170 MIXING VALVE USED AS BASIS OF DESIGN.
 5. PROVIDE WITH MOUNTING BRACKET.

BACKFLOW PREVENTER (BFP) SCHEDULE

MARK	LOCATION	SERVICE	TYPE	SIZE	REMARKS	ACCESSORIES
BFP-1	1ST FLOOR	POTABLE DOMESTIC SERVICE	1	2"	1	1,2
BFP-2	1ST FLOOR	2ND FL BELT PRESS & POLYMER UNITS	1	3"	1	1,2
BFP-3	1ST FLOOR	2ND FL BELT PRESS HOSE BIBBS	1	3/4"	1	1,2
BFP-4	STORAGE 102	CW SIDE OF TMV-3 SERVING POLYMER UNITS	1	1"	1	1,2
BFP-5	STORAGE 102	140°F SIDE OF TMV-3 SERVING POLYMER UNITS	1	1"	1	1,2


TYPE:
 1. REDUCED PRESSURE ZONE
 2. DOUBLE CHECK ASSEMBLY.

REMARKS:
 1. SEE SPECIFICATIONS FOR VALVE STANDARDS AND MANUFACTURERS.


ACCESSORIES:
 1. PROVIDE WITH STRAINER.
 2. PROVIDE WITH AIR GAP FITTING.

THIS RECORD DOCUMENT HAS BEEN PREPARED BASED ON INFORMATION PROVIDED BY THE CONSTRUCTION CONTRACTOR. GRW ENGINEERS, INC. HAS ATTEMPTED TO VERIFY THE ACCURACY AND/OR COMPLETENESS OF THIS INFORMATION BUT SHALL NOT BE RESPONSIBLE FOR ANY ERRORS OR OMISSIONS WHICH MAY BE INCORPORATED HEREIN AS A RESULT.


GRW
 engineering | architecture | geospatial
 www.grwinc.com
 ENGINEER/ARCHITECT: David C. Osborne
 CONSTRUCTION COMPANY: Dugan & Meyers
 DATE: 4/23/19

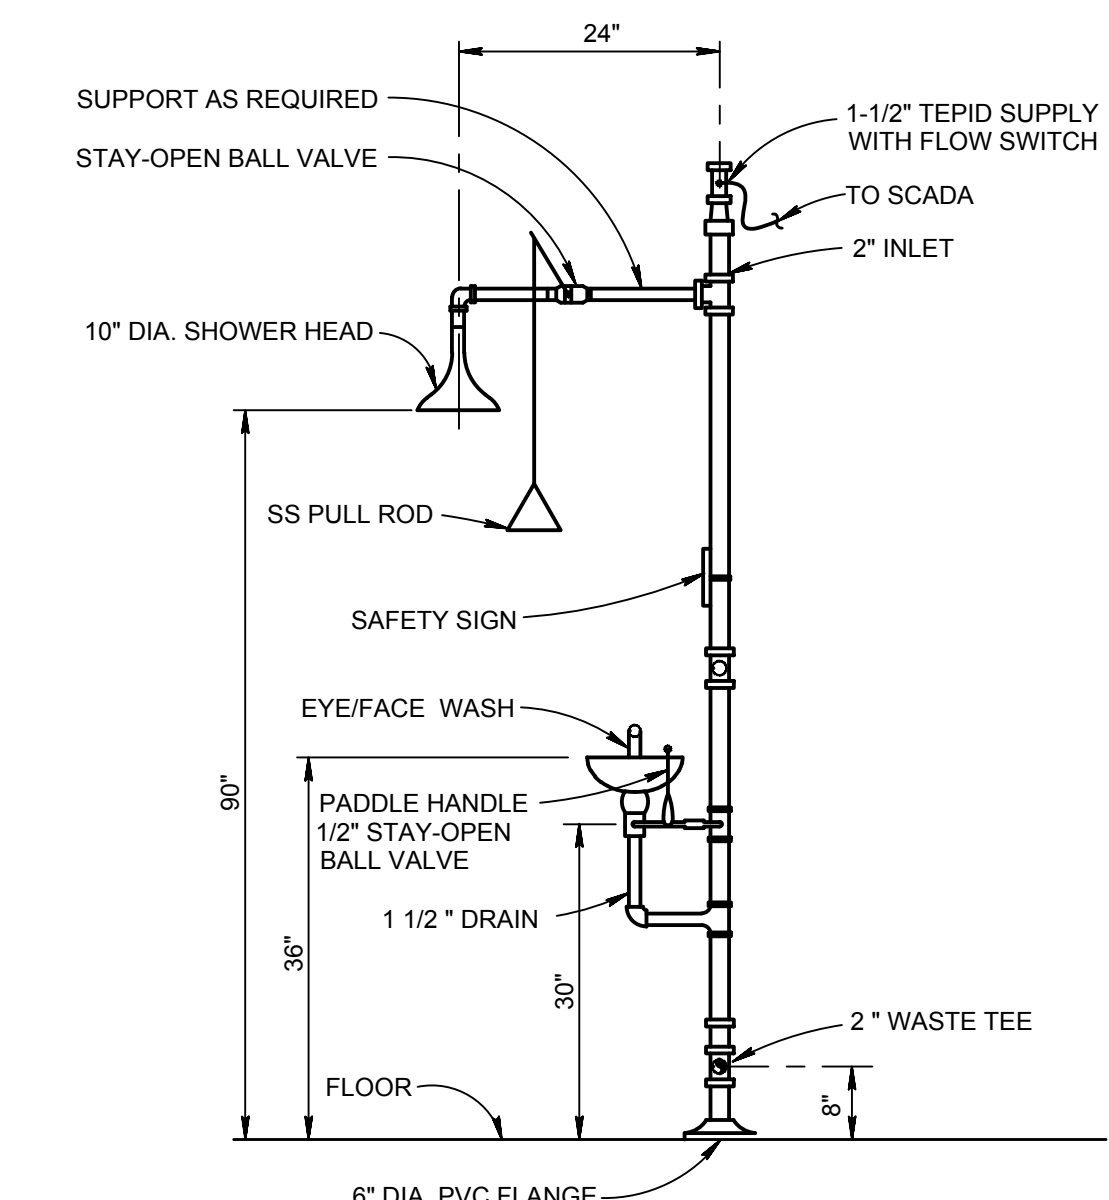


2 SAFETY SHOWER - EYE/FACEWASH DETAIL
 NOT TO SCALE

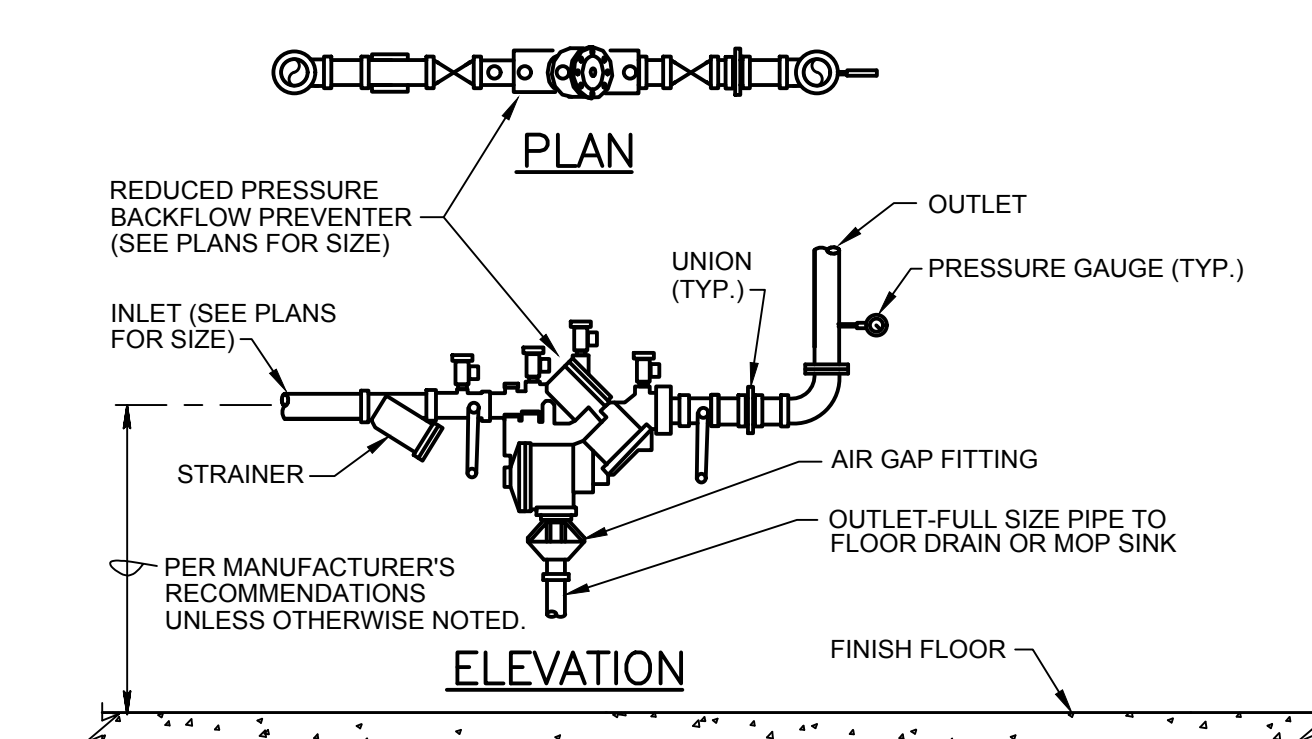


1 REDUCED PRESSURE PRINCIPLE BACKFLOW PREVENTER DETAIL
 NOT TO SCALE

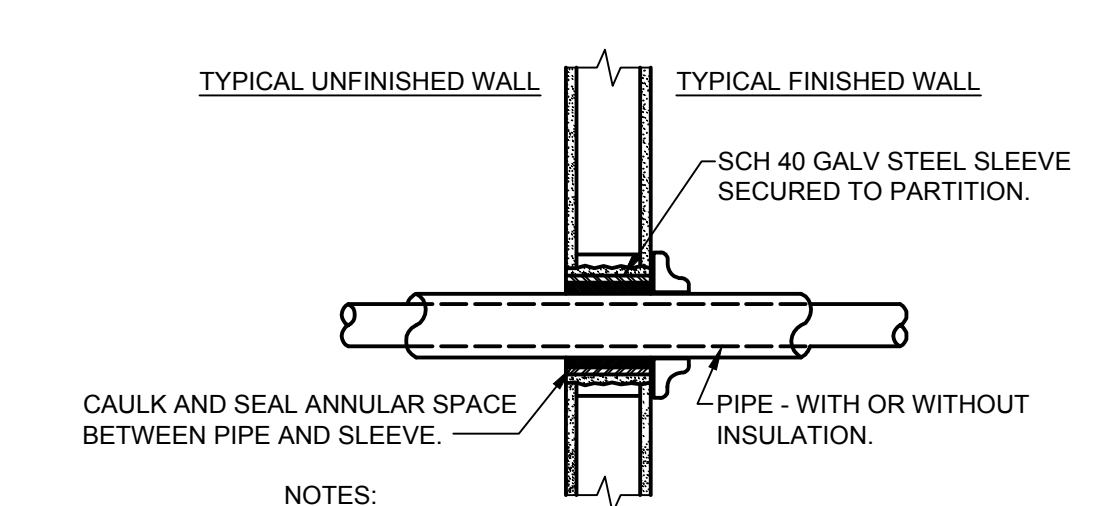


6 PIPE PENETRATION THRU INTERIOR WALL DETAIL
 NOT TO SCALE

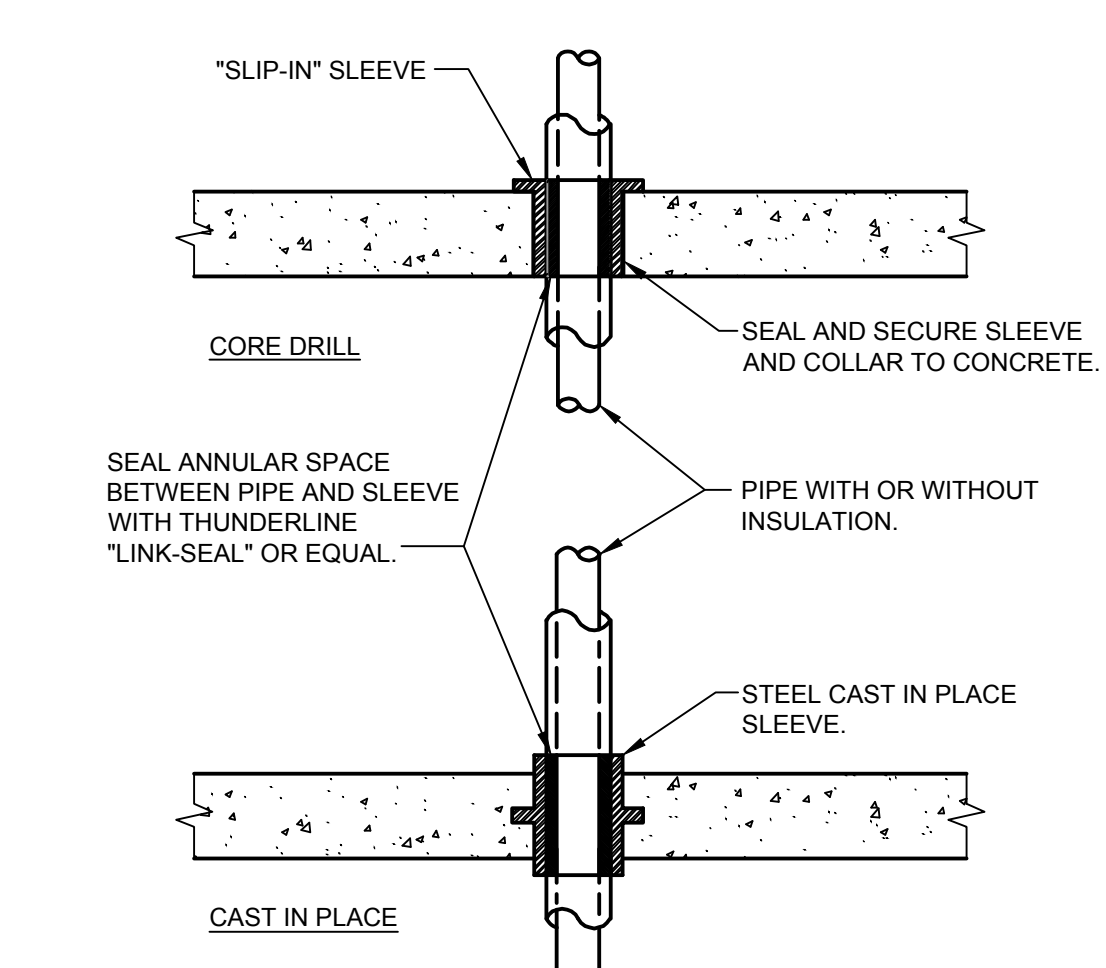


7 PIPE PENETRATION THRU CONCRETE SLAB DETAIL
 NOT TO SCALE

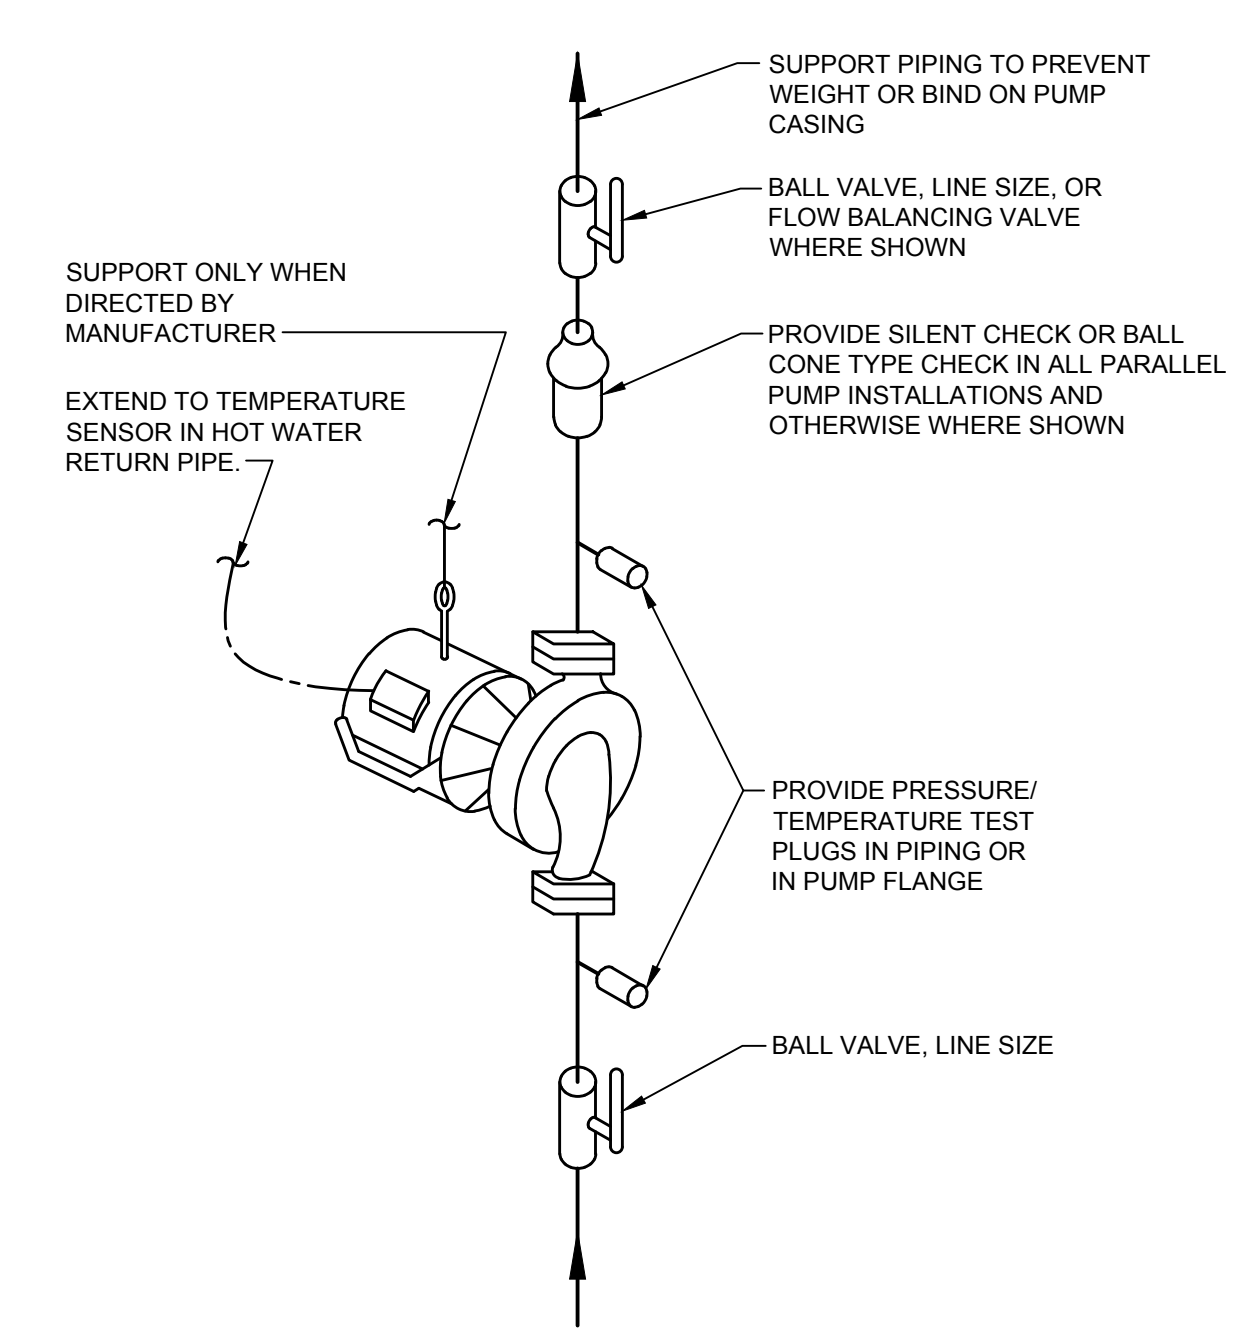

3 TYPICAL IN-LINE CENTRIFUGAL PUMP PIPING DETAIL
 NOT TO SCALE

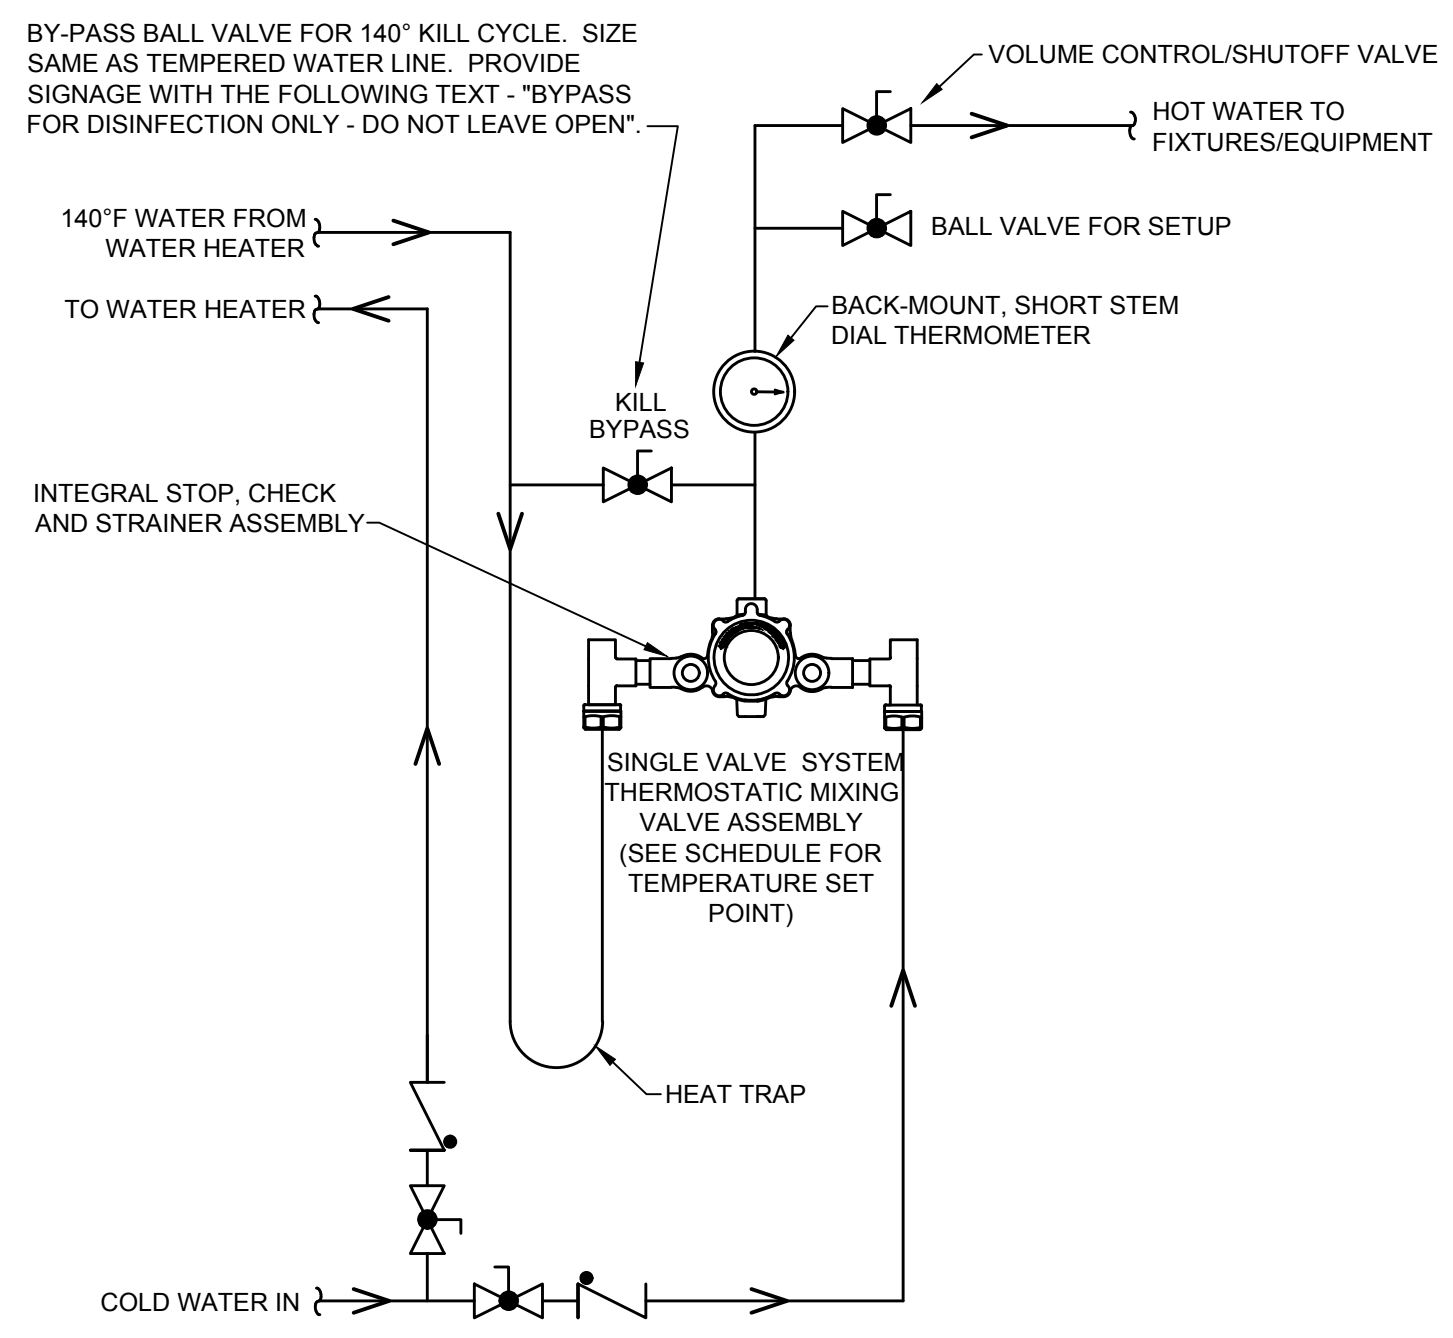

4 THERMOSTATIC MIXING VALVE PIPING DETAIL (TMV-1 & TMV-3)
 NOT TO SCALE

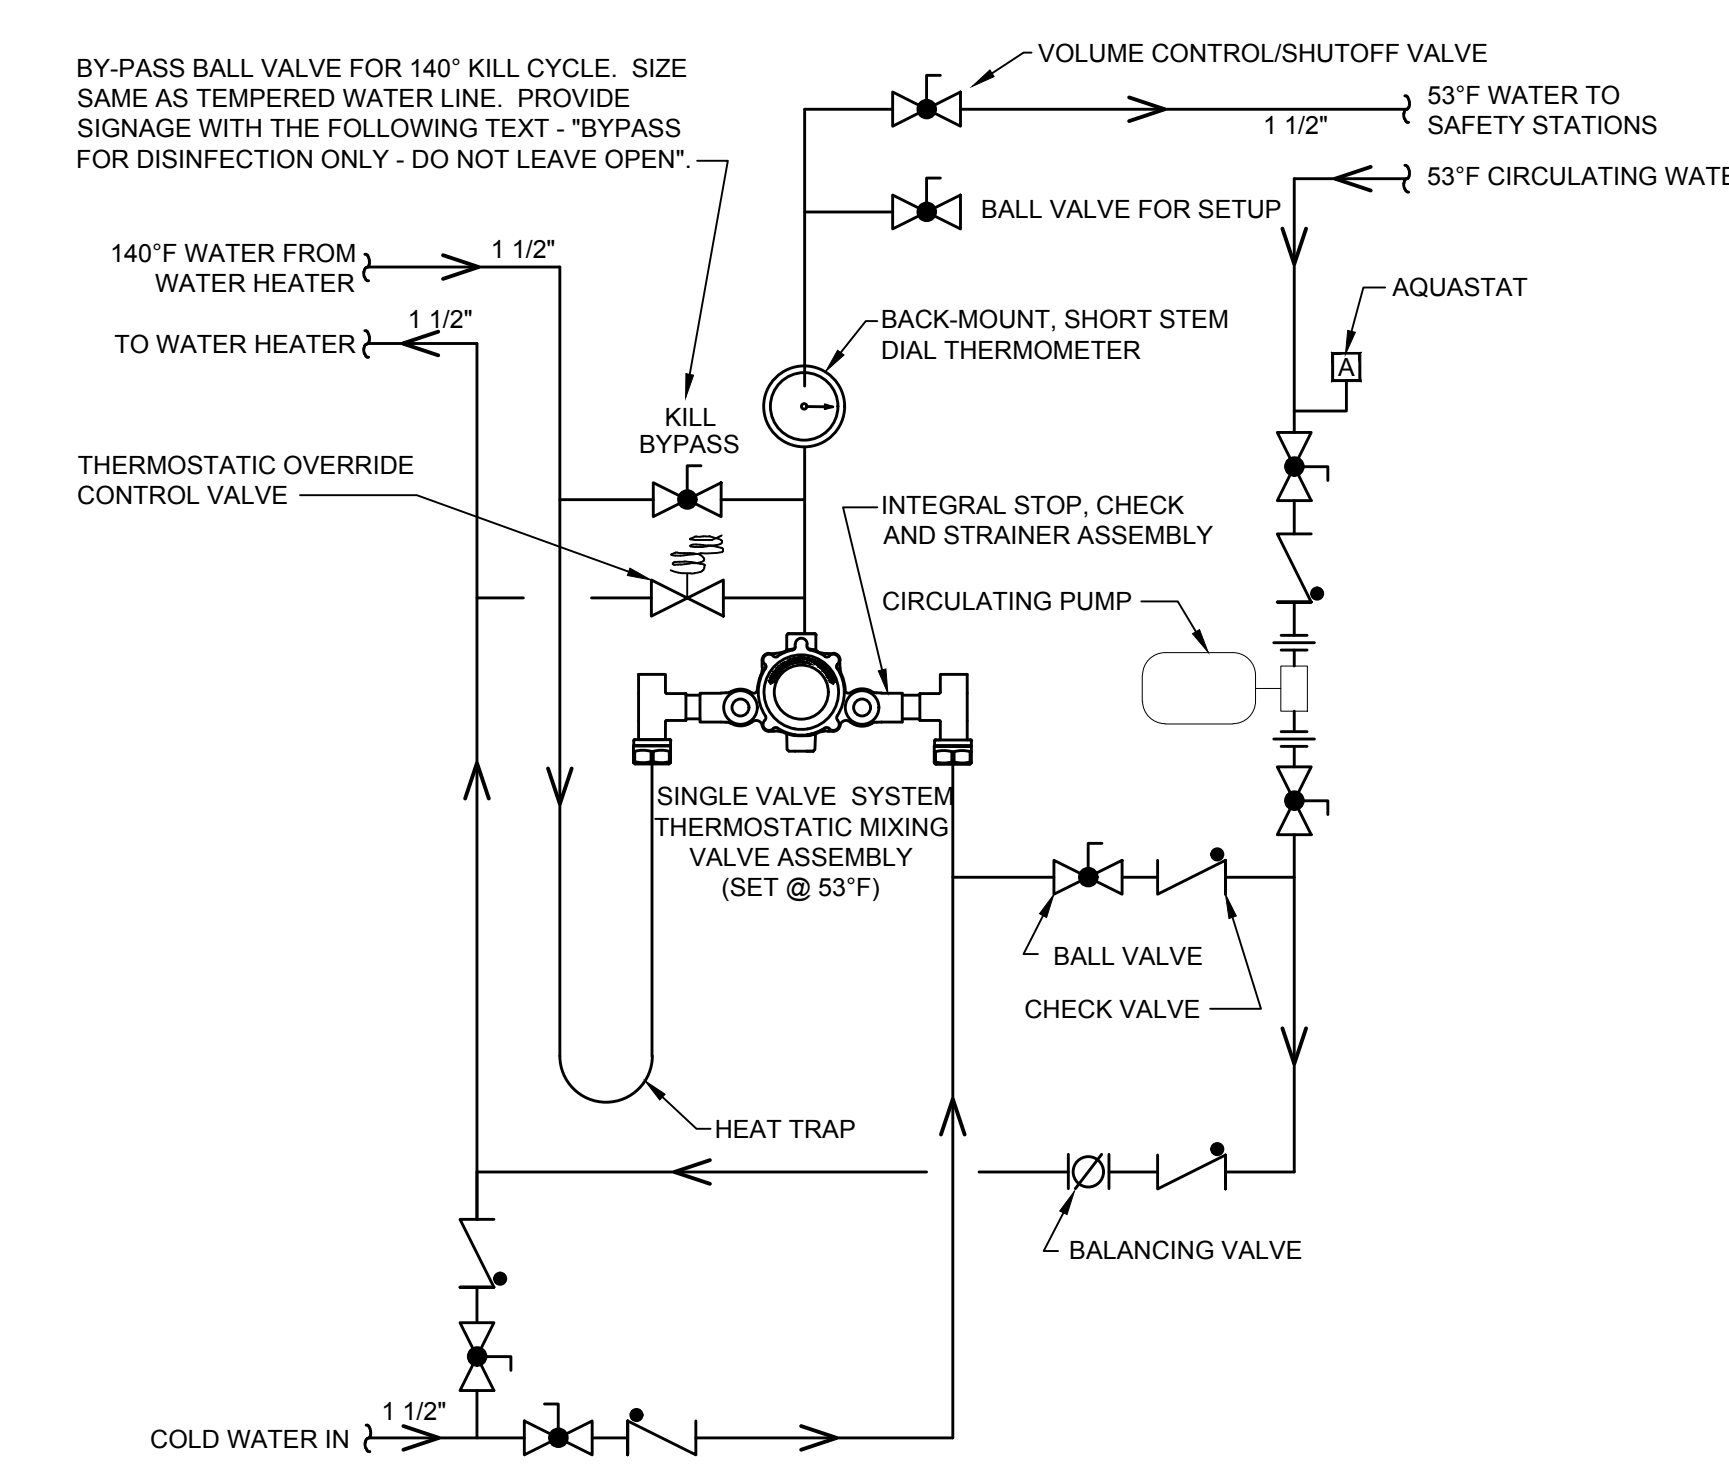

5 SAFETY STATION THERMOSTATIC MIXING VALVE PIPING DETAIL (TMV-2)
 NOT TO SCALE

GRW PROJECT NO. 4384
 CLIENT PROJECT NO.
 ALL RIGHTS RESERVED. THIS DOCUMENT IS THE PROPERTY OF GRW ENGINEERS, INC. AND SHALL NOT BE REPRODUCED IN WHOLE OR IN PART WITHOUT THE WRITTEN PERMISSION OF GRW ENGINEERS, INC. WITHOUT THE WRITTEN PERMISSION.

GRW
 engineering | architecture | geospatial
 www.grwinc.com

BELT FILTER PRESS REPLACEMENT PLUMBING SCHEDULES AND DETAILS
 TAYLOR MILL TREATMENT PLANT
 NORTHERN KENTUCKY WATER DISTRICT

NO.	DATE	DESCRIPTION	DESIGNED	DRAWN	REVIEWED	APPROVED
1	01-20-17	ADDENDUM NO. 2	MAS	DCO	AAT	AAT

DATE: APRIL, 2019
 SCALE: NOT TO SCALE
 SHEET NO. P-601


PLOTTED BY: mwilliamson
 PRINTED: 4/23/2019 @ 2:40PM
 FILE NAME: U:\4384-NKWD-TMTP-BFP-Working Drawings\AutoCAD\4384-P-601.dwg

RECORD DOCUMENTS

PLOTTED BY: mwilliamson

PRINTED: 4/23/2019 @ 2:40PM

FILE NAME: U:\4384-NKVD-TMTP-BFP-Working Drawings\AutoCAD\4384-P-602.dwg

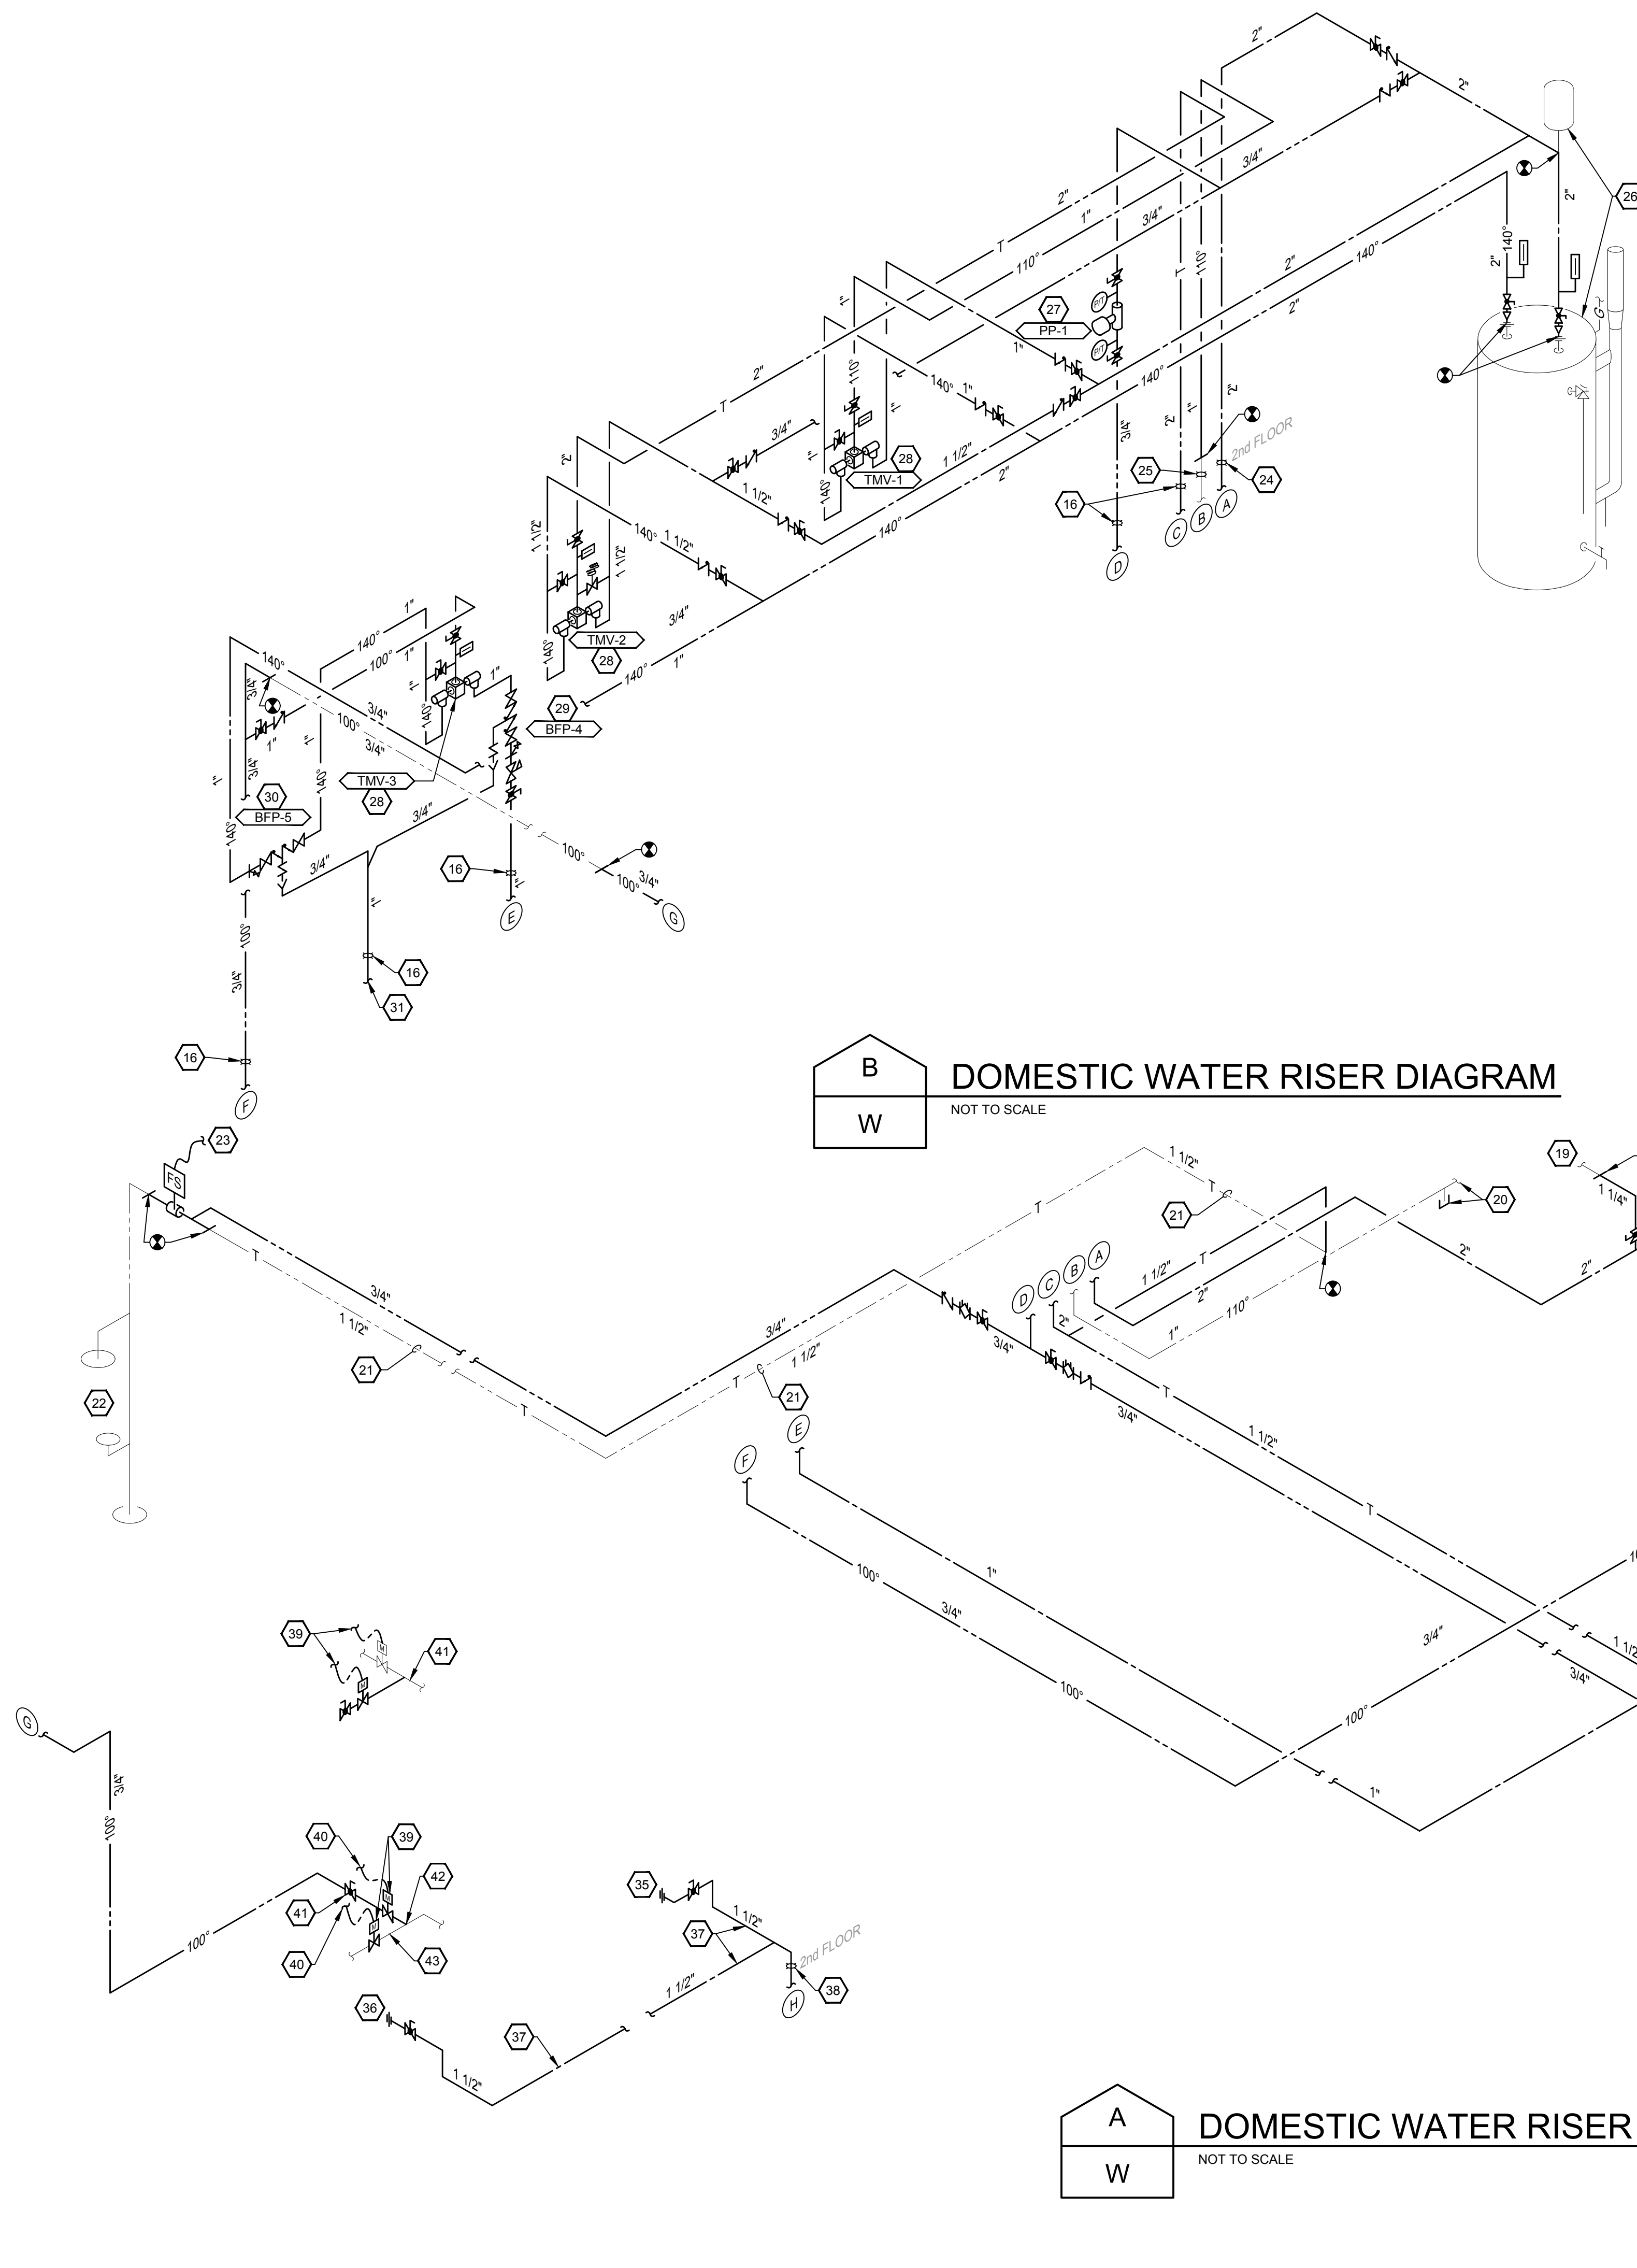

GENERAL NOTES:

- SEE SHEET M-001 FOR LEGEND AND ADDITIONAL GENERAL NOTES.
- SEE SPECIFICATION SECTION 017329 FOR CUTTING AND PATCHING.
- ALL WATER PIPE BEING DEMOLISHED SHALL BE REMOVED TO POINT OF ACTIVE USE AND CAPPED. NO WATER FILLED DEAD ENDS ARE TO REMAIN.

SHEET KEYNOTES:

- EXISTING 3\" DOMESTIC WATER SERVICE ENTRANCE.
- EXISTING SHUT-OFF VALVE, PRV AND WATER METER. RESET PRV OUTLET PRESSURE AS REQUIRED TO ACCOMMODATE NEW BELT FILTER PRESS. VERIFY PRESSURE REQUIREMENT WITH BELT FILTER PRESS MANUFACTURER.
- REMOVE EXISTING 1 1/2\" POTABLE CW PIPE, SHUT-OFF VALVE AND PRV. PROVIDE NEW 2\" POTABLE WATER PIPE, SHUT-OFF VALVE, PRV AND CONNECT TO EXISTING 3\" MAIN.
- PROVIDE BFP-1 IN VERTICAL AND EXTEND AIR-GAP FITTING DRAIN PIPE TO EXISTING FLOOR DRAIN.
- CONNECT NEW POTABLE 2\" CW PIPE TO EXISTING 1 1/4\" POTABLE CW PIPE.
- EXISTING 1 1/4\" POTABLE CW PIPE SERVING ORIGINAL BUILDING FIXTURES. SEE NOTE 19. DEMOLISH ABANDONED/UNUSED PIPE BETWEEN THIS POINT AND NOTE 19 CONNECTION POINT. COORDINATE PRV SETTING WITH BELT FILTER PRESS MANUFACTURER'S REQUIREMENTS.
- PROVIDE NEW POTABLE 3\" CW PIPE FOR POLYMER FEED SYSTEMS AND BELT FILTER PRESS WASHDOWN. CONNECT TO EXISTING 3\" POTABLE CW PIPE. PROVIDE SHUT-OFF VALVE AND PRV.
- PROVIDE BFP-2 WITH STRAINER ABOVE EXISTING BFP. INSTALL TO RETAIN ACCESS TO EXISTING BFP. EXTEND AIR-GAP FITTING DRAIN PIPE TO EXISTING FLOOR DRAIN.
- EXISTING BACKFLOW PREVENTER FOR PROCESS WATER.
- EXISTING CW SUPPLY TO EXISTING BELT FILTER PRESS BUILDING PROCESSES TO REMAIN.
- EXISTING CW SUPPLY TO 2006 BACKWASH TREATMENT BUILDING PROCESSES TO REMAIN.
- PROVIDE BFP-3 WITH STRAINER IN VERTICAL AND EXTEND AIR-GAP FITTING DRAIN PIPE TO EXISTING FLOOR DRAIN.
- PROVIDE 3/4\" POTABLE CW UP TO HOSE REEL. CORE DRILL FLOOR TO ACCOMMODATE PIPE AND FIRE STOPPING.
- PROVIDE 3/4\" POTABLE CW MOUNTED TO CURB WALL.
- PROVIDE HOSE REEL MOUNTED TO FLOOR.
- CORE DRILL FLOOR AS REQUIRED TO ACCOMMODATE PIPE AND FIRE STOPPING.
- COORDINATE SAFETY STATION LOCATION WITH BELT PRESS MANUFACTURER'S ACCESSIBILITY REQUIREMENTS. COORDINATE LOCATION WITH OWNER.
- EXTEND TO SCADA SYSTEM.
- EXISTING 1 1/4\" POTABLE CW PIPE TO TOILET ROOM PLUMBING CHASE AND JANITOR SINK TO REMAIN. SEE NOTE 6 FOR RELATED DEMOLITION.
- EXISTING HW PIPE TO EXISTING LAVATORY AND JANITOR'S SINK TO REMAIN IN USE. CAP PIPE NO LONGER SERVING POLYMER SYSTEM.
- REPURPOSE EXISTING PIPE SERVING SAFETY STATION FOR TEPID WATER SUPPLY.
- EXISTING SAFETY STATION IN 2006 BACKWASH TREATMENT SYSTEM BLDG.
- PROVIDE FLOW SWITCH FOR EXISTING SAFETY STATION. TIE FLOW SWITCH INTO SCADA SYSTEM.
- CORE DRILL AND ENLARGE EXISTING FLOOR OPENING AS REQUIRED TO ACCOMMODATE LARGER PIPE AND FIRE STOPPING.
- EXISTING HW PIPE FLOOR PENETRATION.
- EXISTING WATER HEATER AND EXPANSION TANK. RESET WATER HEATER'S OUTGOING TEMPERATURE TO 140°F.
- PROVIDE TEPID WATER RECIRCULATING PUMP MOUNTED TO WALL @ 4'-6\" AFF.
- PROVIDE TEMPERING VALVE MOUNTED TO WALL @ 4'-0\" AFF.
- PROVIDE BFP-4 WITH STRAINER IN VERTICAL.
- PROVIDE BFP-5 WITH STRAINER PER MANUFACTURER'S RECOMMENDATIONS.
- EXTEND 1\" DRAIN TO EXISTING FIRST FLOOR JANITOR'S SINK.
- PROVIDE 3/4\" HW AND CONNECT TO POLYMER FEED PIPE. PROVIDE BALL VALVE AND 3/4\" HOSE CONNECTION FOR EXISTING POLYMER SYSTEM.
- CORE DRILL FLOOR AS REQUIRED TO INSTALL NEW 2\" PIPE. SEAL FLOOR PENETRATION WATERTIGHT.
- PROVIDE CONNECTION TO NEW BELT PRESS SHOWER ASSEMBLY AT BOTTOM OF GRATING. VERIFY TYPE AND LOCATION OF CONNECTION WITH BELT PRESS MANUFACTURER.
- PROVIDE 1 1/2\" CW TO POLYMER UNIT. SEE SHEET C-102.
- PROVIDE 1 1/2\" CW TO POLYMER TANK. SEE SHEET C-102.
- FASTEN CW PIPE TO TOP OF CONTAINMENT WALL.
- CORE DRILL FLOOR AS REQUIRED TO INSTALL NEW 1 1/2\" PIPE. SEAL FLOOR PENETRATION WATERTIGHT.
- PROVIDE SOLENOID VALVE.
- CONTROL WIRING FOR SOLENOID VALVES. SEE ELECTRICAL SHEET E-702 FOR SEQUENCING.
- PROVIDE MAINTENANCE VALVE (VALVE NORMALLY OPEN).
- PROVIDE 3/4\" HW AND CONNECT TO POLYMER FEED PIPE. SEE SHEET C-102.
- POLYMER FEED PIPE SHOWN FOR REFERENCE ONLY. SEE SHEET C-102.

THIS RECORD DOCUMENT HAS BEEN PREPARED BASED ON INFORMATION PROVIDED BY THE CONSTRUCTION CONTRACTOR. GRW ENGINEERS, INC. HAS ATTEMPTED TO VERIFY THE ACCURACY AND/OR COMPLETENESS OF THIS INFORMATION BUT SHALL NOT BE RESPONSIBLE FOR ANY ERRORS OR OMISSIONS WHICH MAY BE INCORPORATED HEREIN AS A RESULT.

engineering | architecture | geospatial
www.grwinc.com

ENGINEER/ARCHITECT: David C. Osborne
CONSTRUCTION COMPANY: Dugan & Meyers
DATE: 4/23/19

GRW PROJECT NO. 4384
CLIENT PROJECT NO.
ALL RIGHTS RESERVED. THIS DOCUMENT IS THE PROPERTY OF GRW ENGINEERS, INC. AND SHALL NOT BE REPRODUCED IN WHOLE OR IN PART WITHOUT WRITTEN PERMISSION FROM GRW ENGINEERS, INC. OR OTHER THAN THIS SPECIFIC PROJECT WITHOUT WRITTEN PERMISSION.

engineering | architecture | geospatial
www.grwinc.com

**BELT FILTER PRESS REPLACEMENT
PLUMBING RISER DIAGRAMS**
TAYLOR MILL TREATMENT PLANT
NORTHERN KENTUCKY WATER DISTRICT

NO.	DATE	DESCRIPTION	DESIGNED	DRAWN	REVIEWED	APPROVED
			MAS	MAS	AAT	AAT

SCALE CHECK: THIS MARK SHOULD MEASURE EXACTLY 1" WHEN PLOTTED

DATE: APRIL, 2019
SCALE: NOT TO SCALE
SHEET NO. P-602

PLOTTED BY: mwilliamson

PRINTED: 4/23/2019 @ 2:33PM

FILE NAME: U:\4384-NKVD\TMT\BFP\Working Drawings\AutoCAD\4384 E-001.dwg

CEILING MOUNTED

WALL MOUNTED

INTERIOR POWER EQUIPMENT AND DEVICES

EXISTING

NEW

ABBREVIATIONS

FLUOR - FLUORESCENT FOR - FORWARD-OFF-REVERSE FTG - FITTING FVNR - FULL VOLTAGE NON-REVERSING GALV - GALVANIZED G. GND - GROUND GFI - GROUND FAULT INTERRUPTING HID - HIGH INTENSITY DISCHARGE HP - HORSEPOWER HT, H - HEIGHT IN - INCH INC - INCANDESCENT J-BOX, JB - JUNCTION BOX KCMIL - 1000 CIRCULAR MILS KVA - KILOVOLT AMPS KVAF - KILOVOLT AMPS REACTIVE KW - KILOWATT KWH - KILOWATT HOUR LA - LIGHTNING ARRESTER LV - LOW VOLTAGE LVDT - LINEAR VARIABLE DIFFERENTIAL TRANSFORMER MAU - MAKEUP AIR UNIT MAX - MAXIMUM MCB - MAIN CIRCUIT BREAKER MCC - MOTOR CONTROL CENTER MCP - MOTOR CIRCUIT PROTECTOR MDP - MAIN DISTRIBUTION PANEL MFR - MANUFACTURER MG - MOTOR GENERATOR MH - MANHOLE, METAL HALIDE, MOUNTING HEIGHT MIC - MICROPHONE MIN - MINIMUM MLO - MAIN LUGS ONLY MTO - MOUNTED MV - MEDIUM VOLTAGE N/A - NOT APPLICABLE NEC - NATIONAL ELECTRICAL CODE NEMA - NATIONAL ELECTRICAL MANUFACTURERS ASSOCIATION NESC - NATIONAL ELECTRICAL SAFETY CODE	NFPA - NATIONAL FIRE PROTECTION ASSOCIATION NIC - NOT IN CONTRACT NTS - NOT TO SCALE NO - NORMALLY OPEN, NUMBER OH - OVERHEAD OL - OVERLOAD P - POLE PB - PULL BOX, PUSH BUTTON PH - PHASE PNL - PANEL POC - POINT OF CONNECTION PS - PULL SWITCH OR PRESSURE SWITCH QTY - QUANTITY REF - REFERENCE, REFER RCPT - RECEPTACLE RGS - RIGID GALVANIZED STEEL SCH - SCHEDULE SMR - SURFACE METAL RACEWAY S/N - SOLID NEUTRAL SQ FT - SQUARE FOOT SS - STAINLESS STEEL STD - STANDARD STP - SHIELDED TWISTED PAIR SW - SWITCH SYS - SYSTEM TEL - TELEPHONE TM - THERMAL MAGNETIC TV - TELEVISION TVSS - TRANSIENT VOLTAGE SURGE SUPPRESSOR TYP - TYPICAL UG - UNDERGROUND UH - UNIT HEATER V - VOLTAGE VFD - VARIABLE FREQUENCY DRIVE W - WIRE W/ - WITH W/O - WITH OUT WP - WEATHERPROOF WT - WEIGHT XFMR, XFMR - TRANSFORMER
---	--

INTERIOR CONDUIT AND WIRE

WIREWAY

GROUNDING

CONTROLS

CONTROLS

FIRE ALARM/SUPPRESSION SYSTEM DEVICES

COMMUNICATION

COMMUNICATION

GENERAL NOTES:

- THE COLOR OF EXPOSED RUNS OF CONDUIT SHALL CLOSELY MATCH EXISTING BACKGROUND COLOR OF SURFACES IN THE AREA.
- FIRESTOP ALL CONDUITS PENETRATING FIRE RATED WALLS.
- CONTRACTOR SHALL VISIT SITE(S) PRIOR TO BIDDING.

REVISIONS

NO	DATE	DESCRIPTION	DESIGNED	DRAWN	REVIEWED	APPROVED
			JKG	JTR	WLM	WLM

DATE: APRIL, 2019
SCALE: NOT TO SCALE
SHEET NO: E-001


BELT FILTER PRESS REPLACEMENT ELECTRICAL SYMBOLS

TAYLOR MILL TREATMENT PLANT
NORTHERN KENTUCKY WATER DISTRICT

RECORD DOCUMENTS

engineering | architecture | geospatial
www.gwinc.com

ALL RIGHTS RESERVED. NO PART OF THIS DOCUMENT SHALL BE REPRODUCED IN WHOLE OR IN PART WITHOUT THE WRITTEN PERMISSION OF GRW ENGINEERS, INC. AND SHALL NOT BE USED FOR ANY OTHER PROJECT OTHER THAN THIS SPECIFIC PROJECT WITHOUT THE WRITTEN PERMISSION OF GRW ENGINEERS, INC.

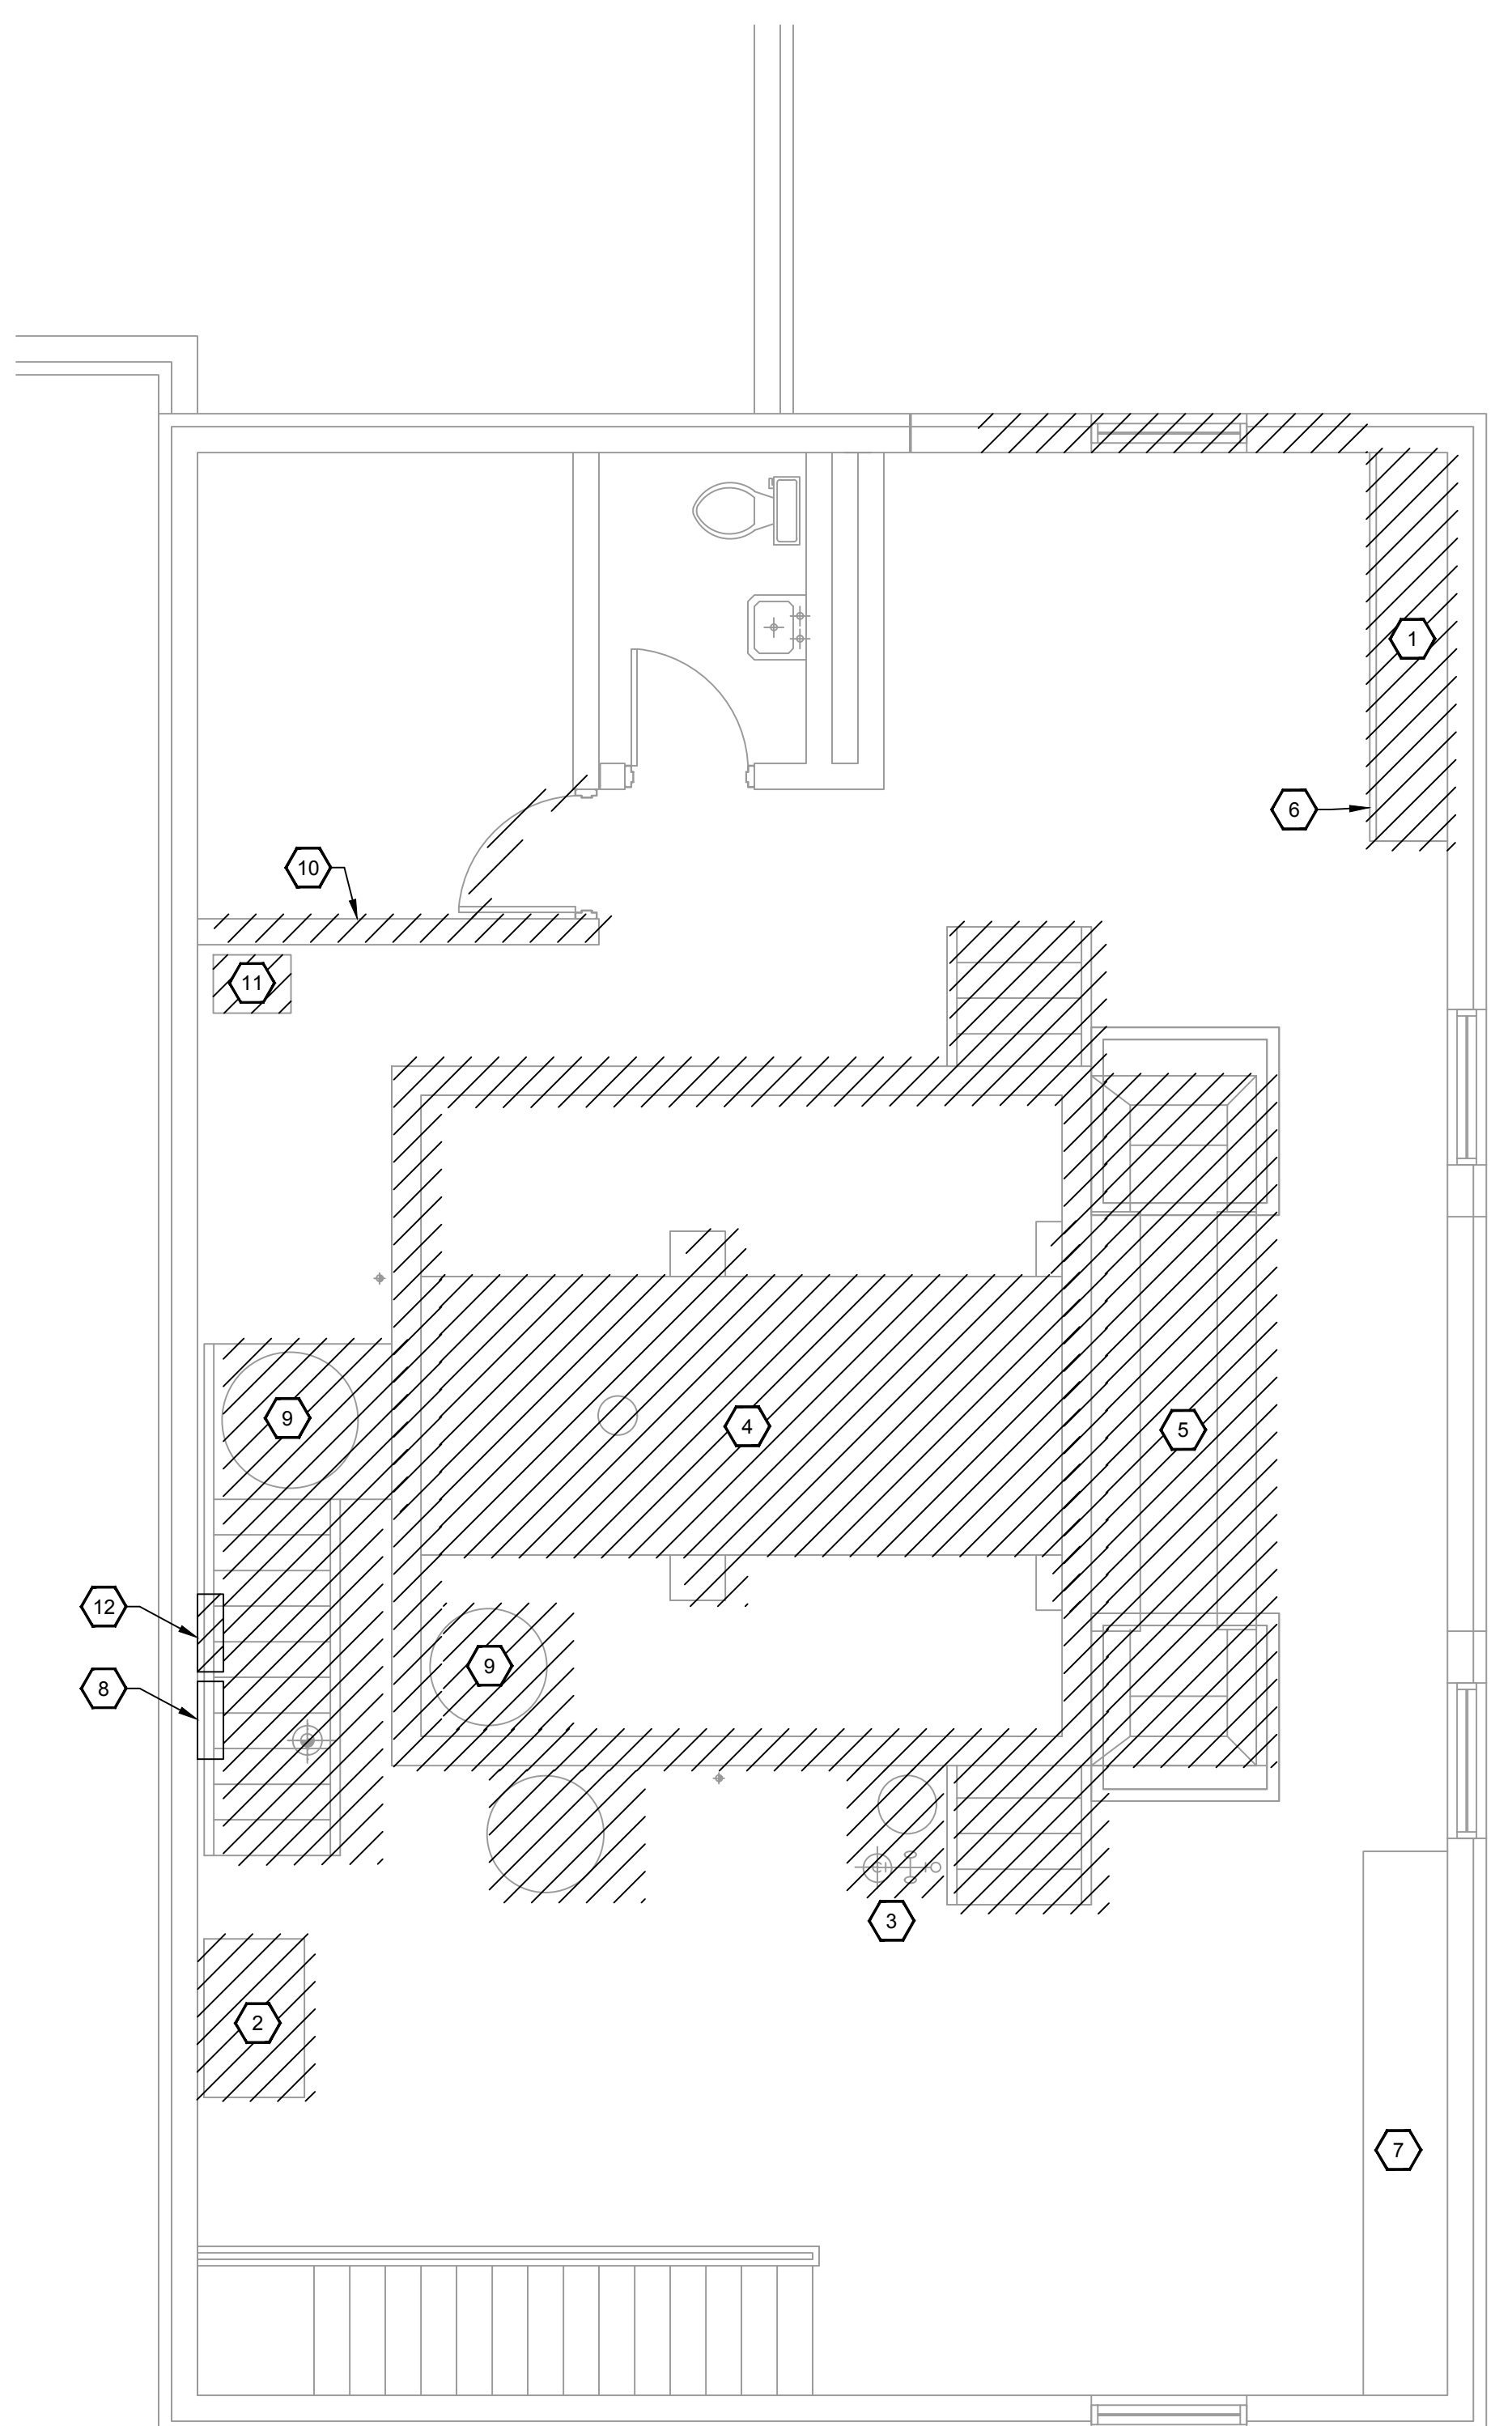

SECOND FLOOR ELECTRICAL PLAN - DEMOLITION

SCALE: 1/4"=1'-0" 0 2 4 8


GENERAL NOTES:

1. REMOVE ALL CONDUIT AND WIRE BACK TO SOURCE. PATCH ALL HOLES TO MATCH ADJOINING CONSTRUCTION AND FINISH. PAINT TO MATCH ADJACENT PAINT COLOR.

SHEET KEYNOTES:

1. EXISTING CONTROL PANEL TO BE REMOVED.
2. EXISTING POLYMER FEED PUMPS TO BE REMOVED.
3. EXISTING SHOWER/EYE WASH TO BE REMOVED.
4. EXISTING FILTER PRESS TO BE REMOVED.
5. EXISTING BELT CONVEYOR TO BE REMOVED.
6. EXISTING AIR COMPRESSOR TO BE REMOVED.
7. EXISTING MOTOR CONTROL CENTER TO REMAIN. EXISTING BUCKETS AND FEEDER CIRCUITS TO EQUIPMENT BEING REPLACED TO BE REMOVED.
8. EXISTING PUMP SPEED CONTROLS FOR POLYMER SYSTEM ON FIRST FLOOR TO REMAIN AS A BACKUP TO THE NEW POLYMER SYSTEM TO BE INSTALLED. LOWER PANEL TO NO MORE THAN 78" TO TOP OF PANEL FOR EASY ACCESS FROM FLOOR LEVEL (STAIRS TO BE REMOVED) AND RELOCATE TO NEW POSITION SHOWN ON SHEET E-103.
9. EXISTING MIXING TANK TO BE REMOVED.
10. EXISTING WALL TO BE REMOVED, REMOVE ALL ELECTRICAL EQUIPMENT - SWITCHES, RECEPTACLES, ETC.
11. EXISTING NATURAL GAS UNIT HEATER TO BE REMOVED. REMOVE ALL CONDUIT AND WIRING.
12. EXISTING DC MOTOR SPEED CONTROLS FOR POLYMER PUMPS TO BE REMOVED.

GRW PROJECT NO. 4384
 CLIENT PROJECT NO.
 ALL RIGHTS RESERVED. NO PART OF THIS DOCUMENT SHALL BE REPRODUCED IN WHOLE OR IN PART WITHOUT THE WRITTEN PERMISSION OF GRW ENGINEERS, INC. AND SHALL NOT BE USED FOR ANY OTHER PROJECT OTHER THAN THIS SPECIFIC PROJECT WITHOUT THE WRITTEN PERMISSION OF GRW ENGINEERS, INC.



engineering | architecture | geospatial
 www.grwinc.com

BELT FILTER PRESS REPLACEMENT ELECTRICAL DEMOLITION PLAN


TAYLOR MILL TREATMENT PLANT
 NORTHERN KENTUCKY WATER DISTRICT

DESIGNED	JKG
DRAWN	JTR
REVIEWED	WLM
APPROVED	WLM

NO.	REVISIONS DESCRIPTION	DATE	BY

SCALE CHECK: _____ THIS MARK SHOULD MEASURE EXACTLY 1" WHEN PLOTTED


THIS RECORD DOCUMENT HAS BEEN PREPARED BASED ON INFORMATION PROVIDED BY THE CONSTRUCTION CONTRACTOR. GRW ENGINEERS, INC. HAS ATTEMPTED TO VERIFY THE ACCURACY AND/OR COMPLETENESS OF THIS INFORMATION BUT SHALL NOT BE RESPONSIBLE FOR ANY ERRORS OR OMISSIONS WHICH MAY BE INCORPORATED HEREIN AS A RESULT.



engineering | architecture | geospatial
 www.grwinc.com



ENGINEER/ARCHITECT: David C. Osborne
 CONSTRUCTION COMPANY: Dugan & Meyers
 DATE: 4/23/19

DATE: APRIL, 2019
 SCALE: 1/4" = 1'-0"
 SHEET NO. E-101

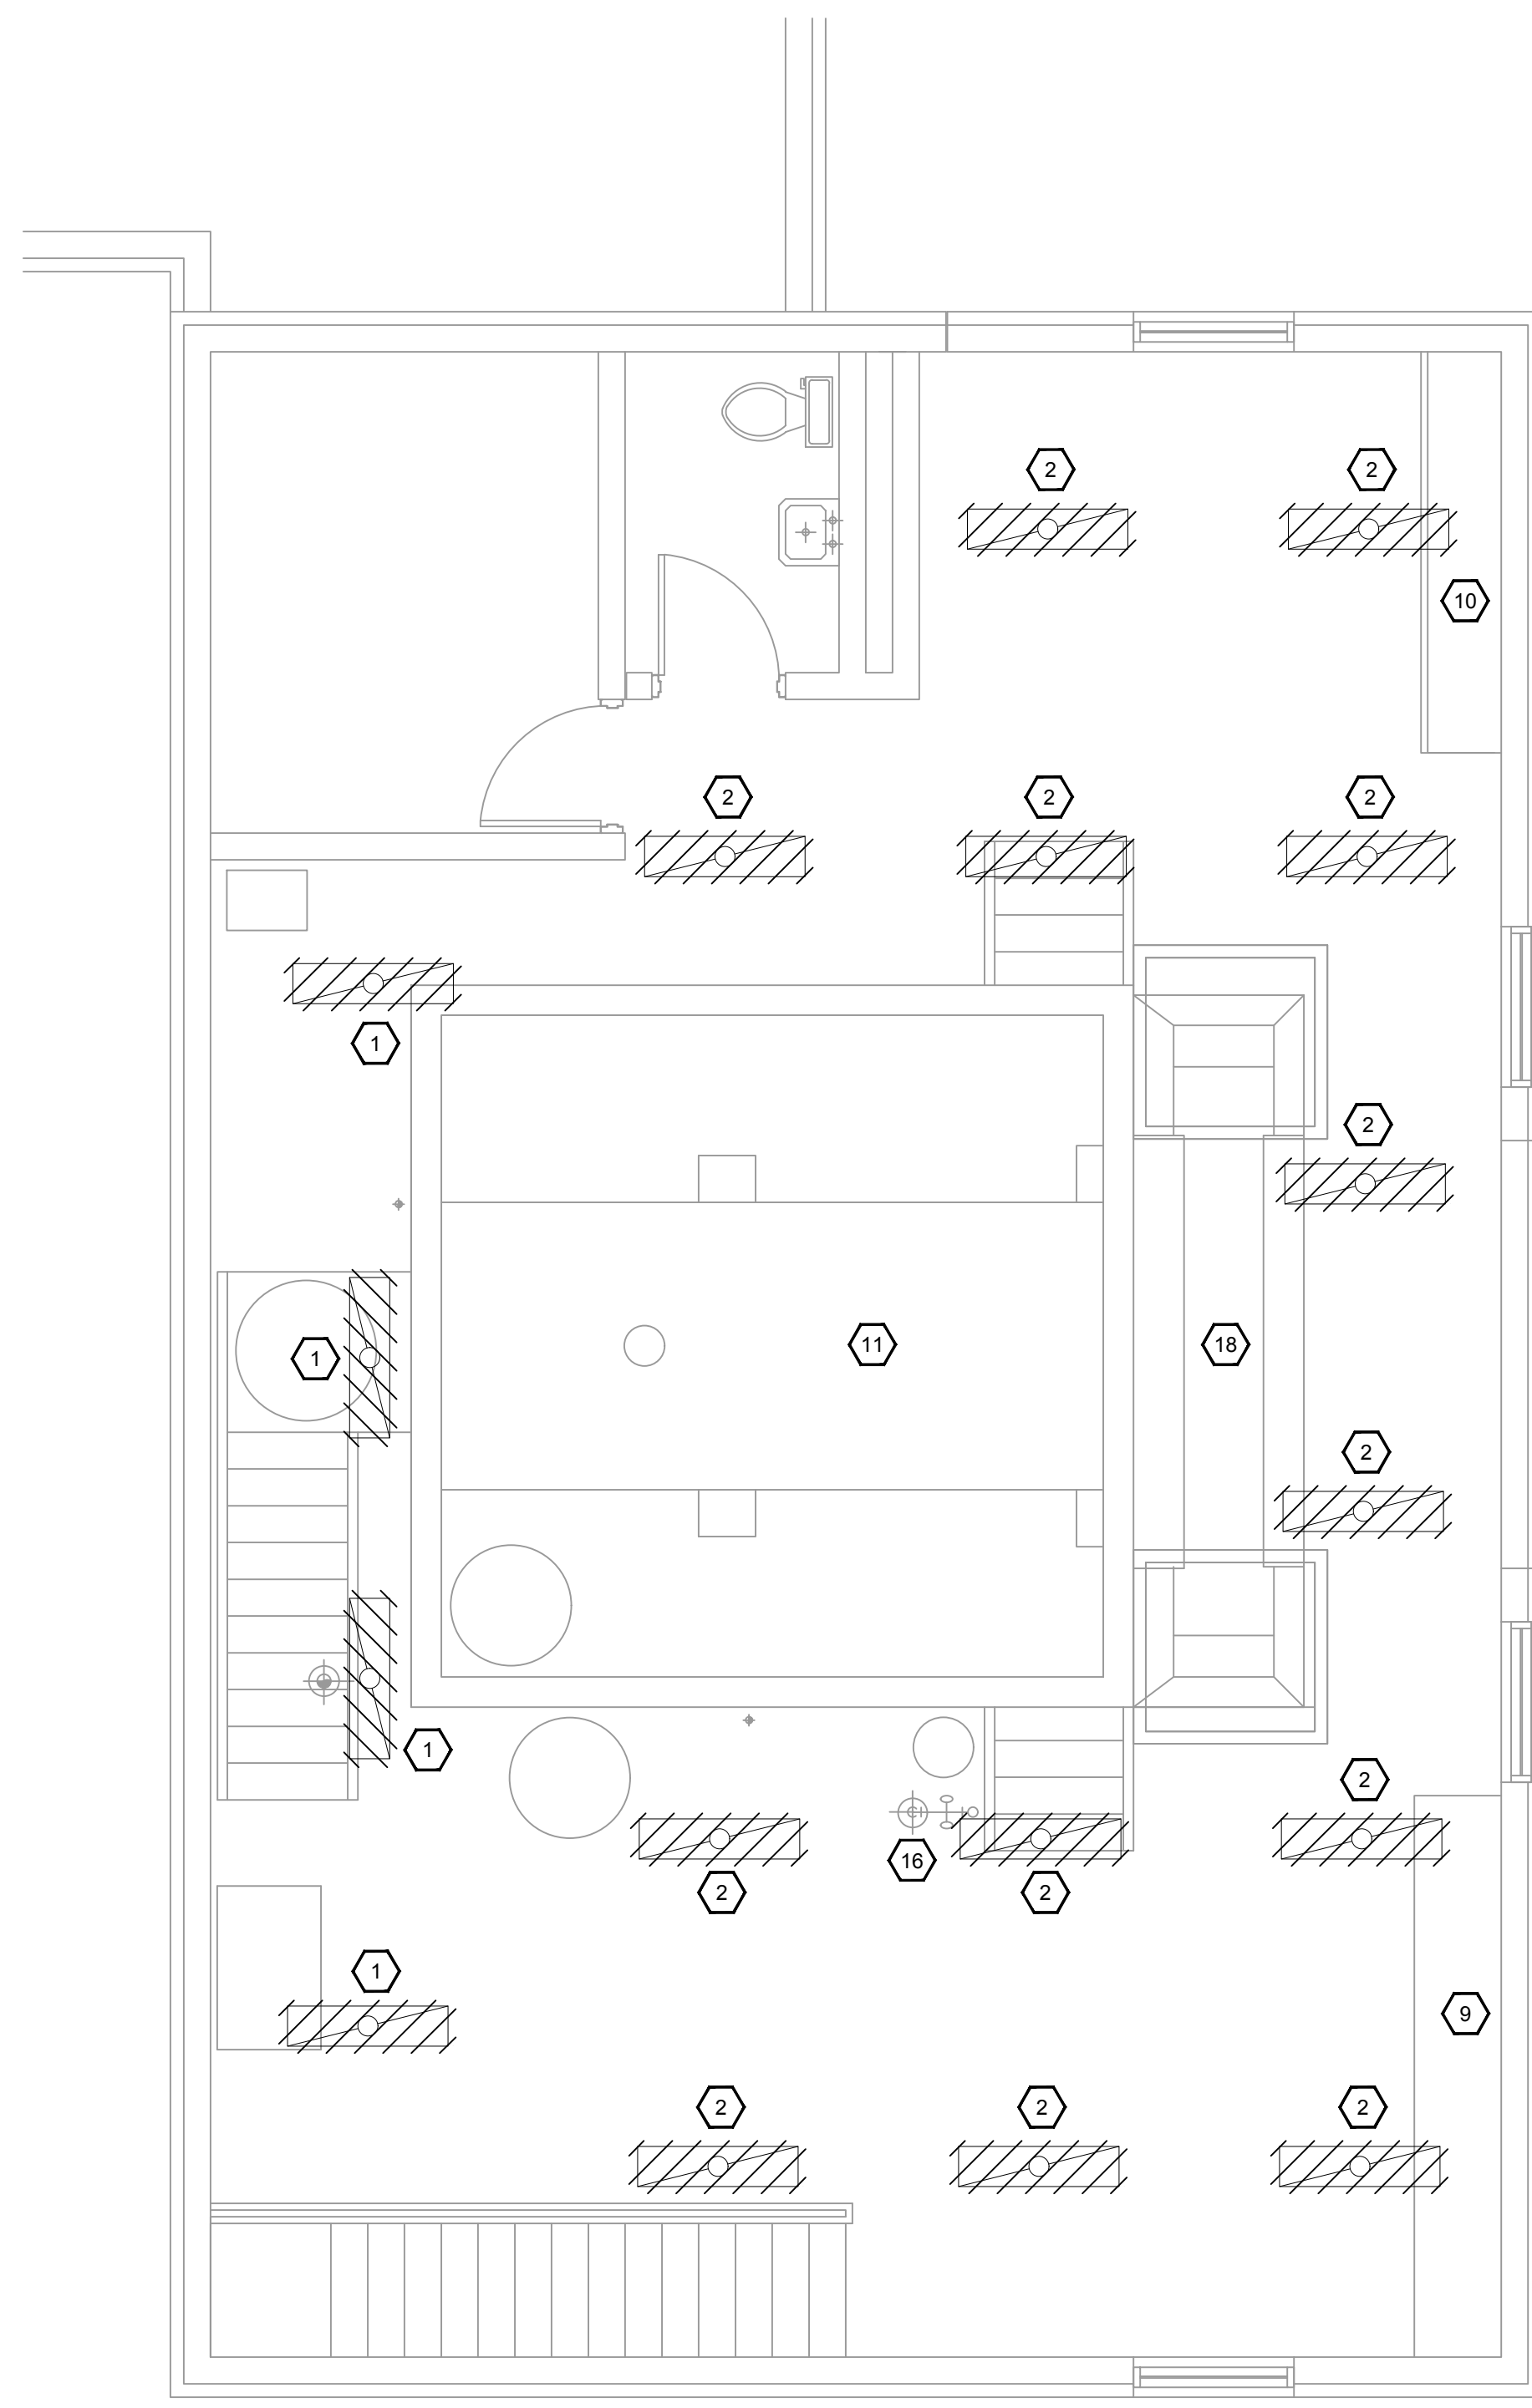


SECOND FLOOR LIGHTING PLAN - DEMOLITION

SCALE: 1/4"=1'-0"

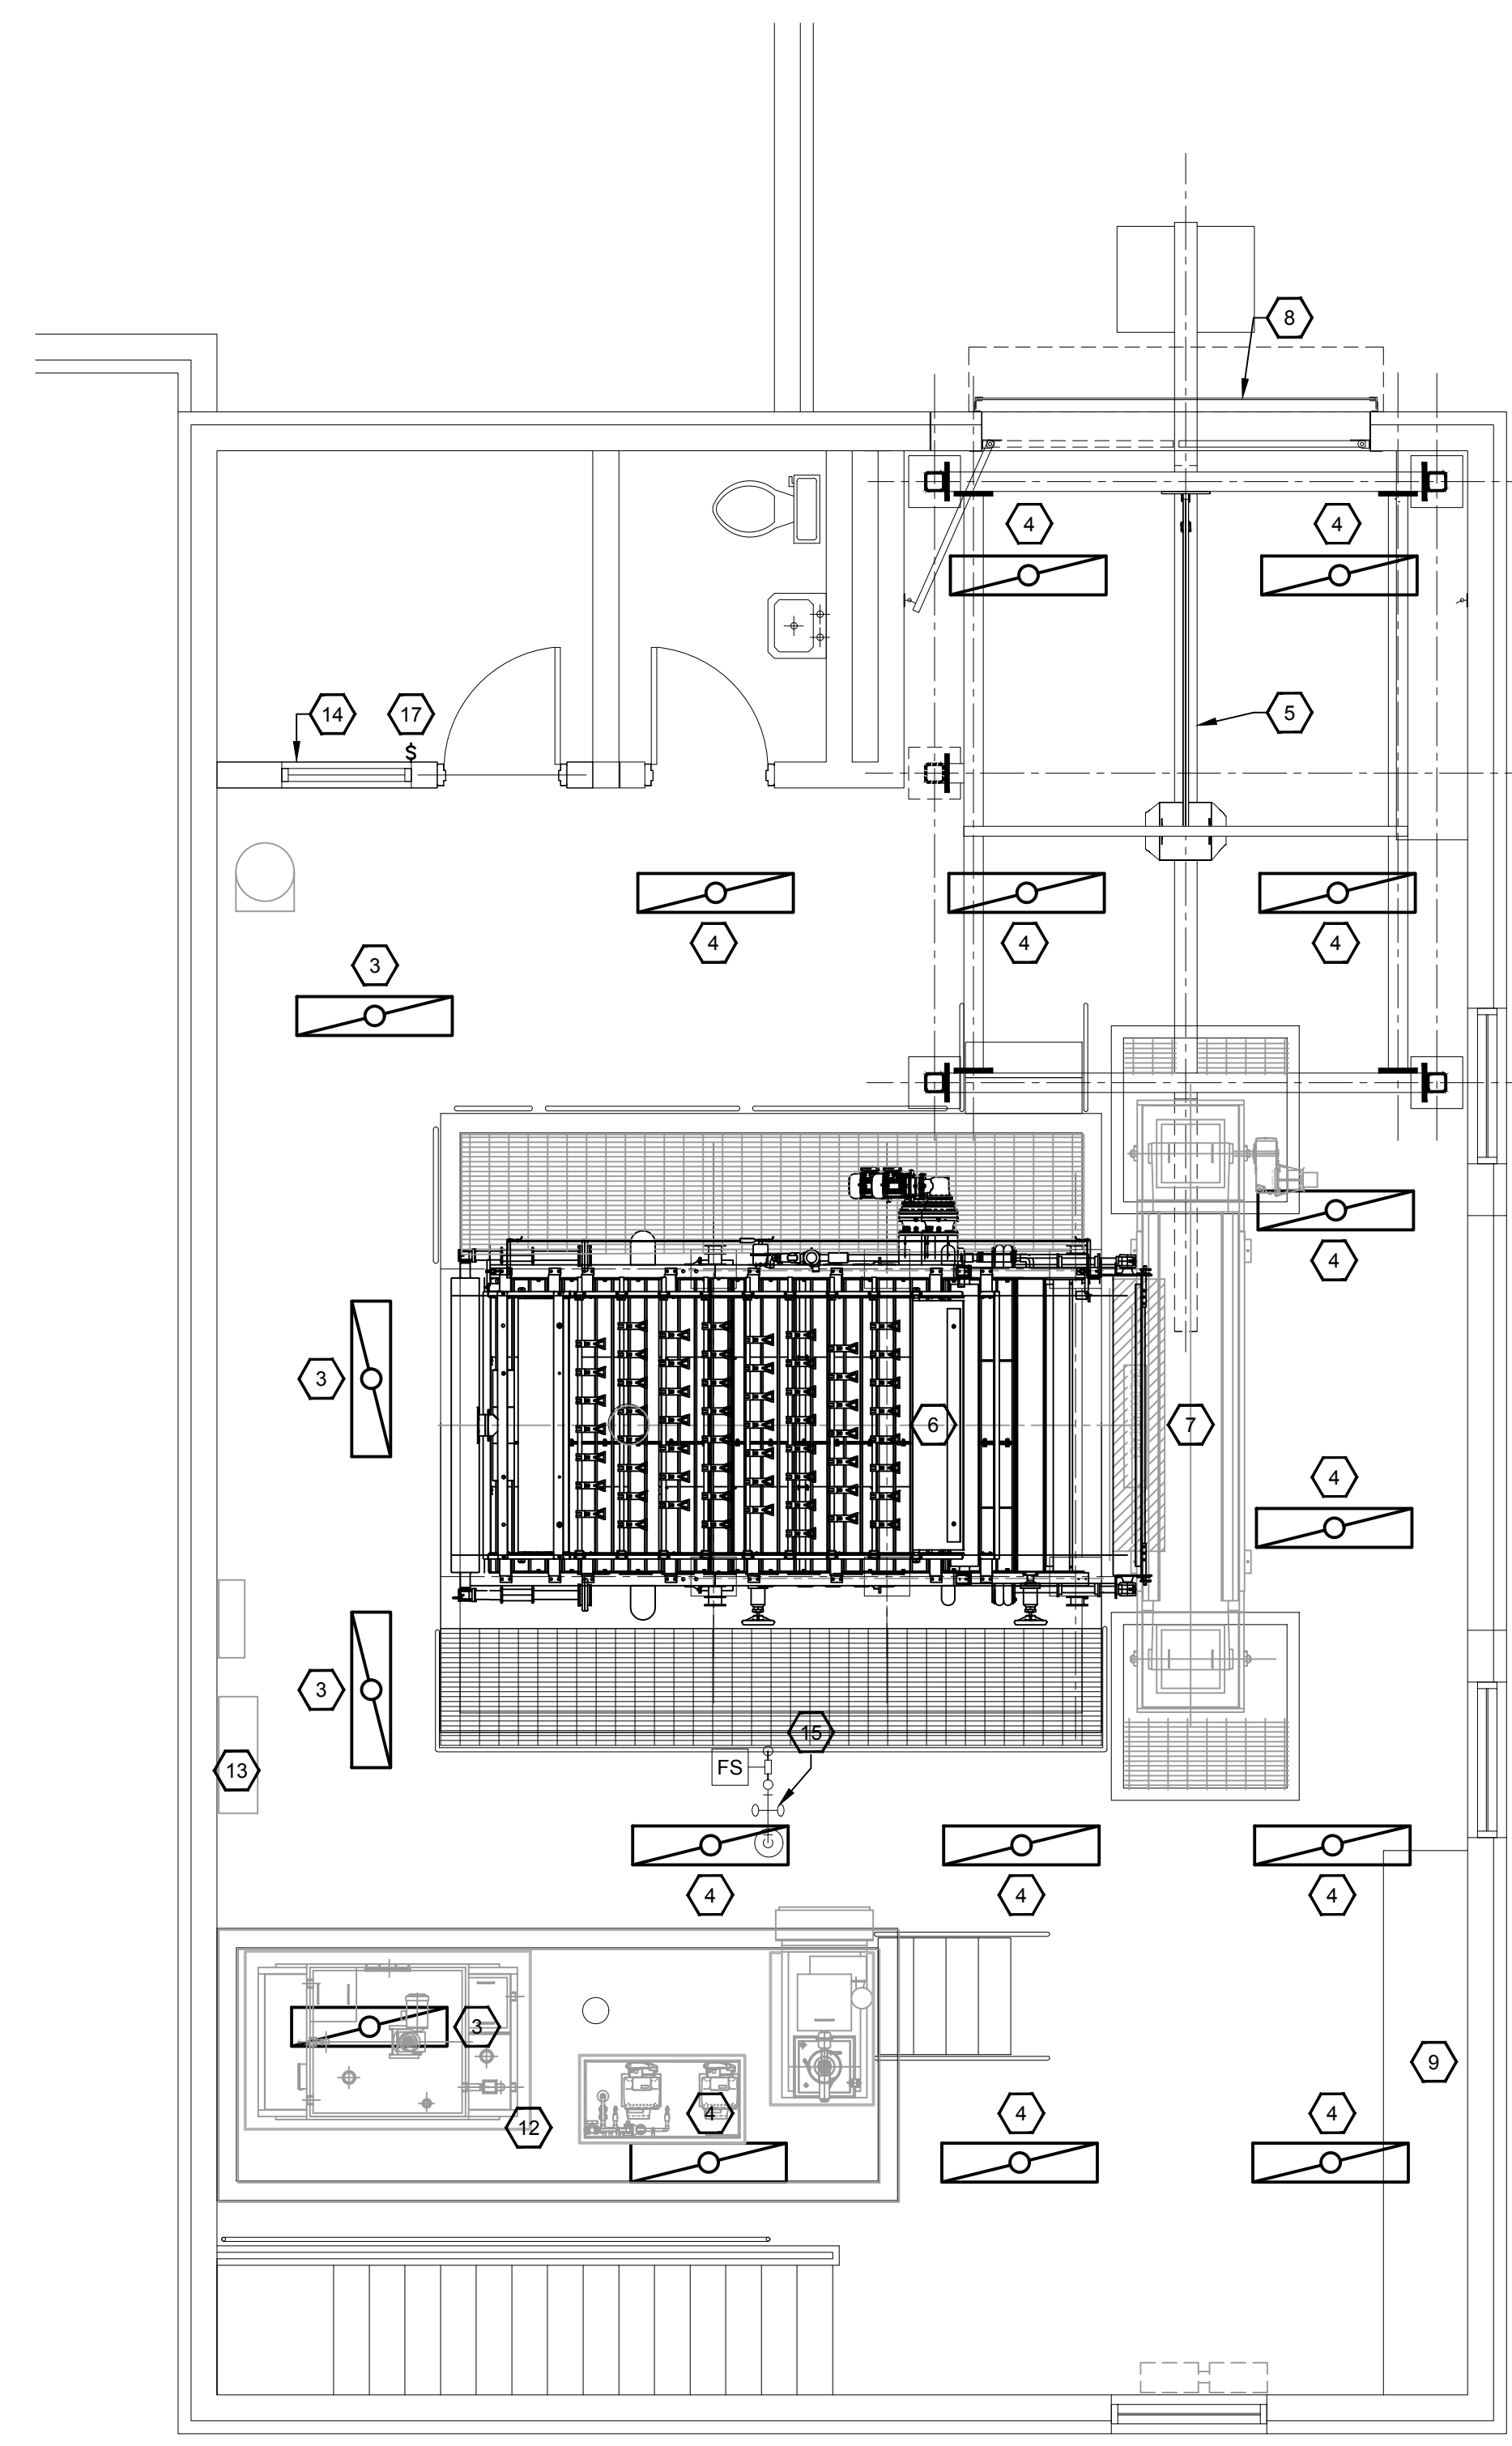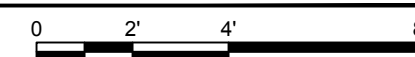

SECOND FLOOR LIGHTING PLAN - NEW WORK

SCALE: 1/4"=1'-0"

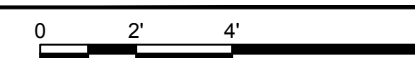

GENERAL NOTES:

1. ALL LIGHTING (EXCEPT WALL MOUNTED EMERGENCY EGRESS LIGHTING) IN THE BELT FILTER PRESS ROOM SHALL BE REPLACED.
2. THE EXISTING T-12 LINEAR FLUORESCENTS (BOTH SURFACE MOUNTED AND PENDANT MOUNTED) SHALL BE REPLACED WITH LED LUMINAIRES, BEGHELLI BS100LED-PG-4-HT-80W-WT41-120-27V. LUMINAIRE SHALL BE DOUBLE PENDANT OR SURFACE MOUNTED AS APPROPRIATE.
3. CONTRACTOR SHALL DISPOSE OF REMOVED LUMINAIRES IN A LEGAL MANNER.
4. CEILING SHALL BE PAINTED TO IN ACCORDANCE WITH SPECIFICATION SECTION 099600.
5. EXISTING CIRCUITS (LP1-22 AND LP1-24) AND LIGHTING CONTROLS SHALL BE REUSED. REFER TO E-601 FOR LP1 SCHEDULE.
6. MOUNTING HEIGHTS OF ALL PENDANT MOUNTED LUMINAIRES SHALL BE RAISED TO WITHIN 6" OF CEILING TO CLEAR NEW EQUIPMENT- BELT FILTER PRESS, MONORAIL, ETC. COORDINATE LUMINAIRE INSTALLATION WITH EQUIPMENT INSTALLER.

SHEET KEYNOTES:

1. EXISTING SURFACE MOUNTED T-12 LINEAR FLUORESCENT LUMINAIRES TO BE REMOVED.
2. EXISTING PENDANT MOUNTED T-12 LINEAR FLUORESCENT LUMINAIRES TO BE REMOVED.
3. NEW SURFACE MOUNTED LED LUMINAIRES TO BE INSTALLED.
4. NEW PENDANT MOUNTED LED LUMINAIRES TO BE INSTALLED.
5. NEW OVERHEAD MONORAIL WITH MOTORIZED HOIST AND TROLLEY.
6. NEW BELT FILTER PRESS.
7. NEW BELT CONVEYOR.
8. NEW COILING DOOR.
9. EXISTING MOTOR CONTROL CENTER (MCC) TO REMAIN. INCLUDES PANELBOARD LP1 CONTAINING EXISTING LIGHTING CIRCUITS.
10. EXISTING BELT FILTER PRESS CONTROL PANEL TO BE REMOVED.
11. EXISTING BELT FILTER PRESS TO BE REMOVED.
12. NEW POLYMER PROCESSING EQUIPMENT.
13. NEW BELT FILTER PRESS CONTROL PANEL.
14. NEW WALL.
15. NEW EMERGENCY SHOWER/EYE WASH STATION.
16. EXISTING EMERGENCY SHOWER/EYE WASH STATION TO BE REMOVED.
17. NEW LIGHT SWITCH. CONNECT TO EXISTING SWITCHED LIGHTING CIRCUIT IN STORAGE ROOM.
18. EXISTING BELT CONVEYOR TO BE REMOVED.

GRW PROJECT NO. 4384

CLIENT PROJECT NO.

ALL RIGHTS RESERVED. NO PART OF THIS DOCUMENT SHALL BE REPRODUCED IN WHOLE OR IN PART WITHOUT THE WRITTEN PERMISSION OF GRW ENGINEERS, INC. AND SHALL NOT BE USED FOR ANY OTHER PROJECT OTHER THAN THIS SPECIFIC PROJECT WITHOUT THE WRITTEN PERMISSION.



BELT FILTER PRESS REPLACEMENT LIGHTING DEMO AND NEW WORK PLAN
TAYLOR MILL TREATMENT PLANT
NORTHERN KENTUCKY WATER DISTRICT

DESIGNED	JKG
DRAWN	CGT
REVIEWED	WLM
APPROVED	WLM

NO.	REVISIONS DESCRIPTION	DATE	BY

THIS RECORD DOCUMENT HAS BEEN PREPARED BASED ON INFORMATION PROVIDED BY THE CONSTRUCTION CONTRACTOR GRW ENGINEERS, INC. HAS ATTEMPTED TO VERIFY THE ACCURACY AND/OR COMPLETENESS OF THIS INFORMATION BUT SHALL NOT BE RESPONSIBLE FOR ANY ERRORS OR OMISSIONS WHICH MAY BE INCORPORATED HEREIN AS A RESULT.


ENGINEER/ARCHITECT: David C. Osborne
CONSTRUCTION COMPANY: Dugan & Meyers
DATE: 4/23/19

DATE: **APRIL, 2019**
SCALE: **1/4" = 1'-0"**
SHEET NO. **E-102**

PLOTTED BY: mwilliamson

PRINTED: 4/26/2019 @ 10:35PM

FILE NAME: U:\4384-NKWD\TMT\BFP\Working Drawings\AutoCAD\4384 E-103.dwg

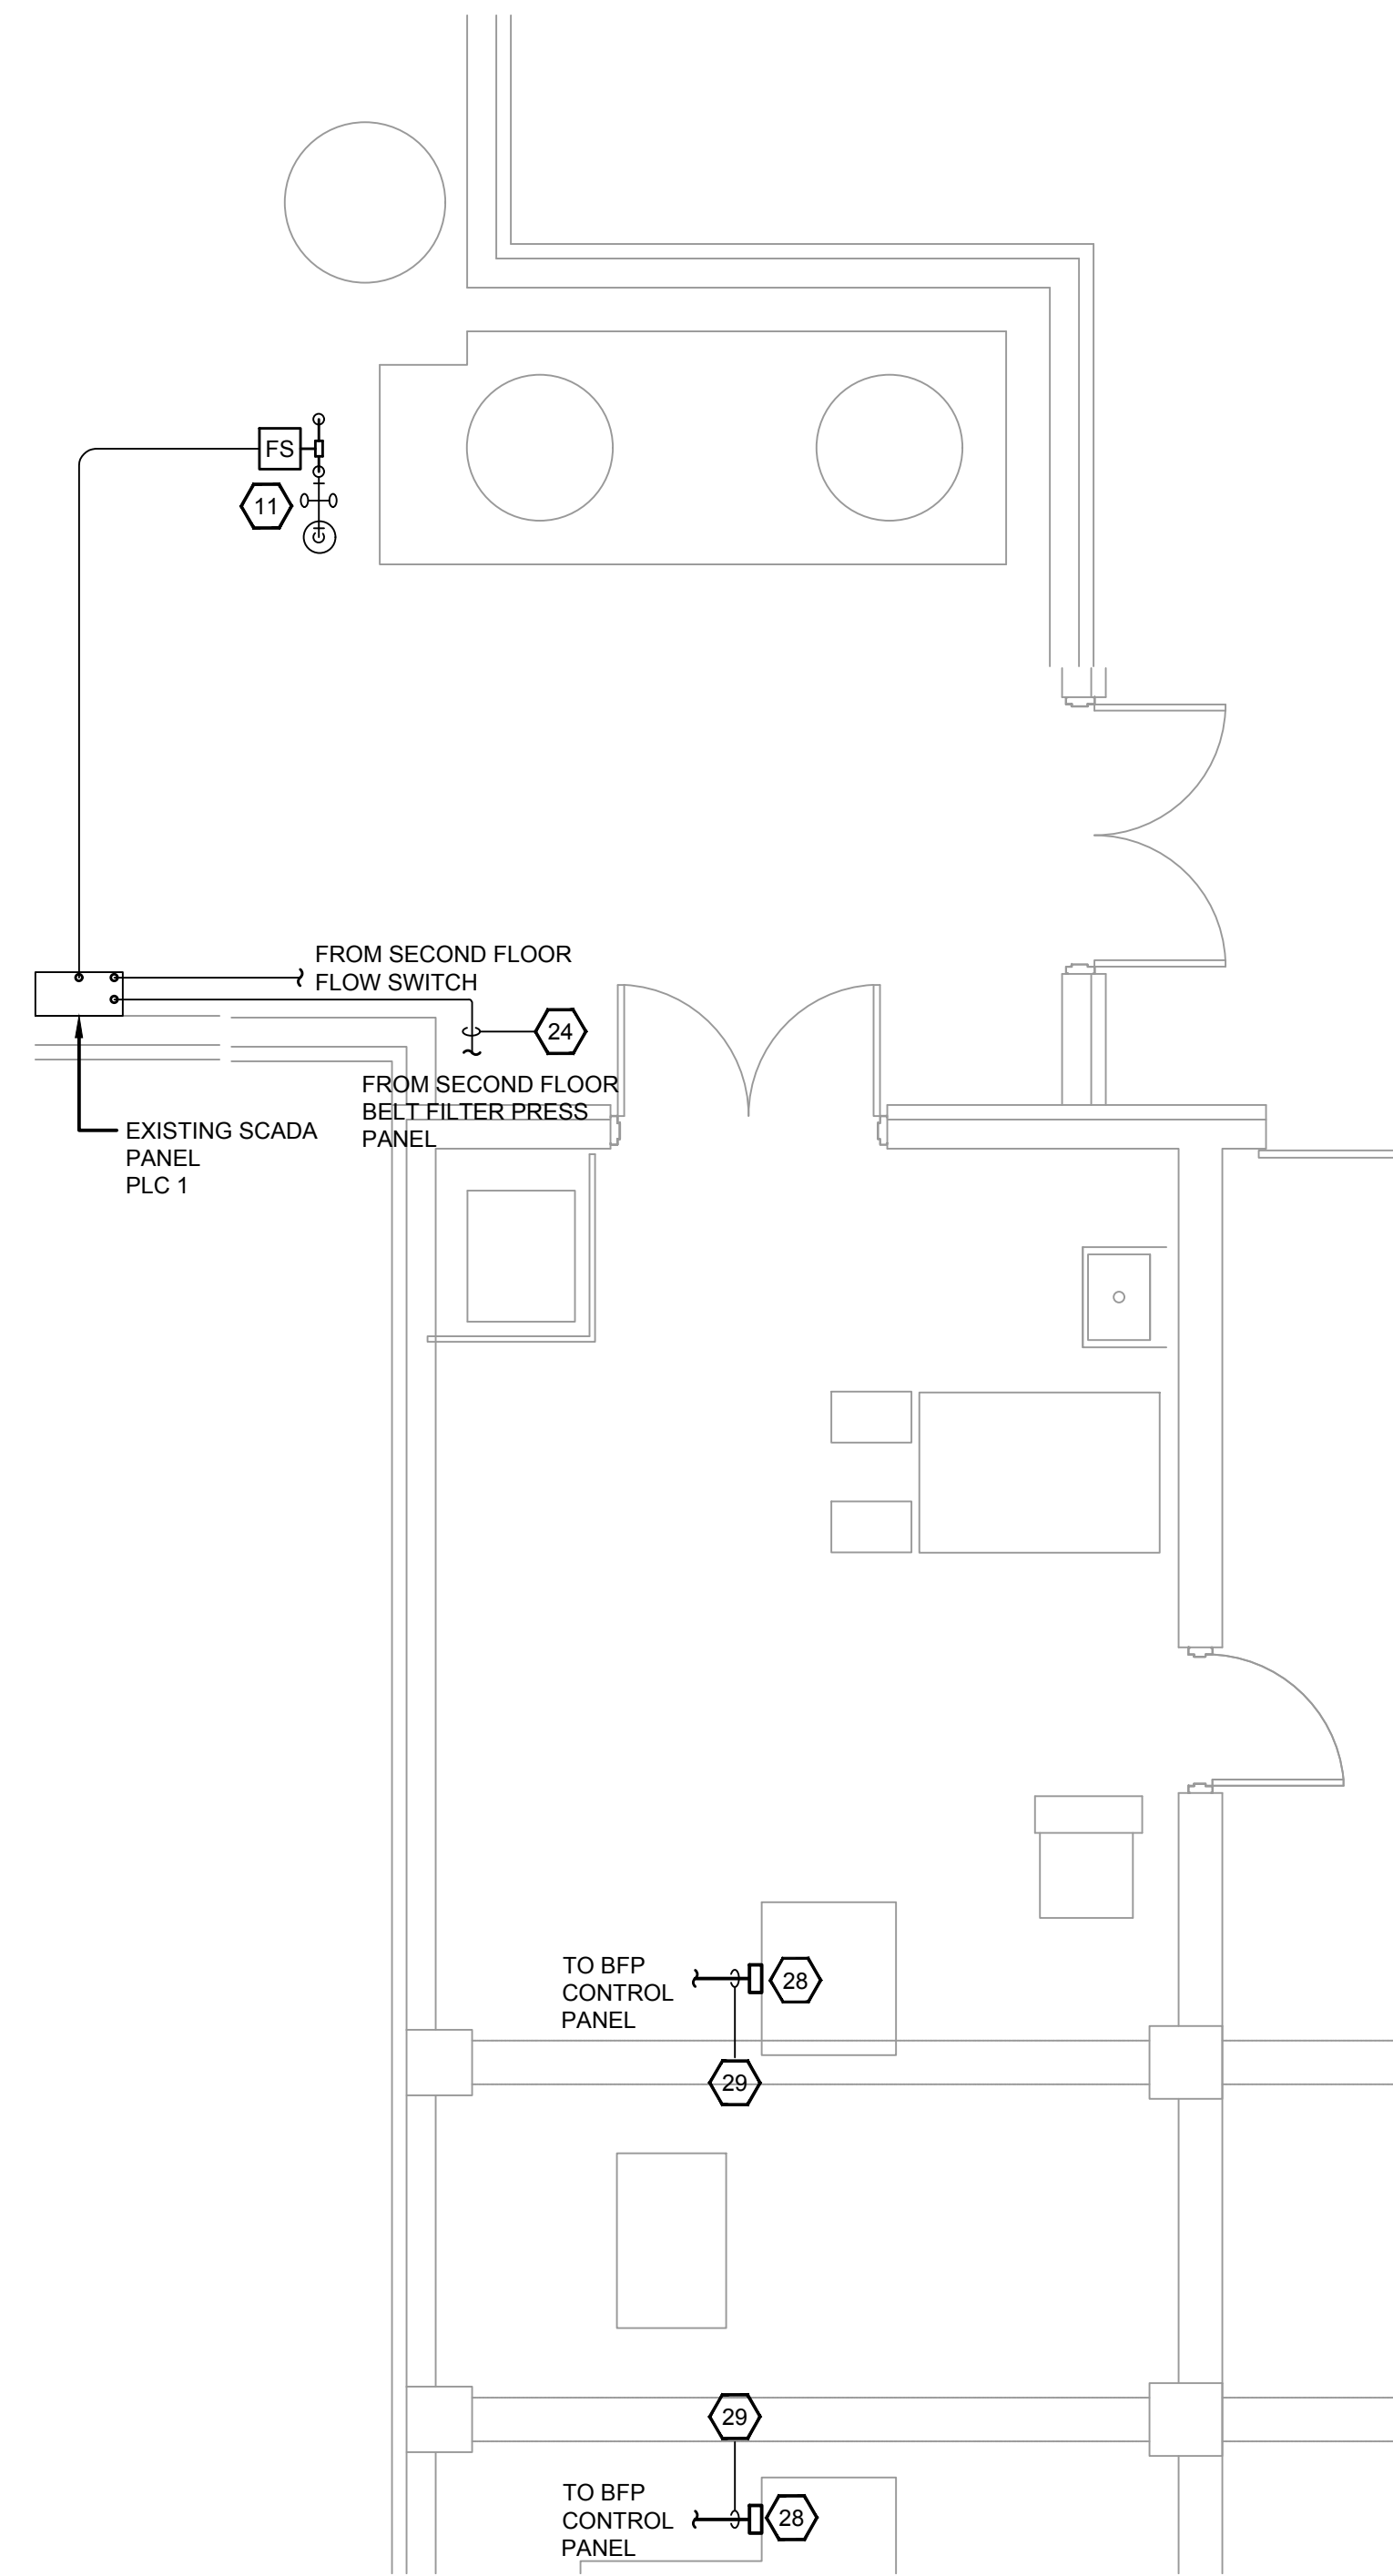

**PARTIAL FIRST FLOOR
NEW WORK PLAN - ELECTRICAL**

SCALE: 1/4"=1'-0"

SCHEDULE OF ALARMS

BELT FILTER PRESS


NO	DESCRIPTION
1	EMERGENCY STOP
2	LIMIT SWITCH FOR BELT ALIGNMENT
3	LOW WATER PRESSURE
4	LOW AIR OR HYDRAULIC PRESSURE
5	MAIN BELT DRIVE FAIL
6	POLYMER PUMP FAIL
7	SLUDGE PUMP FAIL

CONVEYOR BELT

NO	DESCRIPTION
1	EMERGENCY STOP
2	BELT MIS-ALIGNMENT
3	ZERO SPEED SWITCH
4	BELT SLIP OR BREAK

POLYMER SYSTEM

NO	DESCRIPTION
1	FEEDER HOPPER LEVEL ALARM
2	FEEDER VARIABLE FREQUENCY DRIVE FAIL ALARM
3	MIX TANK HIGH-HIGH LEVEL ALARM
4	MIX TANK LOW-LOW LEVEL ALARM

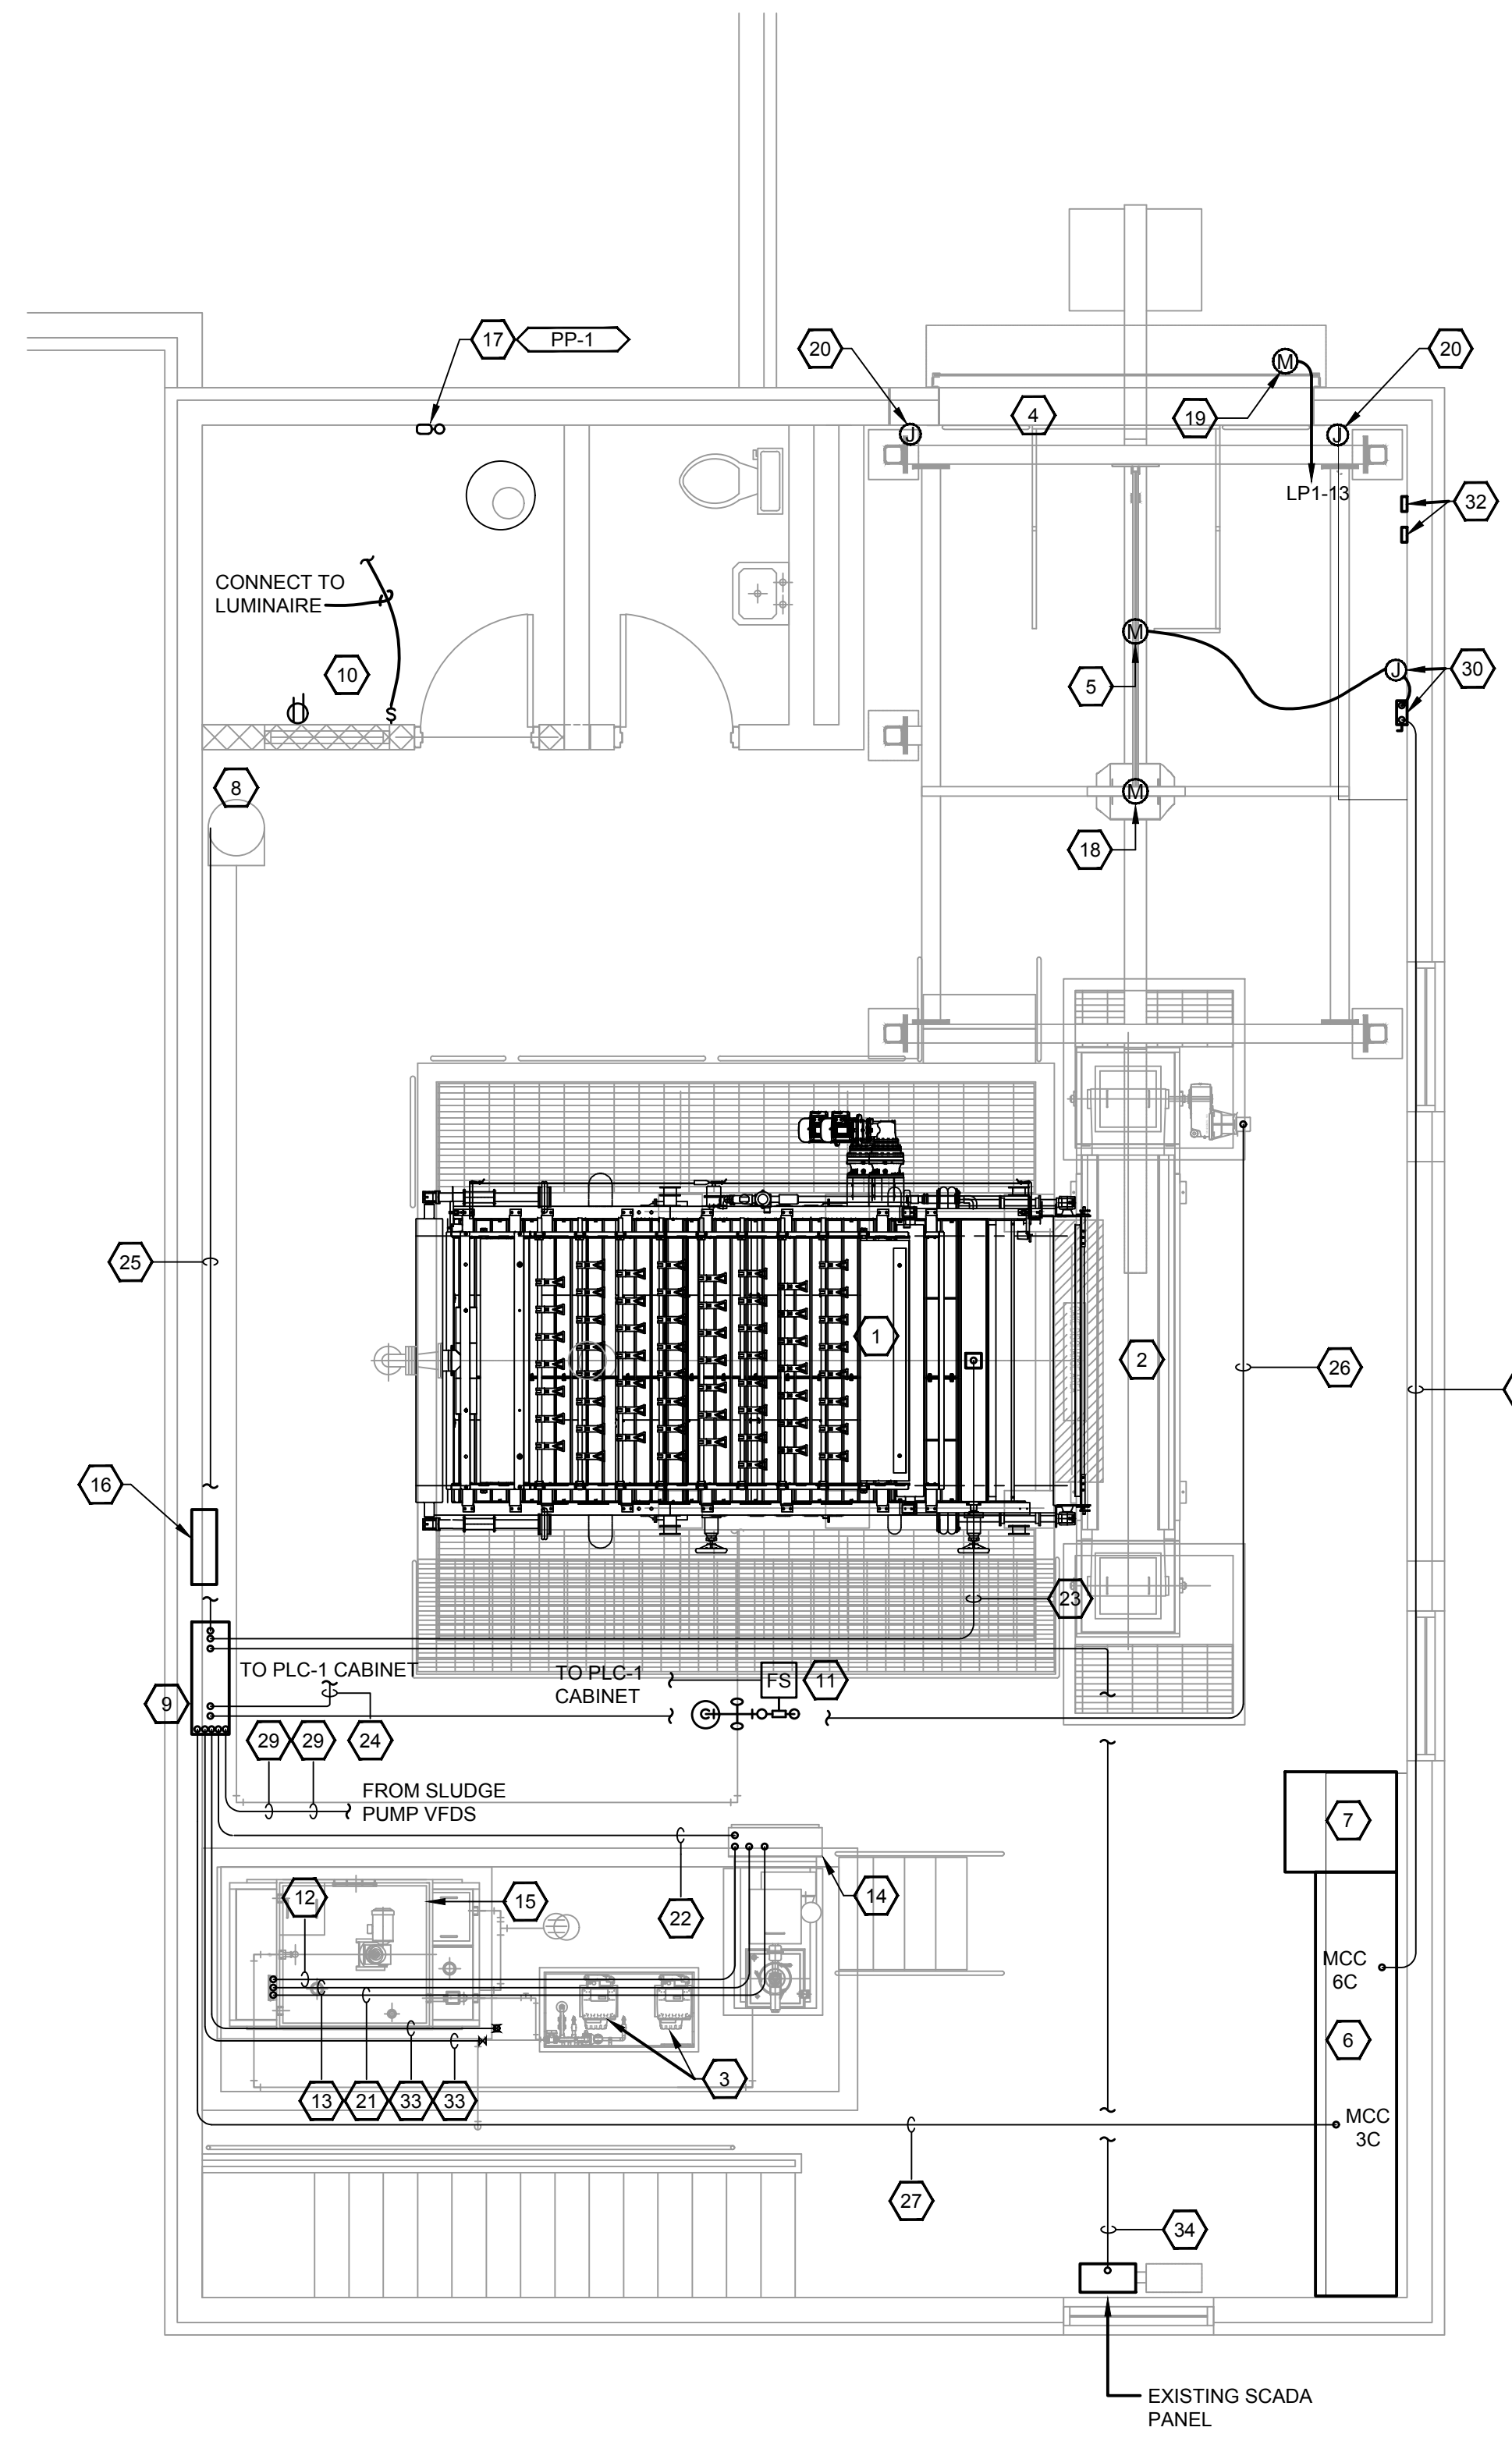

SECOND FLOOR ELECTRICAL PLAN - NEW WORK

SCALE: 1/4"=1'-0"

THIS RECORD DOCUMENT HAS BEEN PREPARED BASED ON INFORMATION PROVIDED BY THE CONSTRUCTION CONTRACTOR GRW ENGINEERS, INC. HAS ATTEMPTED TO VERIFY THE ACCURACY AND/OR COMPLETENESS OF THIS INFORMATION BUT SHALL NOT BE RESPONSIBLE FOR ANY ERRORS OR OMISSIONS WHICH MAY BE INCORPORATED HEREIN AS A RESULT.

GRW
engineering | architecture | geospatial
www.grwinc.com

ENGINEER/ARCHITECT: David C. Osborne
CONSTRUCTION COMPANY: Dugan & Meyers
DATE: 4/23/19

GENERAL NOTES:


- REFER TO SCHEDULES ON SHEETS E-601 AND E-602.
- REFER TO SHEETS E-701 AND E-702 FOR BELT PRESS CONTROL PANEL INTERCONNECTIONS/ POINT TO POINT DRAWING.
- SHOWN ALARMS ARE DESCRIPTIVE. SCADA PROGRAMMING AND ALARM DESIGN TO BE DONE BY OTHERS. NOTE THAT CONTRACTOR SHALL PROVIDE ADDITIONAL ETHERNET SWITCH AND DIGITAL INPUT CARD FOR EXISTING SCADA CABINETS FOR SCADA CONNECTION.
- ONLY THE INTERCONNECTIONS TO BE MADE BY CONTRACTOR ARE SHOWN. FOR FULL LIST OF INTERCONNECTIONS, REFER TO MANUFACTURER SCHEMATICS.

SHEET KEYNOTES:

- NEW BELT FILTER PRESS.
- NEW CONVEYOR BELT.
- NEW POLYMER PUMPS.
- NEW OUTSIDE OVERHEAD COILING DOOR.
- NEW ELECTRIC HOIST WITH TROLLEY MOTOR.
- EXISTING 600 AMPERE, 208/120 VOLT, THREE PHASE, FOUR WIRE, SQUARE D, MOTOR CONTROL CENTER (MCC), TO REMAIN. FURNISH AND INSTALL NEW BUCKETS FOR NEW EQUIPMENT.
- EXISTING CONTROL CABINET WITH VFDS TO REMAIN.
- NEW AIR COMPRESSOR. SEE EQUIPMENT MANUFACTURER RECOMMENDATIONS.
- NEW BELT FILTER PRESS (BFP) CONTROL PANEL. PROVIDE REQUIRED CONNECTIONS TO EXISTING PLANT SCADA AS DETAILED IN KEYNOTES 24 AND 34.
- NEW WALL - FURNISH AND INSTALL ALL NEW ELECTRICAL DEVICES - RECEPTACLE, SWITCH, ETC. CONNECT NEW LIGHT SWITCH TO EXISTING LUMINAIRE. CONNECT NEW RECEPTACLE TO EXISTING RECEPTACLE BRANCH CIRCUIT LP1-32. MATCH WIRING DEVICES TO EXISTING.
- FLOW SWITCH ALARM FURNISHED WITH NEW SHOWER/EYE WASH STATION. PROVIDE (2) #14 IN 3/4" C TO EXISTING SCADA PANEL PLC-1 AS SHOWN FOR MONITORING SHOWER/EYE WASH STATION FLOW SWITCH.
- TWO RUNS OF EACH OF THE FOLLOWING FROM THE POLYMER SYSTEM JUNCTION BOX TO CONTROL PANEL: (2) #14 IN 3/4" C FOR POWER TO MIXING/AGE TANK TRANSDUCERS, (2) #16 SHIELDED CABLE IN 3/4" C FOR SIGNAL FROM MIXING/AGE TANK TRANSDUCERS.
- (2) #12, (1) #12 GND IN 3/4" C FOR POWER TO TRANSFER VALVE FROM THE POLYMER SYSTEM CONTROL PANEL TO SYSTEM JUNCTION BOX.
- NEW POLYMER CONTROL PANEL AND PROCESSING UNIT.
- POLYMER MIXING AND AGING TANK.
- PUMP SPEED CONTROLS FOR EXISTING POLYMER SYSTEM ON FIRST FLOOR TO REMAIN AS A BACKUP SYSTEM. RELOCATE TO POSITION SHOWN AND LOWER PANEL TO NO MORE THAN 78" TO TOP OF PANEL AFF.
- PLUMBING CIRCULATION PUMP - 120 VOLTS, SINGLE PHASE. CONNECT TO NEARBY EXISTING RECEPTACLE CIRCUIT LP1-32.
- NEW RETRACTABLE BEAM MOTOR. FURNISH AND INSTALL CEILING MOUNTED RECEPTACLE FED FROM COILING DOOR CIRCUIT LP1-13 FOR THIS EQUIPMENT.
- OVERHEAD DOOR CONTROLLER AND MOTOR. PROVIDE (2) #12, (1) #12 GND IN 3/4" C FOR THIS CIRCUIT. WIRE AUXILIARY CONTACT FOR COLLISION DETECTION TO RETRACTABLE BEAM MOTOR.
- PHOTO EYE SENSOR. PROVIDE CONDUIT/WIRING TO OVERHEAD DOOR CONTROLLER.
- (3) #12 AND (1) #12 GND IN 3/4" C FOR POWER TO POLYMER MIXER TANK MOTOR FROM POLYMER CONTROL PANEL.
- ONE RUN EACH OF THE FOLLOWING: (6) #12 IN 3/4" C FOR CONTROLS SIGNALS TO/FROM BFP PLC TO POLYMER PLC, (4) #14 IN 3/4" C FOR SPEED FEEDBACK FROM POLYMER PUMP VFDS TO BFP PLC, (4) #14 IN 3/4" C FOR SPEED SETPOINT FROM BFP PLC TO POLYMER SPEED PUMP VFDS, (4) #6 AND (1) #10 GND IN 1" C FOR POWER TO POLYMER CONTROL PANEL.
- ONE RUN EACH OF THE FOLLOWING FROM BELT PRESS JUNCTION BOX TO BFP PANEL PLC: (3) #12, (1) #12 GND IN 3/4" C FOR MAIN BELT MOTOR POWER, (1) #14 IN 3/4" C FOR VARIOUS CONTROL INPUTS.
- (8) #14 IN 3/4" C (INTERLOCKING RELAYS) FROM BFP CONTROL PANEL TO EXISTING SCADA PANEL PLC-1 (LOGIX 5563 BY ALLEN BRADLEY). REFER TO POINT TO POINT DRAWING ON SHEET E-702 FOR LIST OF RELAYS.
- (3) #12, (1) #12 GND IN 3/4" C FOR POWER TO AIR COMPRESSOR.
- ONE RUN EACH OF THE FOLLOWING: (3) #12, (1) #12 GND IN 3/4" C FOR POWER TO CONVEYOR MOTOR, (2) #16 SHIELDED FOR BFP CONVEYOR ZERO SPEED SWITCH INPUT TO BFP PLC, (12) #14 IN 3/4" C FOR VARIOUS CONTROLS SIGNALS BETWEEN BFP PANEL PLC AND BFP CONVEYOR.
- (4) #6, (1) #10 GND IN 1" C FOR POWER TO BELT FILTER PRESS CONTROL PANEL.
- EXISTING SLUDGE PUMP VFD.
- (2) #16 SHIELDED IN 3/4" C FOR SPEED REFERENCE / SPEED SETPOINT SIGNALS BETWEEN EXISTING SLUDGE PUMP VFD AND BELT FILTER PRESS PLC, AND (6) #14 IN 3/4" C FOR VARIOUS CONTROLS SIGNALS BETWEEN SLUDGE PUMP VFD AND BELT FILTER PRESS PLC.
- PROVIDE 30A, THREE PHASE NON FUSED DISCONNECT SWITCH (NEMA 4X), PROVIDE CONNECTION TO JUNCTION BOX FOR ELECTRIC CABLE REEL SERVING TROLLEY/HOIST MOTORS.
- (3) #10 AND (1) #10 GND IN 3/4" C FOR POWER TO TROLLEY/HOIST MOTORS FROM MCC 6C.
- WALL MOUNTED OVERHEAD DOOR AND RETRACTABLE BEAM MOTOR CONTROLS. PROVIDE CONDUIT/WIRING TO RESPECTIVE OPERATING EQUIPMENT.
- (2) #12 AND (1) #12 GND IN 3/4" C FOR POWER TO SOLENOID VALVES. VALVES OPERATE ON SYSTEM SHUTDOWN FOR 10 MINUTES.
- CAT-5 CABLE IN 1" C FROM BFP CONTROL PANEL TO EXISTING SCADA CABINET IN PRESS ROOM.

GRW PROJECT NO. 4384


CLIENT PROJECT NO.

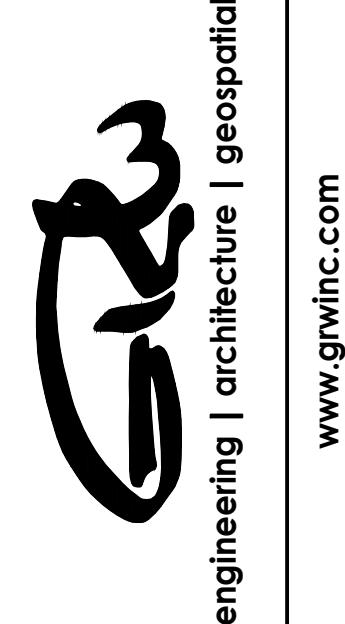


**BELT FILTER PRESS REPLACEMENT
ELECTRICAL NEW WORK PLANS**
TAYLOR MILL TREATMENT PLANT
NORTHERN KENTUCKY WATER DISTRICT

NO	DATE	DESCRIPTION	DESIGNED	DRAWN	REVIEWED	APPROVED
			JKG	JTR	WLM	WLM

DATE: **APRIL, 2019**
SCALE: **1/4" = 1'-0"**
SHEET NO.

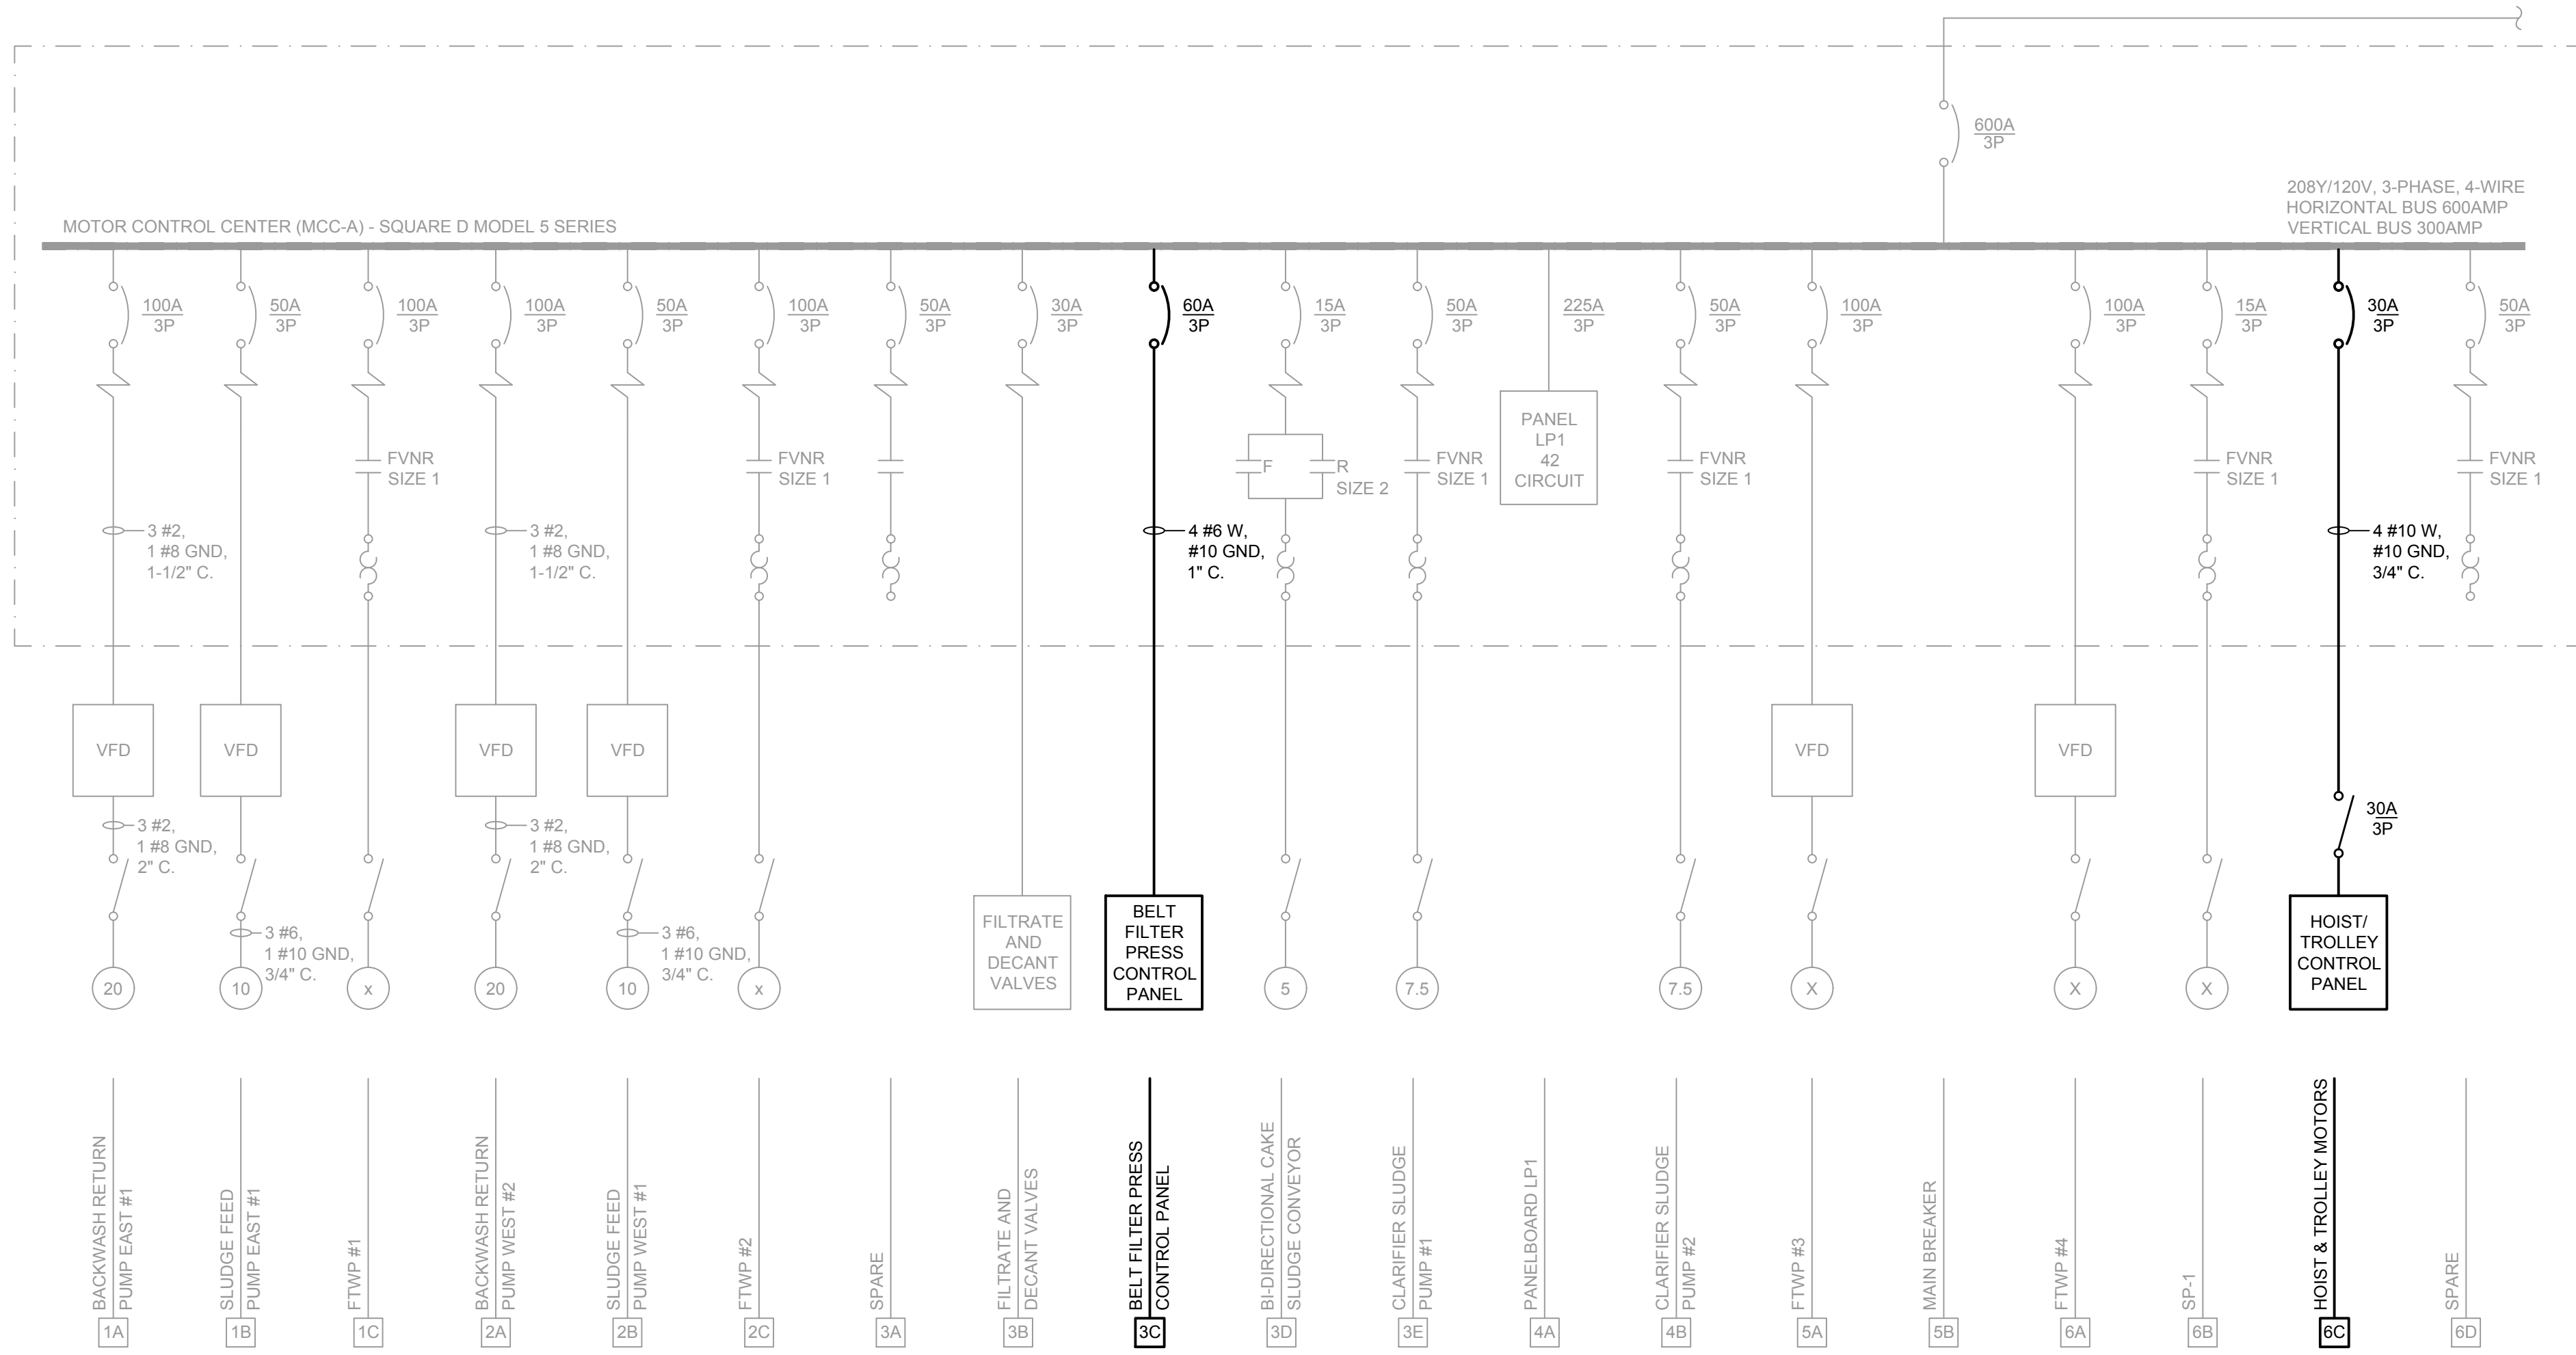

EXISTING ONE LINE DIAGRAM MODIFICATIONS (MCC)
NOT TO SCALE

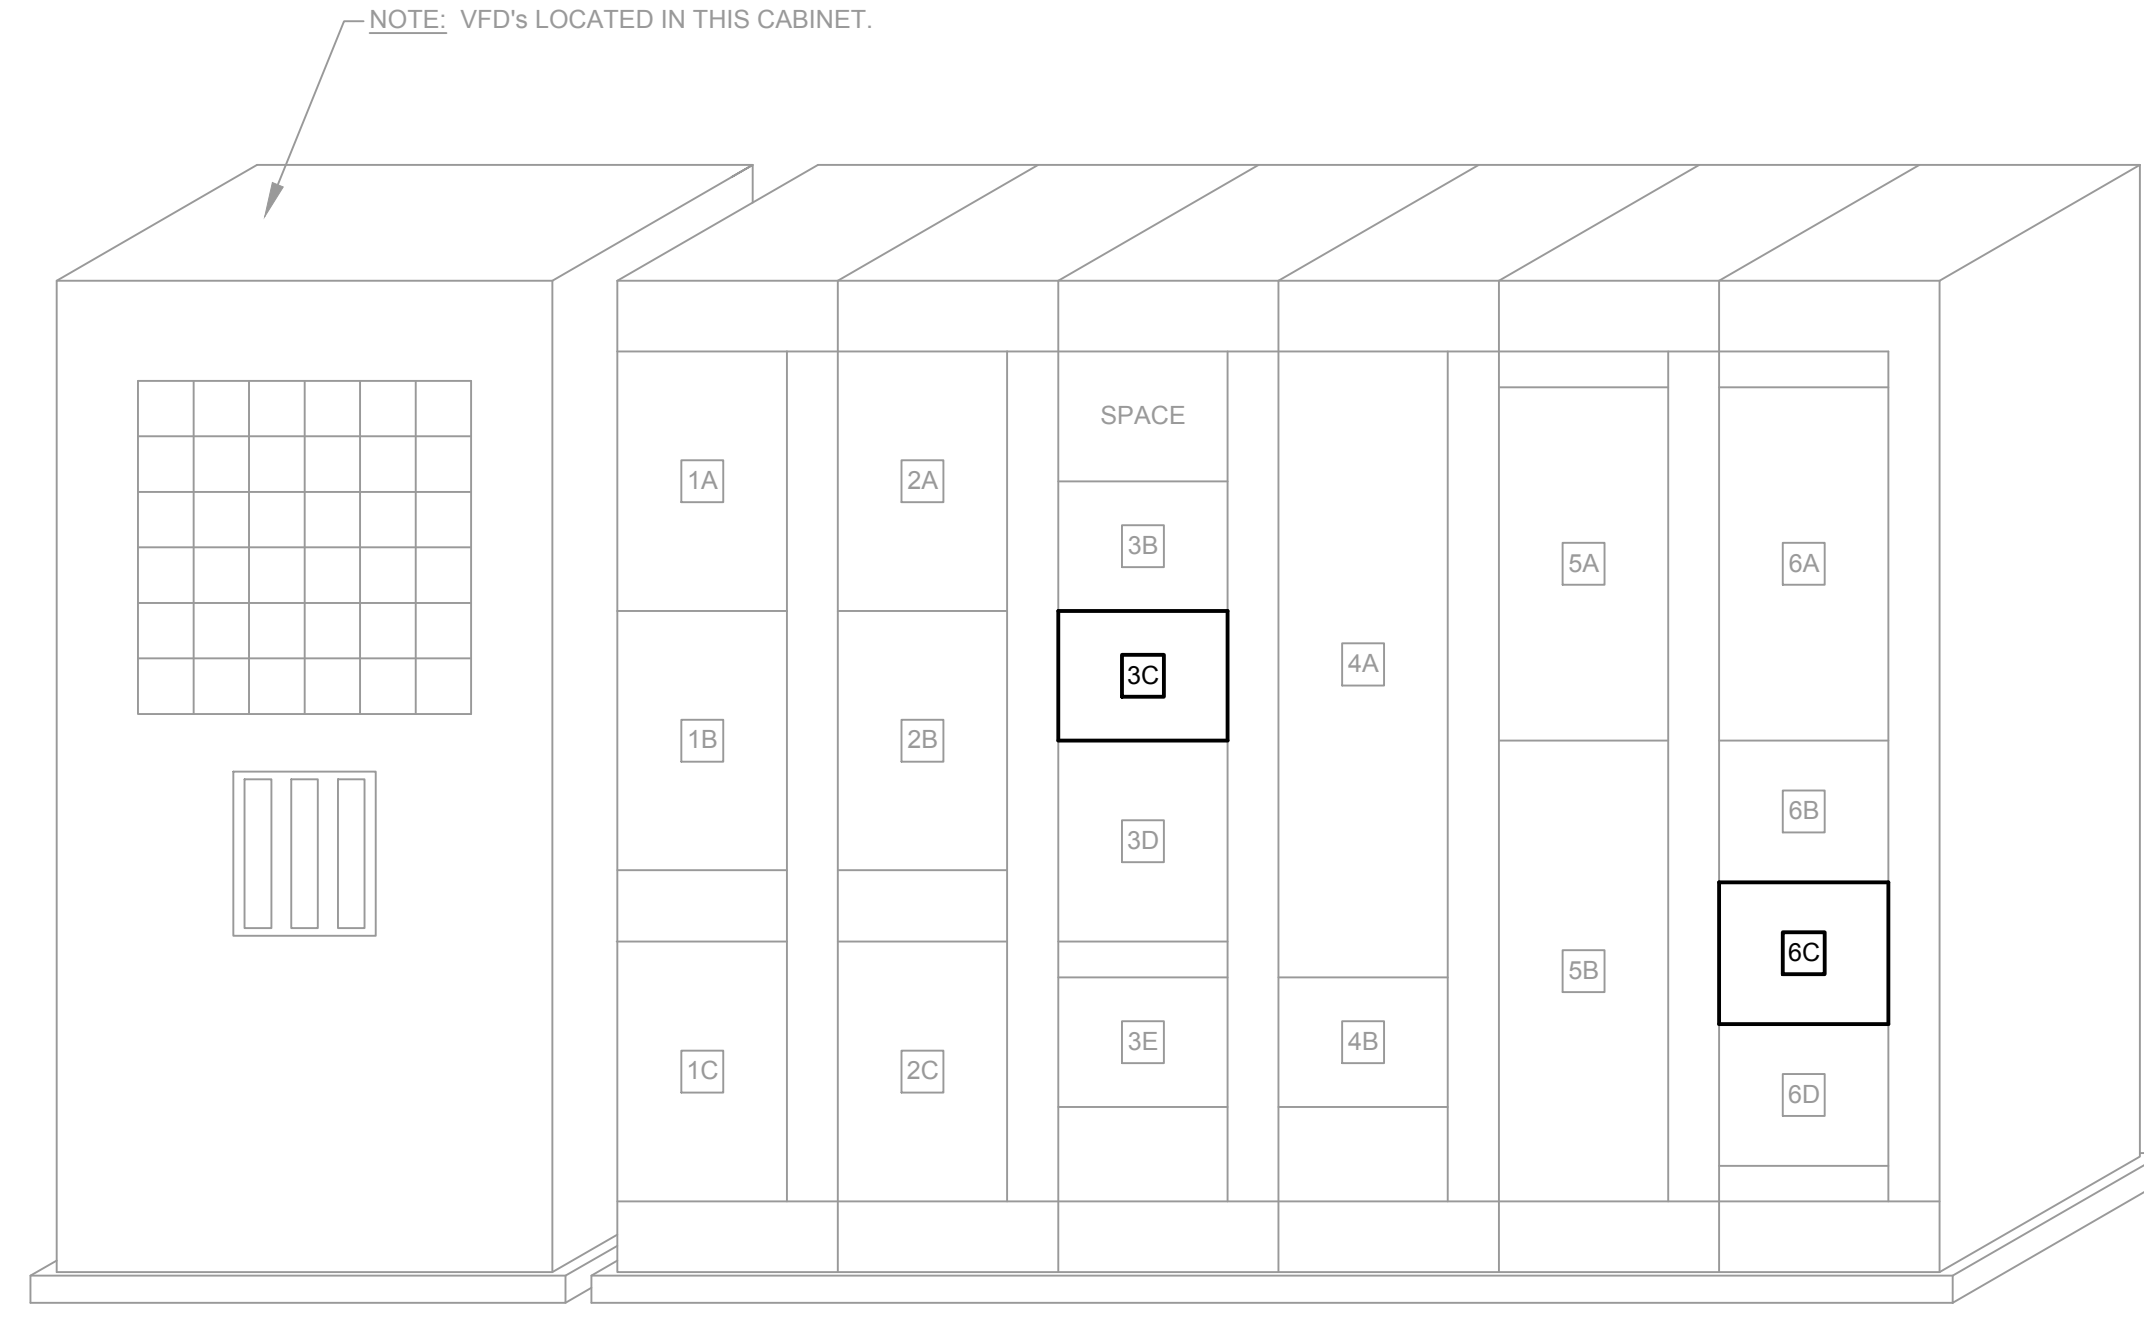

EXISTING MOTOR CONTROL CENTER MODIFICATIONS (MCC-A) - FRONT ELEVATION
NOT TO SCALE

MOTOR CONTROL CENTER - SCHEDULE OF LOADS

NO	LOAD DESCRIPTION	HORSEPOWER	BREAKER SIZE	POLES	CONTROL	LOAD
1A	BACKWASH RETURN PUMP EAST #1	20	100 AMPERES	3	VFD	21,375
1B	SLUDGE FEED PUMP EAST #1	10	50 AMPERES	3	VFD	11,083
1C	FTWP #1	X	100 AMPERES	3	FVNR, SIZE 1	16,553
2A	BACKWASH RETURN PUMP WEST #2	20	100 AMPERES	3	VFD	21,375
2B	SLUDGE FEED PUMP WEST #1	10	50 AMPERES	3	VFD	11,083
2C	FTWP #2	X	100 AMPERES	3	FVNR, SIZE 1	16,553
3A	SPARE	-----	50 AMPERES	3	-----	0
3B	FILTRATE AND DECANT VALVES	VALVES	30 AMPERES	3	-----	5,757
3C	BELT FILTER PRESS CONTROL PANEL	-----	60 AMPERES	3	NEW	9,248
3D	BI-DIRECTIONAL CAKE SLUDGE CONVEYOR	5	15 AMPERES	3	F/R, SIZE 2	4,318
3E	CLARIFIER SLUDGE PUMP #1	7.5	50 AMPERES	3	FVNR, SIZE 1	9,356
4A	PANELBOARD LP1	-----	225 AMPERES	3	-----	64,771
4B	CLARIFIER SLUDGE PUMP #2	7.5	50 AMPERES	3	FVNR, SIZE 1	9,356
5A	FTWP #3	X	100 AMPERES	3	VFD	16,553
5B	MAIN BREAKER	-----	600 AMPERES	3	-----	0
6A	FTWP #4	X	100 AMPERES	3	VFD	16,553
6B	SP-1	X	15 AMPERES	3	FVNR, SIZE 1	5,398
6C	HOIST & TROLLEY MOTORS	2 1/4	30 AMPERES	3	NEW	3,366
6D	SPARE (FULL VOLTAGE, NON-REVERSING), SIZE 1	-----	50 AMPERES	3	FVNR, SIZE 1	0
-----	LAMELLA BUILDING PANEL	-----	200 AMPERES	3	-----	57,575

PANELBOARD SCHEDULE - PANEL LP1
208Y/120 VOLT, THREE PHASE, FOUR WIRE
225 AMP MAIN BREAKER

CKT	AMP	POLE	WIRE	DESCRIPTION	LOAD	A	B	C	LOAD	DESCRIPTION	WIRE	POLE	AMP	CKT
1	15	3	12	SUPPLY & EXHAUST FANS	0.0	0.0	-----	-----	0.0	TRUCK BAY LIGHTS	12	1	20	2
3	15	3	12	SUPPLY & EXHAUST FANS	0.0	-----	0.0	-----	0.0	SPARE	12	1	20	4
5	15	3	12	SUPPLY & EXHAUST FANS	0.0	-----	-----	0.0	0.0	RECEPT GRINDER PUMP	12	1	20	6
7	15	1	12	FTW BASIN CIR BOARD X	0.0	0.0	-----	-----	0.0	SPACE	12	1	15	8
9	15	1	12	HTR DUMPSTER EAST END	0.0	-----	0.0	-----	0.0	HEATER #7 2ND FLR	12	1	15	10
11	15	1	12	HTR FAR EAST END	0.0	-----	-----	0.0	0.0	HEATER #5 TOP OF STAIRS	12	1	15	12
13	15	1	12	COILING DOOR/BEAM EXTENDER	1,127.0	1,127.0	-----	-----	0.0	HEATER #3 1ST FLOOR	12	1	15	14
15	15	1	12	HEATER ABOVE MCC	0.0	-----	0.0	-----	0.0	DOOR OPERATOR EAST	12	3	15	16
17	20	1	12	EXTERIOR POLE LIGHTS	0.0	-----	-----	0.0	0.0	DOOR OPERATOR EAST	12	3	15	18
19	20	1	12	EXTERIOR LIGHTS/TIME CLOCK	0.0	0.0	-----	-----	0.0	DOOR OPERATOR EAST	12	3	15	20
21	20	1	12	LIGHTS PUMP AREA	0.0	-----	631.8	-----	631.8	LGTS 2ND FLR WEST	12	2	20	22
23	20	1	12	ERMG LGTS/BATTERY PACK	0.0	-----	-----	561.6	561.6	LGTS 2ND FLR EAST	12	1	20	24
25	20	1	12	NL BATHROOM	0.0	0.0	-----	-----	0.0	SPARE	12	1	20	26
27	20	1	12	RECEPTACLE BOT STEPS	0.0	-----	0.0	-----	0.0	UNKNOWN	12	2	15	28
29	20	1	12	RECEPT DUMPSTER AREA	0.0	-----	-----	0.0	0.0	UNKNOWN	12	2	20	30
31	20	1	12	RECEPT PRESS AREA	0.0	0.0	-----	-----	0.0	RECEPT OFF & WALL FAN	12	1	20	32
33	15	3	12	GRINDER PUMP STATION	0.0	-----	0.0	-----	0.0	DOOR OPENER WEST	12	3	15	34
35	15	3	12	GRINDER PUMP STATION	0.0	-----	-----	0.0	0.0	DOOR OPENER WEST	12	3	15	36
37	15	3	12	GRINDER PUMP STATION	0.0	0.0	-----	-----	0.0	DOOR OPENER WEST	12	3	15	38
39	20	1	12	SPARE	0.0	-----	0.0	-----	0.0	SPARE	12	3	15	40
41	20	1	12	FILTER TO WASTE CNTRL PNL	0.0	-----	-----	0.0	0.0	RECEPT OFF ALARM	12	3	20	42

THIS RECORD DOCUMENT HAS BEEN PREPARED BASED ON INFORMATION PROVIDED BY THE CONSTRUCTION CONTRACTOR GRW ENGINEERS, INC. HAS ATTEMPTED TO VERIFY THE ACCURACY AND/OR COMPLETENESS OF THIS INFORMATION BUT SHALL NOT BE RESPONSIBLE FOR ANY ERRORS OR OMISSIONS WHICH MAY BE INCORPORATED HEREIN AS A RESULT.

GRW
engineering | architecture | geospatial
www.grwinc.com

ENGINEER/ARCHITECT: **David C. Osborne**
CONSTRUCTION COMPANY: **Dugan & Meyers**
DATE: 4/23/19

GRW PROJECT NO. 4384
CLIENT PROJECT NO.
ALL RIGHTS RESERVED. THE ACCURACY OF THIS INFORMATION SHALL NOT BE GUARANTEED. GRW ENGINEERS, INC. AND SHALL NOT BE RESPONSIBLE FOR ANY ERRORS OR OMISSIONS WHICH MAY BE INCORPORATED HEREIN AS A RESULT OF THIS PROJECT WITHOUT WRITTEN PERMISSION.

GRW
engineering | architecture | geospatial
www.grwinc.com

BELT FILTER PRESS REPLACEMENT ELECTRICAL DETAILS AND SCHEDULES
TAYLOR MILL TREATMENT PLANT
NORTHERN KENTUCKY WATER DISTRICT

NO	DATE	BY	DESCRIPTION

DESIGNED: JKG
DRAWN: JTR
REVIEWED: WLM
APPROVED: WLM

SCALE CHECK: THIS MARK SHOULD MEASURE EXACTLY 1" WHEN PLOTTED

DATE: APRIL, 2019
SCALE: NOT TO SCALE
SHEET NO. E-601

PLOTTED BY: mwilliamson

PRINTED - 4/23/2019 @ 2:38PM

FILE NAME: U:\4384-NKWD-TMTP-BFP-Working Drawings\AutoCAD\4384-E-602.dwg

NEW LOADS SCHEDULE

NO	LOAD DESCRIPTION	CKT	HP	BKR	POLES	CONDUIT	WIRE	VOLTAGE	LOAD
1	OVERHEAD COILING & RETRACTABLE BEAM MOTORS	LP1-13	0.50	20	1	3/4" GRC	2 #12 W/#12 GND	120	1,127
2	MONORAIL HOIST MOTOR	MCC 6C	2.00	20	3	3/4" GRC	3 #12 W/#12 GND	208	2,700
3	MONORAIL TROLLEY MOTOR	MCC 6C	0.25	20	3	3/4" GRC	3 #12 W/#12 GND	208	666
4	POLYMER FEED PUMPS	* BFP CNTRL PNL	0.67	20	3	3/4" GRC	3 #12 W/#12 GND	208/120	500
5	COMPRESSOR	* BFP CNTRL PNL	2.00	-----	3	3/4" GRC	3 #12 W/#12 GND	208/120	2,700
6	FILTER PRESS CONVEYOR	* BFP CNTRL PNL	1.50	-----	3	3/4" GRC	3 #12 W/#12 GND	208/120	2,375
7	FILTER PRESS MOTOR	* BFP CNTRL PNL	3.00	-----	3	3/4" GRC	3 #12 W/#12 GND	208/120	3,815
8	POLYMER MIXER	* BFP CNTRL PNL	1.50	20	3	3/4" GRC	3 #12 W/#12 GND	208/120	2,375
9	POLYMER PROCESS	* BFP CNTRL PNL	-----	20	3	3/4" GRC	3 #12 W/#12 GND	208/120	?
10	BELT FILTER PRESS CONTROL PANEL	* 3C	-----	60	3	3/4" GRC	4 #6 W/#10 GND	208/120	10,000

WATTS 26,258

* THESE LOADS ARE REPLACING SIMILAR EXISTING LOADS

POLYMER PROCESS CONTROL PANEL LOADS

NO	LOAD DESCRIPTION	MCC	HP	BKR	POLES	VOLTAGE	LOAD	CONDUIT	WIRE	NOTES
1	TRANSFER PUMP MOTOR	* -----	---	20	3	208/120		3/4" GRC	3 #12 W/ #12 GND	
2	MIXER MOTOR	* -----	---	20	3	208/120		3/4" GRC	3 #12 W/ #12 GND	
3	FEED MOTOR	* -----	---	20	3	208/120		3/4" GRC	3 #12 W/ #12 GND	PER FEED MOTOR (2)
4	TRANSFER VALVE	* -----	---	20	1	120		3/4" GRC	2 #12 W/ #12 GND	

0 WATTS
0 AMPERES

* THESE LOADS ARE REPLACING SIMILAR EXISTING LOADS

FILTER PRESS CONTROL PANEL LOADS

NO	LOAD DESCRIPTION	MCC	HP	BKR	POLES	VOLTAGE	LOAD	CONDUIT	WIRE	NOTES
1	FILTER PRESS MOTOR	* -----	3.00	20	3	208/120	3,958	3/4" GRC	3 #12 W/ #12 GND	CNTRL AND PWR
2	AIR COMPRESSOR	* -----	2.00	20	3	208/120	2,807	3/4" GRC	3 #12 W/ #12 GND	CNTRL AND PWR
3	POLYMER CONTROL PANEL	* -----	---	60	3	208/120	-----	1" GRC	4 #6 W/ #10 GND	CNTRL AND PWR
4	SLUDGE FEED PUMPS	* 1B & 2B	?	-----	3	208/120	-----	EXISTING	EXISTING	CNTRL ONLY, PWR EXISTING
5	PRESS CONVEYOR	* -----	1.50	-----	3	208/120	2,483	3/4" GRC	3 #12 W/ #12 GND	CNTRL AND PWR

9,248 WATTS
26 AMPERES

* THESE LOADS ARE REPLACING SIMILAR EXISTING LOADS


GRW PROJECT NO. 4384
CLIENT PROJECT NO.
ALL RIGHTS RESERVED. NO PART OF THIS DOCUMENT SHALL BE REPRODUCED IN WHOLE OR IN PART WITHOUT THE WRITTEN PERMISSION OF GRW ENGINEERS, INC. AND SHALL NOT BE USED FOR ANY OTHER PROJECT OTHER THAN THIS SPECIFIC PROJECT WITHOUT WRITTEN PERMISSION.
www.grwinc.com

BELT FILTER PRESS REPLACEMENT ELECTRICAL SCHEDULES
TAYLOR MILL TREATMENT PLANT
NORTHERN KENTUCKY WATER DISTRICT

DESIGNED	JKG
DRAWN	JTR
REVIEWED	WLM
APPROVED	WLM

NO.	REVISIONS	DATE	BY
1	ADDENDUM NO. 1 - CHANGE TO GRC	1/18/2017	ACR

THIS RECORD DOCUMENT HAS BEEN PREPARED BASED ON INFORMATION PROVIDED BY THE CONSTRUCTION CONTRACTOR. GRW ENGINEERS, INC. HAS ATTEMPTED TO VERIFY THE ACCURACY AND/OR COMPLETENESS OF THIS INFORMATION BUT SHALL NOT BE RESPONSIBLE FOR ANY ERRORS OR OMISSIONS WHICH MAY BE INCORPORATED HEREIN AS A RESULT.



engineering | architecture | geospatial
www.grwinc.com
ENGINEER/ARCHITECT: David C. Osborne
CONSTRUCTION COMPANY: Dugan & Meyers
DATE: 4/23/19


DATE: APRIL, 2019
SCALE: NOT TO SCALE
SHEET NO. E-602

RECORD DOCUMENTS

PLOTTED BY: mwilliamson

PRINTED: 4/23/2019 @ 2:37PM

FILE NAME: U:\4384-NKVD TMTTP BFP\Working Drawings\AutoCAD\4384 E-701.dwg

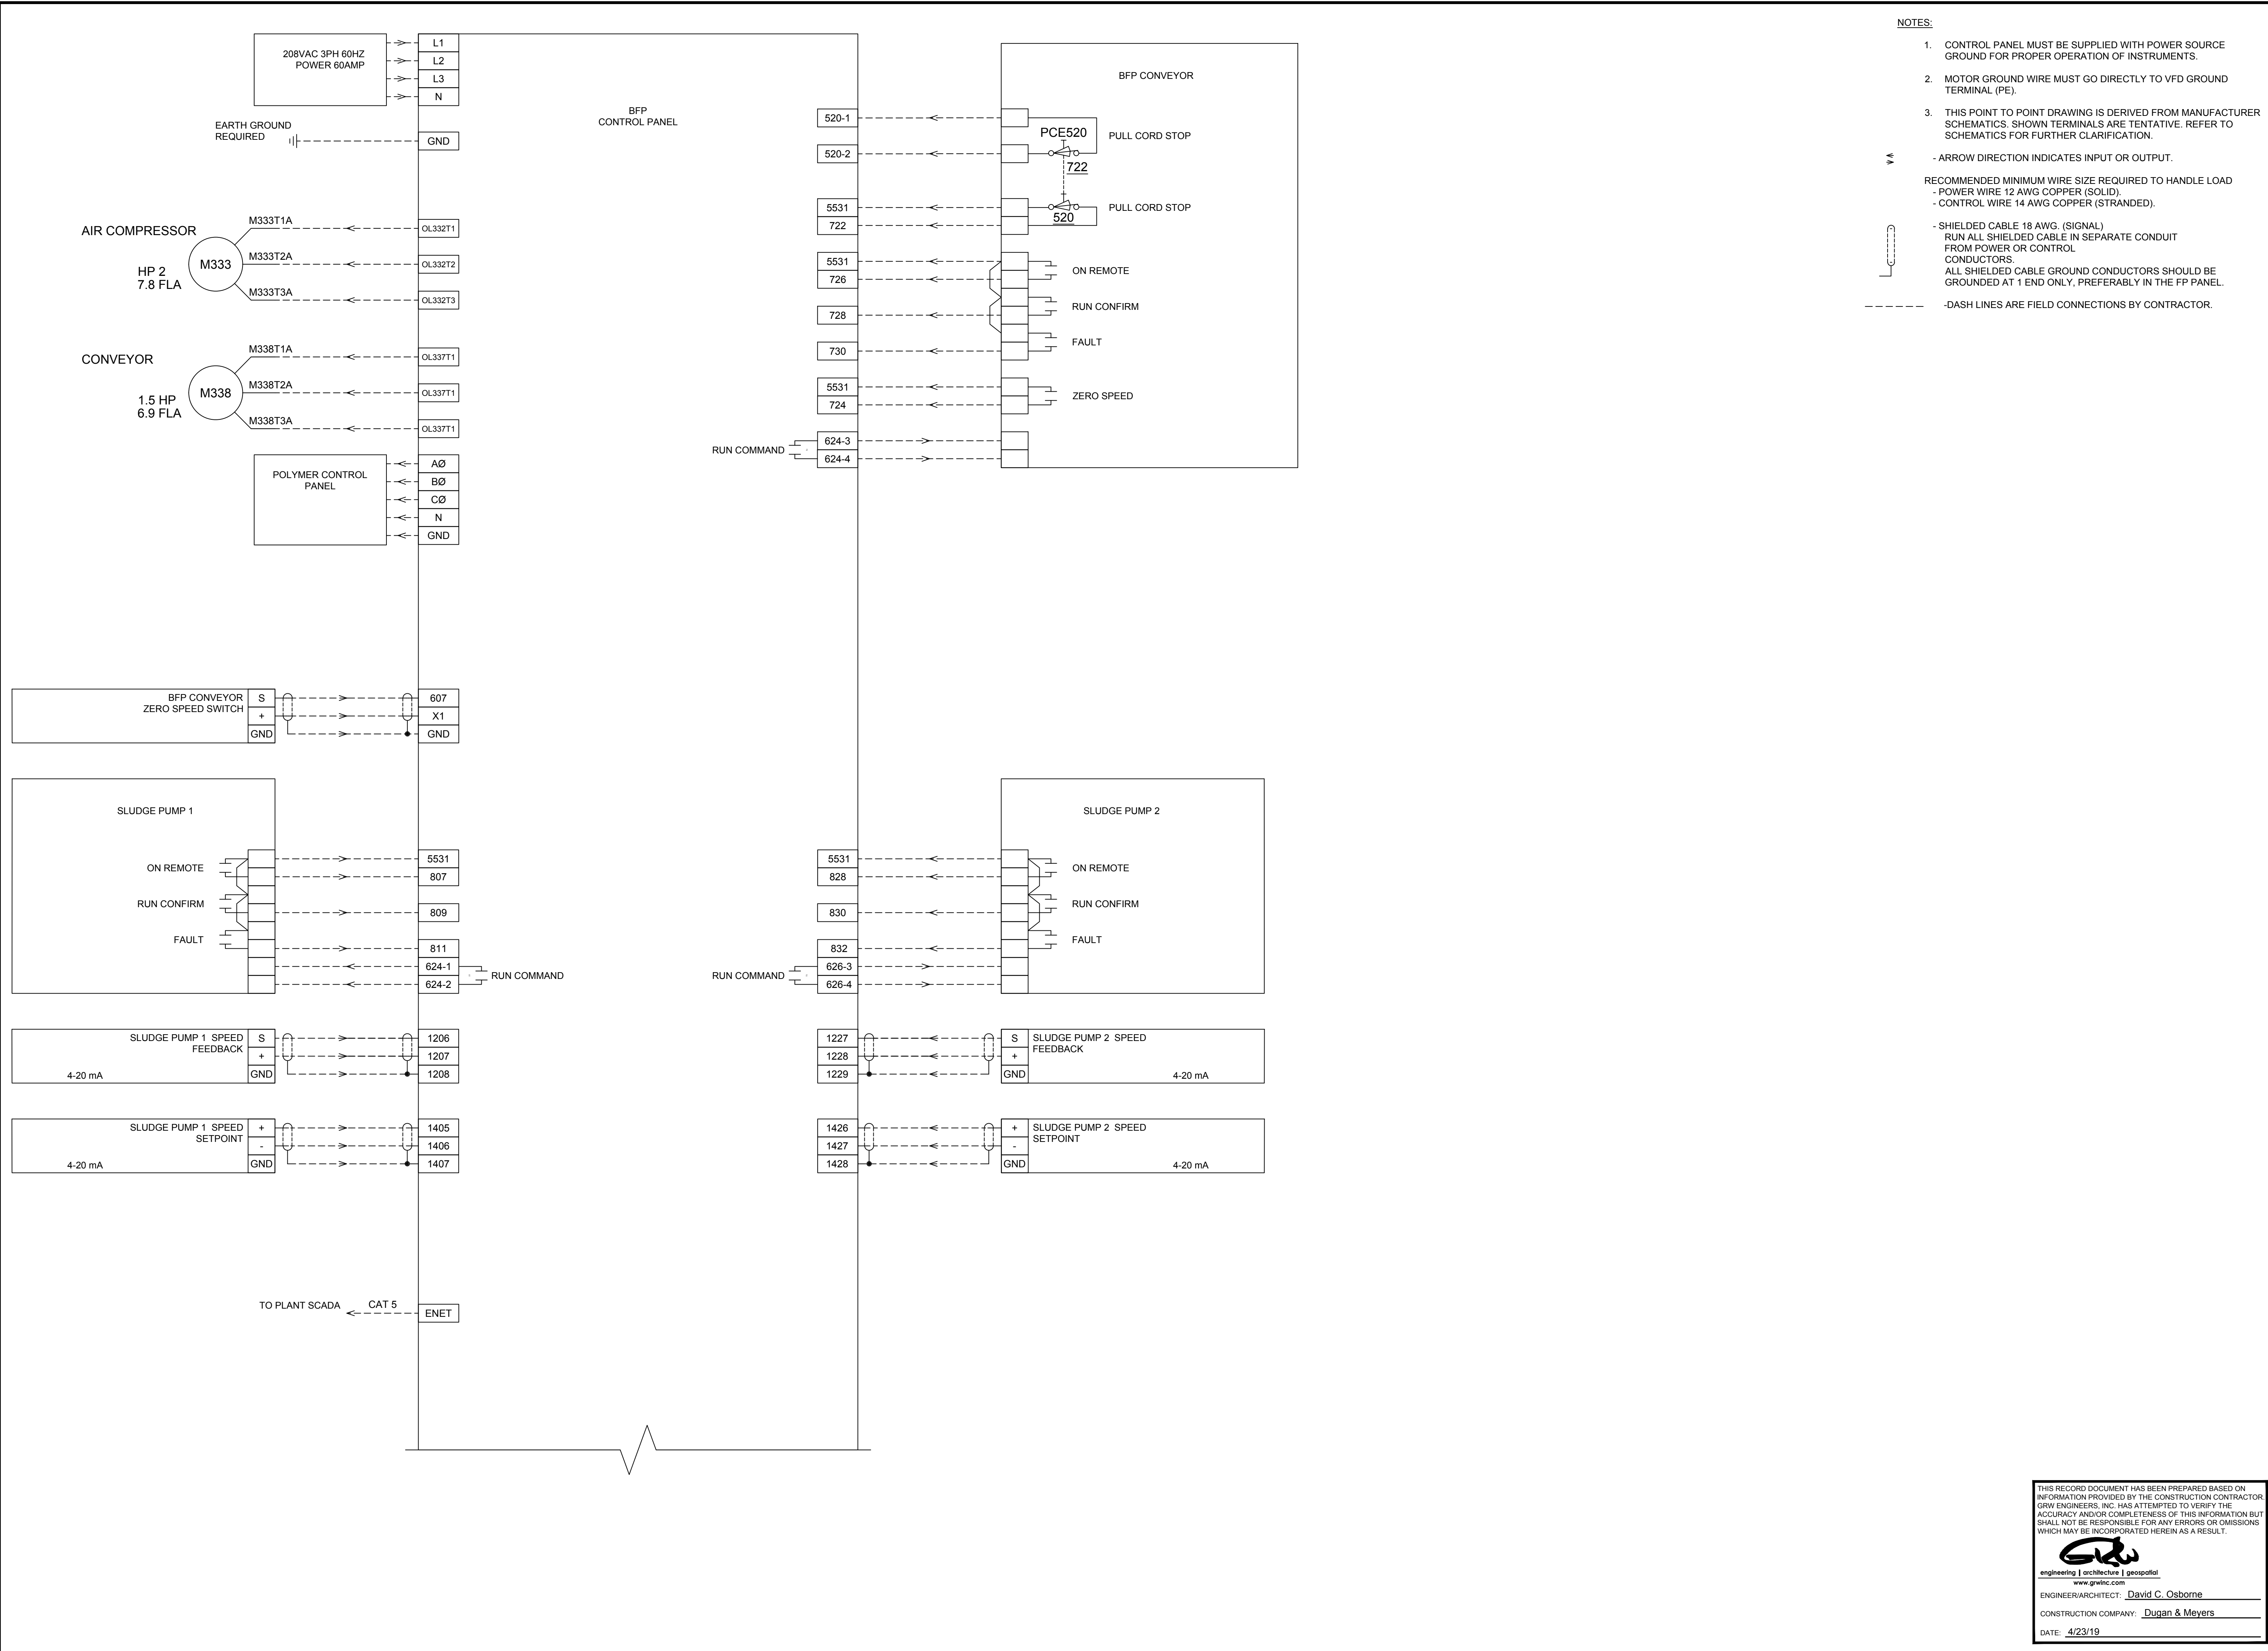

- NOTES:
- CONTROL PANEL MUST BE SUPPLIED WITH POWER SOURCE GROUND FOR PROPER OPERATION OF INSTRUMENTS.
 - MOTOR GROUND WIRE MUST GO DIRECTLY TO VFD GROUND TERMINAL (PE).
 - THIS POINT TO POINT DRAWING IS DERIVED FROM MANUFACTURER SCHEMATICS. SHOWN TERMINALS ARE TENTATIVE. REFER TO SCHEMATICS FOR FURTHER CLARIFICATION.
- RECOMMENDED MINIMUM WIRE SIZE REQUIRED TO HANDLE LOAD
- POWER WIRE 12 AWG COPPER (SOLID).
 - CONTROL WIRE 14 AWG COPPER (STRANDED).
 - SHIELDED CABLE 18 AWG (SIGNAL)
 - RUN ALL SHIELDED CABLE IN SEPARATE CONDUIT FROM POWER OR CONTROL CONDUCTORS.
 - ALL SHIELDED CABLE GROUND CONDUCTORS SHOULD BE GROUNDED AT 1 END ONLY, PREFERABLY IN THE FP PANEL.
- DASH LINES ARE FIELD CONNECTIONS BY CONTRACTOR.

GRW PROJECT NO. 4384

CLIENT PROJECT NO.

engineering | architecture | geospatial

www.grwinc.com

**BELT FILTER PRESS REPLACEMENT
POINT TO POINT**

TAYLOR MILL TREATMENT PLANT
NORTHERN KENTUCKY WATER DISTRICT

DESIGNED	BY	DATE	DESCRIPTION
JKG	ACR	1/18/2017	ADDENDUM NO. 1 - SLUDGE FLOW REMOVED

REVIEWED	DATE	DESCRIPTION
STAFF		
WLM		
WLM		

NO.	REVISIONS	DATE	DESCRIPTION
1	ADDENDUM NO. 1 - SLUDGE FLOW REMOVED	1/18/2017	

DATE: APRIL, 2019

SCALE: NOT TO SCALE

SHEET NO. E-701

THIS RECORD DOCUMENT HAS BEEN PREPARED BASED ON INFORMATION PROVIDED BY THE CONSTRUCTION CONTRACTOR. GRW ENGINEERS, INC. HAS ATTEMPTED TO VERIFY THE ACCURACY AND/OR COMPLETENESS OF THIS INFORMATION BUT SHALL NOT BE RESPONSIBLE FOR ANY ERRORS OR OMISSIONS WHICH MAY BE INCORPORATED HEREIN AS A RESULT.

engineering | architecture | geospatial

www.grwinc.com

ENGINEER/ARCHITECT: David C. Osborne

CONSTRUCTION COMPANY: Dugan & Meyers


DATE: 4/23/19

RECORD DOCUMENTS

PLOTTED BY: mwilliamson

PRINTED: 4/23/2019 @ 2:37PM

FILE NAME: U:\4384-NKWD TMTTP BFP\Working Drawings\AutoCAD\4384 E-702.dwg

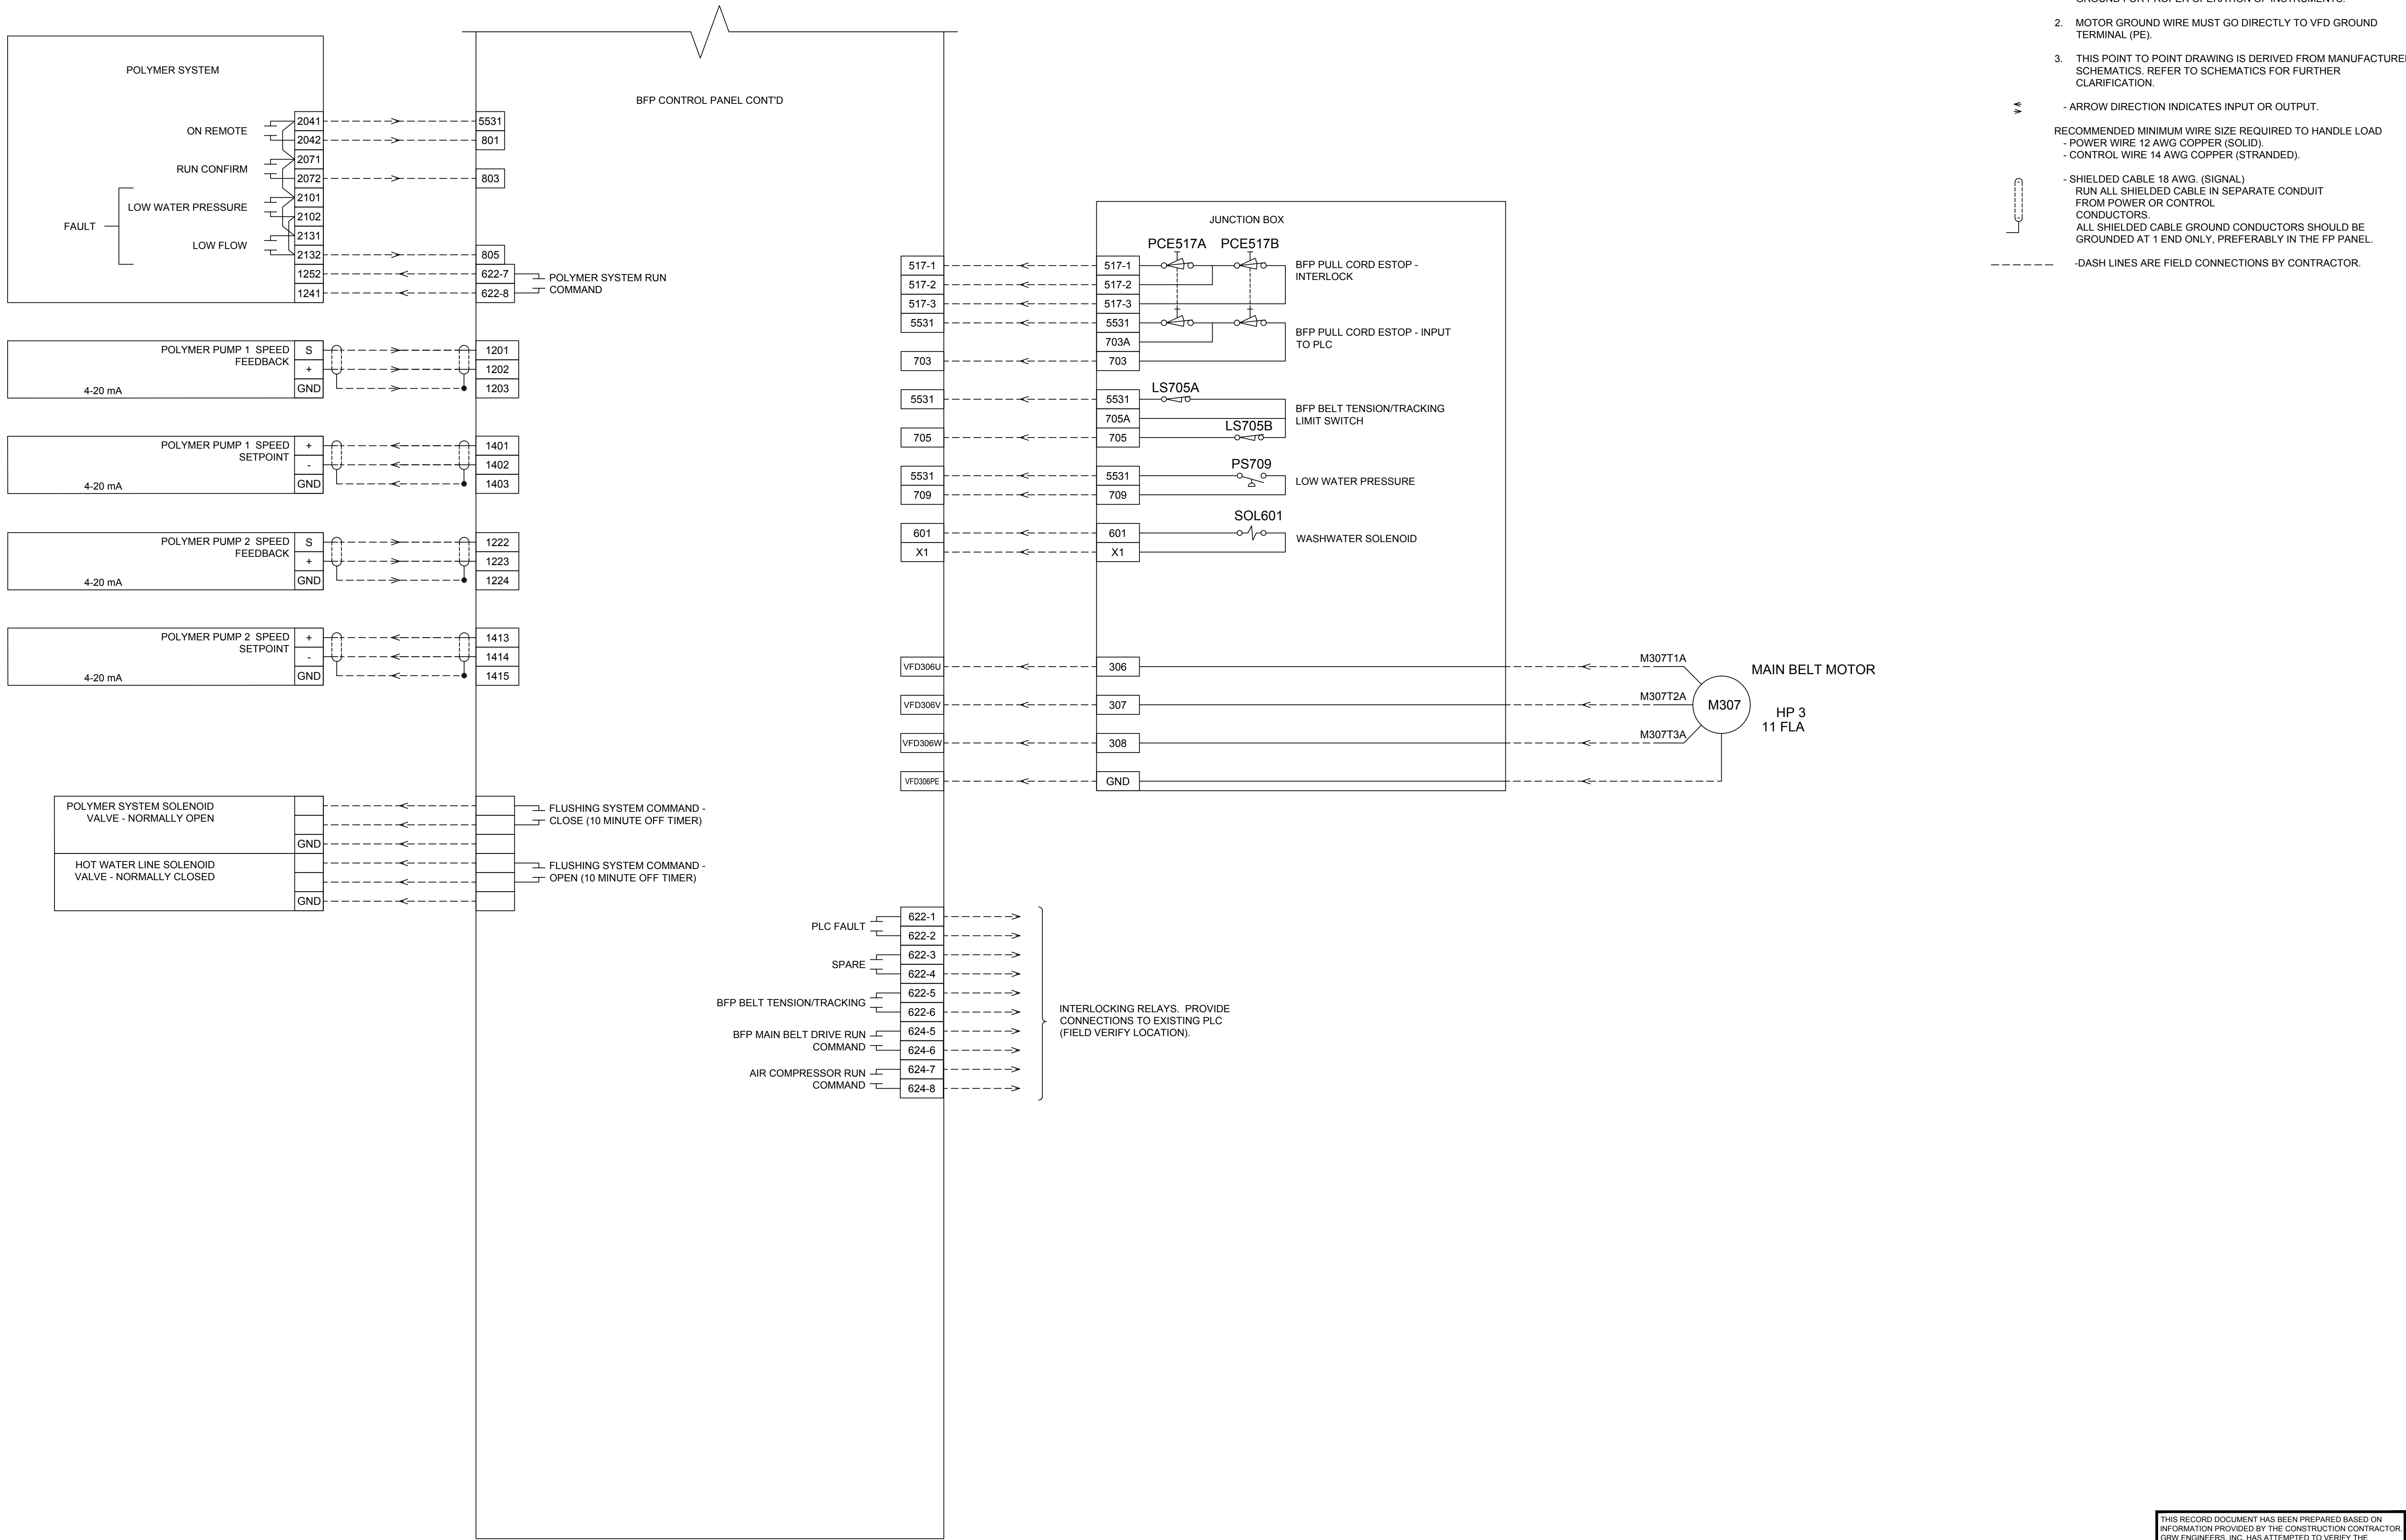

- NOTES:**
- CONTROL PANEL MUST BE SUPPLIED WITH POWER SOURCE GROUND FOR PROPER OPERATION OF INSTRUMENTS.
 - MOTOR GROUND WIRE MUST GO DIRECTLY TO VFD GROUND TERMINAL (PE).
 - THIS POINT TO POINT DRAWING IS DERIVED FROM MANUFACTURER SCHEMATICS. REFER TO SCHEMATICS FOR FURTHER CLARIFICATION.
- ARROW DIRECTION INDICATES INPUT OR OUTPUT.
- RECOMMENDED MINIMUM WIRE SIZE REQUIRED TO HANDLE LOAD
- POWER WIRE 12 AWG COPPER (SOLID).
 - CONTROL WIRE 14 AWG COPPER (STRANDED).
- SHIELDED CABLE 18 AWG. (SIGNAL)
RUN ALL SHIELDED CABLE IN SEPARATE CONDUIT FROM POWER OR CONTROL CONDUCTORS.
ALL SHIELDED CABLE GROUND CONDUCTORS SHOULD BE GROUNDED AT 1 END ONLY, PREFERABLY IN THE FP PANEL.
- DASH LINES ARE FIELD CONNECTIONS BY CONTRACTOR.

GRW PROJECT NO. 4384

CLIENT PROJECT NO.

ALL RIGHTS RESERVED. THE ACCURACY AND COMPLETENESS OF THIS INFORMATION SHALL NOT BE GUARANTEED IN WHOLE OR IN PART BY GRW ENGINEERS, INC. AND SHALL NOT BE USED FOR ANY OTHER PROJECTS WITHOUT WRITTEN PERMISSION.

GRW
engineering | architecture | geospatial
www.grwinc.com

**BELT FILTER PRESS REPLACEMENT
POINT TO POINT**

TAYLOR MILL TREATMENT PLANT
NORTHERN KENTUCKY WATER DISTRICT

DESIGNED	JKG	STAFF	REVIEWED	WLM	APPROVED	WLM
DATE						
NO.						
DESCRIPTION						
SCALE CHECK: THIS MARK SHOULD MEASURE EXACTLY 1" WHEN PLOTTED						

THIS RECORD DOCUMENT HAS BEEN PREPARED BASED ON INFORMATION PROVIDED BY THE CONSTRUCTION CONTRACTOR. GRW ENGINEERS, INC. HAS ATTEMPTED TO VERIFY THE ACCURACY AND/OR COMPLETENESS OF THIS INFORMATION BUT SHALL NOT BE RESPONSIBLE FOR ANY ERRORS OR OMISSIONS WHICH MAY BE INCORPORATED HEREIN AS A RESULT.

GRW
engineering | architecture | geospatial
www.grwinc.com

ENGINEER/ARCHITECT: David C. Osborne
CONSTRUCTION COMPANY: Dugan & Meyers
DATE: 4/23/19

DATE: APRIL, 2019

SCALE: NOT TO SCALE

SHEET NO. **E-702**

RECORD DOCUMENTS