


# NOLIN RIVER WATERSHED SEWER INFRASTRUCTURE

## FOR THE HARDIN COUNTY WATER DISTRICT NO. 2 HARDIN COUNTY, KENTUCKY AUGUST 2017

### LIST OF DRAWINGS

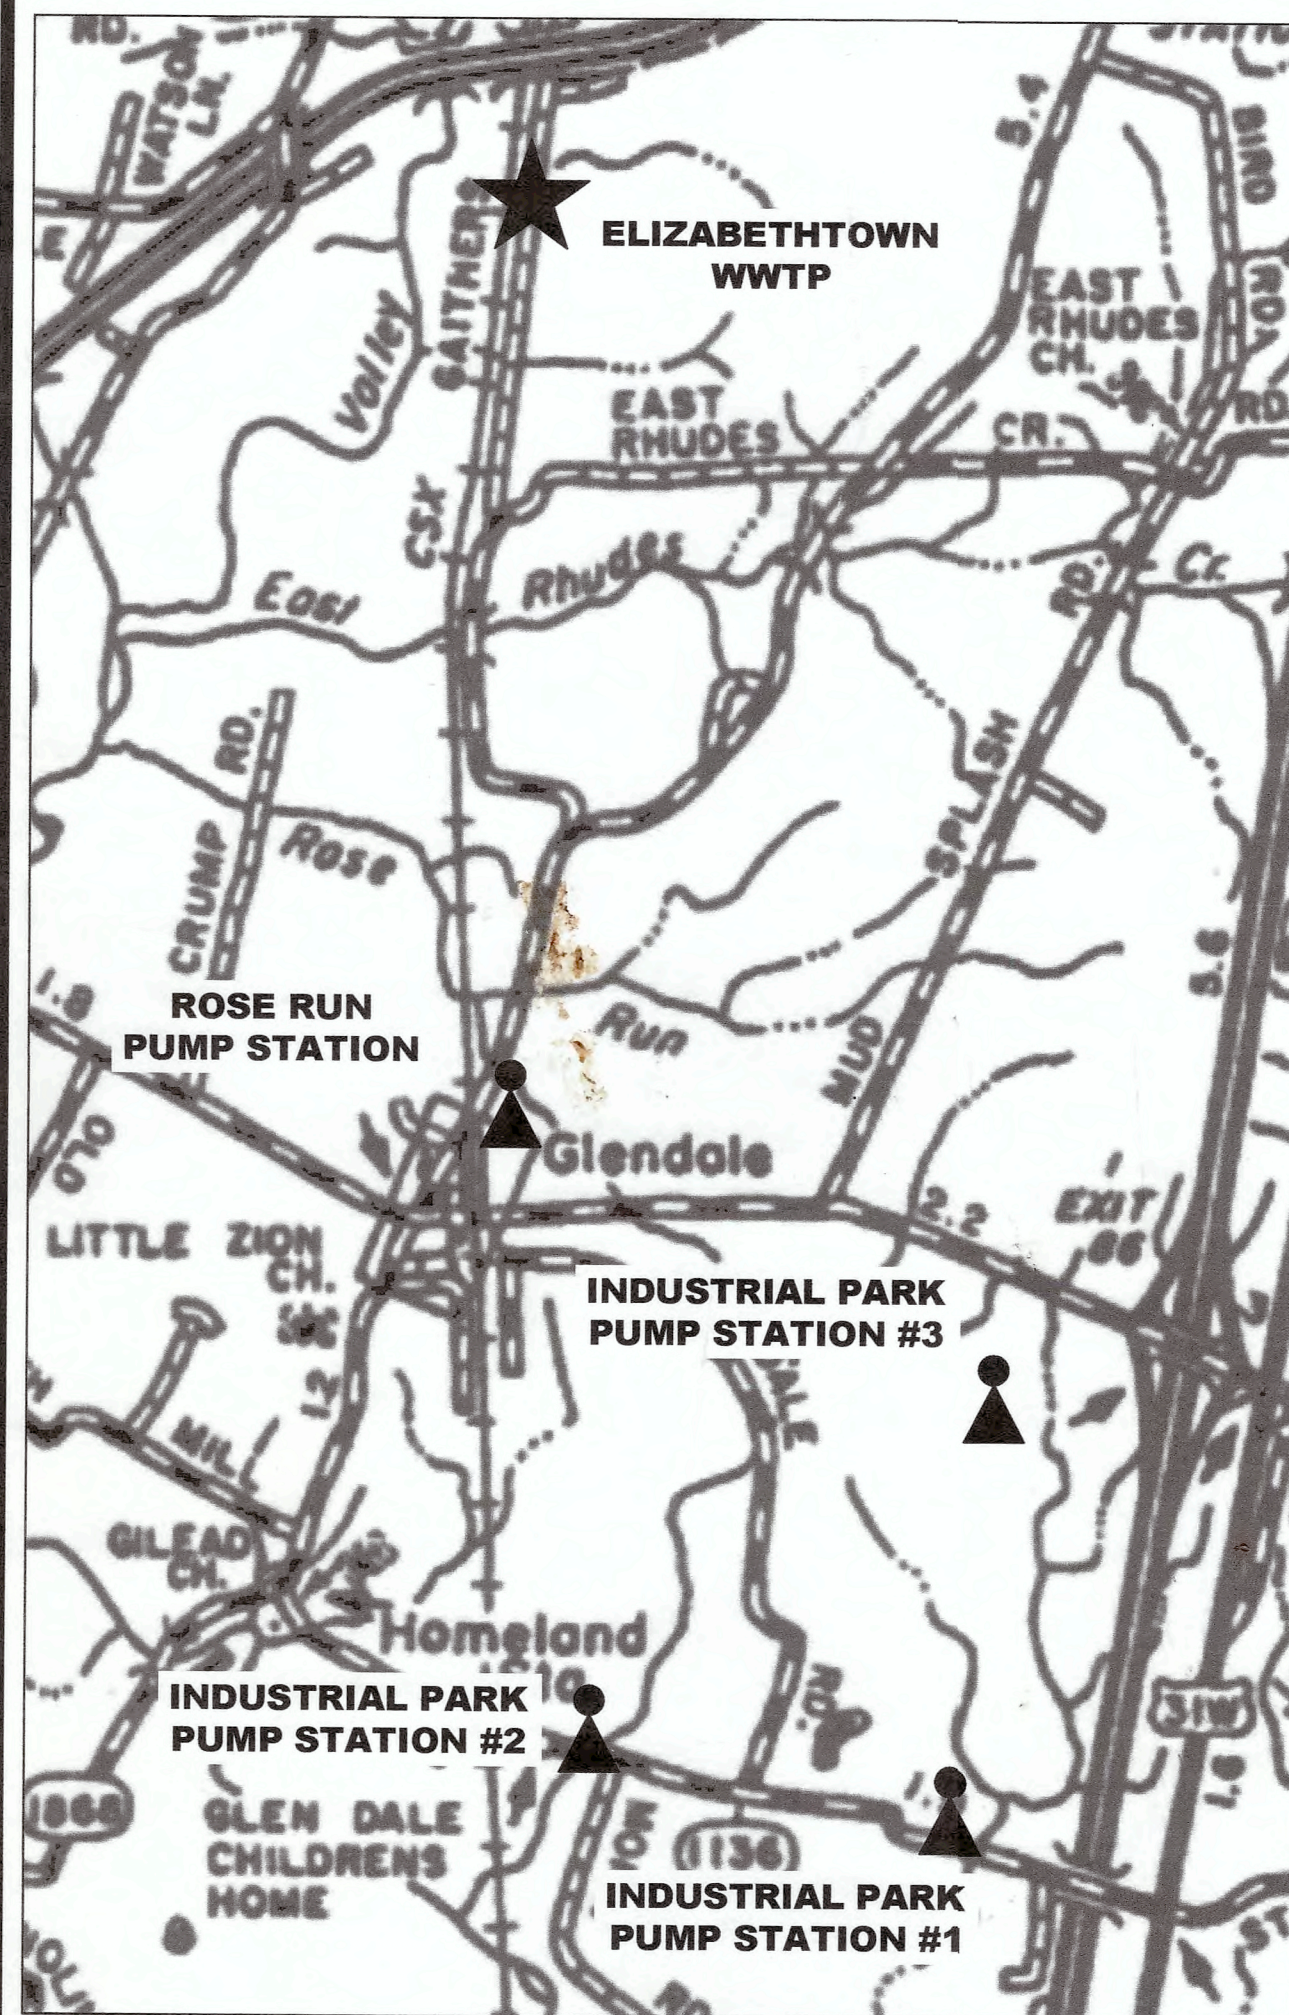

LOCATION MAP  
NTS

325 WEST MAIN STREET, SUITE 710  
LOUISVILLE, KY 40202  
502-583-7020  
502-583-7026 FAX  
WWW.STRAND.COM

CONTRACTS 1-2017, 2-2017, 3-2017, AND 4-2017

ISSUED FOR BID

GLENDALE C-4 AS-BUILTS

SHEET NO.	TITLE	CONTRACT
		1 2 3 4
<b>GENERAL</b>		
01	TITLE SHEET, LOCATION MAP, AND LIST OF DRAWINGS	• • • •
02	USGS TOPOGRAHIC MAP	• • • •
03	FORCE MAIN PLAN AND PROFILE INDEX SHEET	• • • •
03A	GRAVITY SEWER PLAN AND PROFILE INDEX SHEET	• • • •
04	DESIGN CRITERIA, GENERAL NOTES, LEGEND, AND ABBREVIATIONS	• • • •
<b>INDUSTRIAL PARK PUMP STATION NO. 1</b>		
05	PHOTOGRAPHIC SITE PLAN	•
06	PLANIMETRIC SITE PLAN	•
07	PLANS AND SECTIONS	•
08	ELECTRICAL SITE PLAN	•
09	ELECTRICAL AND HVAC CONTROL BUILDING PLANS	•
10	CONTROL BUILDING DETAILS	•
<b>INDUSTRIAL PARK PUMP STATION NO. 2</b>		
11	PHOTOGRAPHIC SITE PLAN	•
12	PLANIMETRIC SITE PLAN	•
13	PLANS AND SECTIONS	•
14	ELECTRICAL SITE PLAN	•
15	ELECTRICAL AND HVAC CONTROL BUILDING PLANS	•
16	CONTROL BUILDING DETAILS	•
<b>ROSE RUN PUMP STATION</b>		
17	PHOTOGRAPHIC SITE PLAN	•
18	PLANIMETRIC SITE PLAN	•
19	PLANS AND SECTIONS	•
20	ELECTRICAL SITE PLAN	•
21	ELECTRICAL AND HVAC CONTROL BUILDING PLANS	•
22	CONTROL BUILDING DETAILS	•
<b>INDUSTRIAL PARK PUMP STATION NO. 3</b>		
23	PHOTOGRAPHIC SITE PLAN	•
24	PLANIMETRIC SITE PLAN	•
25	PLANS AND SECTIONS	•
26	ELECTRICAL SITE PLAN	•
27	ELECTRICAL AND HVAC CONTROL BUILDING PLANS	•
28	CONTROL BUILDING DETAILS	•

SHEET NO.	TITLE	CONTRACT
		1 2 3 4
<b>INDUSTRIAL PARK PUMP STATION NO. 1 FORCE MAIN</b>		
29	STA. 10+00 TO STA. 23+00	•
30	STA. 23+00 TO STA. 36+00	•
31	STA. 36+00 TO STA. 49+00	•
32	STA. 49+00 TO STA. 62+00	•
33	STA. 62+00 TO STA. 75+00	•
34	STA. 75+00 TO STA. 81+17	•
<b>INDUSTRIAL PARK PUMP STATION NO. 1 AND NO. 2 FORCE MAINS</b>		
35	STA. 81+17 TO STA. 94+50	•
36	STA. 94+50 TO STA. 107+50	•
37	STA. 107+50 TO STA. 120+50	•
38	STA. 120+50 TO STA. 133+50	•
39	STA. 133+50 TO STA. 146+50	•
40	STA. 146+50 TO STA. 159+50	•
41	INDUSTRIAL PARK NO. 1 STA. 157+00 TO STA. 165+82.00	•
<b>INDUSTRIAL PARK PUMP STATION NO. 2 FORCE MAIN</b>		
42	STA. 159+50 TO STA. 172+50	•
43	STA. 172+50 TO STA. 185+50	•
44	STA. 185+50 TO STA. 198+50	•
45	STA. 198+50 TO STA. 211+50	•
<b>INDUSTRIAL PARK NO. 2 AND ROSE RUN PUMP STATIONS FORCE MAINS</b>		
46	STA. 211+50 TO STA. 224+50	•
47	STA. 224+50 TO STA. 237+50	•
48	STA. 237+50 TO STA. 250+50	•
49	STA. 250+50 TO STA. 263+50	•
50	STA. 263+50 TO STA. 276+50	•
51	STA. 276+50 TO STA. 289+50	•
52	STA. 289+50 TO STA. 302+50	•
53	STA. 302+50 TO STA. 315+50	•
54	STA. 315+50 TO STA. 328+50	•
55	STA. 328+50 TO STA. 341+50	•
56	STA. 341+50 TO STA. 354+50	•
57	STA. 354+50 TO STA. 367+50	•
58	STA. 367+50 TO STA. 380+50	•
59	FLOOD WALL SECTIONS	•
60	STA. 380+50 TO STA. 384+40	•
<b>INDUSTRIAL PARK PUMP STATION NO. 3 FORCE MAIN</b>		
61	STA. 10+00 TO STA. 23+50	•
62	STA. 23+50 TO STA. 37+00	•
63	STA. 37+00 TO STA. 50+50	•
64	STA. 50+50 TO STA. 64+00	•
65	STA. 64+00 TO STA. 77+50	•
66	STA. 77+50 TO STA. 86+11	•


SHEET NO.	TITLE	CONTRACT
		1 2 3 4
<b>GRAVITY SEWER PLAN AND PROFILE</b>		
67	LINE A STA. 10+00 TO STA. 23+50	•
68	LINE A STA. 23+50 TO STA. 25+82	•
69	LINE B STA. 10+00 TO STA. 11+80.52	•
70	LINE C STA. 10+00 TO STA. 12+31.43	•
71	LINE D STA. 10+00 TO STA. 29+90.00	•
71A	LINE F STA. 10+00 TO STA. 15+10.00	•
72	LINE H STA. 10+00 TO STA. 23+00	•
73	LINE H STA. 23+00 TO STA. 34+31.20	•
74	LINE I STA. 10+00 TO STA. 14+27.41	•
75	LINE J STA. 10+00 TO STA. 16+49	•
76	LINE K STA. 10+00 TO STA. 24+28	•
77	LINE L STA. 10+00 TO STA. 13+84.84	•
78	LINE M STA. 10+00 TO STA. 21+50	•
79	LINE M STA. 21+50 TO STA. 33+00	•
80	LINE M STA. 33+00 TO STA. 42+19.16	•
81	LINE N STA. 10+00 TO STA. 19+59	•
82	LINE O STA. 10+00 TO STA. 16+75	•
83	LINE P STA. 10+00 TO STA. 18+15	•
84	LINE Q STA. 10+00 TO STA. 11+96	•
85	LINE R STA. 10+00 TO STA. 23+50	•
86	LINE R STA. 23+50 TO STA. 37+00	•
87	LINE R STA. 37+00 TO STA. 50+50	•
88	LINE R STA. 50+50+ TO STA. 64+00	•
89	LINE R STA. 64+00 TO STA. 77+50	•
90	LINE R STA. 77+50 TO STA. 91+00	•
91	LINE R STA. 91+00 TO STA. 104+50	•
92	LINE R STA. 104+50 TO STA. 114+71.09	•
93	LINE R1 STA. 10+00 TO STA. 24+16.15	•
94	LINE T STA. 10+00 TO STA. 23+50	•
95	LINE T STA. 23+50 TO STA. 28+60.61	•
96	LINE T1 STA. 10+00 TO STA. 16+14.73	•
97	LINE U STA. 10+00 TO STA. 23+50	•
98	LINE U STA. 23+50 TO STA. 37+00	•
99	LINE U STA. 37+00 TO STA. 50+50	•
100	LINE U STA. 50+50 TO STA. 53+00	•
<b>DETAILS</b>		
101	STANDARD DETAILS	•
102	STRUCTURAL DETAILS - 1	•
103	STRUCTURAL DETAILS - 2	•
104	STRUCTURAL DETAILS - 3	•
105	ARCHITECTURAL AND STRUCTURAL SCHEDULES	•
106	INDUSTRIAL PARK PUMP STATION NO. 1 - ELECTRICAL AND HVAC CONTROL BUILDING SCHEDULE	•
107	ELECTRICAL DETAILS	•
108	INDUSTRIAL PARK PUMP STATION NO. 1 - ELECTRICAL SCHEDULES, ELEVATION, AND ONE-LINE DIAGRAM	•
109	INDUSTRIAL PARK PUMP STATION NO. 2 - ELECTRICAL SCHEDULE AND ONE-LINE DIAGRAM	•
110	ROSE RUN PUMP STATION - ELECTRICAL SCHEDULES, ELEVATION, AND ONE-LINE DIAGRAM	•
111	INDUSTRIAL PARK PUMP STATION NO. 3 - ELECTRICAL SCHEDULES, ELEVATIONS, AND ONE-LINE DIAGRAM	•
112	CROSS SECTION DETAILS	•



**SA**  
STRAND  
ASSOCIATES®

SHEET  
01



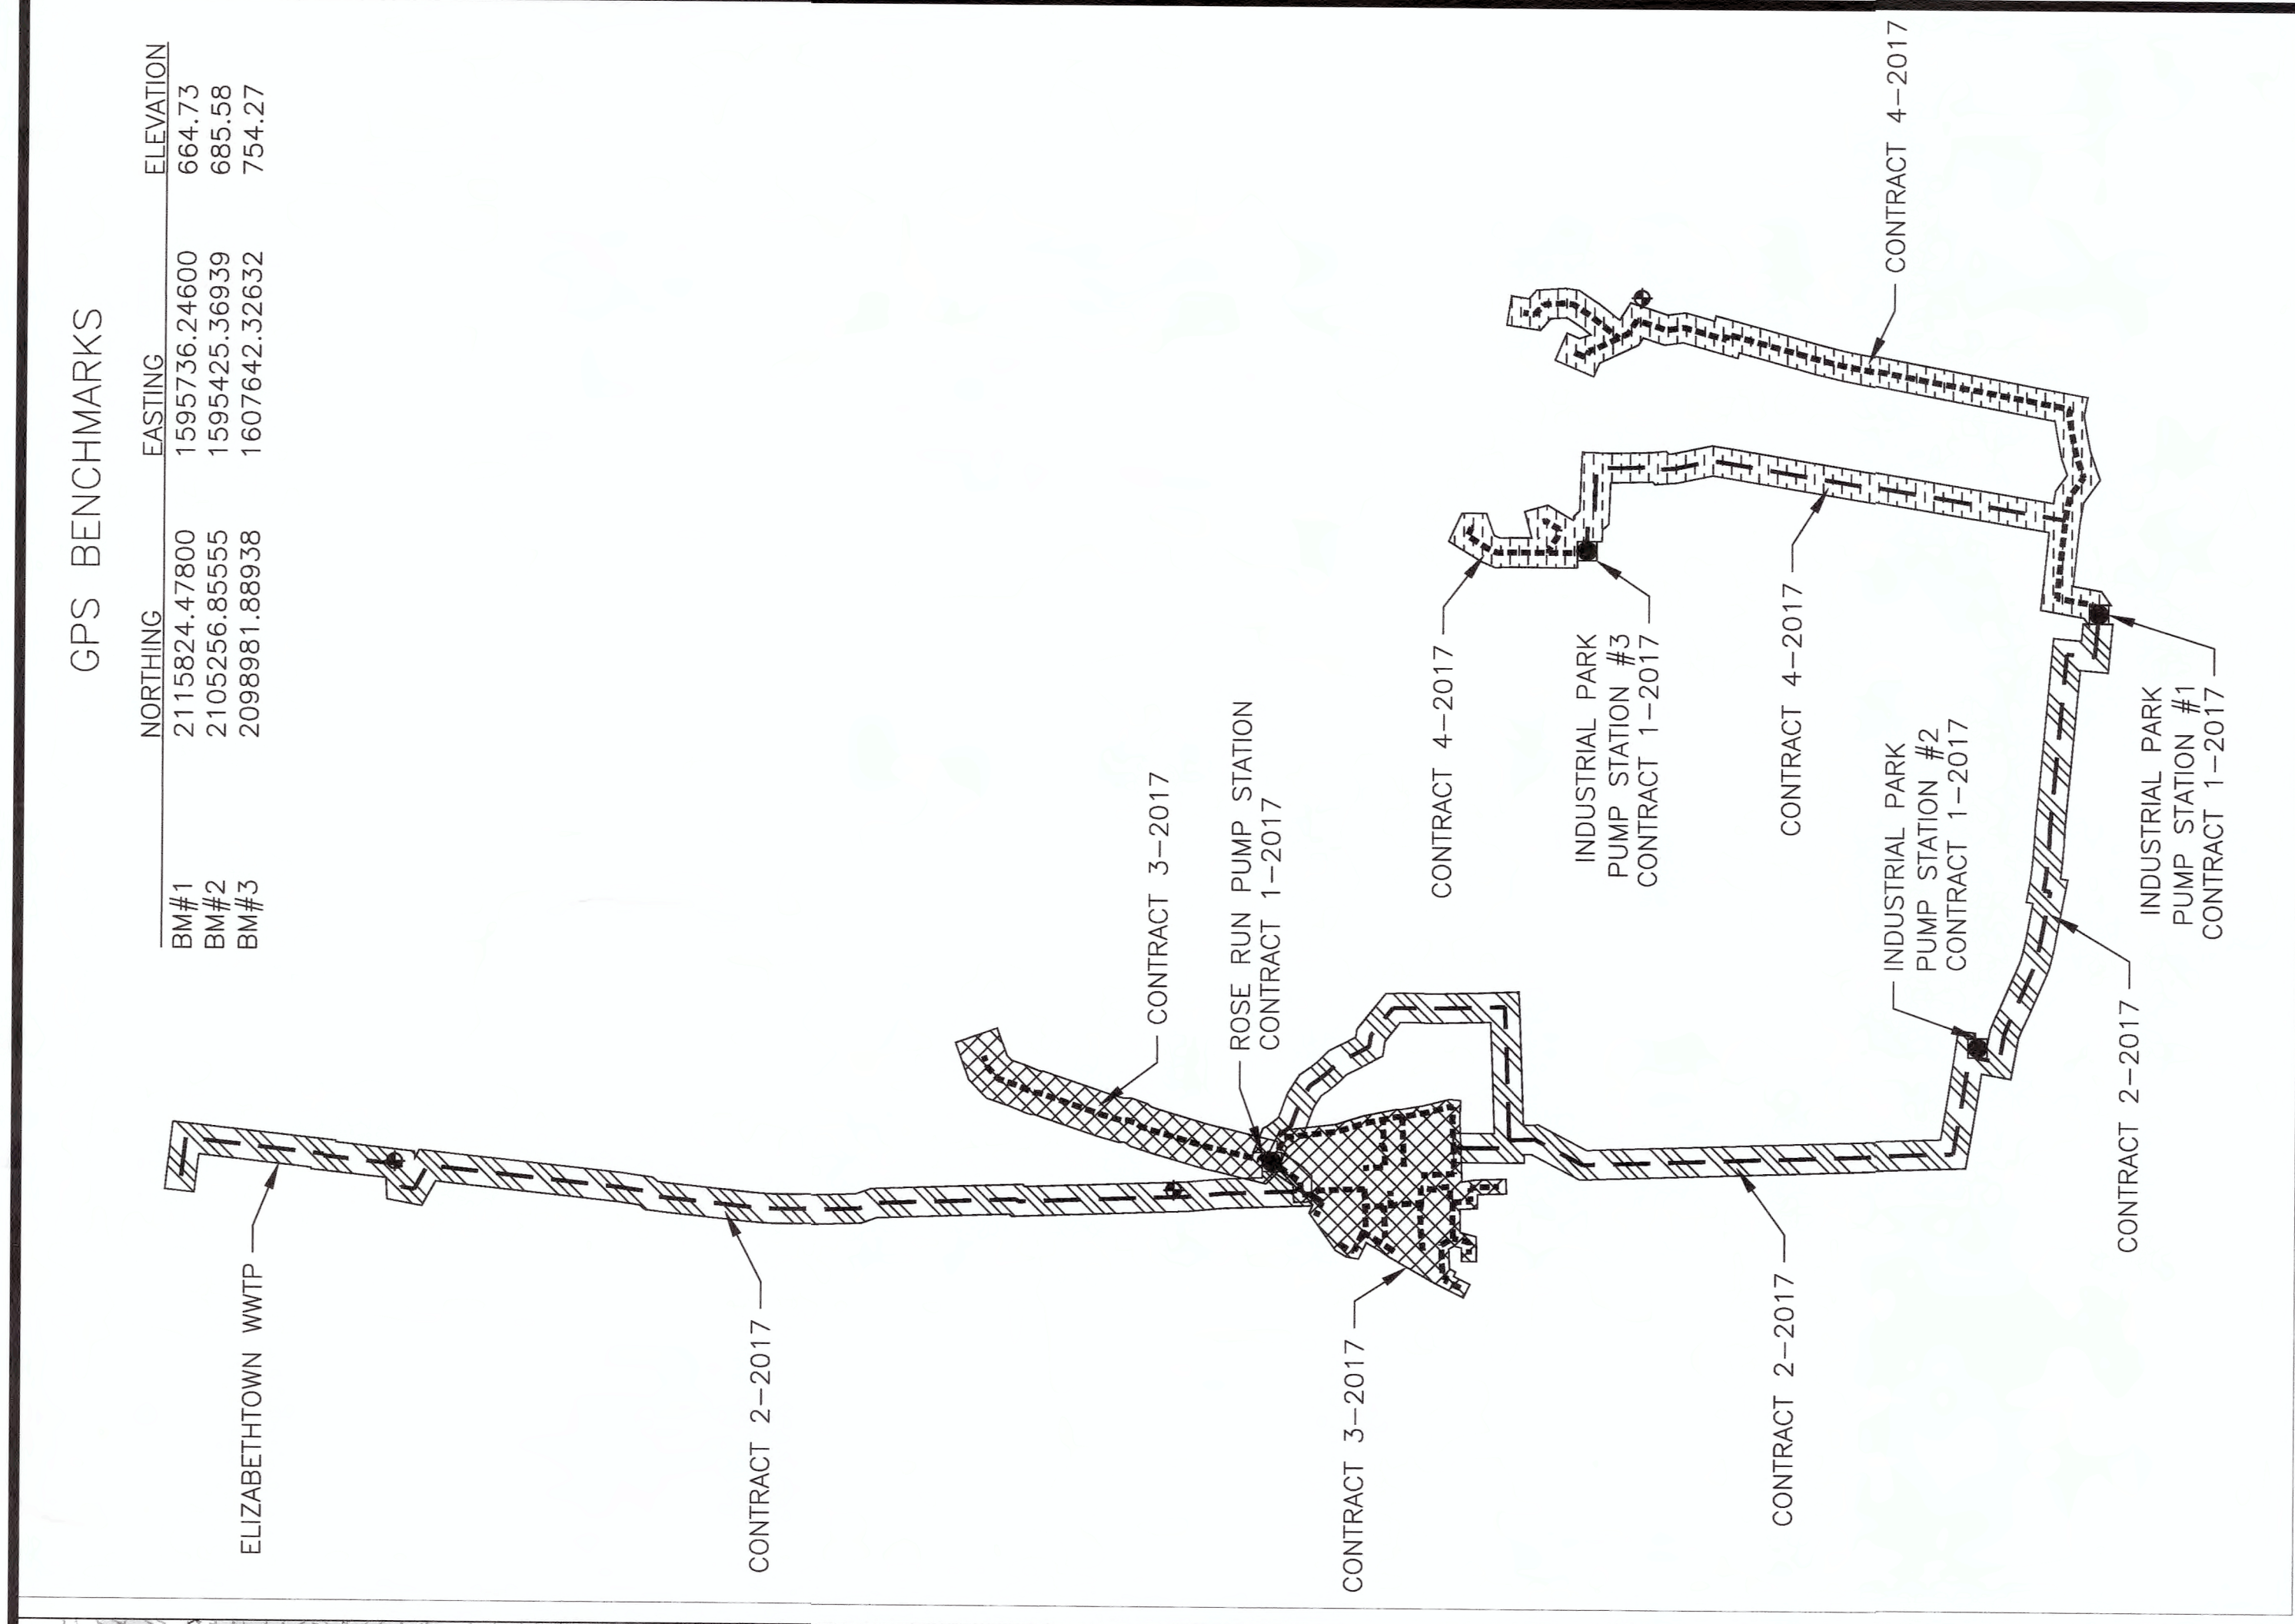

BM#	NORTHING	EASTING	ELEVATION
BM#1	2115824.47800	1595736.24600	664.73
BM#2	2105256.85555	1595425.36939	685.58
BM#3	2098981.88938	1607642.32632	754.27



STATE OF KENTUCKY  
 MARK A. SNEVE  
 18511  
 8/15/17

NO.	REVISIONS	DATE:

**USGS TOPOGRAFIC MAP**  
**GRAVITY SEWER AND FORCE MAIN ROUTES**  
**CONTRACTS 1-2017, 2-2017, 3-2017, AND 4-2017**  
 NOLIN RIVER WATERSHED SEWER INFRASTRUCTURE  
 HARDIN COUNTY WATER DISTRICT NO. 2  
 HARDIN COUNTY, KENTUCKY

JOB NO.  
 5980.020  
 PROJECT MGR.  
 MAS



SHEET  
 02











**DESIGN CRITERIA:**

**ROSE RUN PUMP STATION DESIGN DATA**

AVG. DAILY SEWAGE FLOW: PEOPLE @ 100 G.P.C.D.	=	207,360 G.P.D.
AVG. FLOW: G.P.D./1,440	=	144 G.P.M.
PUMPING RATE PER PUMP: F.P.S. X S.F. X 448.8 G.P.M./C.F.S. (BASED ON FORCE MAIN SCOUR VELOCITY)	=	360 G.P.M.
STORAGE CAPACITY: MIN. X G.P.M.	=	10,800 GALLONS
STATIC HEAD	=	35.4 FEET
FORCE MAIN SIZE: 8"; MATERIAL: PVC (C=120)	=	36 FEET
DYNAMIC HEADLOSS	=	72 FEET
TOTAL DYNAMIC HEAD (T.D.H.)	=	
WETWELL DIAMETER: 8"; LEAVE SPACE FOR FUTURE SECOND WETWELL	=	

**ROSE RUN PUMP STATION EQUIPMENT DATA**

- TWO (2) 20 HP (MIN.) PUMPS
- CAPACITY (OPERATING POINT): 423 G.P.M. @ 85 T.D.H.
- PUMP TYPE & MANUFACTURER: FLYGT NP 3153 MT IMPELLER NO. 263
- DISCHARGE SIZE: 6"
- PUMP CONTROL: AUTOMATIC
- SOLIDS PASSING SIZE: N/A FOR N-SERIES PUMPS
- FORCE MAIN PRESSURE RATING & TYPE: PRESSURE CLASS 300, PVC
- CYCLE TIME: 12 MIN.
- ODOR CONTROL: BIOXIDE
- Volt: 460 AMP: 26

**INDUSTRIAL PARK PUMP STATION NO. 1 DESIGN DATA**

AVG. DAILY SEWAGE FLOW: PEOPLE @ 100 G.P.C.D.	=	132,000 G.P.D.
AVG. FLOW: G.P.D./1,440	=	92 G.P.M.
PUMPING RATE PER PUMP: F.P.S. X S.F. X 448.8 G.P.M./C.F.S. (BASED ON FORCE MAIN SCOUR VELOCITY)	=	230 G.P.M.
STORAGE CAPACITY: MIN. X G.P.M.	=	13,800 GALLONS
STATIC HEAD	=	46.5 FEET
FORCE MAIN SIZE: 6"; MATERIAL: PVC (C=120)	=	89 FEET
DYNAMIC HEADLOSS	=	136 FEET
TOTAL DYNAMIC HEAD (T.D.H.)	=	
WETWELL DIAMETER: 10' EACH; DUAL WETWELLS NEEDED	=	

**INDUSTRIAL PARK PUMP STATION NO. 1 EQUIPMENT DATA**

- TWO (2) 23 HP (MIN.) PUMPS
- CAPACITY (OPERATING POINT): 232 G.P.M. @ 138 T.D.H.
- PUMP TYPE & MANUFACTURER: FLYGT NP 3153 SH IMPELLER NO. 167
- DISCHARGE SIZE: 4"
- PUMP CONTROL: AUTOMATIC
- SOLIDS PASSING SIZE: N/A FOR N-SERIES PUMPS
- FORCE MAIN PRESSURE RATING & TYPE: PRESSURE CLASS 300, PVC
- CYCLE TIME: 12 MIN.
- ODOR CONTROL: BIOXIDE
- Volt: 460 AMP: 26

**INDUSTRIAL PARK PUMP STATION NO. 2 DESIGN DATA**

*NOTE- THIS PUMP STATION WILL HAVE NO EQUIPMENT INSTALLED INITIALLY	=	N/A G.P.D.
AVG. DAILY SEWAGE FLOW: PEOPLE @ 100 G.P.C.D.	=	N/A G.P.M.
AVG. FLOW: G.P.D./1,440	=	N/A G.P.M.
PUMPING RATE PER PUMP: F.P.S. X S.F. X 448.8 G.P.M./C.F.S. (BASED ON FORCE MAIN SCOUR VELOCITY)	=	N/A G.P.M.
STORAGE CAPACITY: MIN. X G.P.M.	=	N/A GALLONS
STATIC HEAD	=	N/A FEET
FORCE MAIN SIZE: 16"; MATERIAL: PVC (C=120)	=	N/A FEET
DYNAMIC HEADLOSS	=	N/A FEET
TOTAL DYNAMIC HEAD (T.D.H.)	=	N/A FEET
WETWELL DIAMETER: 10' EACH; DUAL WETWELLS NEEDED	=	

**INDUSTRIAL PARK PUMP STATION NO. 3 DESIGN DATA**

AVG. DAILY SEWAGE FLOW: PEOPLE @ 100 G.P.C.D.	=	46,080 G.P.D.
AVG. FLOW: G.P.D./1,440	=	32 G.P.M.
PUMPING RATE PER PUMP: F.P.S. X S.F. X 448.8 G.P.M./C.F.S. (BASED ON FORCE MAIN SCOUR VELOCITY)	=	80 G.P.M.
STORAGE CAPACITY: MIN. X G.P.M.	=	4,800 GALLONS
STATIC HEAD	=	37.2 FEET
FORCE MAIN SIZE: 4"; MATERIAL: PVC (C=120)	=	6 FEET
DYNAMIC HEADLOSS	=	43 FEET
TOTAL DYNAMIC HEAD (T.D.H.)	=	
WETWELL DIAMETER: 6"	=	

**INDUSTRIAL PARK PUMP STATION NO. 3 EQUIPMENT DATA**

- TWO (2) 4 HP (MIN.) PUMPS
- CAPACITY (OPERATING POINT): 145 G.P.M. @ 54 T.D.H.
- PUMP TYPE & MANUFACTURER: FLYGT NP 3085 SH IMPELLER NO. 126
- DISCHARGE SIZE: 4"
- PUMP CONTROL: AUTOMATIC
- SOLIDS PASSING SIZE: N/A FOR N-SERIES PUMPS
- FORCE MAIN PRESSURE RATING & TYPE: PRESSURE CLASS 300, PVC
- CYCLE TIME: 12 MIN.
- Volt: 460 AMP: 5

**GENERAL NOTES:**

- THE CONTRACTOR SHALL CONTACT AND OBTAIN THE PERMISSION OF THE OWNER 48 HOURS (MIN.) PRIOR TO ANY CONSTRUCTION ACTIVITY INTERRUPTING OPERATION OF THE EXISTING PUMP STATIONS. ALL MATERIALS, EQUIPMENT AND PERSONNEL REQUIRED SHALL BE ON SITE PRIOR TO ANY CONSTRUCTION ACTIVITY THAT DISRUPTS OPERATION OF THE EXISTING PUMP STATIONS.
- ALL PROPOSED MAINS LOCATED WITHIN THE LIMITS OF THE EXISTING HIGHWAY R.O.W. SHALL BE INSTALLED WITH 36" (MIN.) OF COVER ABOVE THE PROPOSED MAIN. THE DIMENSION OF COVER WILL BE MEASURED FROM THE TOP EXTERIOR SURFACE OF THE PROPOSED MAIN AT THE POINT OF MAXIMUM DIAMETER OF THE PROPOSED MAIN (JOINT, BELL, FITTING, ETC.) TO THE GROUND SURFACE. COVER AT HIGHWAY DITCH LINES SHALL ACCORDINGLY BE 36" BELOW INVERT TO DITCH.
- THE CONTRACTOR SHALL NOTE THAT THE LENGTH OF BORES AND CASINGS REFERRED TO ON THE CONTRACT DRAWINGS IS A MINIMUM. CONTRACTOR SHALL ADJUST LENGTH AS REQUIRED BY FIELD REQUIREMENTS DURING CONSTRUCTION OF THIS PROJECT.
- THE CONTRACTOR SHALL NOTE THAT MANY WATERWAY CROSSINGS (CREEKS, STREAMS, DRAINS, ETC.) REQUIRE PROTECTION BY PLACEMENT OF EITHER A CRUSHED ROCK OR CONCRETE CAP ABOVE THE PROPOSED MAIN. MOST OF THESE CROSSINGS HAVE BEEN IDENTIFIED, HOWEVER ADDITIONAL CAPS MAY BE REQUIRED AS ACTUAL FIELD CONSTRUCTION DICTATES. FURTHER THE LENGTH AND MATERIAL (STONE OR CONCRETE) MAY BE CHANGED AS REQUIRED BY ACTUAL FIELD CONDITIONS DURING CONSTRUCTION OF THIS CONTRACT. ALL CHANGES SHALL BE PAID FOR AT THE UNIT PRICE BID FOR SAID WATERWAY CROSSINGS UNDER THIS CONTRACT AND SHALL BE APPROVED BY THE OWNER PRIOR TO INSTALLATION.
- THE CONTRACTOR SHALL NOTE THAT THE APPROXIMATE LOCATION OF MANY OF THE EXISTING HIGHWAY CULVERTS AND APPURTENANCES HAVE BEEN DEPICTED ON THE CONTRACT DRAWINGS, HOWEVER ADDITIONAL SUCH ITEMS MAY EXIST. FURTHERMORE IN SOME CIRCUMSTANCES THE EXISTING CULVERTS HAVE BEEN REFERRED TO AS BROKEN OR DAMAGED. IT IS THE CONTRACTOR'S RESPONSIBILITY TO LOCATE AND DOCUMENT THE CONDITION OF ALL EXISTING APPURTENANCES (HIGHWAY AND UTILITY) TO PREVENT CLAIMS THAT SAID ITEMS WERE DAMAGED DIRECTLY OR INDIRECTLY BY THE CONTRACTOR DURING CONSTRUCTION OF THIS CONTRACT.
- ALL EXCAVATION UNDER THIS CONTRACT IS UNCLASSIFIED. NO EXTRA COMPENSATION WILL BE ALLOWED FOR ROCK EXCAVATION. ADDITIONALLY, NO EXTRA COMPENSATION WILL BE ALLOWED FOR EXTRA TRENCH DEPTH THAT MAY BE REQUIRED TO AVOID EXISTING UTILITIES, ETC. OR REQUIRED BY GRADE TRANSITIONS SUCH AS CREEK CROSSINGS, ETC. THE CONTRACTOR SHALL INCLUDE ALL SUCH COSTS IN THE PRICE BID.
- THE CONTRACTOR SHALL NOTE THAT SOME PROPERTIES ALONG THE PROPOSED ROUTE MAY HAVE EXISTING ON-SITE SEWAGE DISPOSAL SYSTEMS (SEPTIC TANKS, LEACH FIELDS, ETC.) THE CONTRACTOR SHALL ASSESS FIELD CONDITIONS AHEAD OF ITS EXCAVATION AS REQUIRED TO AVOID DISTURBING ALL SUCH SYSTEMS. HOWEVER IF DISTURBANCE IS UNAVOIDABLE OR ACCIDENTAL, THE CONTRACTOR SHALL HAVE ON CALL A LICENSED PLUMBER TO REPAIR ANY AND ALL DAMAGE CAUSED DIRECTLY OR INDIRECTLY BY THE CONTRACTOR. FURTHERMORE, THE CONTRACTOR SHALL CONTACT THE OWNER AND/OR THE ENGINEER PRIOR TO BACK FILLING THE PURPOSED MAIN OR SEWER TO ALLOW ASSESSMENT OF FIELD CONDITIONS WHICH MAY REQUIRE FURTHER PROTECTION OF THE PROPOSED MAIN. ANY REPAIRS MADE TO EXISTING SEPTIC SYSTEMS SHALL BE PERMANENT, IN ACCORDANCE WITH ALL GOVERNING CODES, AND SHALL BE COMPLETED THE SAME DAY.
- THE PROPERTY LINES ARE BASED ON PVA MAPS ONLY NOT A BOUNDARY SURVEY. THE ACCURACY OF THE PROPERTY LINES ARE APPROXIMATE ONLY.
- THE CONTRACTOR SHALL NOTIFY THE OWNER IMMEDIATELY IF SINK HOLE IS ENCOUNTERED DURING EXCAVATION.

**WETLANDS CONSTRUCTION NOTES:**

IT IS THE CONTRACTOR'S RESPONSIBILITY TO CONTROL EROSION TO/FROM SITES LABELED AS WETLANDS DURING CONSTRUCTION. REFER TO THE U.S. ARMY CORPS OF ENGINEERS PERMIT NUMBER LRL-2015-00774-mck IN THE SPECIFICATIONS FOR SPECIAL WETLANDS CONSTRUCTION PERMIT REQUIREMENTS.

MAINS CONSTRUCTED WITHIN AREAS IDENTIFIED AS WETLANDS SHALL USE HORIZONTAL DIRECTIONAL DRILLING (HDD) TO MINIMIZE THE AREA OF DISTURBANCE CAUSED BY CONSTRUCTION.

ALL EXCESS ROCK PLACED WITHIN WETLANDS FOR CONSTRUCTION PURPOSES REGARDLESS OF SIZE AND PLACEMENT MUST BE REMOVED FROM THE SITE AFTER UTILITY CONSTRUCTION IS COMPLETE.

SOIL EXCAVATED FOR ANY INSERTION OR RECEIVING PITS IN WETLANDS MUST BE EXCAVATED IN EVEN LAYERS. THE SOIL LAYERS MUST REMAIN NEAR THE ORIGINAL PIT AT ALL TIMES AND MUST BE PLACED BACK INTO THEIR ORIGINAL PIT AT THEIR EXCAVATED ELEVATION AFTER CONSTRUCTION NEAR THE PIT AREA IS COMPLETE. ONLY MATERIAL REMOVED FROM INSERTION OR RECEIVING PITS CAN BE PLACED BACK IN THE PIT DURING THE BACKFILL PROCESS.

**ELECTRICAL ABBREVIATIONS:**

A	AMPERE
ATS	AUTOMATIC TRANSFER SWITCH
C	CONDUIT
EF	EXHAUST FAN
FVNR	FULL VOLTAGE NON-REVERSING
G	GROUND
HP	HORSEPOWER
KVA	KILOVOLT AMPERES
KW	KILOWATT
LP	LIGHTING PANEL
MCB	MAIN CIRCUIT BREAKER
MCC	MOTOR CONTROL CENTER
MCM	THOUSAND CIRCULAR MILS
MLO	MAIN LUGS ONLY
NEC	NATIONAL ELECTRIC CODE
P	PUMP
Ø	PHASE
PVC	POLYVINYL CHLORIDE
RVSS	REDUCED VOLTAGE SOLID STATE
SCC	SUPERVISORY CONTROL CENTER
SS	STAINLESS STEEL
V	VOLTS
XFMR	TRANSFORMER

**DRAFTING SYMBOLS**

	DETAIL NOTATION
	DETAIL LETTER
	SHEET THAT DETAIL IS SHOWN ON
	SECTION NOTATION
	SECTION NUMBER
	SHEET THAT SECTION IS SHOWN ON
	SECTION NUMBER
	SHEET THAT SECTION IS SHOWN ON
	ELEVATION NOTATION
	ELEVATION LETTER
	SHEET THAT ELEVATION IS SHOWN ON
	EQUIPMENT IDENTIFICATION
	TYPE OF EQUIPMENT
	EQUIPMENT GROUP
	ROOM IDENTIFICATION
	DOOR IDENTIFICATION
	WINDOW IDENTIFICATION
	KEY/SPECIFIC NOTE CALL-OUT
	PARTITION TYPE REFERENCE
	CENTER LINE OF BEAM-COLUMN FRAME SYSTEM
	POINTS OF VIEW BEING CONSIDERED MATCH LINE
	REVISION
	FINISH ELEVATION
	SPOT ELEVATION
	HIDDEN OBJECT
	FUTURE OBJECT

**ARCHITECTURAL SYMBOLS**

	EARTH
	SAND, PLASTER, STUCCO
	CONCRETE
	BRICK
	CONCRETE BLOCK
	BATT INSULATION
	RIGID INSULATION
	BEDDING STONE
	SPLIT FACE BLOCK
	ROOF
	CANADIAN HEMLOCK
	NELLIE STEVENS HOLLY

**LEGEND:**

**TOPOGRAPHICAL SYMBOLS**

	PROPERTY LINE AND/OR RIGHT OF WAY
	CONSTRUCTION EASEMENT ON SEWER AND WATER PLANS
	PERMANENT EASEMENT ON SEWER AND WATER PLANS
	TEMPORARY EASEMENT ON SEWER AND WATER PLANS
	SECTION LINE
	CENTER LINE
	SOIL BORING
	EXISTING GUY WIRE
	EXISTING UTILITY POLE
	BURIED TELEPHONE CABLE PEDESTAL
	SIGN
	LIGHT POLE
	EXISTING TREE
	EXISTING MAILBOX
	EXISTING WATER METER
	EXISTING FIRE HYDRANT
	EXISTING FENCE POST
	EXISTING EDGE OF PAVEMENT
	EXISTING GRAVEL ROAD
	EXISTING TRAIL
	RAILROAD
	BRIDGE
	FENCE
	GUARD RAIL
	CURB AND GUTTER
	EXISTING OVERHEAD ELECTRIC
	MAJOR CONTOUR LINES
	MINOR CONTOUR LINES
	PROPOSED ROAD
	PROPOSED FENCE
	FLOODWAY
	100 YR FLOOD

**UNDERGROUND UTILITY SYMBOLS**

	EXISTING WATER MAIN
	NEW SANITARY SEWER AND MANHOLE
	EXISTING STORM SEWER
	FORCE MAIN WITH AIR RELEASE VALVE VACUUM MANHOLE
	PROPOSED ELECTRIC
	CREEK
	EXISTING GAS MAIN
	EXISTING ELECTRIC
	EXISTING PHONE
	CULVERT IN PROFILE
	ORIGINAL GROUND IN PROFILE
	NOTATION FOR COMBUSTIBLE FLUIDS

**PIPING SYMBOLS**

	FLANGE JOINT
	MECHANICAL JOINT

**ELECTRICAL SYMBOLS**

	LIGHTING
	FIXTURE SYMBOL (TYPICAL)
	A-INDICATES FIXTURE TYPE
	2-INDICATES CIRCUIT NUMBER
	B-INDICATES SWITCHING
	SOLID CIRCLE INDICATES ALWAYS ON
	INCANDESCENT, HID, WALL
	1X4 FLUORESCENT, SURFACE OR PENDANT
	SWITCHES
	SINGLE POLE
	THREE WAY
	EQUIPMENT AND WIRING
	TRANSFORMER
	LINE VOLTAGE THERMOSTAT
	480V LOAD, REFER TO MCC SCHEDULE FOR EQUIPMENT NUMBER
	DISCONNECT, F=FUSED, B=CIRCUIT BREAKER, BLANK=NON-FUSED
	STROBE; WALL MOUNT
	HORN; WALL MOUNT

**POWER SYMBOLS**

	UNDERGROUND ELECTRIC
	OVERHEAD ELECTRIC
	CIRCUIT NUMBER (TYPICAL)
	OTHERWISE SHOWN PANEL DESIGNATION (TYP.)
	DUPLEX, 125 VOLT, WP INDICATES WEATHERPROOF
	DUPLEX, 125 VOLT, ABOVE FURNITURE
	FIXED EQUIPMENT CONNECTION
	AUTOMATIC TRANSFER SWITCH (ONE-LINE DIAGRAM)
	CIRCUIT BREAKER (ONE-LINE DIAGRAM)
	METER (ONE-LINE DIAGRAM)

**INSTRUMENTATION EQUIPMENT**

	LEVEL INDICATING TRANSMITTER, *: S=SUBMERSIBLE, U=ULTRASONIC, R=RING TYPE, RA=RADAR
	LEVEL SWITCH, *: C=CONDUCTANCE, F=BALL FLOAT, V=VIBRATING FORK, B=BUILDING FLOODING

**ACTUATORS**

	MOTOR (ELECTRIC)
--	------------------

**EQUIPMENT SYMBOLS**

	UNIT HEATER
--	-------------



DATE:	
REVISIONS	
NO.	


**DESIGN CRITERIA, GENERAL NOTES, LEGEND, AND ABBREVIATIONS**  
**CONTRACTS 1-2017, 2-2017, 3-2017, AND 4-2017**  
 NOLIN RIVER WATERSHED SEWER INFRASTRUCTURE  
 HARDIN COUNTY WATER DISTRICT NO. 2  
 HARDIN COUNTY, KENTUCKY

**JOB NO.**  
 5980.020  
**PROJECT MGR.**  
 MAS



**SHEET**  
 04



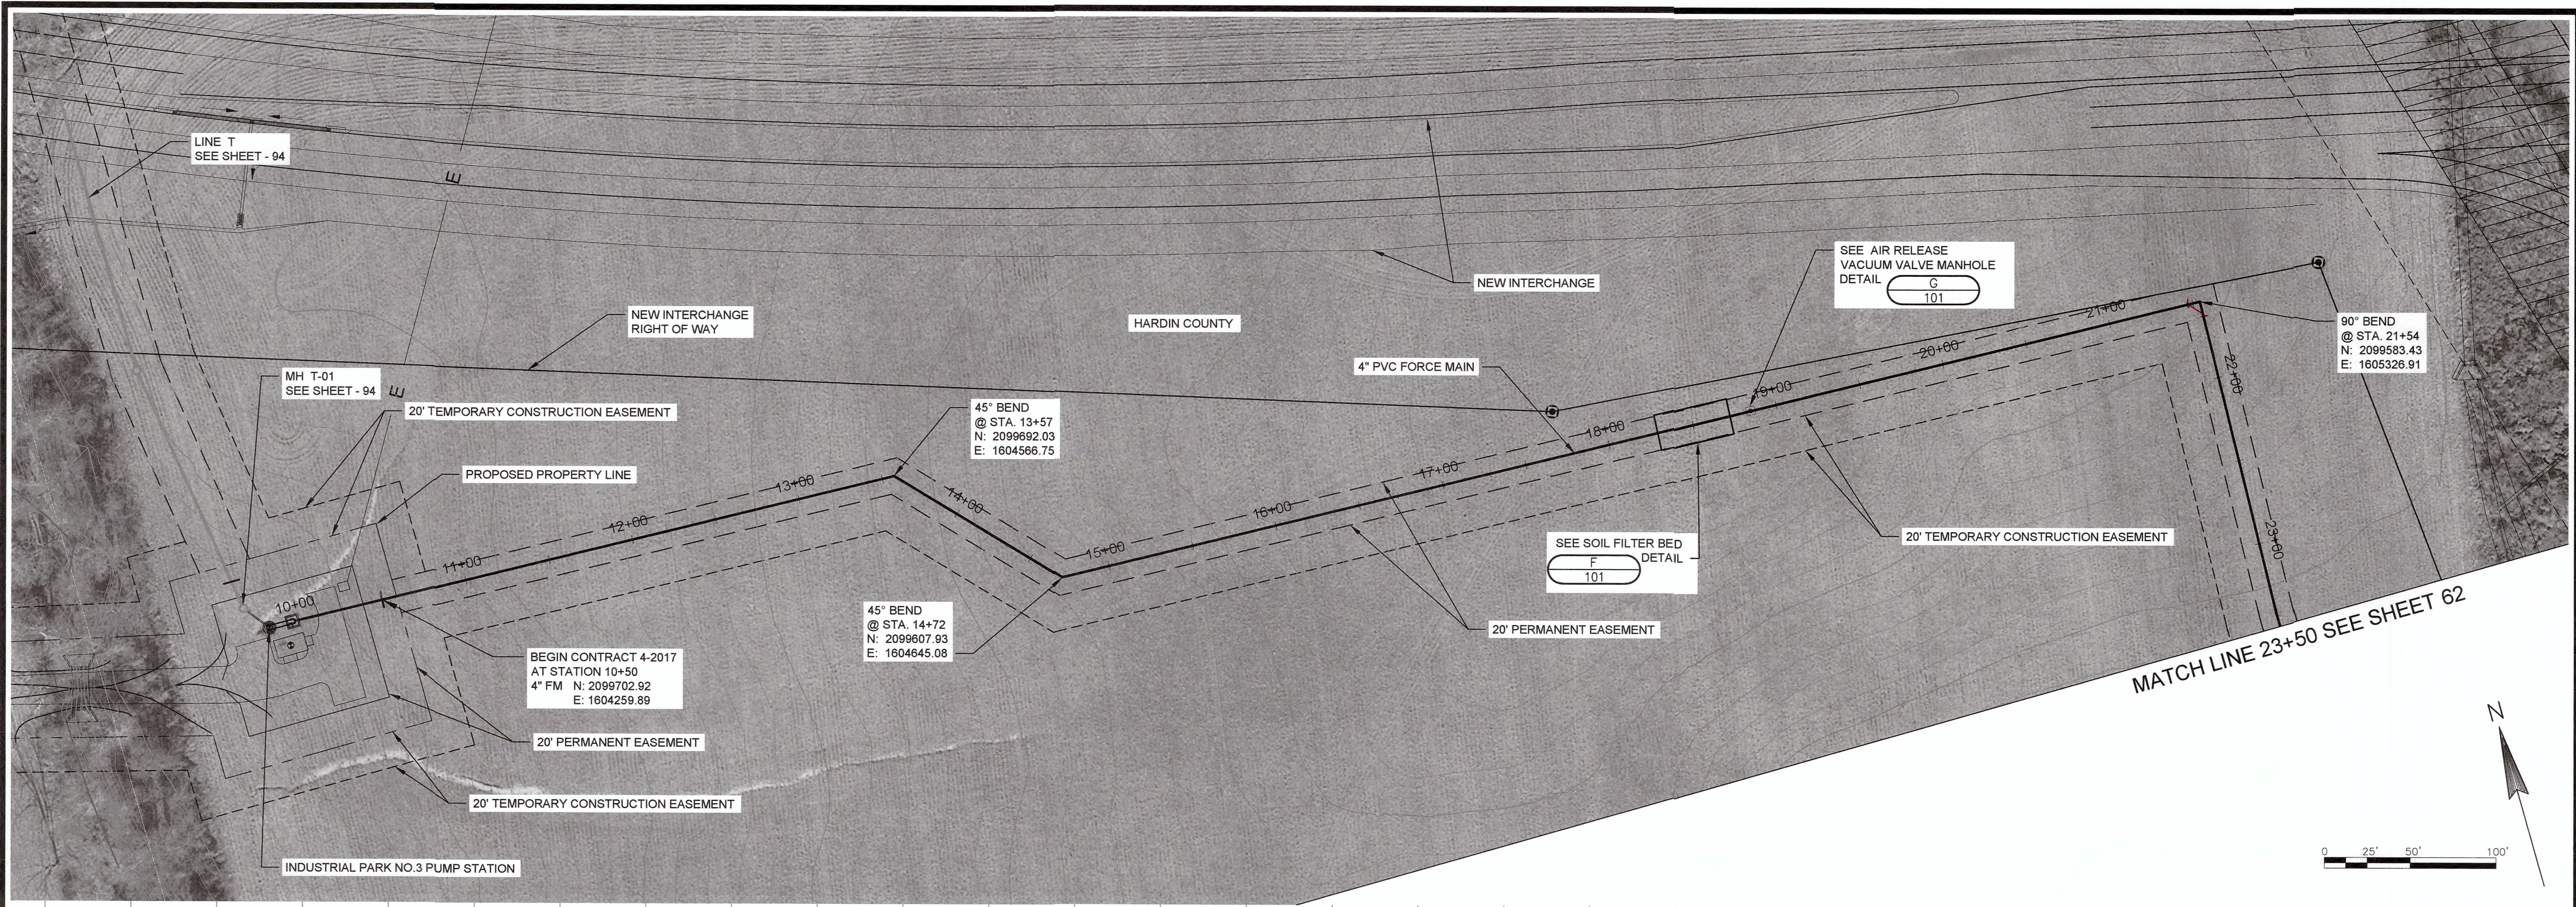


STATE OF KENTUCKY  
 MARK A. SNEVE  
 18511  
 8/15/17

DATE:	
REVISIONS:	
NO.:	

**INDUSTRIAL PARK PUMP STATION NO. 3  
 FORCE MAIN STA. 10+00 TO STA. 23+50  
 CONTRACT 4-2017**

NOLIN RIVER WATERSHED SEWER INFRASTRUCTURE  
 HARDIN COUNTY WATER DISTRICT NO. 2  
 HARDIN COUNTY, KENTUCKY

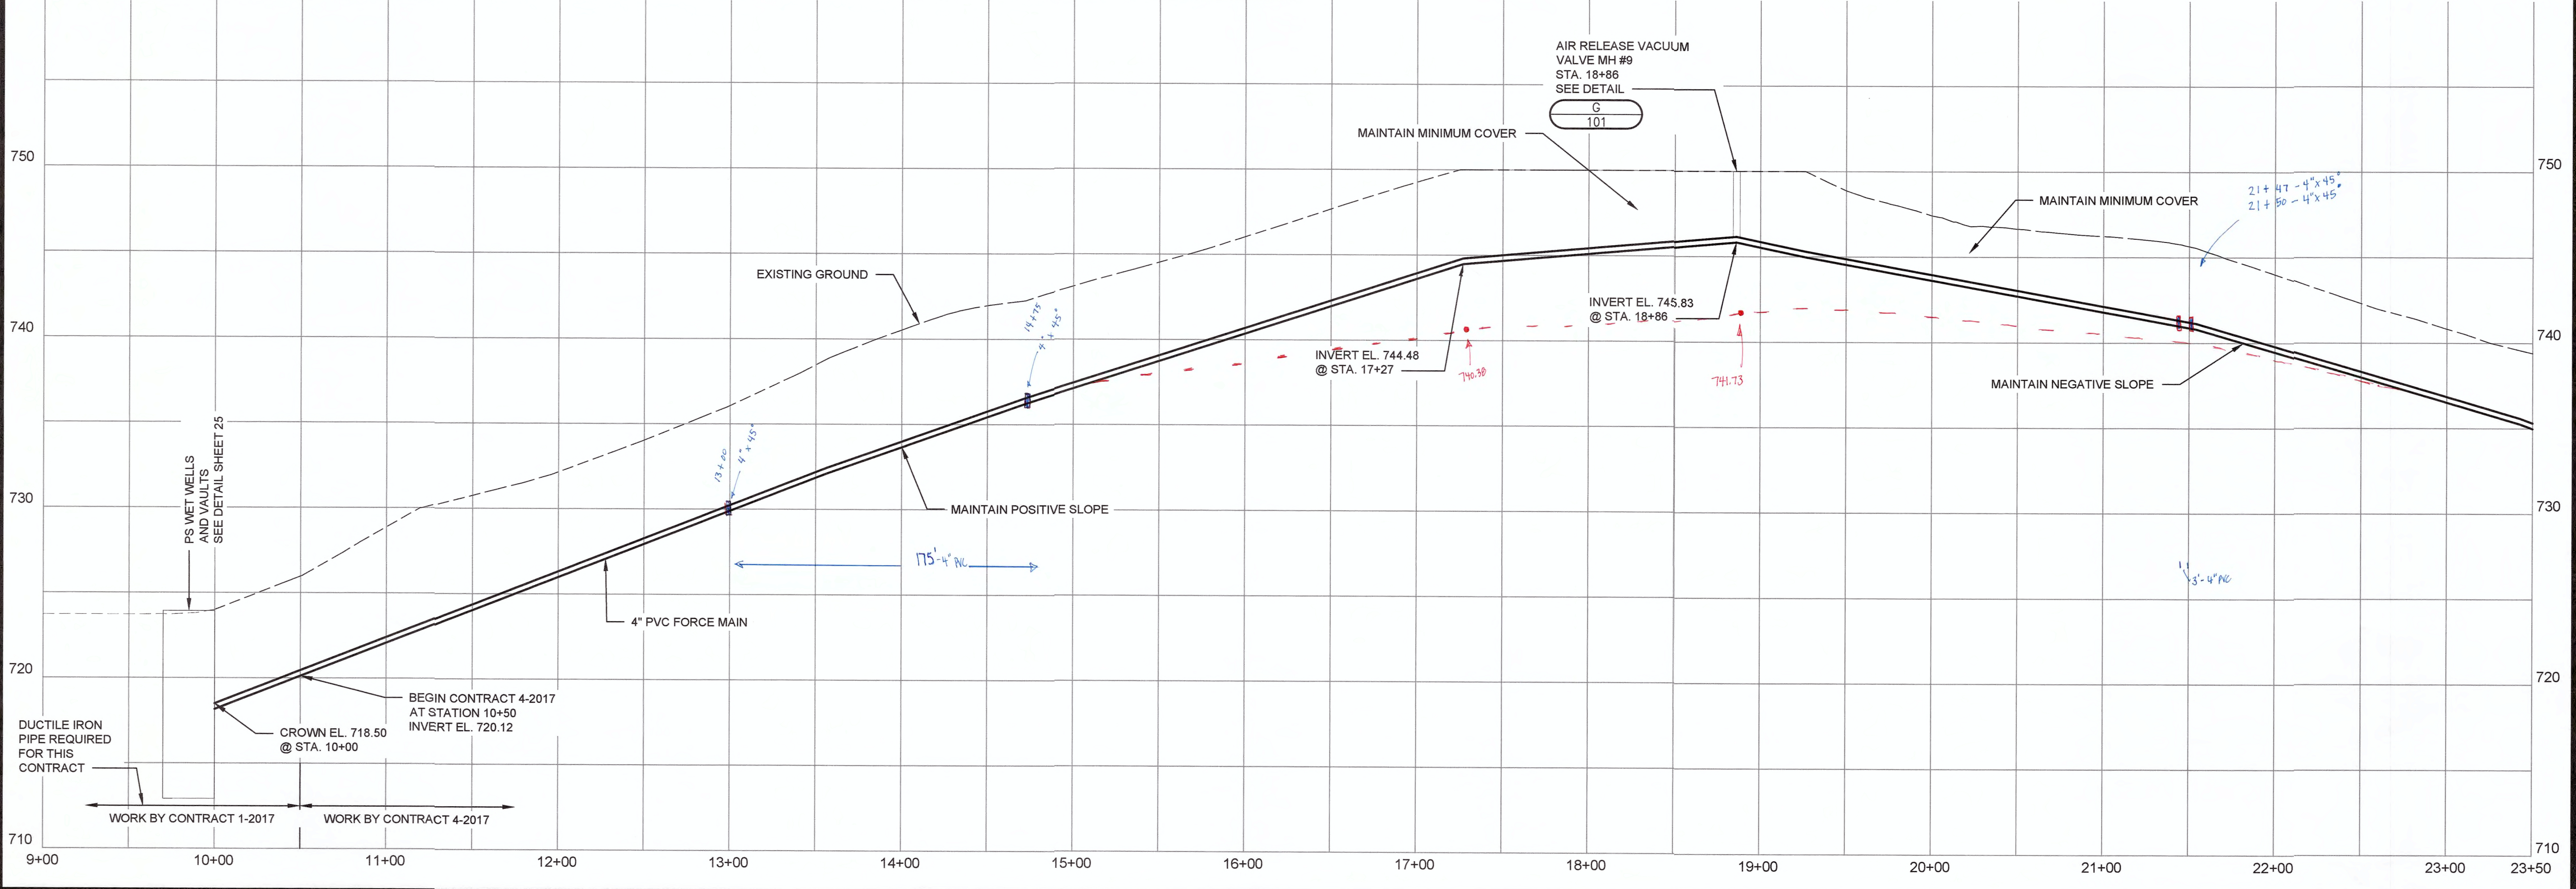



JOB NO.  
5980.020

PROJECT MGR.  
MAS

**SA**  
**STRAND**  
 ASSOCIATES®

SHEET  
**61**



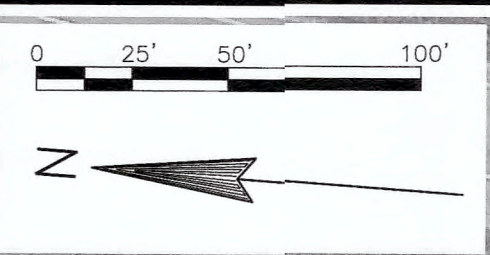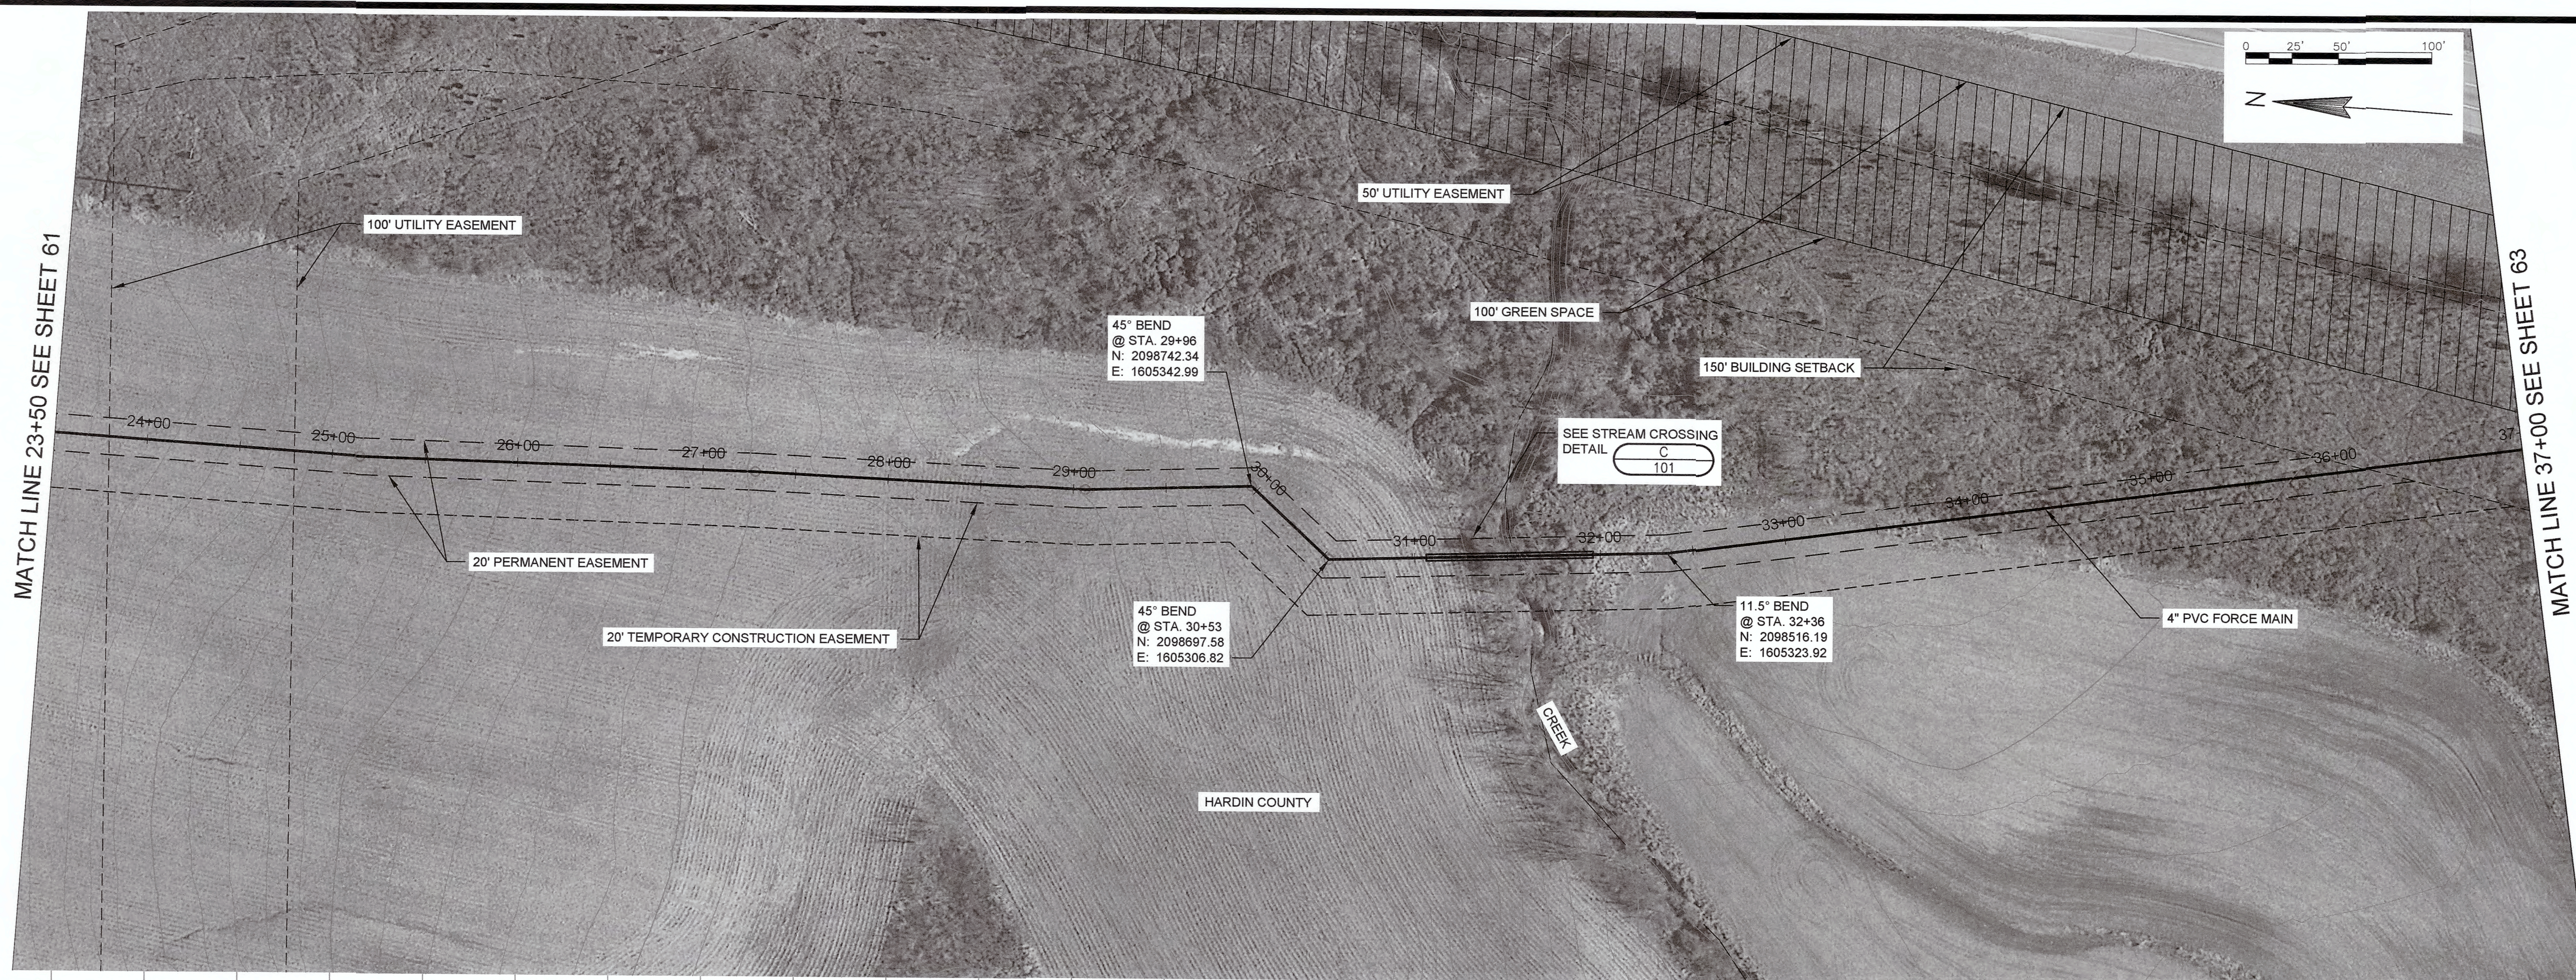

DATE:	
REVISIONS	
NO.	

**INDUSTRIAL PARK PUMP STATION NO. 3**  
**FORCE MAIN STA. 23+50 TO STA. 37+00**  
**CONTRACT 4-2017**


NOLIN RIVER WATERSHED SEWER INFRASTRUCTURE  
 HARDIN COUNTY WATER DISTRICT NO. 2  
 HARDIN COUNTY, KENTUCKY

JOB NO.  
5980.020


PROJECT MGR.  
MAS



SHEET  
62

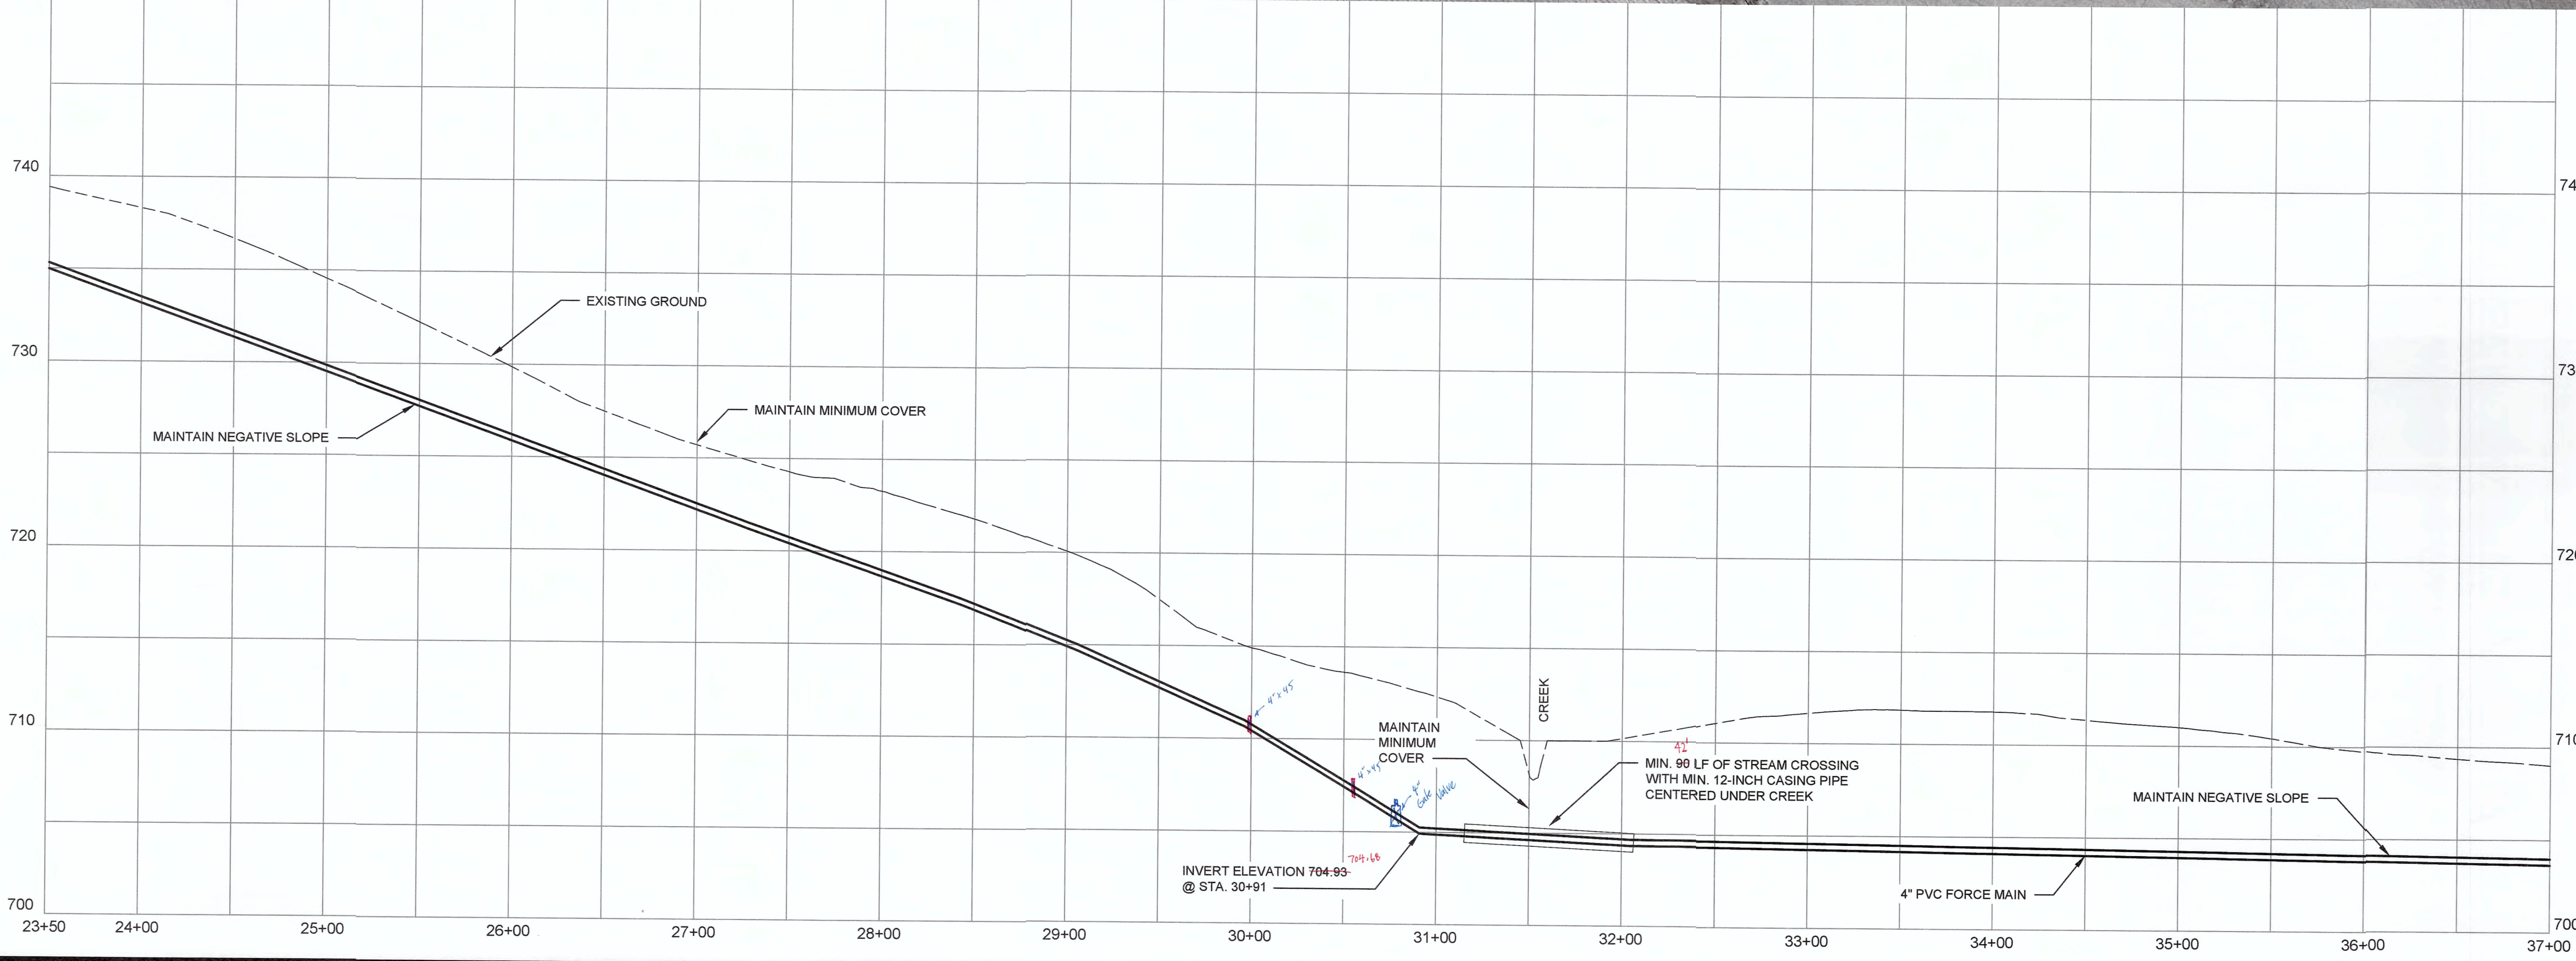




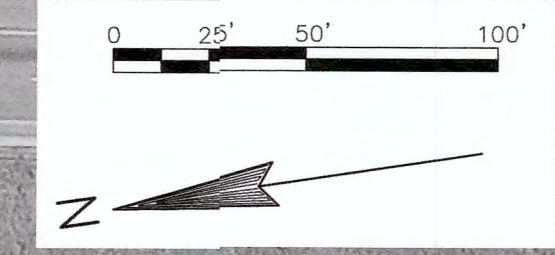

22.5° BEND  
@ STA. 37+53  
N: 2098009.63  
E: 1605426.44

MATCH LINE 37+00 SEE SHEET 62

MATCH LINE 50+50 SEE SHEET 64

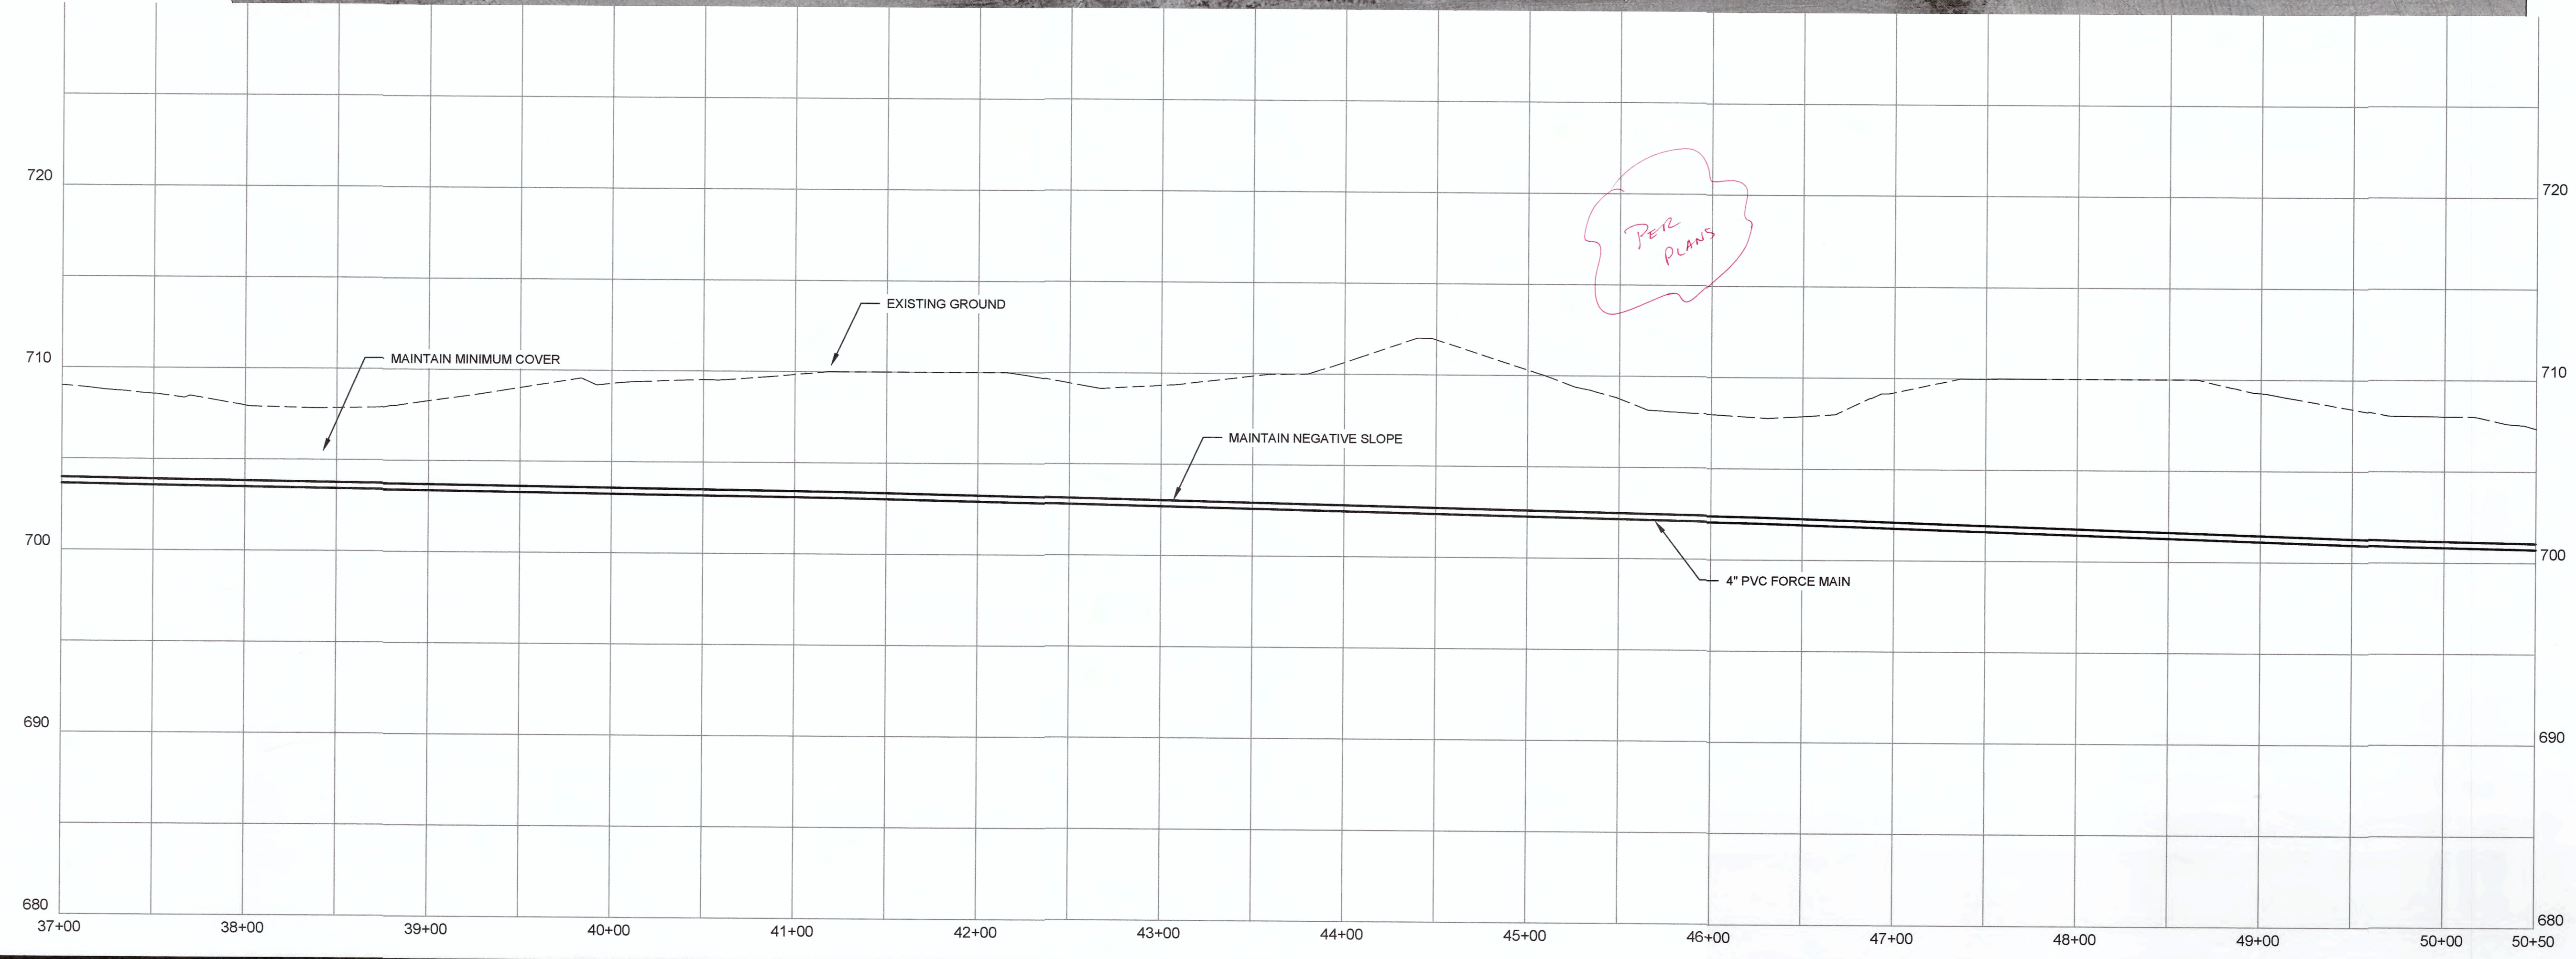

NO.	REVISIONS	DATE

**INDUSTRIAL PARK PUMP STATION NO. 3**  
**FORCE MAIN STA. 37+00 TO STA. 50+50**  
**CONTRACT 4-2017**

NOLIN RIVER WATERSHED SEWER INFRASTRUCTURE  
 HARDIN COUNTY WATER DISTRICT NO. 2  
 HARDIN COUNTY, KENTUCKY


**JOB NO.**  
5980.020

**PROJECT MGR.**  
MAS




**SHEET**  
**63**



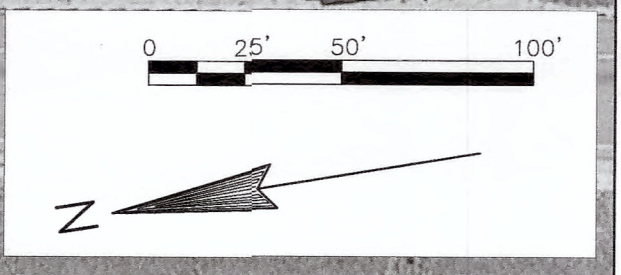

MATCH LINE 50+50 SEE SHEET 63

MATCH LINE 64+00 SEE SHEET 65

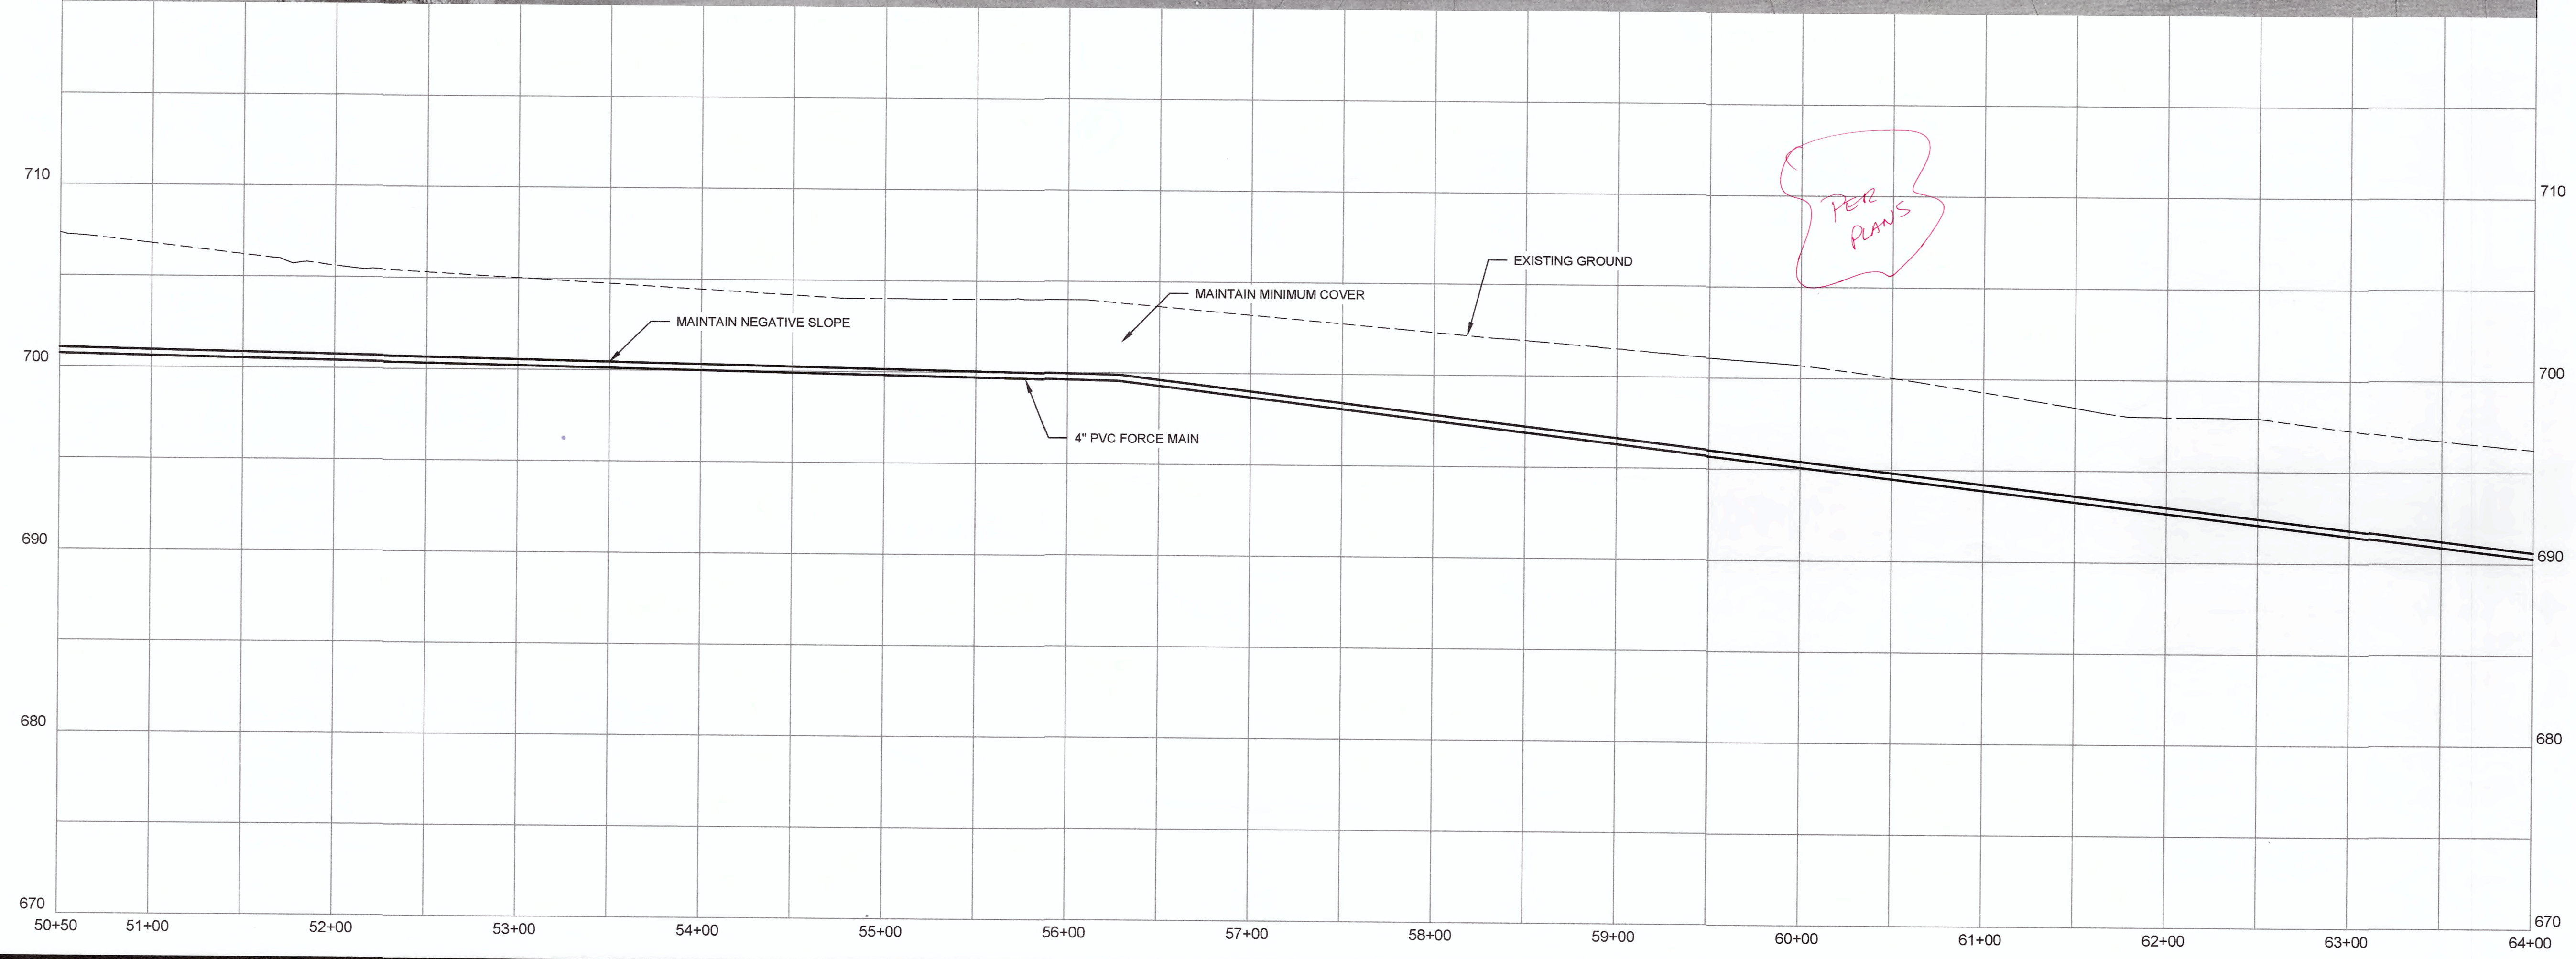

NO.	REVISIONS	DATE:

**INDUSTRIAL PARK PUMP STATION NO. 3  
FORCE MAIN STA. 50+50 TO STA. 64+00  
CONTRACT 4-2017**

NOLIN RIVER WATERSHED SEWER INFRASTRUCTURE  
HARDIN COUNTY WATER DISTRICT NO. 2  
HARDIN COUNTY, KENTUCKY


**JOB NO.**  
5980.020

**PROJECT MGR.**  
MAS




**SHEET**  
**64**



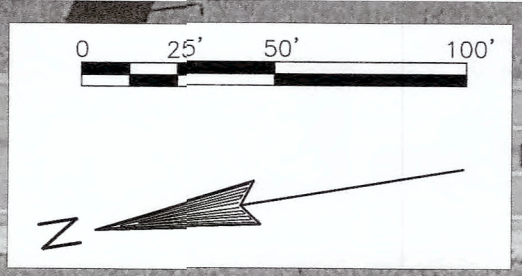

MATCH LINE 64+00 SEE SHEET 64

MATCH LINE 77+50 SEE SHEET 66

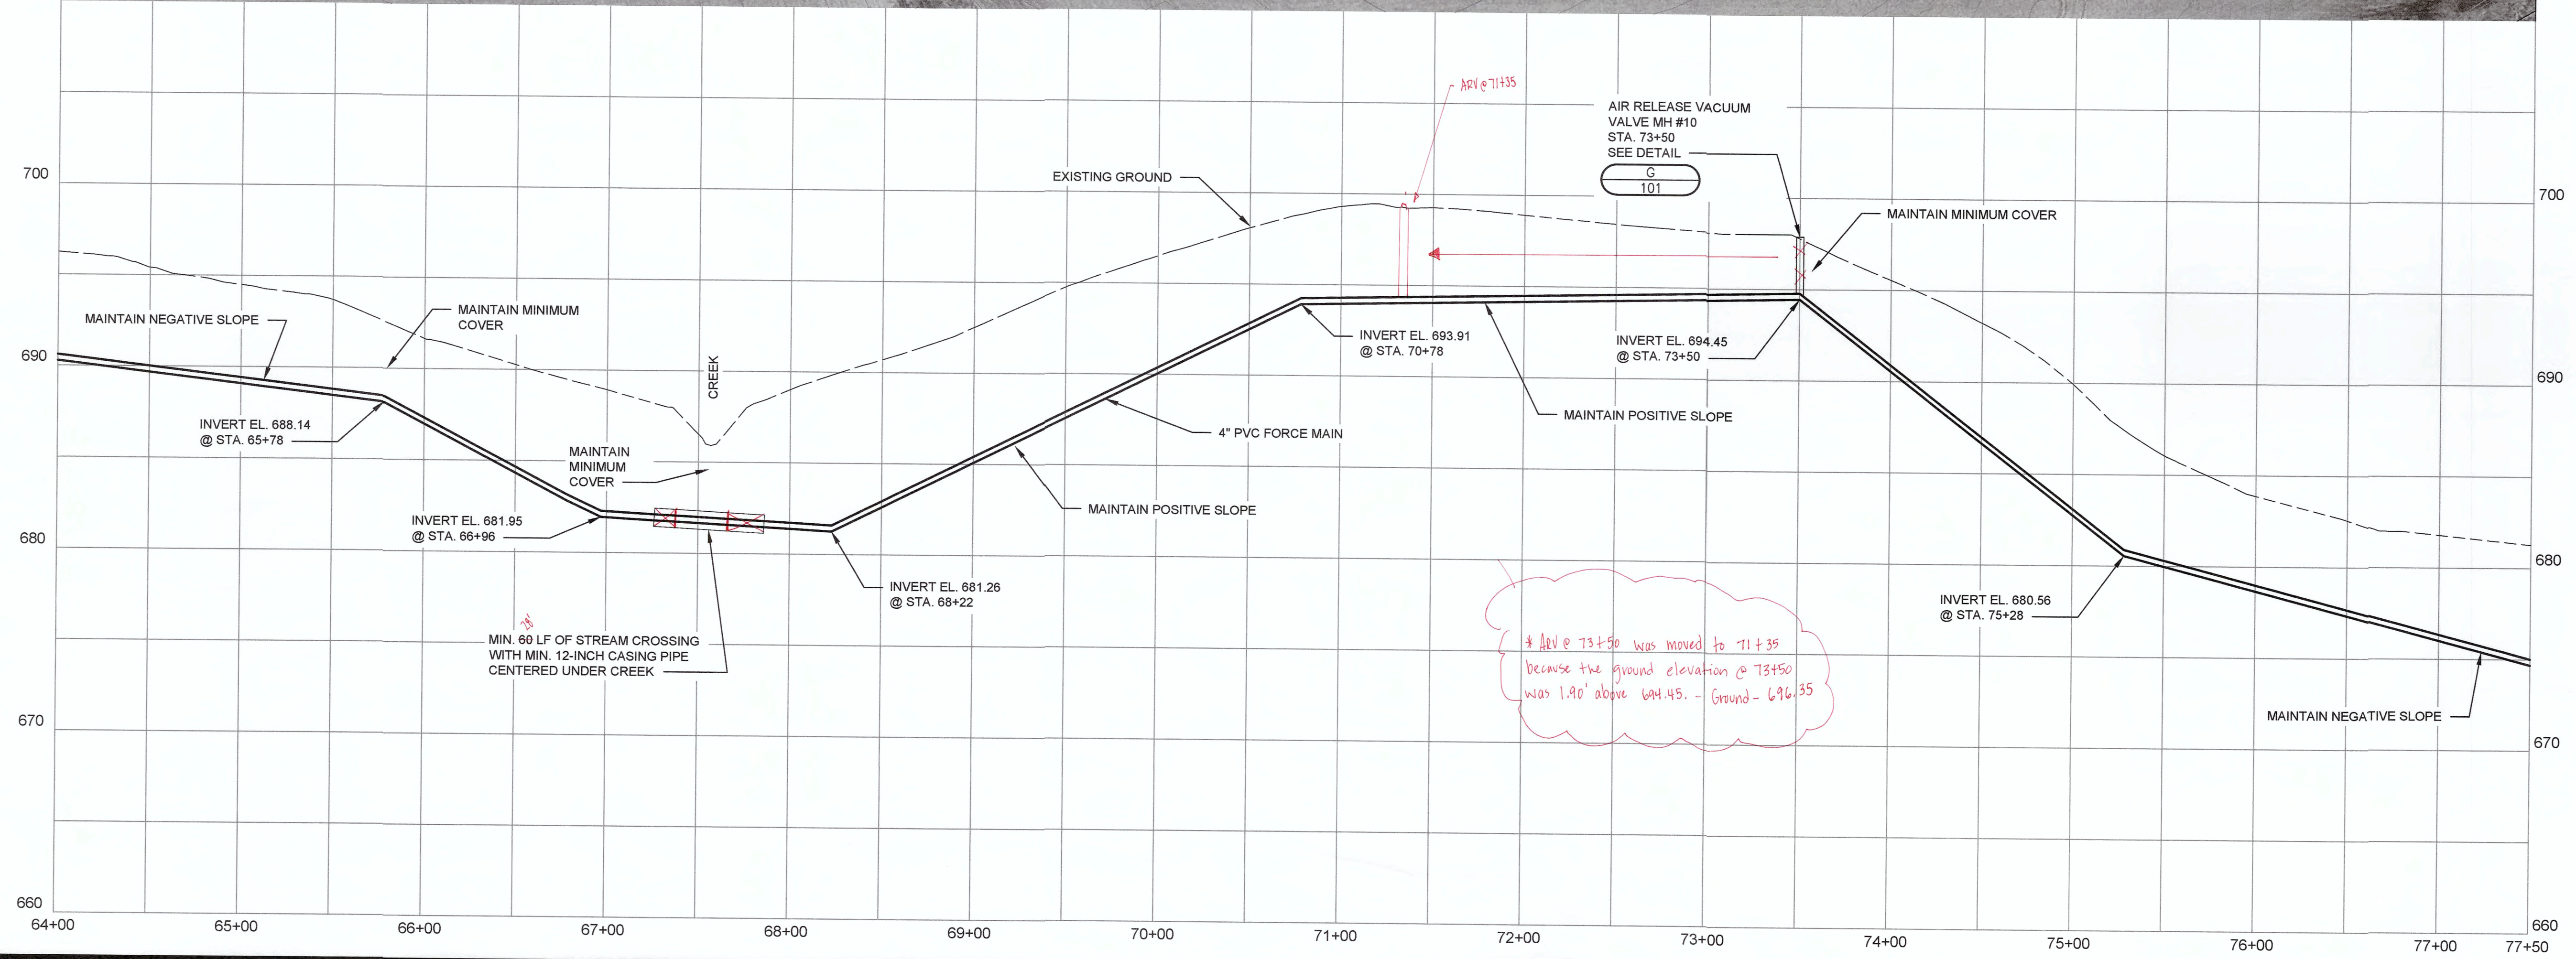

NO.	REVISIONS	DATE:

**INDUSTRIAL PARK PUMP STATION NO. 3**  
**FORCE MAIN STA. 64+00 TO STA. 77+50**  
**CONTRACT 4-2017**

NOLIN RIVER WATERSHED SEWER INFRASTRUCTURE  
 HARDIN COUNTY WATER DISTRICT NO. 2  
 HARDIN COUNTY, KENTUCKY

**JOB NO.**  
5980.020

**PROJECT MGR.**  
MAS





**SHEET**  
65





MATCH LINE 77+50 SEE SHEET 65

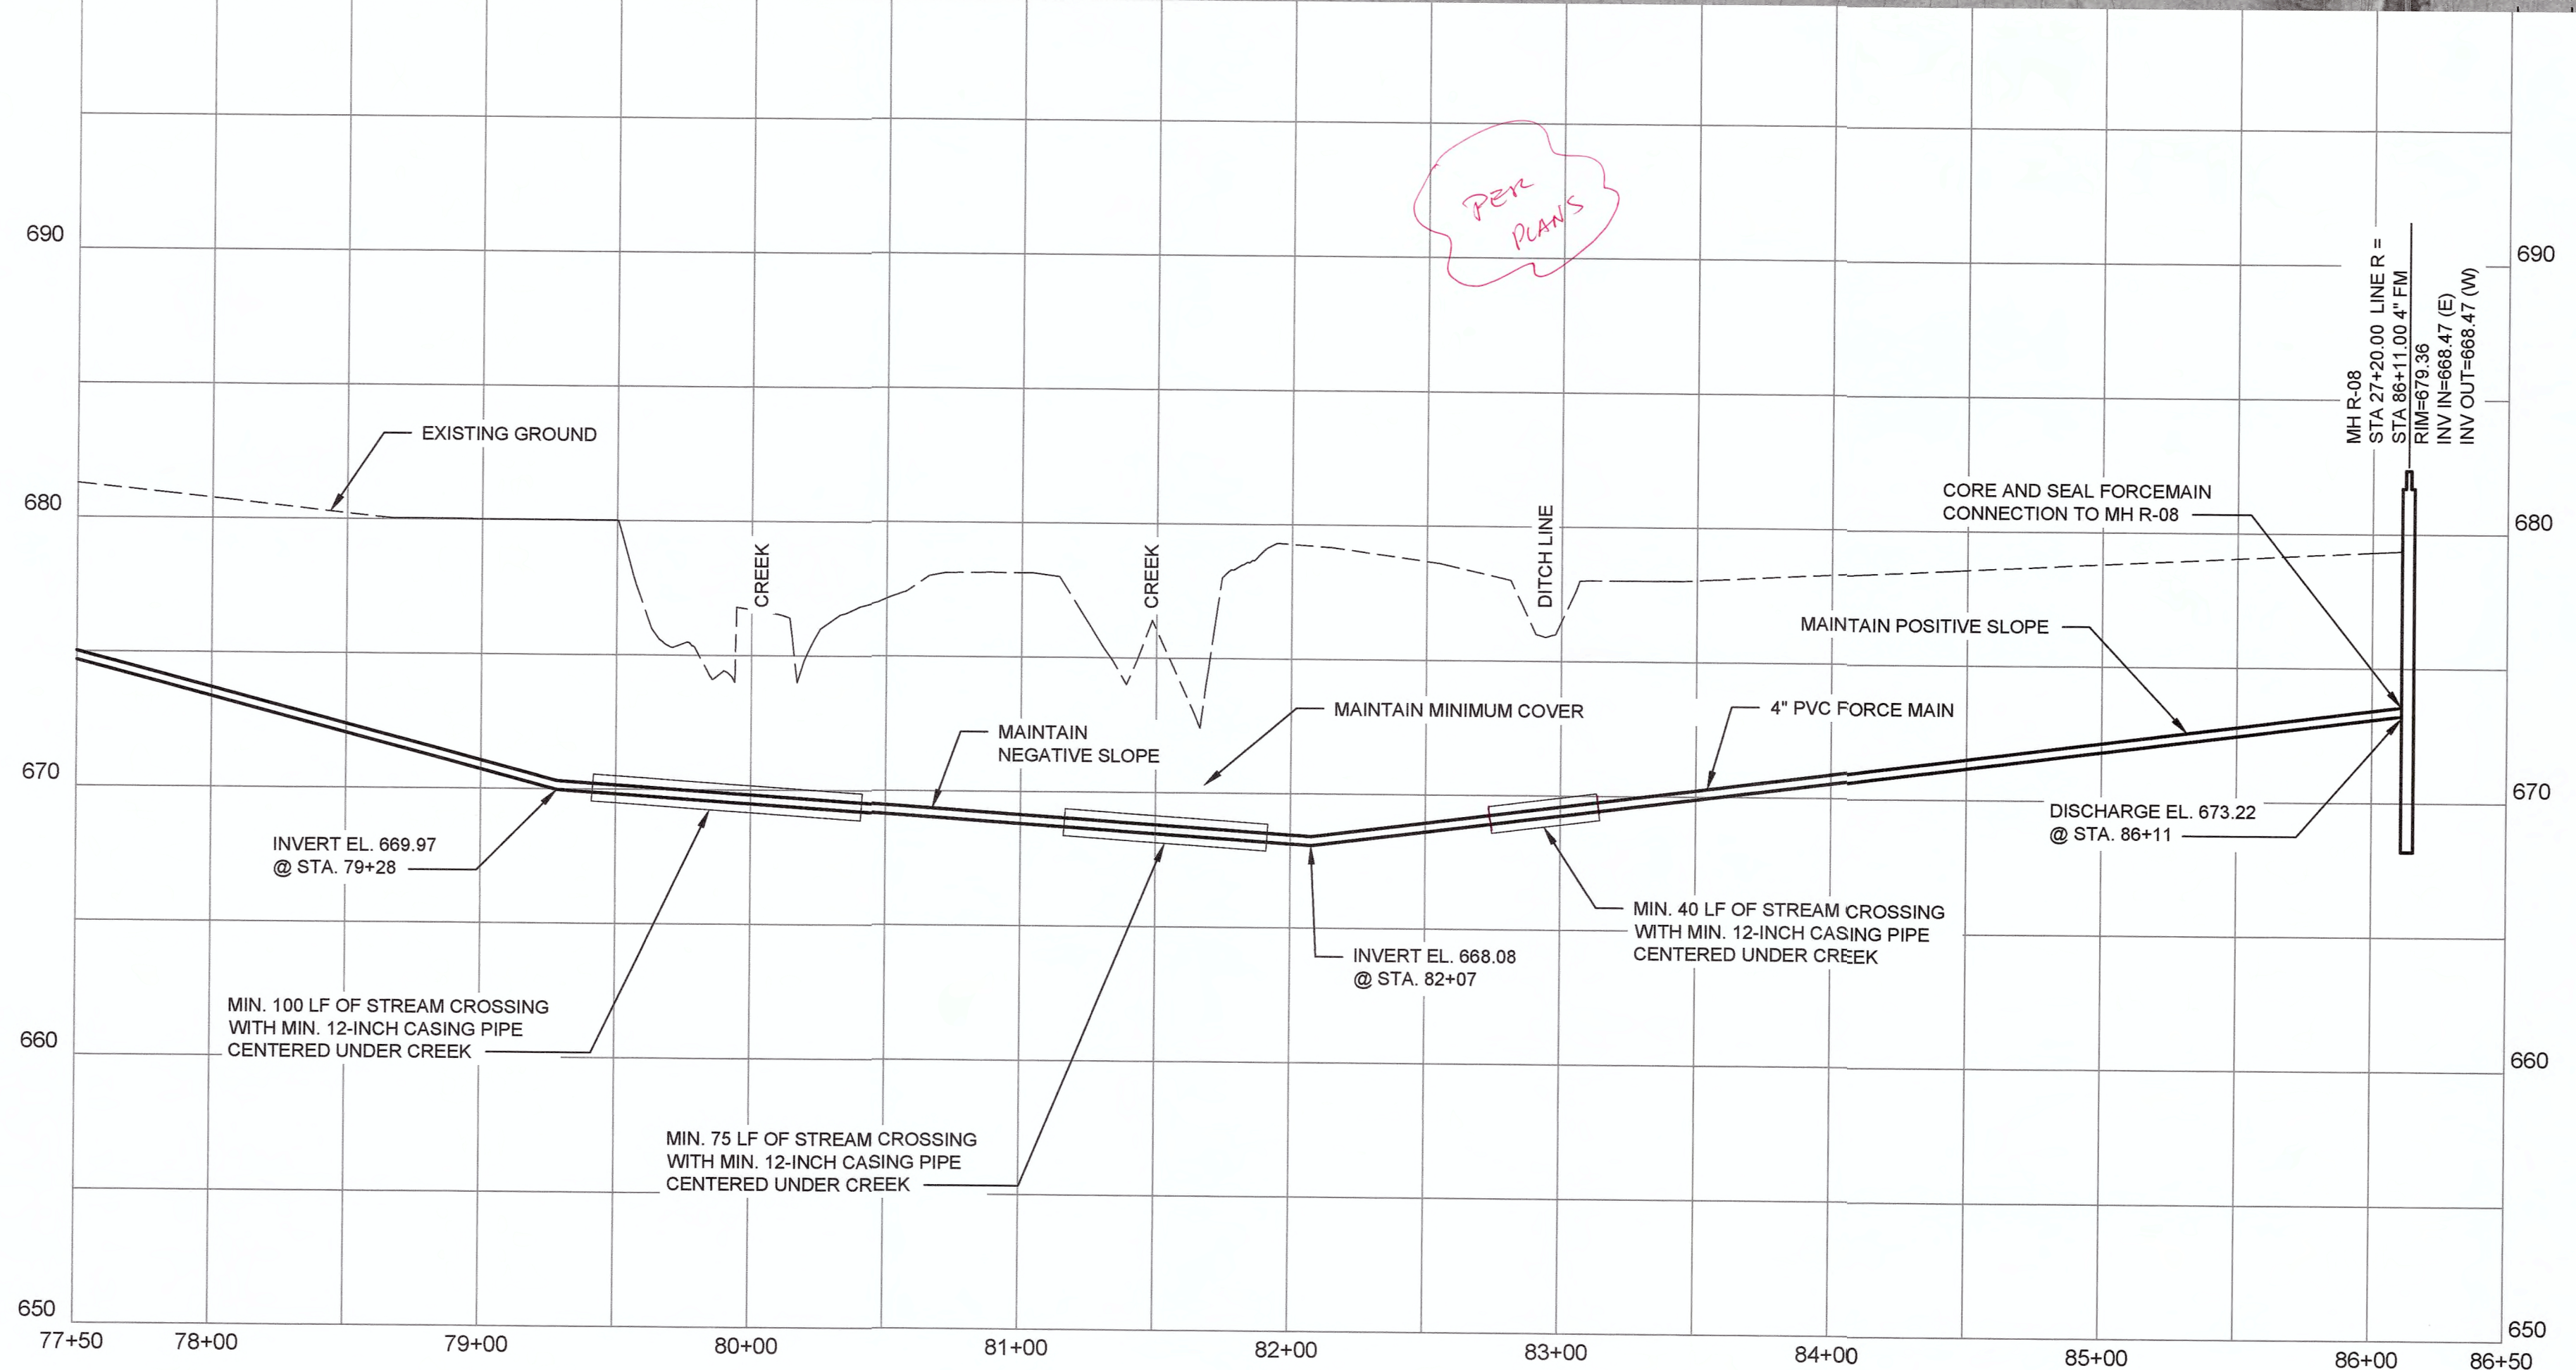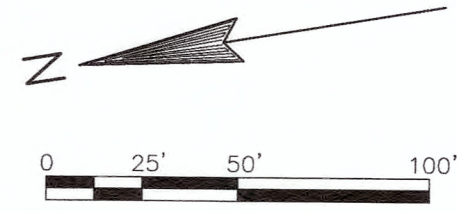

DATE:	REVISIONS:	NO.:

**INDUSTRIAL PARK PUMP STATION NO. 3**  
**FORCE MAIN STA. 77+50 TO STA. 86+11**  
**CONTRACT 4-2017**

NOLIN RIVER WATERSHED SEWER INFRASTRUCTURE  
 HARDIN COUNTY WATER DISTRICT NO. 2  
 HARDIN COUNTY, KENTUCKY



**JOB NO.**  
5980.020

**PROJECT MGR.**  
MAS



**SHEET**  
66




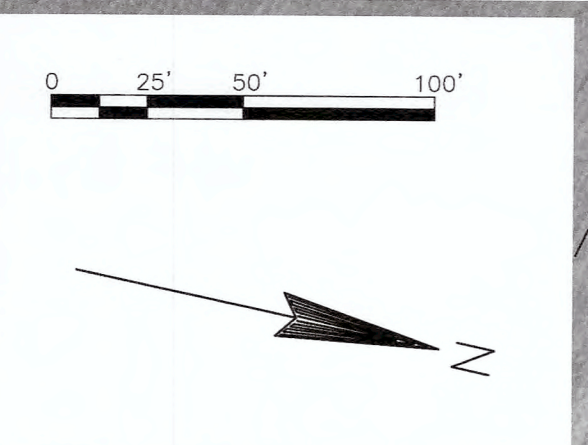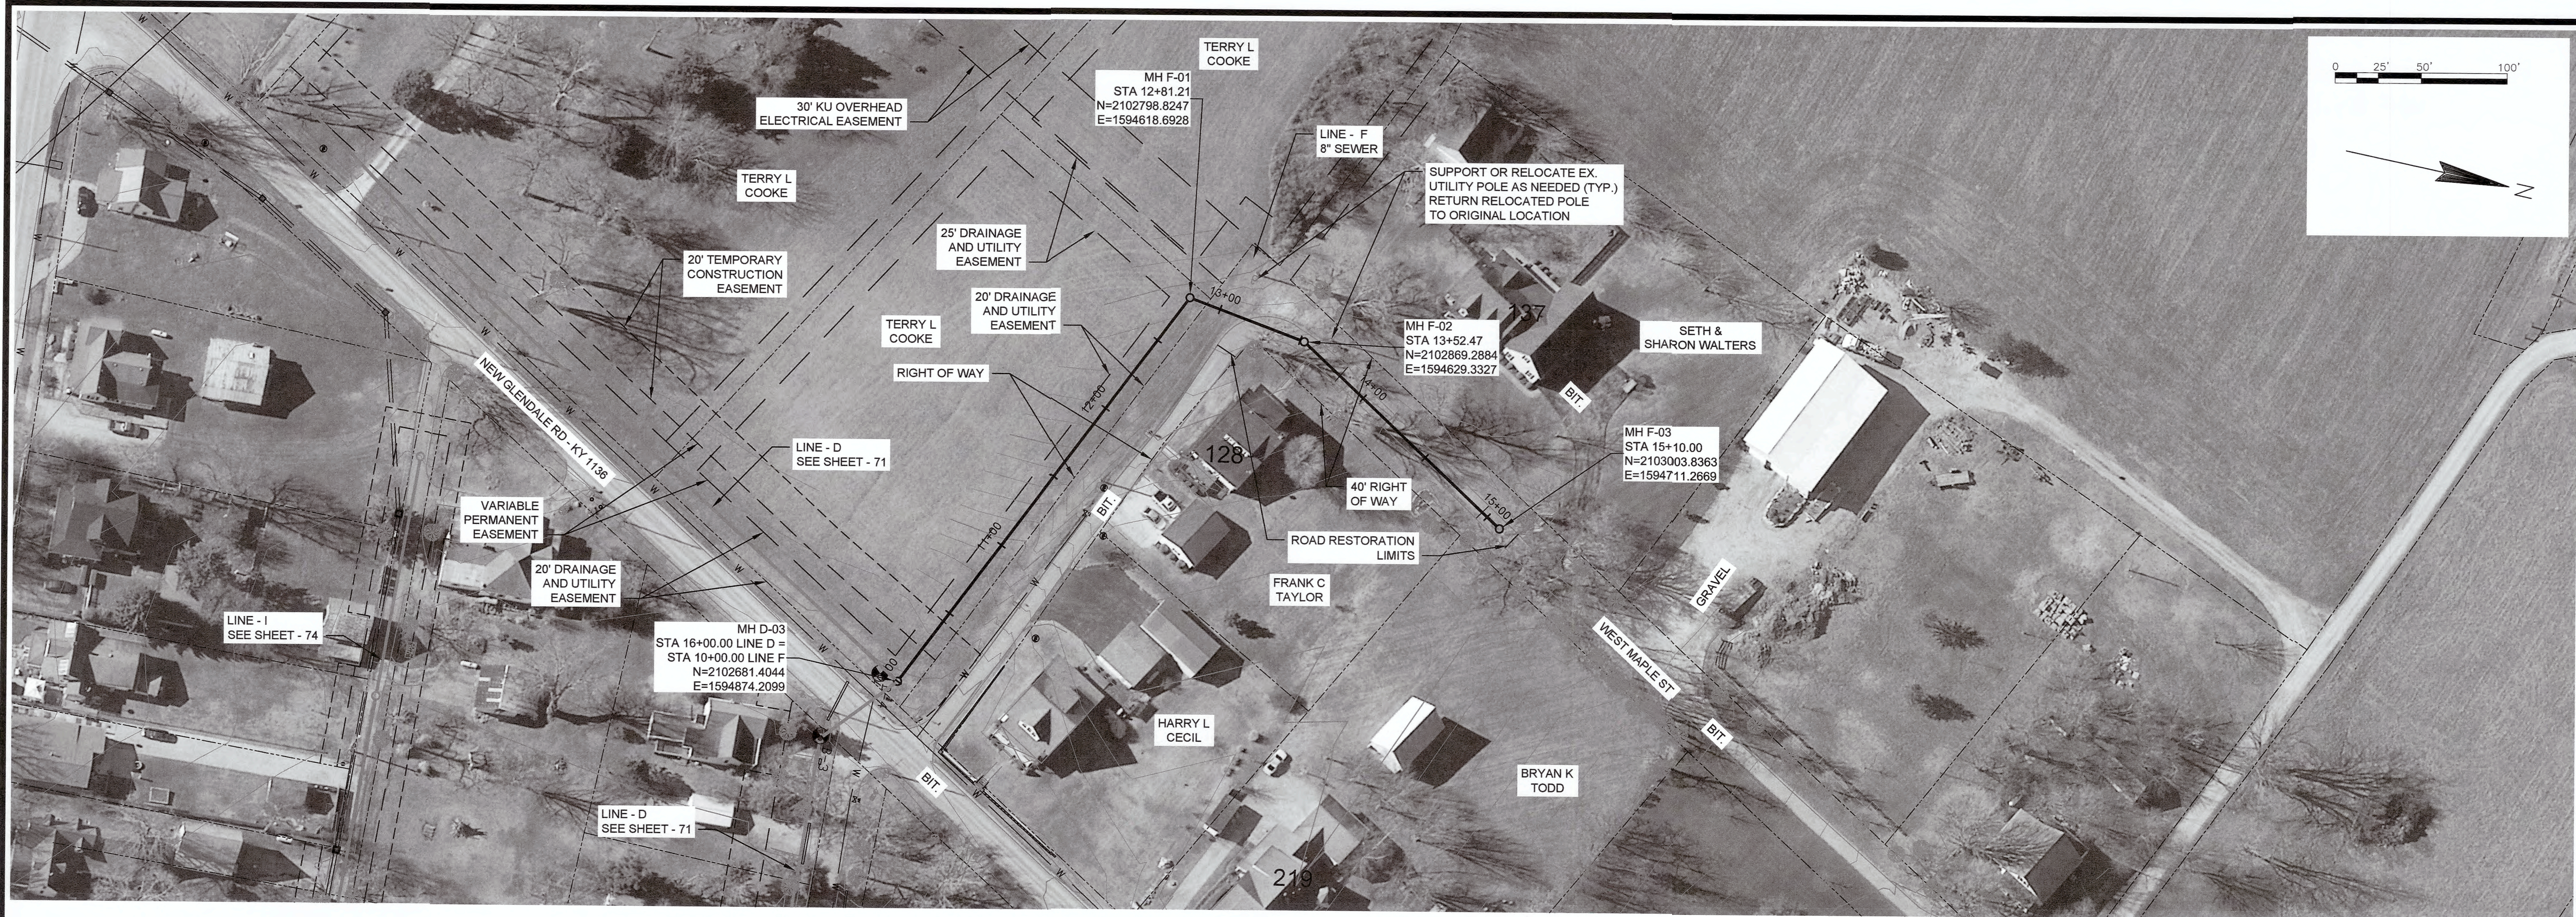

DATE:	NO.	REVISIONS

**GRAVITY SEWER PLAN AND PROFILE**  
**LINE F STA. 10+00 TO STA. 15+10.00**  
**CONTRACT 3-2017**

NOLIN RIVER WATERSHED SEWER INFRASTRUCTURE  
 HARDIN COUNTY WATER DISTRICT NO. 2  
 HARDIN COUNTY, KENTUCKY

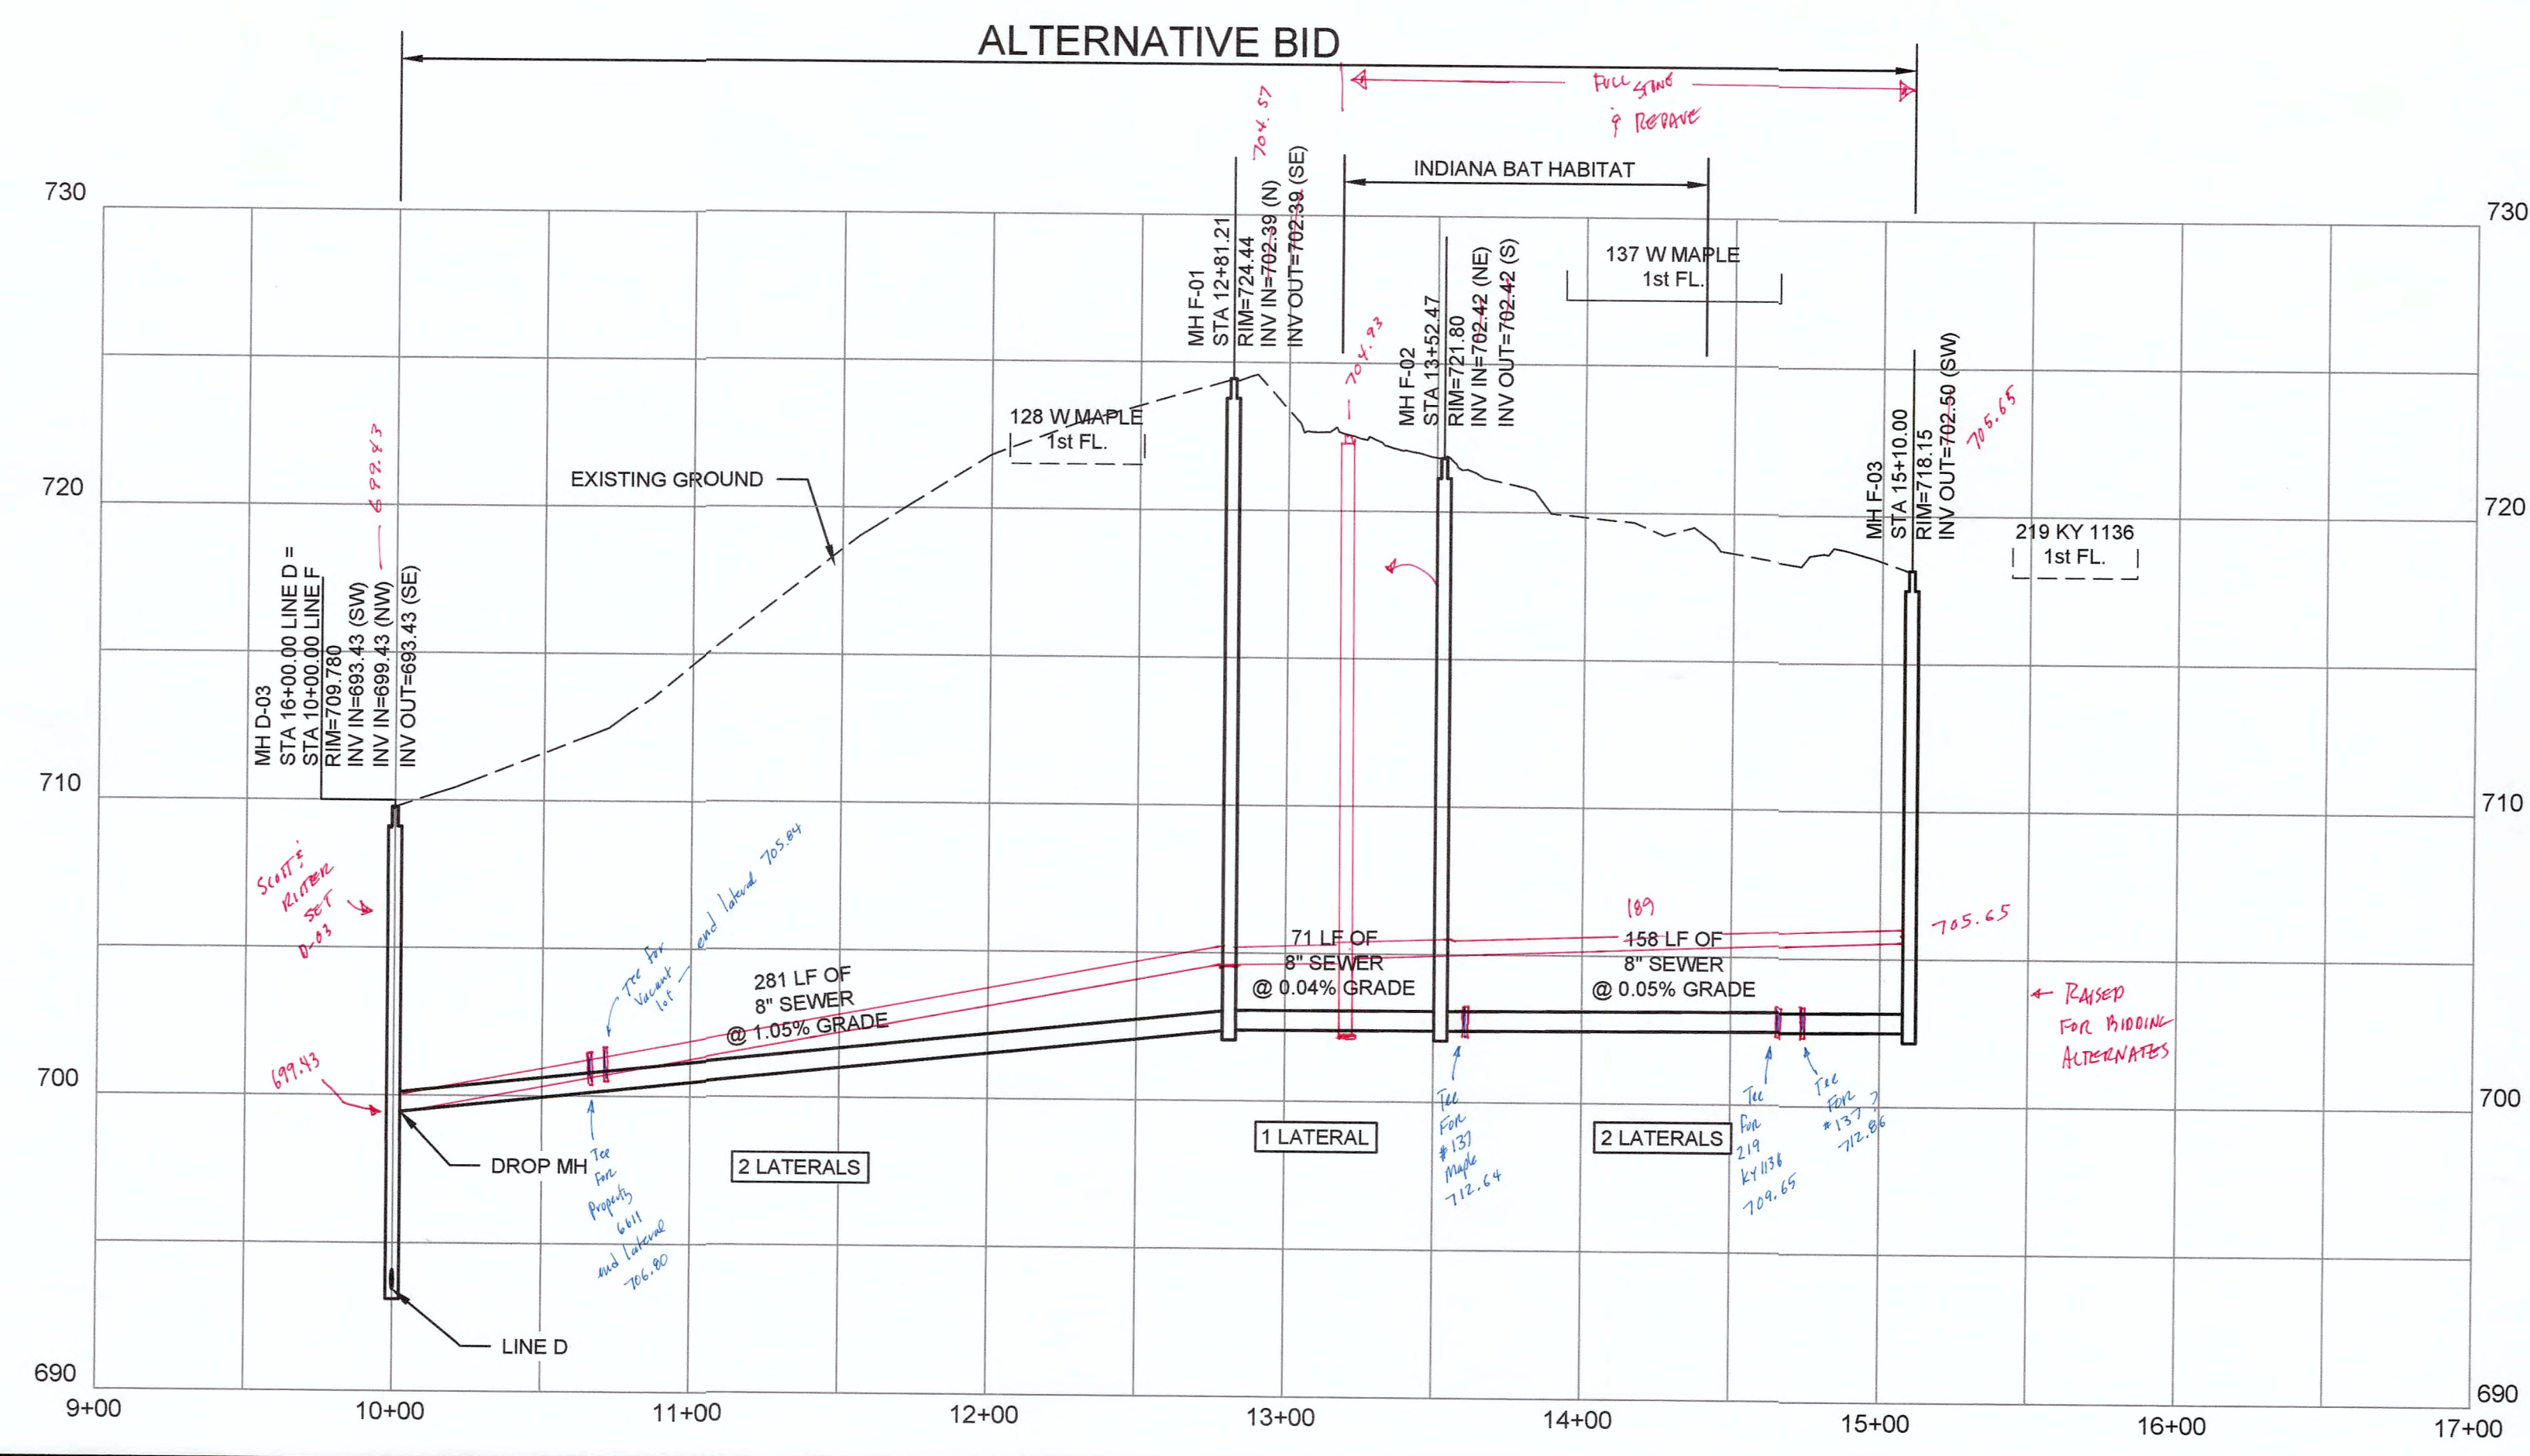


JOB NO.  
5980.020

PROJECT MGR.  
MAS

STRAND ASSOCIATES®

SHEET  
71A



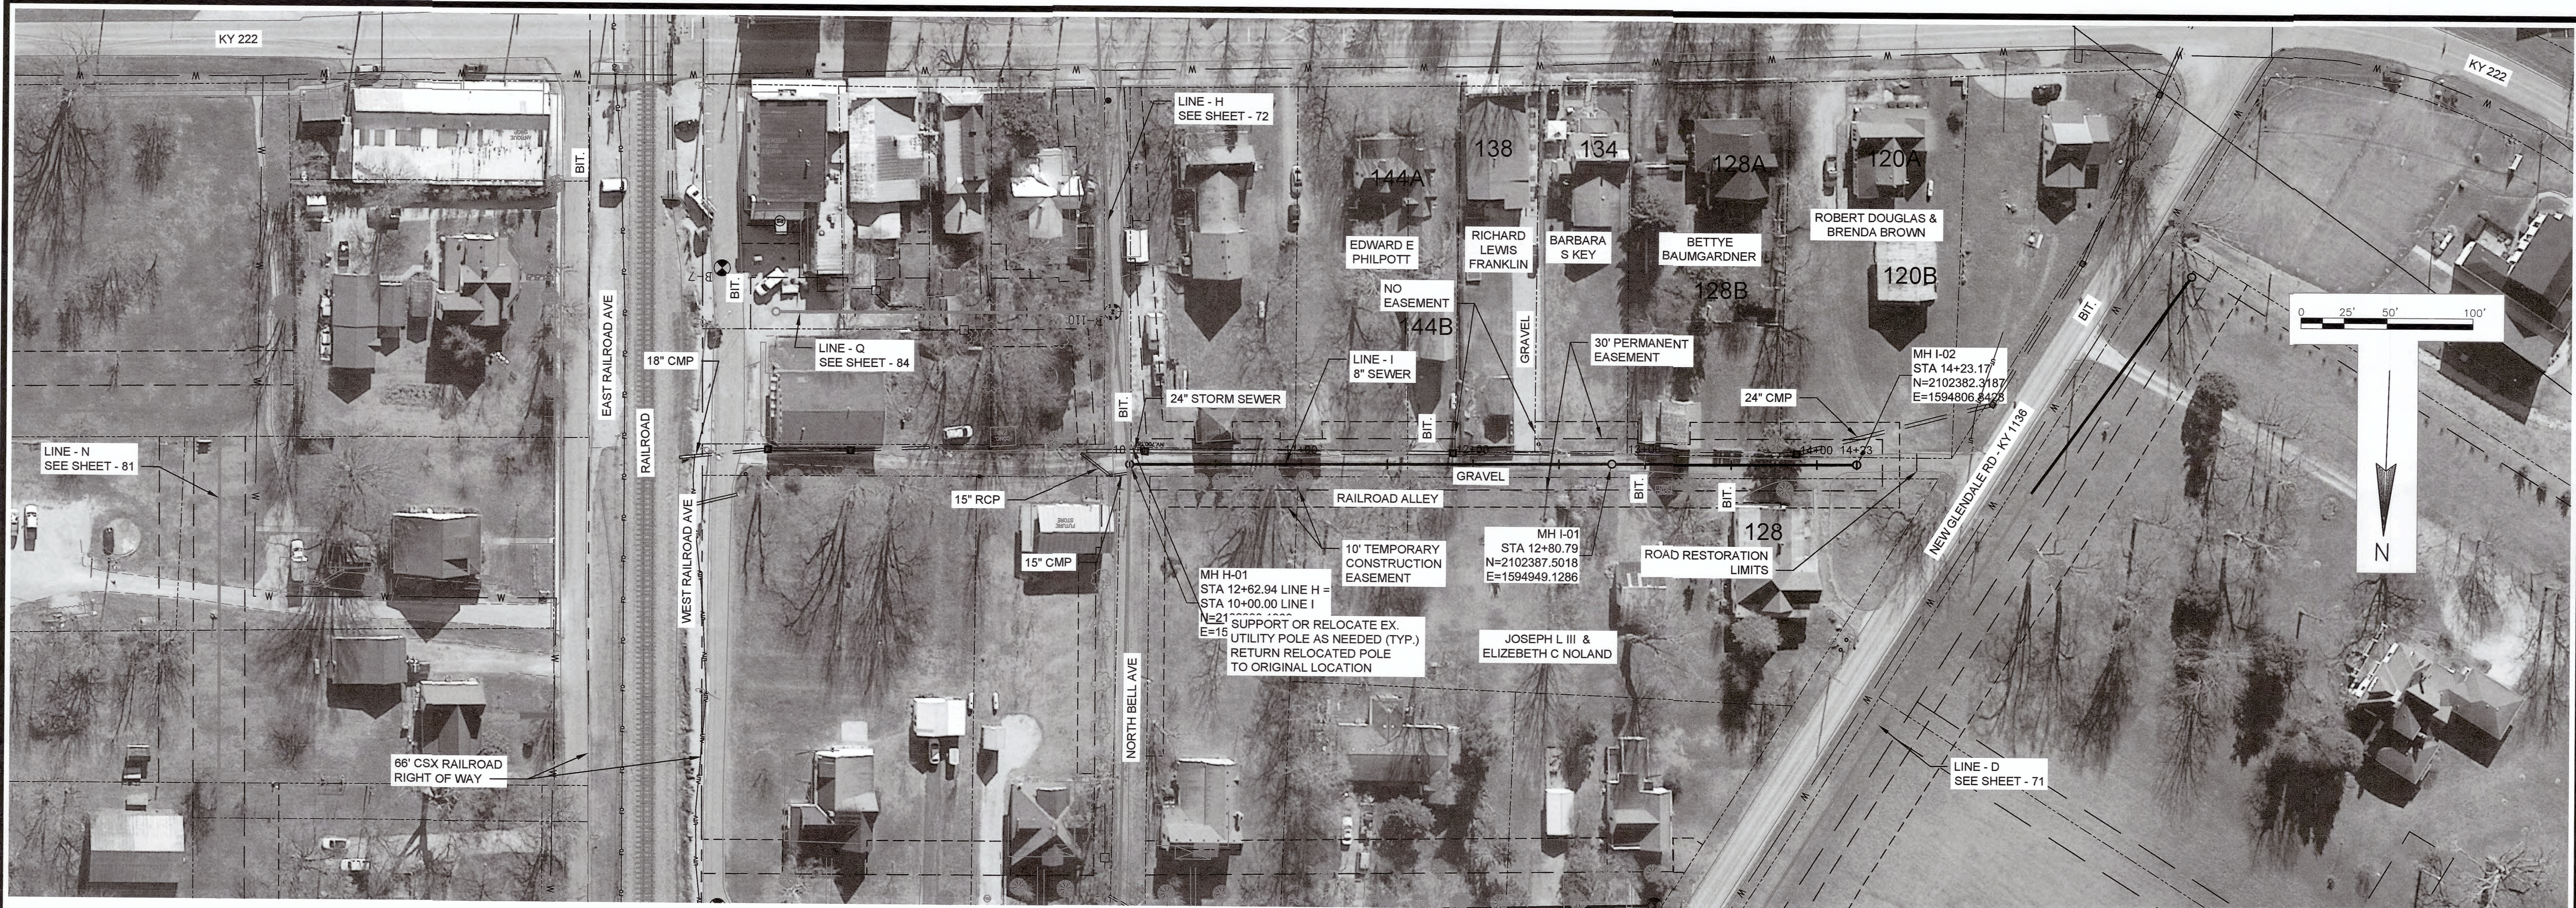

NO.	REVISIONS	DATE

**GRAVITY SEWER PLAN AND PROFILE**  
**LINE I STA. 10+00 TO STA. 14+27.41**  
**CONTRACT 3-2017**


NOLIN RIVER WATERSHED SEWER INFRASTRUCTURE  
 HARDIN COUNTY WATER DISTRICT NO. 2  
 HARDIN COUNTY, KENTUCKY

**JOB NO.**  
5980.020

**PROJECT MGR.**  
MAS



**SHEET**  
74

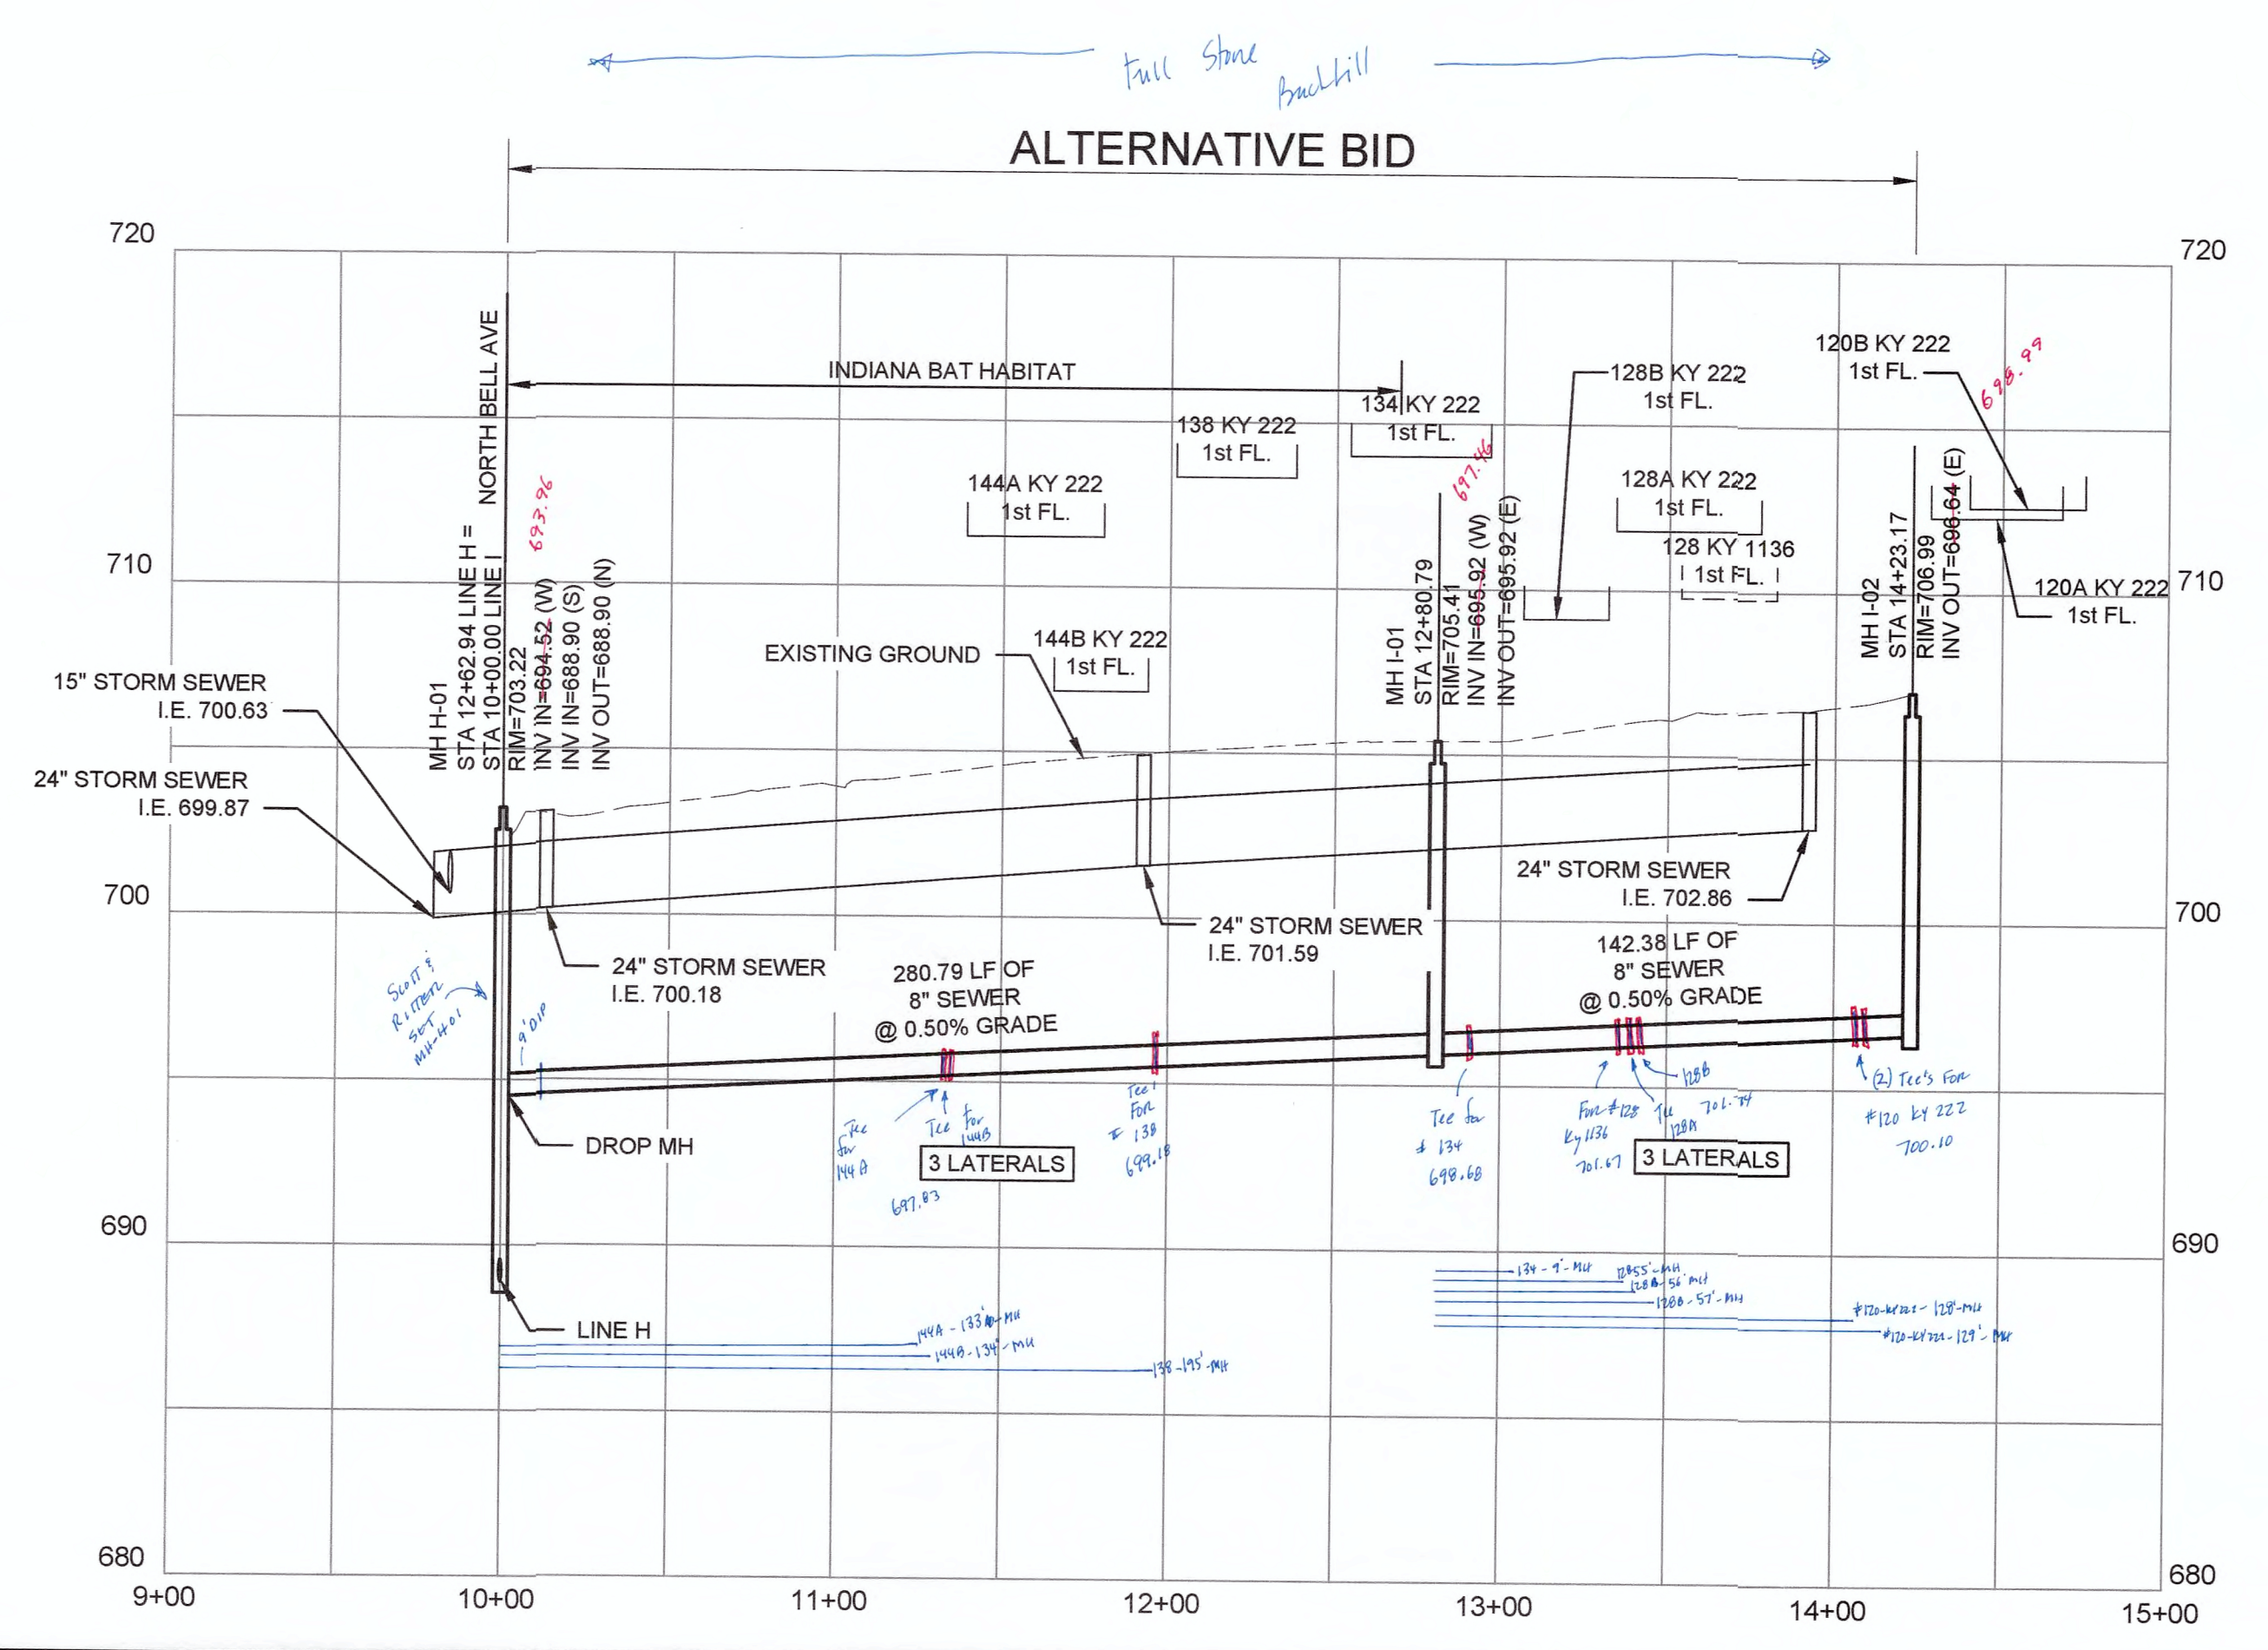

*These are ORIGINAL plans w/changes*

*\* Elevation changes because of change in plans when rebidding Alternative bid*




\* SEE EASEMENT FOR SPECIAL CONSTRUCTION REQUIREMENT ON THIS PROPERTY



DATE:	
REVISIONS	
NO.	

ALTERNATIVE BID

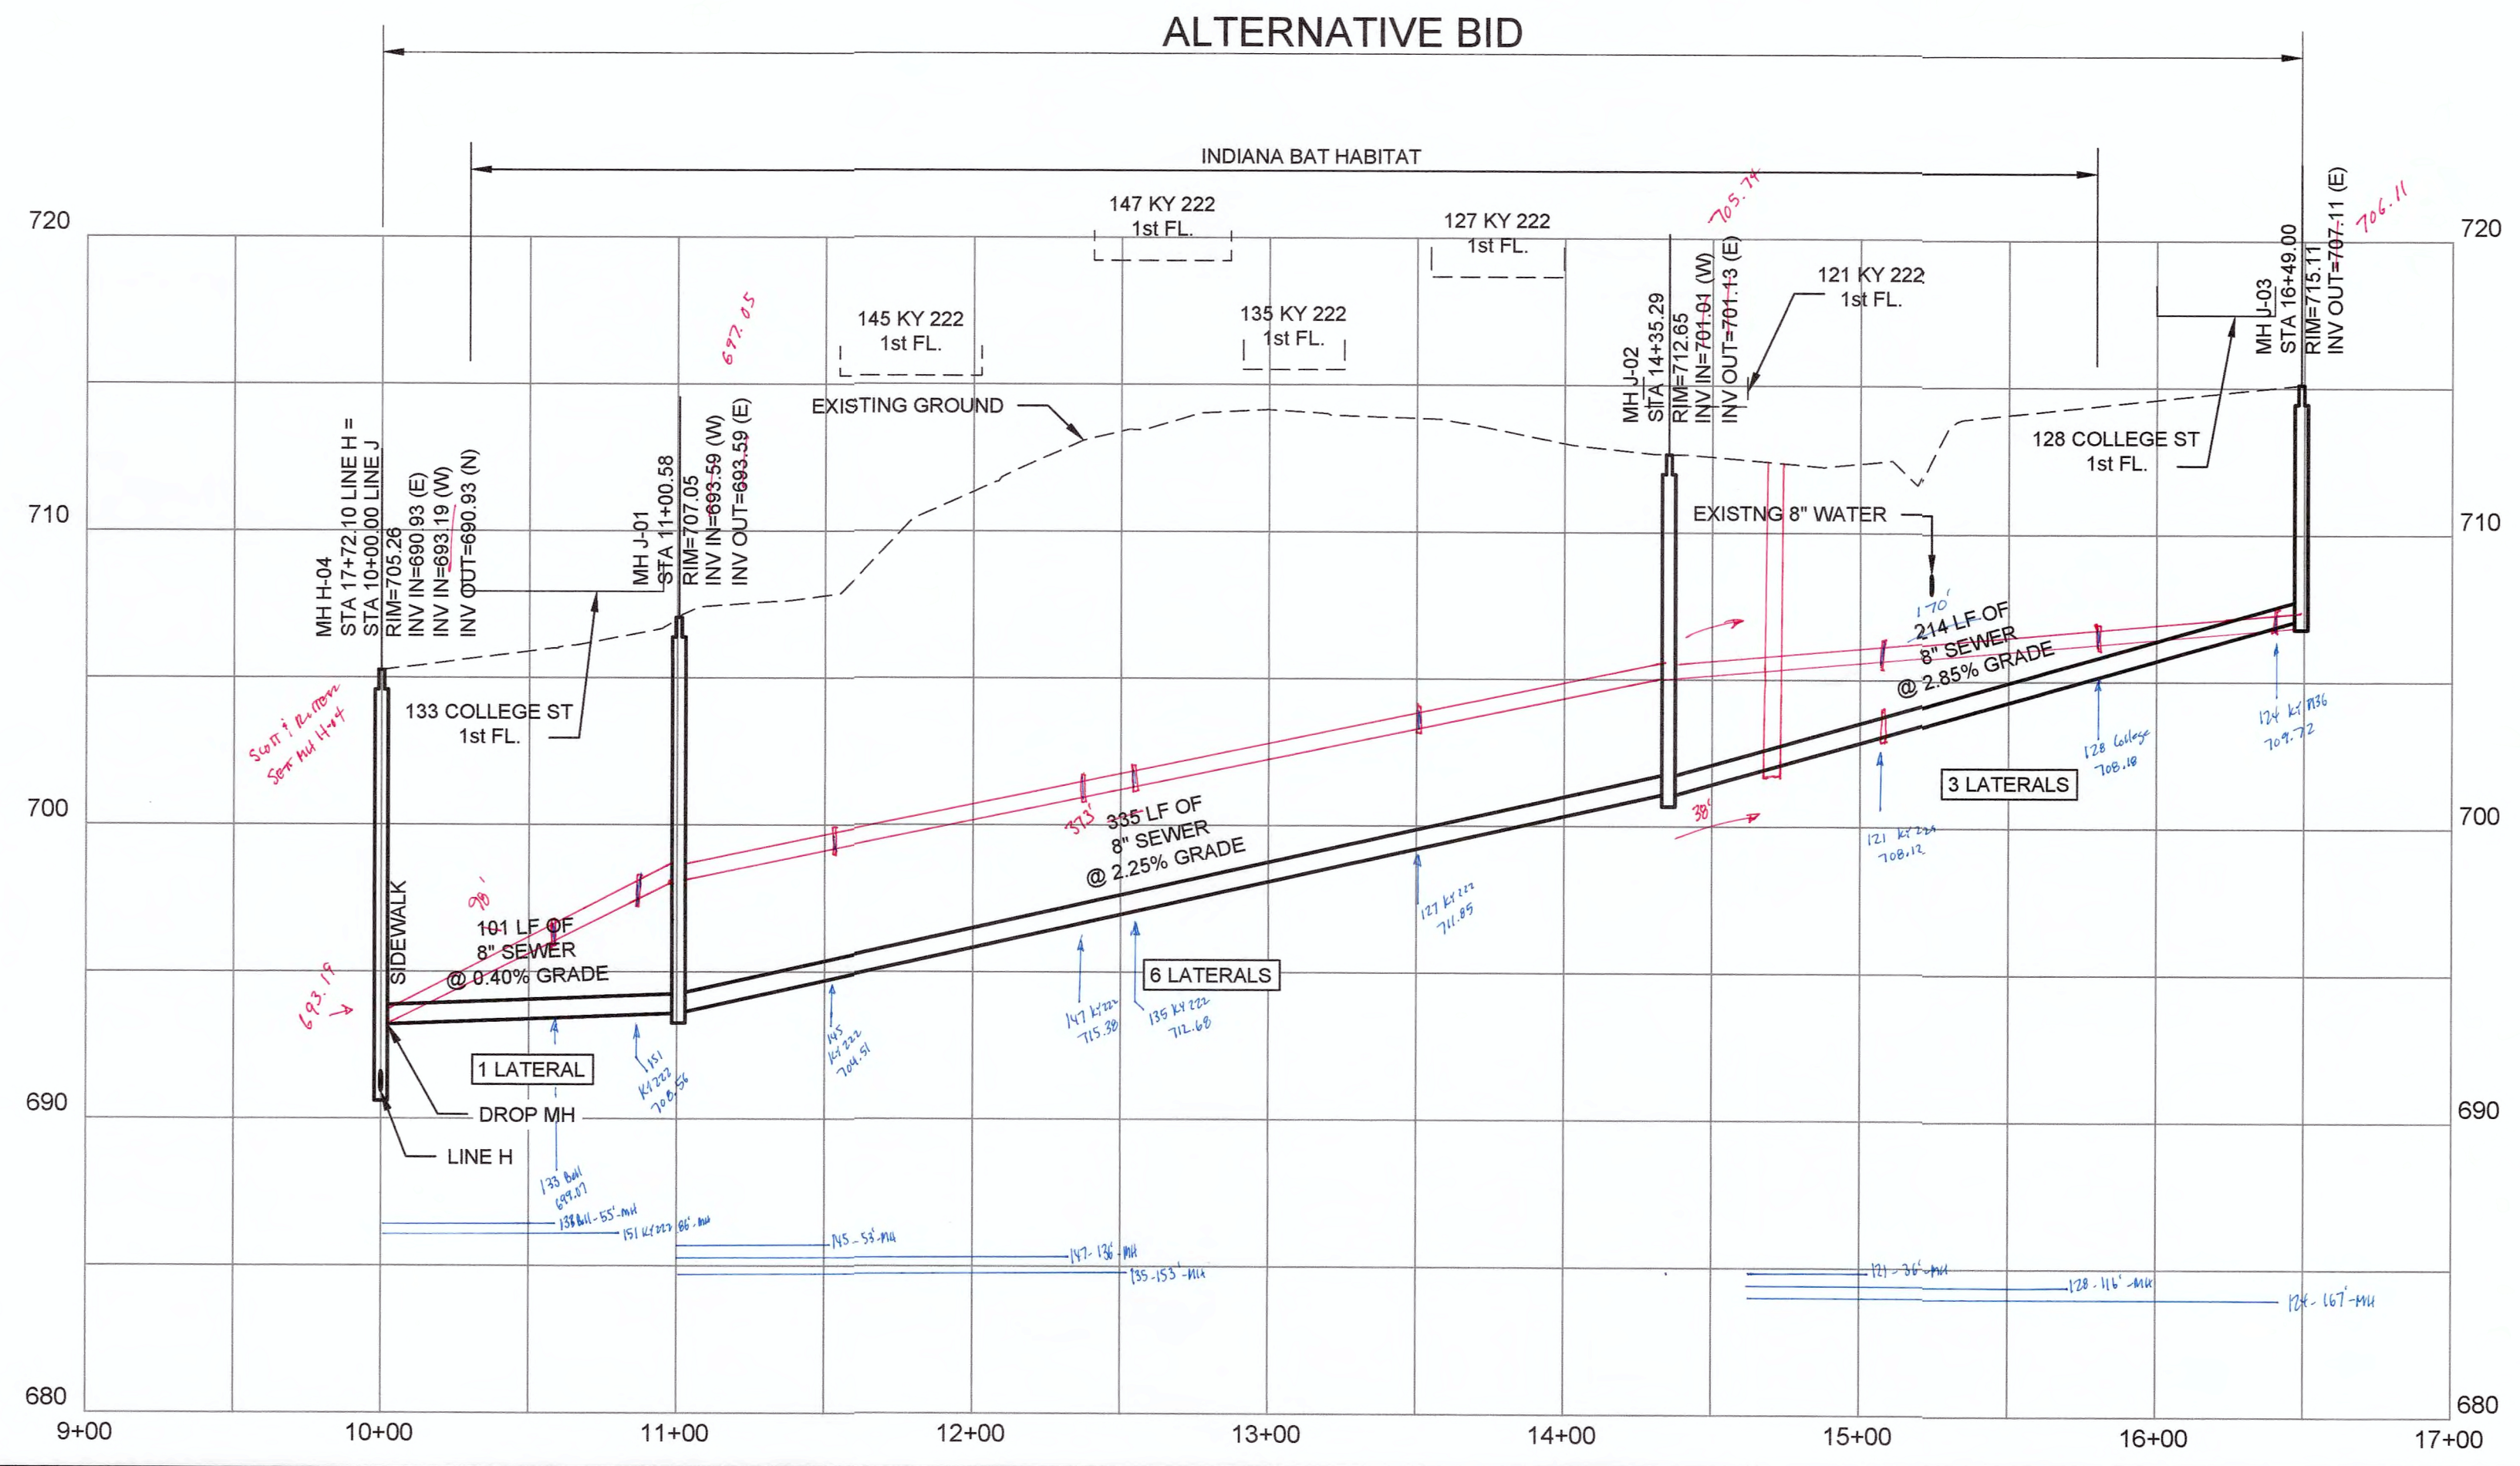

124 KY 1136  
1st FL.

\* THESE ARE ORIGINAL PLANS w/ CHANGES  
\* PLANS WERE CHANGED WHEN REVISIONING ALTERNATE WORK


**GRAVITY SEWER PLAN AND PROFILE**  
**LINE J STA. 10+00 TO STA. 16+49.00**  
**CONTRACT 3-2017**  
 NOLIN RIVER WATERSHED SEWER INFRASTRUCTURE  
 HARDIN COUNTY WATER DISTRICT NO. 2  
 HARDIN COUNTY, KENTUCKY

JOB NO.  
5980.020  
PROJECT MGR.  
MAS



SHEET  
75




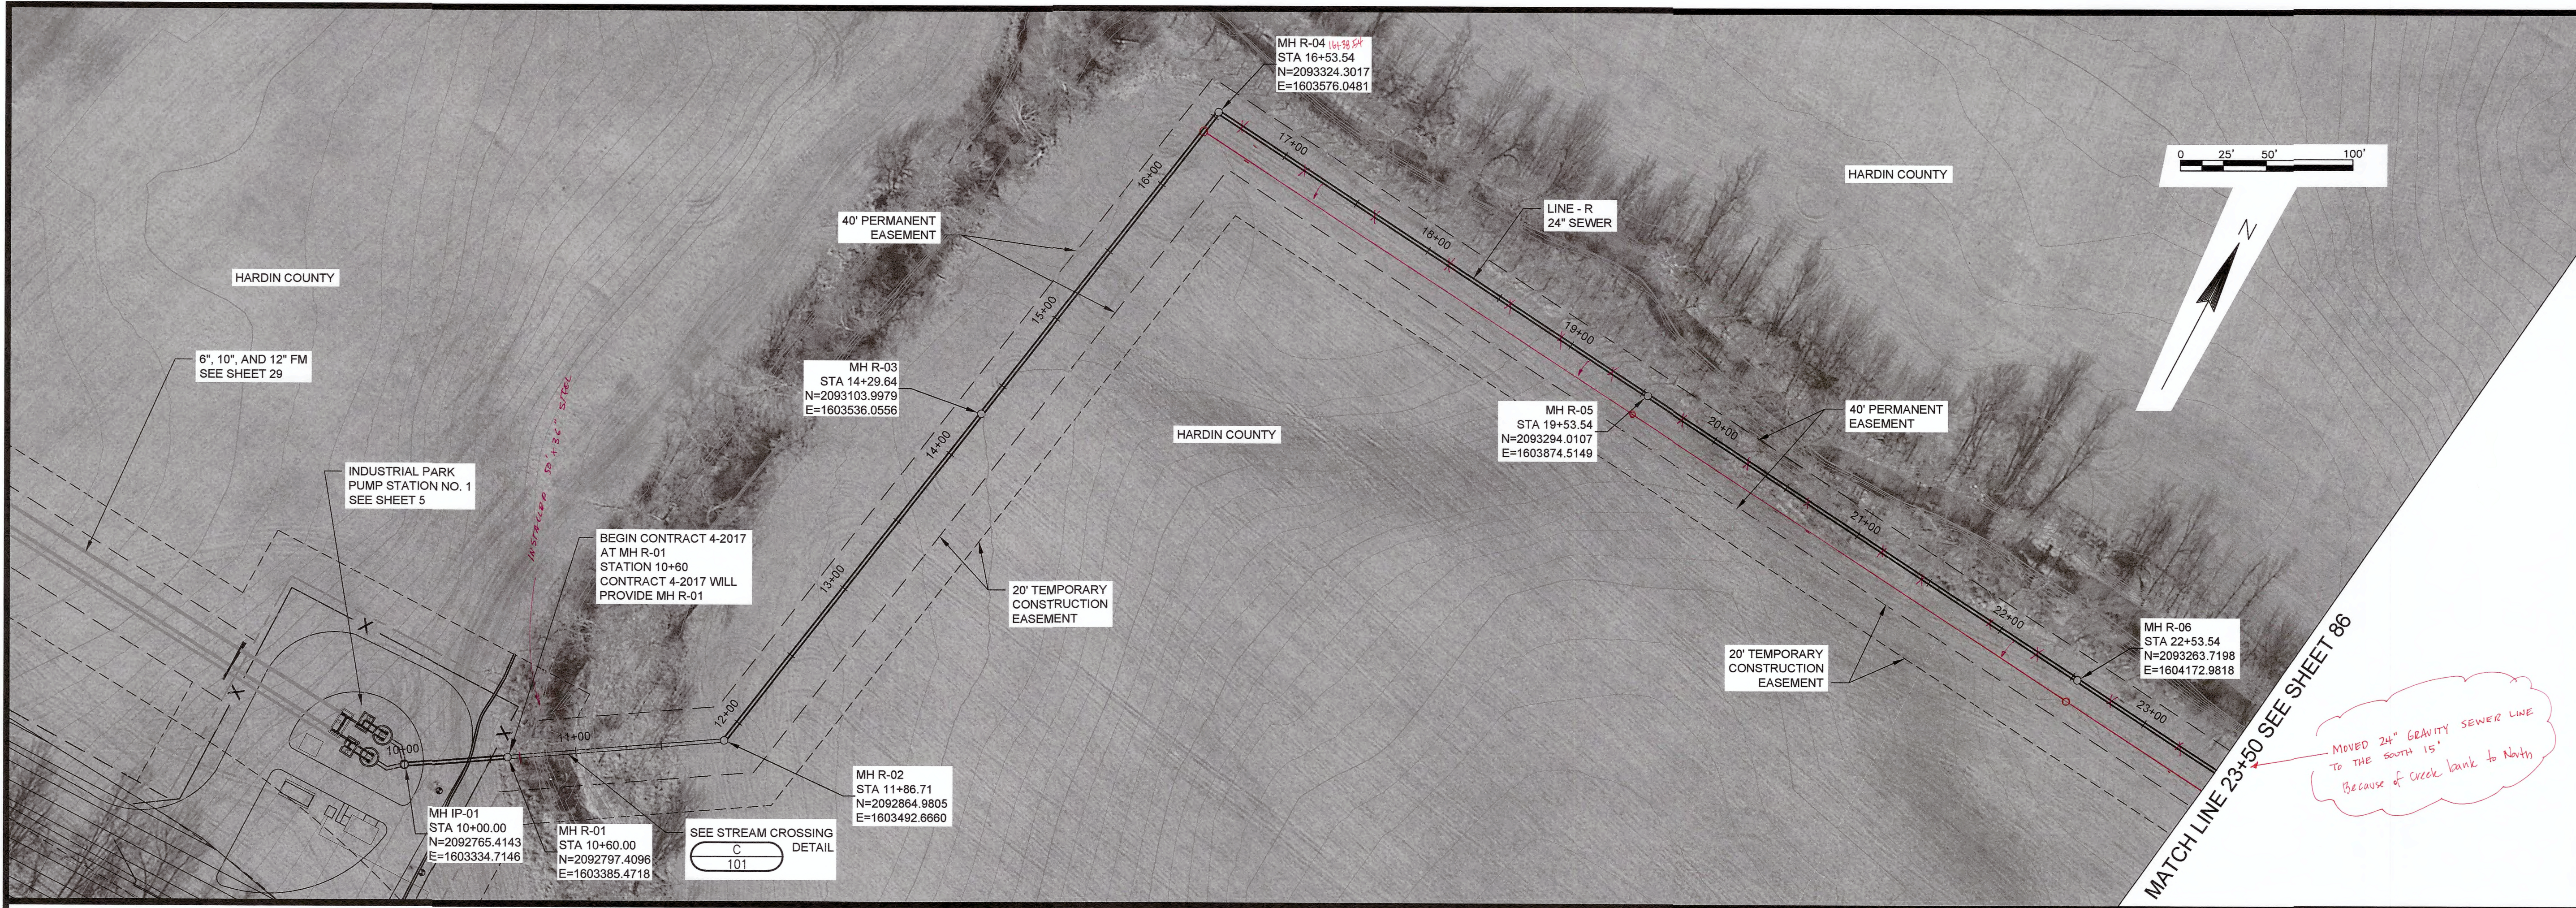

NO.	REVISIONS	DATE

**GRAVITY SEWER PLAN AND PROFILE**  
**LINE R STA. 10+00 TO STA. 23+50**  
**CONTRACT 4-2017**

NOLIN RIVER WATERSHED SEWER INFRASTRUCTURE  
 HARDIN COUNTY WATER DISTRICT NO. 2  
 HARDIN COUNTY, KENTUCKY

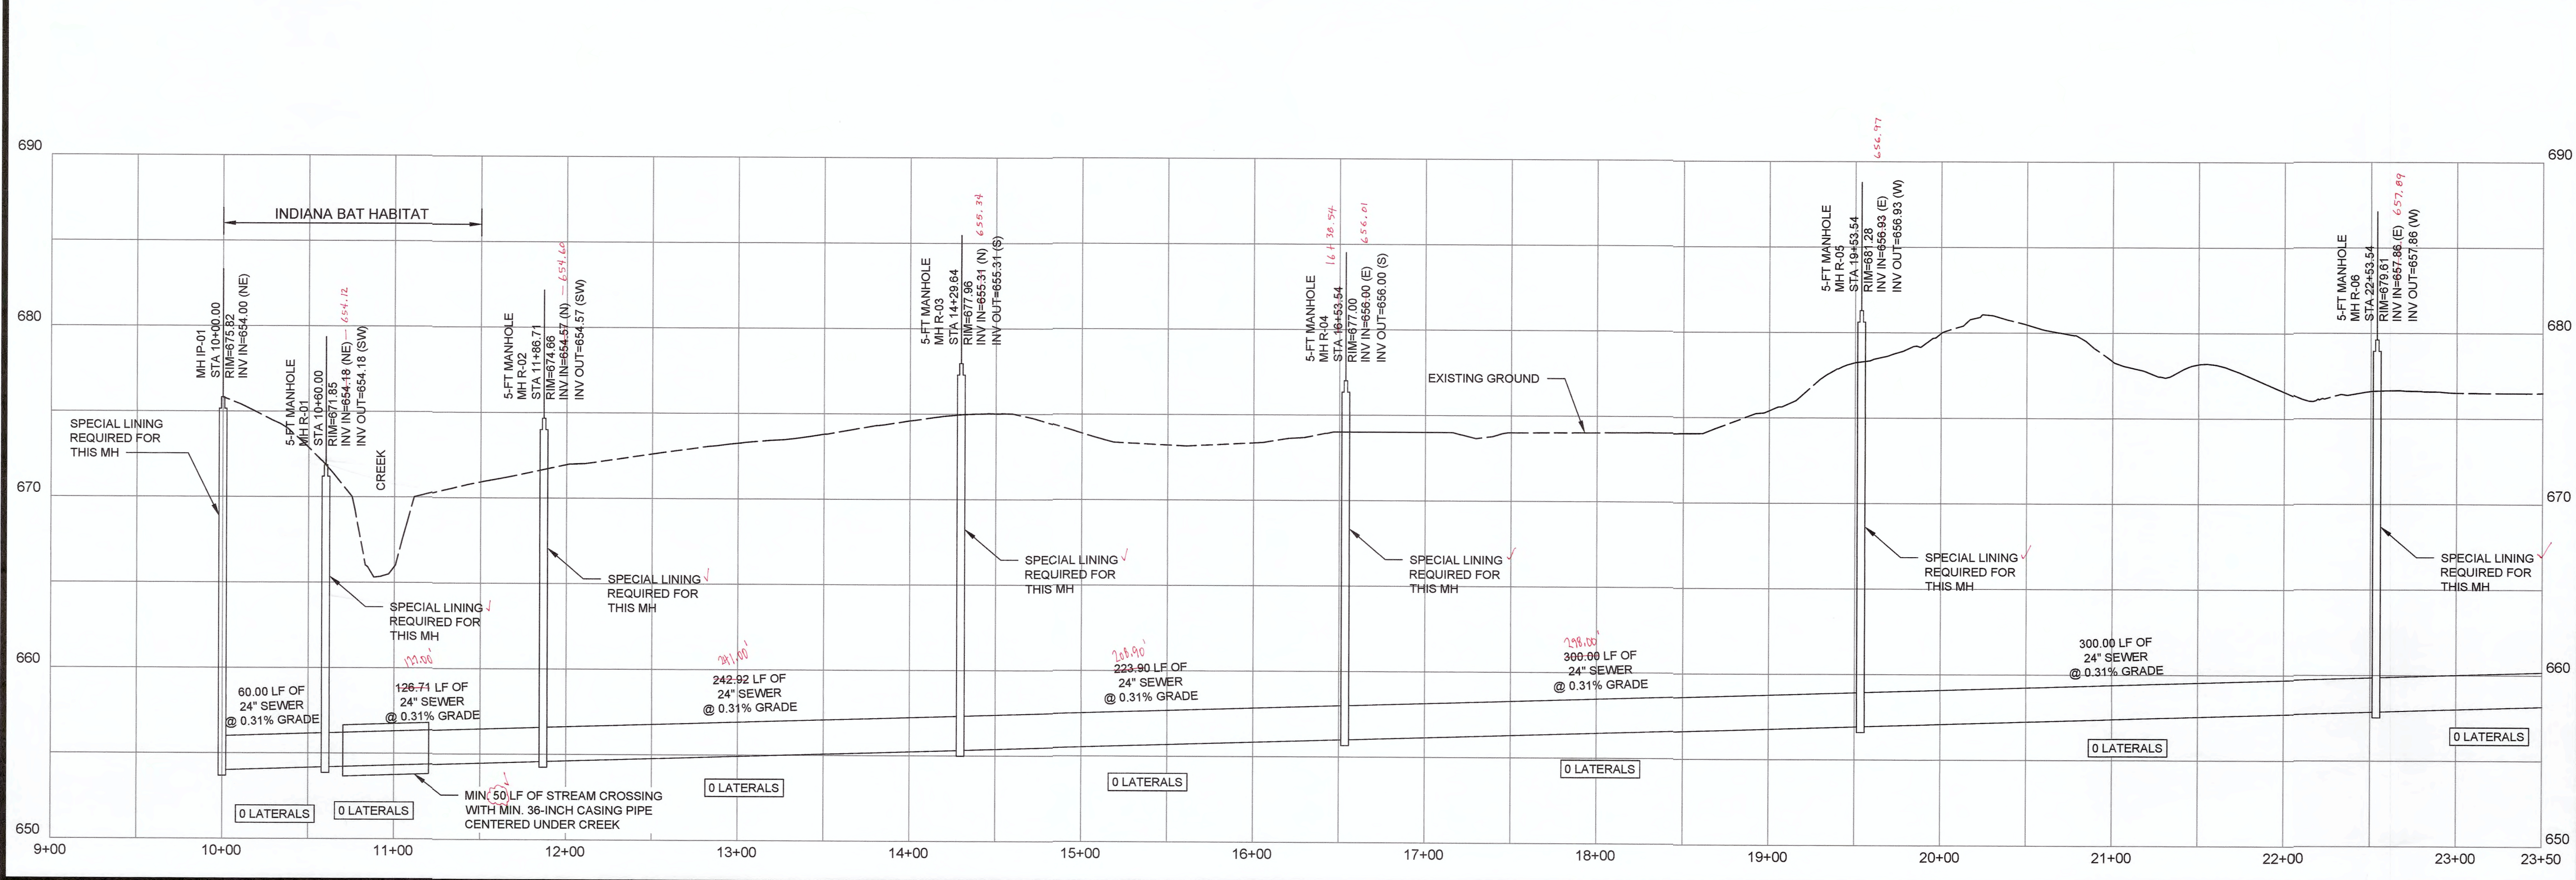

**JOB NO.**  
5980.020

**PROJECT MGR.**  
MAS

**SA STRAND ASSOCIATES**

**SHEET 85**