


CONDUIT AND CABLE	RECEPTACLE	EQUIPMENT	GENERAL NOTES: 1. NOT ALL SYMBOLS AND ABBREVIATIONS SHOWN ON THE DRAWING ARE USED FOR THIS PROJECT.	ABBREVIATIONS CONT'D
<p>EXPOSED CONDUIT OR CABLE VISIBLE</p> <p>EXPOSED CONDUIT OR CABLE HIDDEN</p> <p>CONDUIT BURIED IN FLOOR OR UNDERGROUND</p> <p>DIRECT BURIED CONDUIT OR CABLE</p> <p>FLEXIBLE CONDUIT</p> <p>CONDUIT OR CABLE CONTINUATION</p> <p>CONDUIT OR CABLE TURNING DOWN</p> <p>CONDUIT OR CABLE TURNING UP</p> <p>CONDUIT WITH BUSHING</p> <p>CONDUIT CAPPED FOR FUTURE USE</p> <p>CONDUIT CONTINUATION FROM EXISTING CAPPED STUB</p> <p>CONDUIT TURNED UP AND CAPPED (CAP AT ELEVATION NOTED)</p> <p>CONDUIT DROPPING OUT BOTTOM OF EQUIPMENT</p> <p>COMMUNICATIONS TEE</p> <p>TEE IN HORIZONTAL CONDUIT RUN WITH THE BRANCH GOING HORIZONTAL</p> <p>TEE IN HORIZONTAL CONDUIT RUN WITH THE BRANCH GOING UP (AND PIERCING THE PLANE OF PROJECTION)</p> <p>TEE IN HORIZONTAL CONDUIT RUN WITH THE BRANCH GOING DOWN</p> <p>TEE IN VERTICAL CONDUIT RUN WITH THE BRANCH GOING HORIZONTAL</p> <p>NO CONNECTION</p> <p>NEUTRAL CONNECTION</p> <p>LOOP INDICATES SHIELDED CABLE (SIZE AS REQUIRED)</p> <p>CABLE CHANNEL TURNS DOWN</p> <p>CABLE CHANNEL TURNS UP</p> <p>CONDUIT NUMBER CALLOUT, SEE CABLE SCHEDULE</p>	<p><u>RECEPTACLE AND DEVICE SUFFIXES</u></p> <p>WP WEATHERPROOF</p> <p>EP EXPLOSION-PROOF</p> <p>LT LOCKING TYPE</p> <p>IG ISOLATED GROUND</p> <p>GFI GROUND FAULT INTERRUPTER</p> <p>CLOCK HANGER RECEPTACLE, SINGLE, FLUSH MOUNTED</p> <p>SINGLE RECEPTACLE, FLUSH MOUNTED, STRAIGHT-BLADE</p> <p>SINGLE RECEPTACLE, SURFACE MOUNTED</p> <p>DUPLEX RECEPTACLE, FLUSH MOUNTED, STRAIGHT-BLADE (120V)</p> <p>DUPLEX RECEPTACLE, FLUSH MOUNTED, STRAIGHT-BLADE (240V)</p> <p>DUPLEX RECEPTACLE, SURFACE MOUNTED, STRAIGHT-BLADE</p> <p>FLOOR DUPLEX RECEPTACLE, STRAIGHT-BLADE</p> <p>FLOOR SPECIAL PURPOSE RECEPTACLE, STRAIGHT-BLADE</p> <p>SPECIAL PURPOSE POWER RECEPTACLE, SURFACE MOUNTED, STRAIGHT-BLADE, RATING AS NOTED</p> <p>WELDING RECEPTACLE</p> <p>S SINGLE POLE SWITCH</p> <p>S₃ THREE WAY SWITCH</p> <p>S₄ FOUR WAY SWITCH</p> <p>S_D DIMMER SWITCH</p> <p>S_K SINGLE POLE SWITCH, KEY OPERATED</p> <p>S_P SINGLE POLE SWITCH WITH PILOT LIGHT</p>	<p>TWO WINDING TRANSFORMER</p> <p>AUTO TRANSFORMER</p> <p>POTENTIAL TRANSFORMER</p> <p>LINE TRAP</p> <p>CAPACITOR</p> <p>TRANSFER SWITCH</p> <p>AIR OR VACUUM CIRCUIT BREAKER</p> <p>LIGHTNING OR SURGE ARRESTER</p> <p>GROUND CONNECTION</p> <p>BATTERY</p> <p>EQUIPMENT AS NOTED ON PLANS</p> <p>GUAGEBOARD</p> <p>DISCONNECT SWITCH</p> <p>ELECTRICAL DEVICE</p> <p>THERMOSTAT</p> <p>JUNCTION BOX</p> <p>TERMINAL BOX CONTAINING TERMINAL BLOCKS WITH SUFFICIENT NUMBER OF POLES TO TERMINATE ALL CONDUCTORS ENTERING THE BOX</p> <p>TB</p> <p>GENERATOR</p> <p>SPD SURGE SUPPRESSION DEVICE</p> <p>INDICATING LIGHT (COLOR)</p> <p>A - AMBER</p> <p>BL - BLUE</p> <p>C - CLEAR</p> <p>G - GREEN</p> <p>R - RED</p> <p>W - WHITE</p> <p>Y - YELLOW</p> <p>INDICATING LIGHT (FUNCTIONS)</p> <p>L - LINE POTENTIAL</p> <p>S - SYNCHRONIZING</p> <p>SO - SCOPE ON</p> <p>T - TRIP INDICATION</p> <p>T&S - TRIP & SUPER-VISING (TWO LIGHTS)</p> <p>COIL DESIGNATIONS</p> <p>M - MOTOR STARTER</p> <p>TDR - TIME DELAY RELAY</p> <p>C - CONTACTOR</p> <p>CR - CONTROL RELAY</p> <p>MX - MOTOR STARTER AUX RELAY (USUALLY PICKS UP THE "M" COIL)</p> <p>F - FORWARD OR FAST</p> <p>R - REVERSE</p> <p>S - SLOW</p> <p>CONTROL STATION</p> <p>X - TYPE/DESIGNATION:</p> <p>A - HAND/OFF/AUTO</p> <p>B - H/O/A WITH START</p> <p>C - REMOTE STOP</p> <p>D - START/STOP</p> <p>E - AUTO/ON</p> <p>F - JOG/OFF/AUTO</p> <p>G - J/O/A WITH START</p> <p>P - PHOTOCELL</p> <p>V - VIBRATION SWITCH</p> <p>DCS INTERFACE SYMBOL W/ SCHEMATIC REFERENCE DRAWING NUMBER</p> <p>XXX</p>	<p><u>CABLE CONDUCTOR COLOR CODING</u></p> <p>BK - BLACK</p> <p>RD - RED</p> <p>BL - BLUE</p> <p>OR - ORANGE</p> <p>YL - YELLOW</p> <p>BR - BROWN</p> <p>WH - WHITE</p> <p>GN - GREEN</p> <p>RD/BK - RED/BLACK</p> <p>BL/BK - BLUE/BLACK</p> <p>OR/BK - ORANGE/BLACK</p> <p>YL/BK - YELLOW/BLACK</p> <p>BR/BK - BROWN/BLACK</p> <p>BK/RD - BLACK/RED</p>	<p>M METER</p> <p>MAN MANUAL</p> <p>MISC MISCELLANEOUS</p> <p>MTR MOTOR</p> <p>NC NORMALLY CLOSED</p> <p>NEC NATIONAL ELECTRICAL CODE</p> <p>NEUT NEUTRAL</p> <p>NO NORMALLY OPEN</p> <p>NTS NOT TO SCALE</p> <p>Ω OHMMETER</p> <p>O/H (OR) OH OVERHEAD</p> <p>OL OVERLOAD</p> <p>OP OPERATING</p> <p>P POLE</p> <p>PC PHOTOCCELL</p> <p>P.F. (OR) PF POWER FACTOR</p> <p>PH (OR) ∅ PHASE</p> <p>PNL PANEL</p> <p>POT POTENTIOMETER</p> <p>PP POWER PANEL</p> <p>PS PRESSURE SWITCH</p> <p>PT POTENTIAL TRANSFORMER</p> <p>PVC POLYVINYL CHLORIDE</p> <p>PWR POWER</p> <p>R (OR) REV REVERSE</p> <p>RCT RECTIFIER</p> <p>RCPT RECEPTACLE</p> <p>REF REFERENCE</p> <p>REF DWG # REFERENCE DRAWING NUMBER (AS INDICATED)</p> <p>REQD REQUIRED</p> <p>RES RESISTOR</p> <p>RGS RIGID GALVANIZED STEEL</p> <p>RMC RIGID METALLIC CONDUIT</p> <p>RTD RESISTANCE TEMPERATURE DETECTOR</p> <p>SHLD SHIELDED</p> <p>SH (OR) SHT SHEET</p> <p>SP SPARE</p> <p>STA STATION</p> <p>STR STARTER</p> <p>SW SWITCH</p> <p>SWBD SWITCHBOARD</p> <p>SWGR SWITCHGEAR</p> <p>TB TERMINAL BLOCK</p> <p>TBD TERMINAL BOARD</p> <p>TBX TERMINAL BOX</p> <p>TDR TIME DELAY RELAY</p> <p>TEL TELEPHONE</p> <p>T.O.C. (OR) TOC TOP OF CONCRETE</p> <p>T.O.D. (OR) TOD TOP OF DUCT</p> <p>T.O.G. (OR) TOG TOP OF GRATING</p> <p>T.O.S. (OR) TOS TOP OF STEEL</p> <p>TSP TWISTED SHIELDED PAIR</p> <p>TYP TYPICAL</p> <p>U/G (OR) UG UNDERGROUND</p> <p>UPS UNINTERRUPTIBLE POWER SUPPLY</p> <p>UV UNDERVOLTAGE</p> <p>V VOLTS (OR) VOLTAGE</p> <p>VFD VARIABLE FREQUENCY DRIVE</p> <p>VS VOLT METER SWITCH</p> <p>W WATT or WIRE</p> <p>WP WEATHERPROOF</p> <p>WR WELDING RECEPTACLE</p> <p>XDCR TRANSDUCER</p> <p>XE MISC. ELECTRICAL EQUIPMENT</p> <p>XF POWER TRANSFORMER</p> <p>XFER TRANSFER</p> <p>XFMR TRANSFORMER</p> <p>XMTR TRANSMITTER</p>
<p><u>LINE SYMBOLS</u></p>	<p><u>LIGHTING</u></p>		<p><u>ABBREVIATIONS</u></p>	
<p>POWER CIRCUIT LINE</p> <p>MCC BUS, PANEL BUS, FEEDER BUS, LOAD CENTER OR SWGR BRANCH CIRCUIT</p> <p>POWER PANEL AND MCC BRANCH CIRCUITS, METERING OR RELAY LINE</p> <p>EQUIPMENT ENCLOSURE LINE</p> <p>SWITCHGEAR, MCC'S, TRANSFORMERS AND POWER PANELS</p> <p>OPERATION LINE (WITH DIRECTION OF OPERATION)</p> <p>FUTURE EQUIPMENT OR CIRCUIT</p> <p>CONTINUATION</p>	<p>BATTERY OPERATED EMERGENCY LIGHT LUMINAIRE</p> <p>EXIT LUMINAIRE</p> <p>FLOODLIGHT LUMINAIRE (AIMED)</p> <p>STREET LIGHTING LUMINAIRE, MAST ARM AND STEEL OR ALUMINUM POLE</p> <p>STREET LIGHTING LUMINAIRE, MAST ARM AND WOOD POLE</p> <p>NORMAL EMERGENCY</p> <p>STRIP LUMINAIRE</p> <p>CEILING MOUNT LUMINAIRE</p> <p>PENDANT MOUNT LUMINAIRE</p> <p>STANCHION MOUNT LUMINAIRE</p> <p>WALL MOUNT LUMINAIRE</p> <p>LIGHTING CONTACTOR</p> <p>PHOTOELECTRIC CONTROL CELL</p>			
<p><u>GROUNDING</u></p> <p>GROUND CABLE BURIED</p> <p>GROUND CABLE EXPOSED</p> <p>GROUND ROD</p> <p>TEST WELL IN ACCESSIBLE BOX WITH COVER</p> <p>GROUND CONDUCTOR TURNING UP</p> <p>GROUND CONDUCTOR TURNING DOWN</p> <p>EXOTHERMIC CONNECTION</p> <p>EQUIPMENT, DEVICE, STRUCTURAL, SUPPORT CONNECTION</p> <p>GROUND CONDUCTOR PIGTAIL FOR ABOVE GRADE AND FINISHED CONCRETE CONNECTION TO EQUIPMENT AND FUTURE CONNECTION</p> <p>10 FT</p> <p>AIR TERMINAL (LIGHTNING ROD) CONNECTED TO GROUND CABLE</p> <p>GROUND CABLE CONTINUATION</p> <p>GROUND BAR</p>				

<p>BURNS & MCDONNELL STATE LICENSE #43</p> <p>YEVGENIY KHISLAVSKIY 04/17/2020 KENTUCKY SEAL 34514</p> <p>PROFESSIONAL ENGR/ARCH STAMP</p>	<p style="text-align: center;">PIEDMONT 'S NATURAL GAS FACILITY DRAWINGS ARE CONSIDERED CONFIDENTIAL (OM-1095) * DRAWING IS CURRENT ONLY THROUGH THE LATEST REVISED DATE * TO ENSURE THERE IS NO RISK OF INAPPROPRIATE DISCLOSURE ALL PREVIOUS PAPER COPIES OF THIS DRAWING MUST BE DESTROYED IN ACCORDANCE WITH RECORDS & INFO. MANAGEMENT (RIM) POLICY 1001</p>					<p>REF. DWG(S)</p>																																																						
<table border="1"> <thead> <tr> <th>NO.</th> <th>DATE</th> <th>REVISION(S) DESCRIPTION</th> <th>BY</th> <th>CHK</th> <th>APPD</th> <th>DESCRIPTION</th> <th>APPROVALS</th> </tr> </thead> <tbody> <tr> <td>0</td> <td>02-19-2021</td> <td>ISSUED FOR AS-BUILT</td> <td>MCR</td> <td>KM</td> <td>AHD</td> <td>AREA CODE</td> <td>DATE: N/A INITIALS: N/A REGIONAL ENGINEER</td> </tr> <tr> <td></td> <td></td> <td></td> <td></td> <td></td> <td></td> <td>ACCOUNT NUMBER</td> <td>DATE: N/A INITIALS: N/A MGR TECH REC & STD</td> </tr> <tr> <td></td> <td></td> <td></td> <td></td> <td></td> <td></td> <td>PROJECT NUMBER</td> <td>DATE: N/A INITIALS: N/A KILOVOLT</td> </tr> <tr> <td></td> <td></td> <td></td> <td></td> <td></td> <td></td> <td>DRAWING BY</td> <td>DATE: 04-17-2020 INITIALS: YBK PRINCIPAL ENGINEER</td> </tr> <tr> <td></td> <td></td> <td></td> <td></td> <td></td> <td></td> <td>STATION ID</td> <td></td> </tr> <tr> <td></td> <td></td> <td></td> <td></td> <td></td> <td></td> <td>CHECKER INITIALS</td> <td></td> </tr> </tbody> </table>	NO.	DATE	REVISION(S) DESCRIPTION	BY	CHK	APPD	DESCRIPTION	APPROVALS	0	02-19-2021	ISSUED FOR AS-BUILT	MCR	KM	AHD	AREA CODE	DATE: N/A INITIALS: N/A REGIONAL ENGINEER							ACCOUNT NUMBER	DATE: N/A INITIALS: N/A MGR TECH REC & STD							PROJECT NUMBER	DATE: N/A INITIALS: N/A KILOVOLT							DRAWING BY	DATE: 04-17-2020 INITIALS: YBK PRINCIPAL ENGINEER							STATION ID								CHECKER INITIALS		<p>DATE: 04-17-2020</p> <p>INITIALS: YBK</p>	<p>DATE: N/A</p> <p>INITIALS: N/A</p>	<p>DATE: N/A</p> <p>INITIALS: N/A</p>	<p>DATE: N/A</p> <p>INITIALS: N/A</p>
NO.	DATE	REVISION(S) DESCRIPTION	BY	CHK	APPD	DESCRIPTION	APPROVALS																																																					
0	02-19-2021	ISSUED FOR AS-BUILT	MCR	KM	AHD	AREA CODE	DATE: N/A INITIALS: N/A REGIONAL ENGINEER																																																					
						ACCOUNT NUMBER	DATE: N/A INITIALS: N/A MGR TECH REC & STD																																																					
						PROJECT NUMBER	DATE: N/A INITIALS: N/A KILOVOLT																																																					
						DRAWING BY	DATE: 04-17-2020 INITIALS: YBK PRINCIPAL ENGINEER																																																					
						STATION ID																																																						
						CHECKER INITIALS																																																						
	<p style="text-align: center;">UL60 PROJECTS ELECTRICAL LEGEND BOONE COUNTY, KY ERLANGER, KY</p>					<table border="1"> <tr> <td>SHEET(S)</td> <td>1 OF 1</td> <td>DWG SCALE</td> <td>NONE</td> </tr> <tr> <td>DWG DATE</td> <td>07/09/2019</td> <td>SUPERSEDED</td> <td></td> </tr> <tr> <td colspan="2">DRAWING NUMBER</td> <td colspan="2">REVISION</td> </tr> <tr> <td colspan="2">PNG - E-043-0001076</td> <td colspan="2">0</td> </tr> <tr> <td colspan="4">DISCIPLINE / RESOURCE CENTER / LINE NUMBER</td> </tr> </table>	SHEET(S)	1 OF 1	DWG SCALE	NONE	DWG DATE	07/09/2019	SUPERSEDED		DRAWING NUMBER		REVISION		PNG - E-043-0001076		0		DISCIPLINE / RESOURCE CENTER / LINE NUMBER																																					
SHEET(S)	1 OF 1	DWG SCALE	NONE																																																									
DWG DATE	07/09/2019	SUPERSEDED																																																										
DRAWING NUMBER		REVISION																																																										
PNG - E-043-0001076		0																																																										
DISCIPLINE / RESOURCE CENTER / LINE NUMBER																																																												

PANELBOARD NAME:	LP-1 AC POWER PANEL	10,000 RMS SYMMETRICAL A.I.C.	60 AMP TRIP MAIN BREAKER
PANELBOARD TYPE:	MAIN CIRCUIT BREAKER	SURFACE MOUNTED, NEMA 12 ENCLOSURE	100 AMP MAINS
PANEL LOCATION:	RTU BUILDING	120/240 VOLTS, 1 PHASE, 3 WIRE, 60 Hz	
SUPPLIED FROM:	TO BE DETERMINED		

CKT NO.	TRIP AMPS	NO. POLES	WIRE / GND / COND	LOAD SERVED	LOAD VA	Ø	LOAD VA	LOAD SERVED	WIRE / GND / COND	NO. POLES	TRIP AMPS	CKT NO.
1	20	1		LIGHTS 1-2, RTU BLDG	300	A	300	FLOOD LIGHT, RTU BLDG		1	20	2
3	20	1		OUTLET 1-2, RTU BLDG	720	B	720	OUTLET 3-4, RTU BLDG		1	20	4
5	20	1		OUTLET 5-6, RTU BLDG	720	A		SPARE		1	20	6
7	20	2		HVAC	1000	B		SPARE		1	20	8
					1000	A		SPARE		1	20	10
11	20	1		SPARE		B		SPARE		1	20	12
13	20	1		SPARE		A		SPARE		1	20	14
15	20	1		SPARE		B		SPARE		1	20	16

TOTAL CONNECTED LOAD = 5.4 kVA X 100% DEMAND FACTOR = 5.4 kVA ESTIMATED DEMAND LOAD
 PHASE BALANCE (KVA) - A: 2.9 , B: 2.4 DESIGN LOAD = 22 AMPERES, TOTAL LOAD WITH EXPANSION = 34 AMPERES

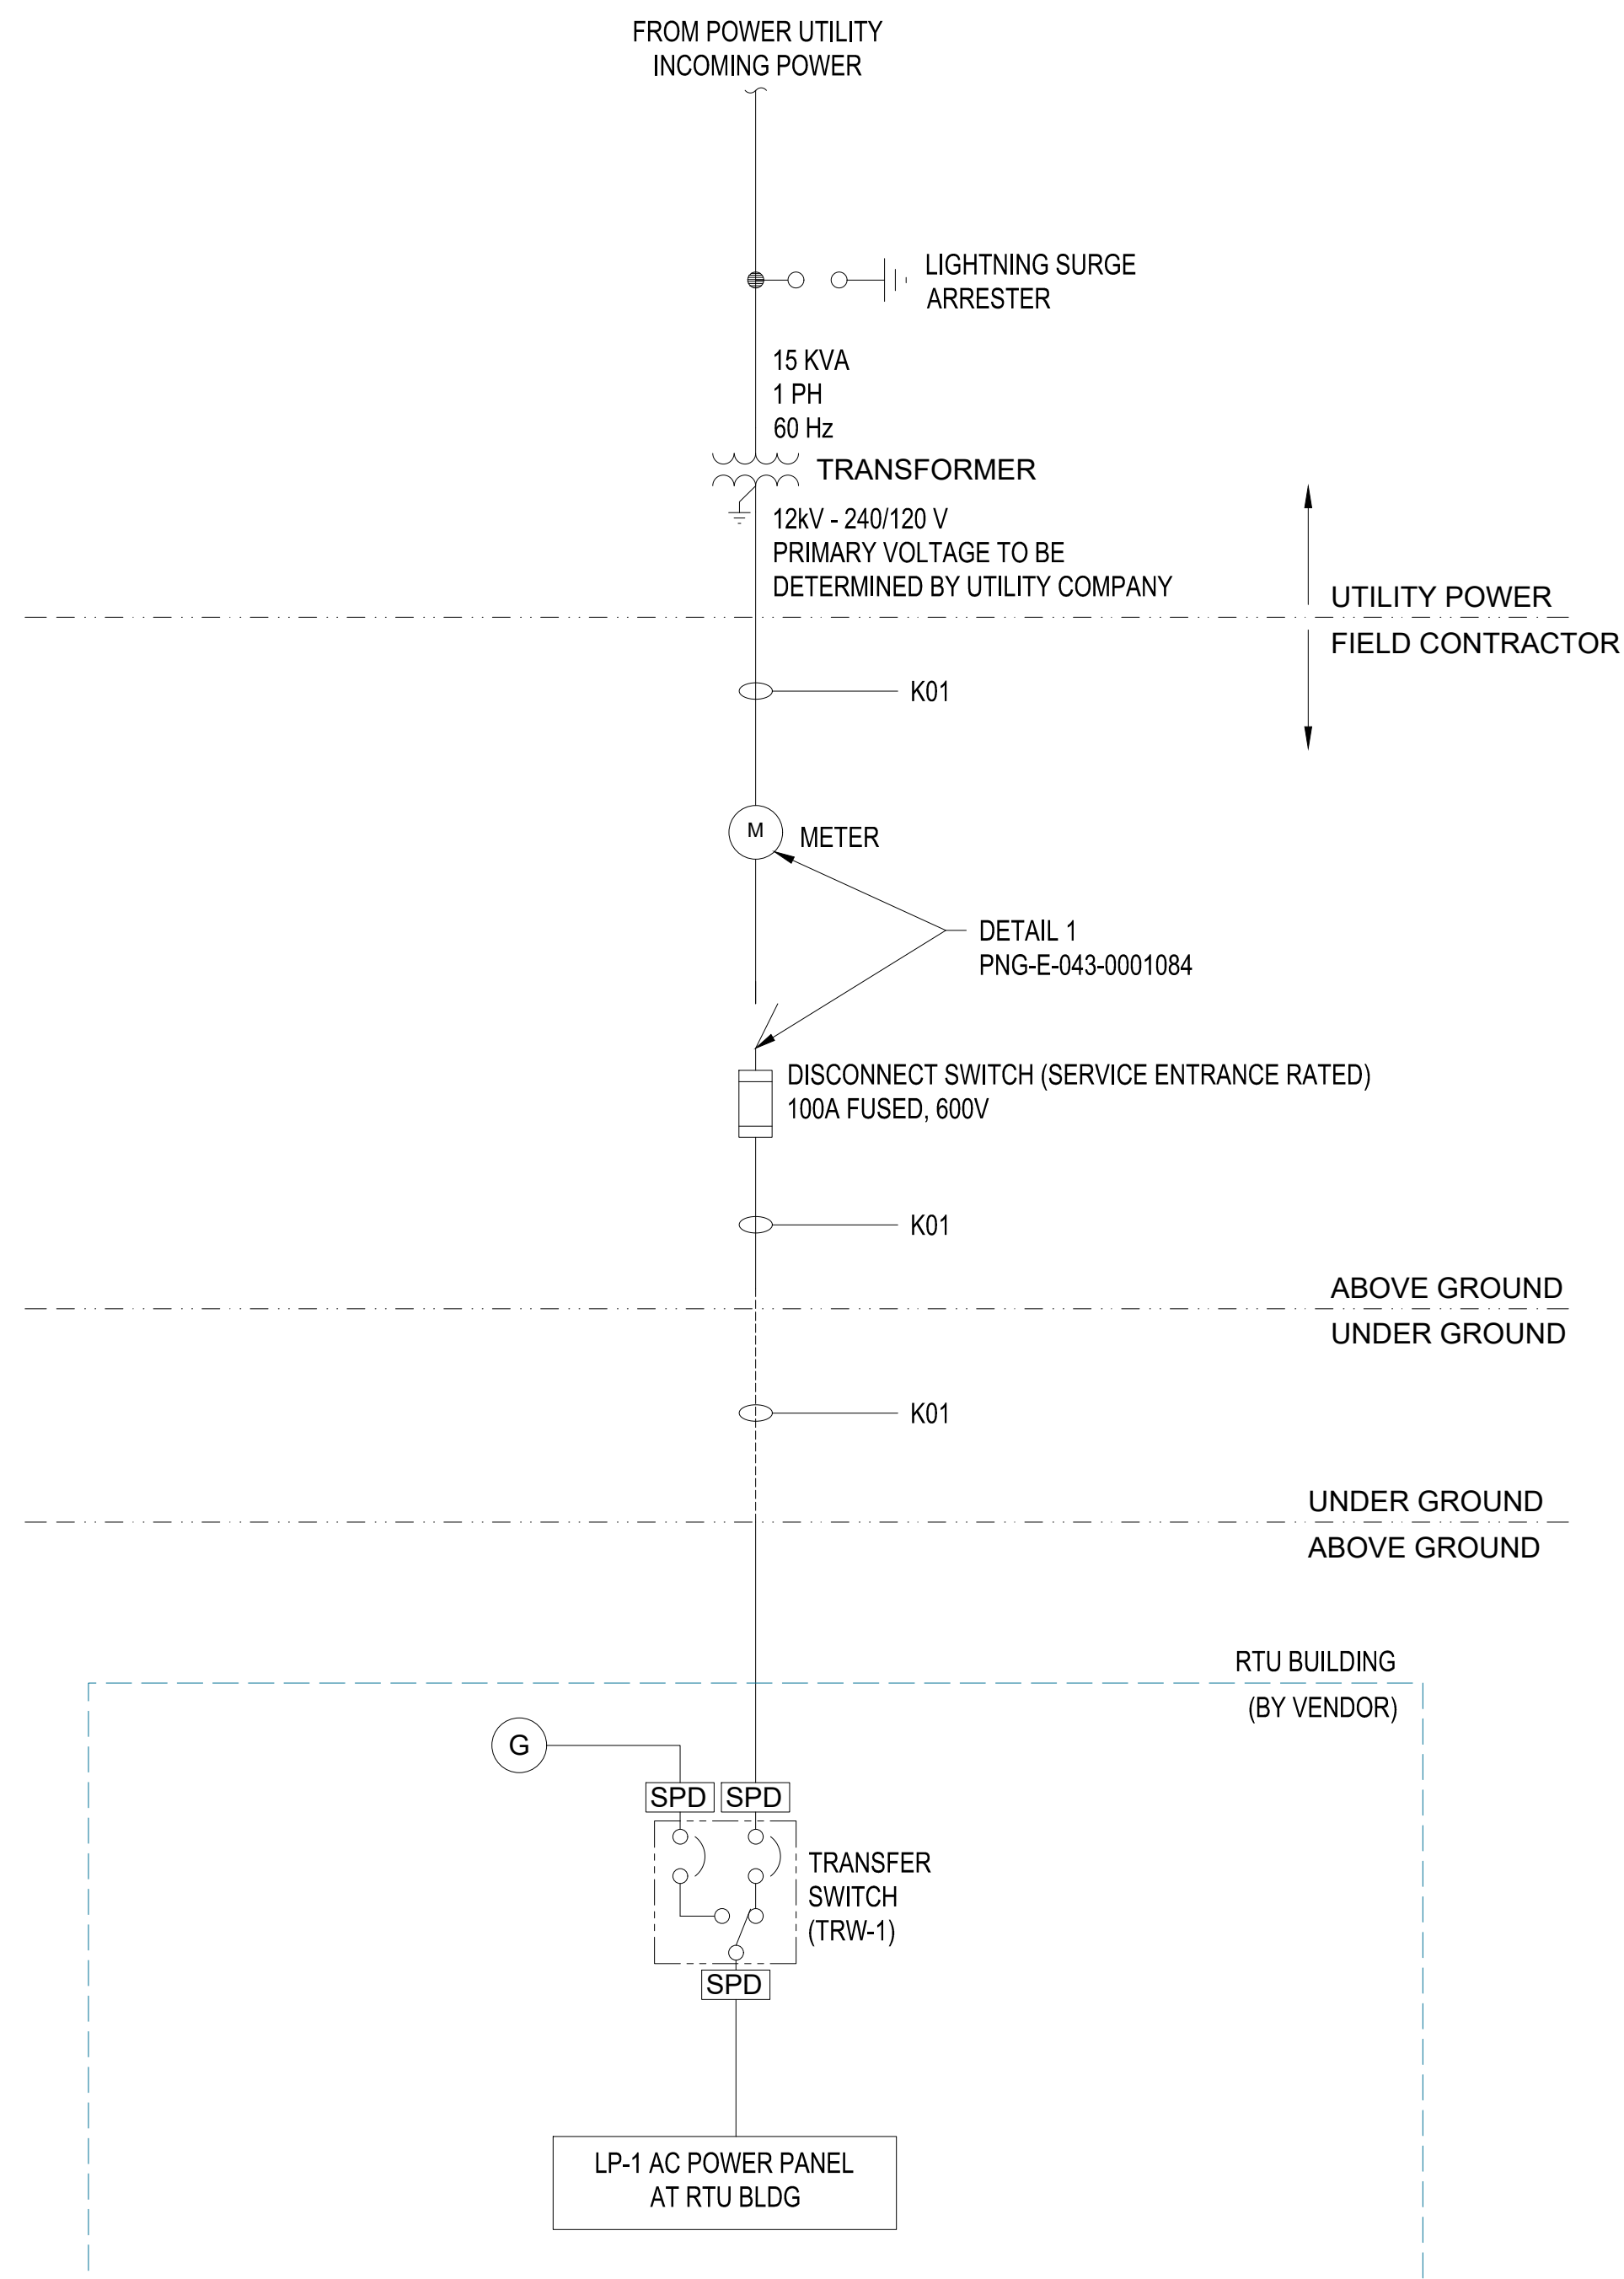

NOTES:

1. TRANSFORMER SIZING, DISCONNECT SWITCH RATING, CABLE SIZES, CONDUIT SIZE ARE BASED ON THE MAXIMUM ESTIMATE 15KVA LOAD REQUIREMENT.
2. FIELD ELECTRICAL CONTRACTOR TO FURNISH AND INSTALL POWER CABLE, METER RACK, RISER, METER SOCKET, FUSED DISCONNECTED SWITCH COMBINATION WATT-HOUR METER AND CIRCUIT PANEL. ELECTRICAL SUBCONTRACTOR TO SECURE AND PASS ALL PERMITS AND COORDINATE POWER INSTALLATION WITH UTILITY. MINIMUM REQUIREMENT IS 100 AMP @ 120/240 VAC, SINGLE PHASE SERVICE.
3. WATT-HOUR METER, DISCONNECT SWITCH, RISER AND WEATHER HEAD CONFIGURATION MAY VARY BASED ON UTILITY POWER COMPANY REQUIREMENT. CONTRACTOR TO CONFIRM WITH THE OWNER REPRESENTATIVE AND UTILITY PRIOR TO PURCHASE.
4. CONTRACTOR TO RED-LINE UTILITY'S TRANSFORMER INFORMATION AS NEEDED.
5. COMBINATION METER, DISCONNECT, CIRCUIT PANEL BY ELECTRICAL SUBCONTRACTOR. ELECTRICAL SUBCONTRACTOR TO SECURE AND PASS ALL PERMITS AND COORDINATE POWER INSTALLATION WITH UTILITY.

BURNS & MCDONNELL
STATE LICENSE #43

YEVGENIY KHISLAVSKIY
04/17/2020
KENTUCKY
SEAL 34514

PROFESSIONAL ENGINEER STAMP


PIEDMONT'S NATURAL GAS FACILITY DRAWINGS ARE CONSIDERED CONFIDENTIAL (OM-1095) * DRAWING IS CURRENT ONLY THROUGH THE LATEST REVISED DATE * TO ENSURE THERE IS NO RISK OF INAPPROPRIATE DISCLOSURE ALL PREVIOUS PAPER COPIES OF THIS DRAWING MUST BE DESTROYED IN ACCORDANCE WITH RECORDS & INFO. MANAGEMENT (RIM) POLICY 1001

REF. DWG(S) -

NO.	DATE	REVISION(S) DESCRIPTION	BY	CHK	APPD	DESCRIPTION	DATE	INITIALS	APPROVALS
0	02-19-2021	ISSUED FOR AS-BUILT	MCR	KM	AHD	AREA CODE -	N/A	N/A	REGIONAL ENGINEER
						ACCOUNT NUMBER -			
						PROJECT NUMBER V8351			MGR TECH REC & STD
						DRAWING BY MCR			
						STATION ID S0903K1			PRINCIPAL ENGINEER
						CHECKER INITIALS KM	04-17-2020	YBK	


UL60/AM07 INTERCONNECT
ONE-LINE DIAGRAM & PANELBOARD SCHEDULE
 BOONE COUNTY, KY
 ERLANGER, KY

SHEET(S)	1 OF 1	DWG SCALE	NONE
DWG DATE	07/09/2019	SUPERSEDED	
DRAWING NUMBER	PNG - E-043-0001077		
REVISION	0		
DISCIPLINE / RESOURCE CENTER / LINE NUMBER			

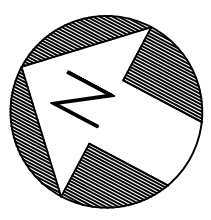

NOTES:

1. GROUNDING INSTALLATION MUST COMPLY WITH OSHA AND NATIONAL ELECTRICAL CODE REQUIREMENTS, EXCEPT WHERE LOCAL CODE PREVAILS.
2. A TEST MEASUREMENT OF THE RESISTANCE OF THE GROUNDING SYSTEM MUST BE TAKEN WHEN INSTALLED. IF THE RESISTANCE TO GROUND IS GREATER THAN 5 OHMS, ADDITIONAL GROUND RODS MUST BE INSTALLED UNTIL A COMBINED RESISTANCE OF 5 OHMS OR LESS IS OBTAINED.
3. THE GROUNDING SYSTEM IS SHOWN DIAGRAMMATICALLY SO THAT APPROXIMATE ROUTING OF GROUNDING CONDUCTORS AND LOCATIONS OF TAPS, WELLS AND GROUND RODS CAN BE ACCOMPLISHED.

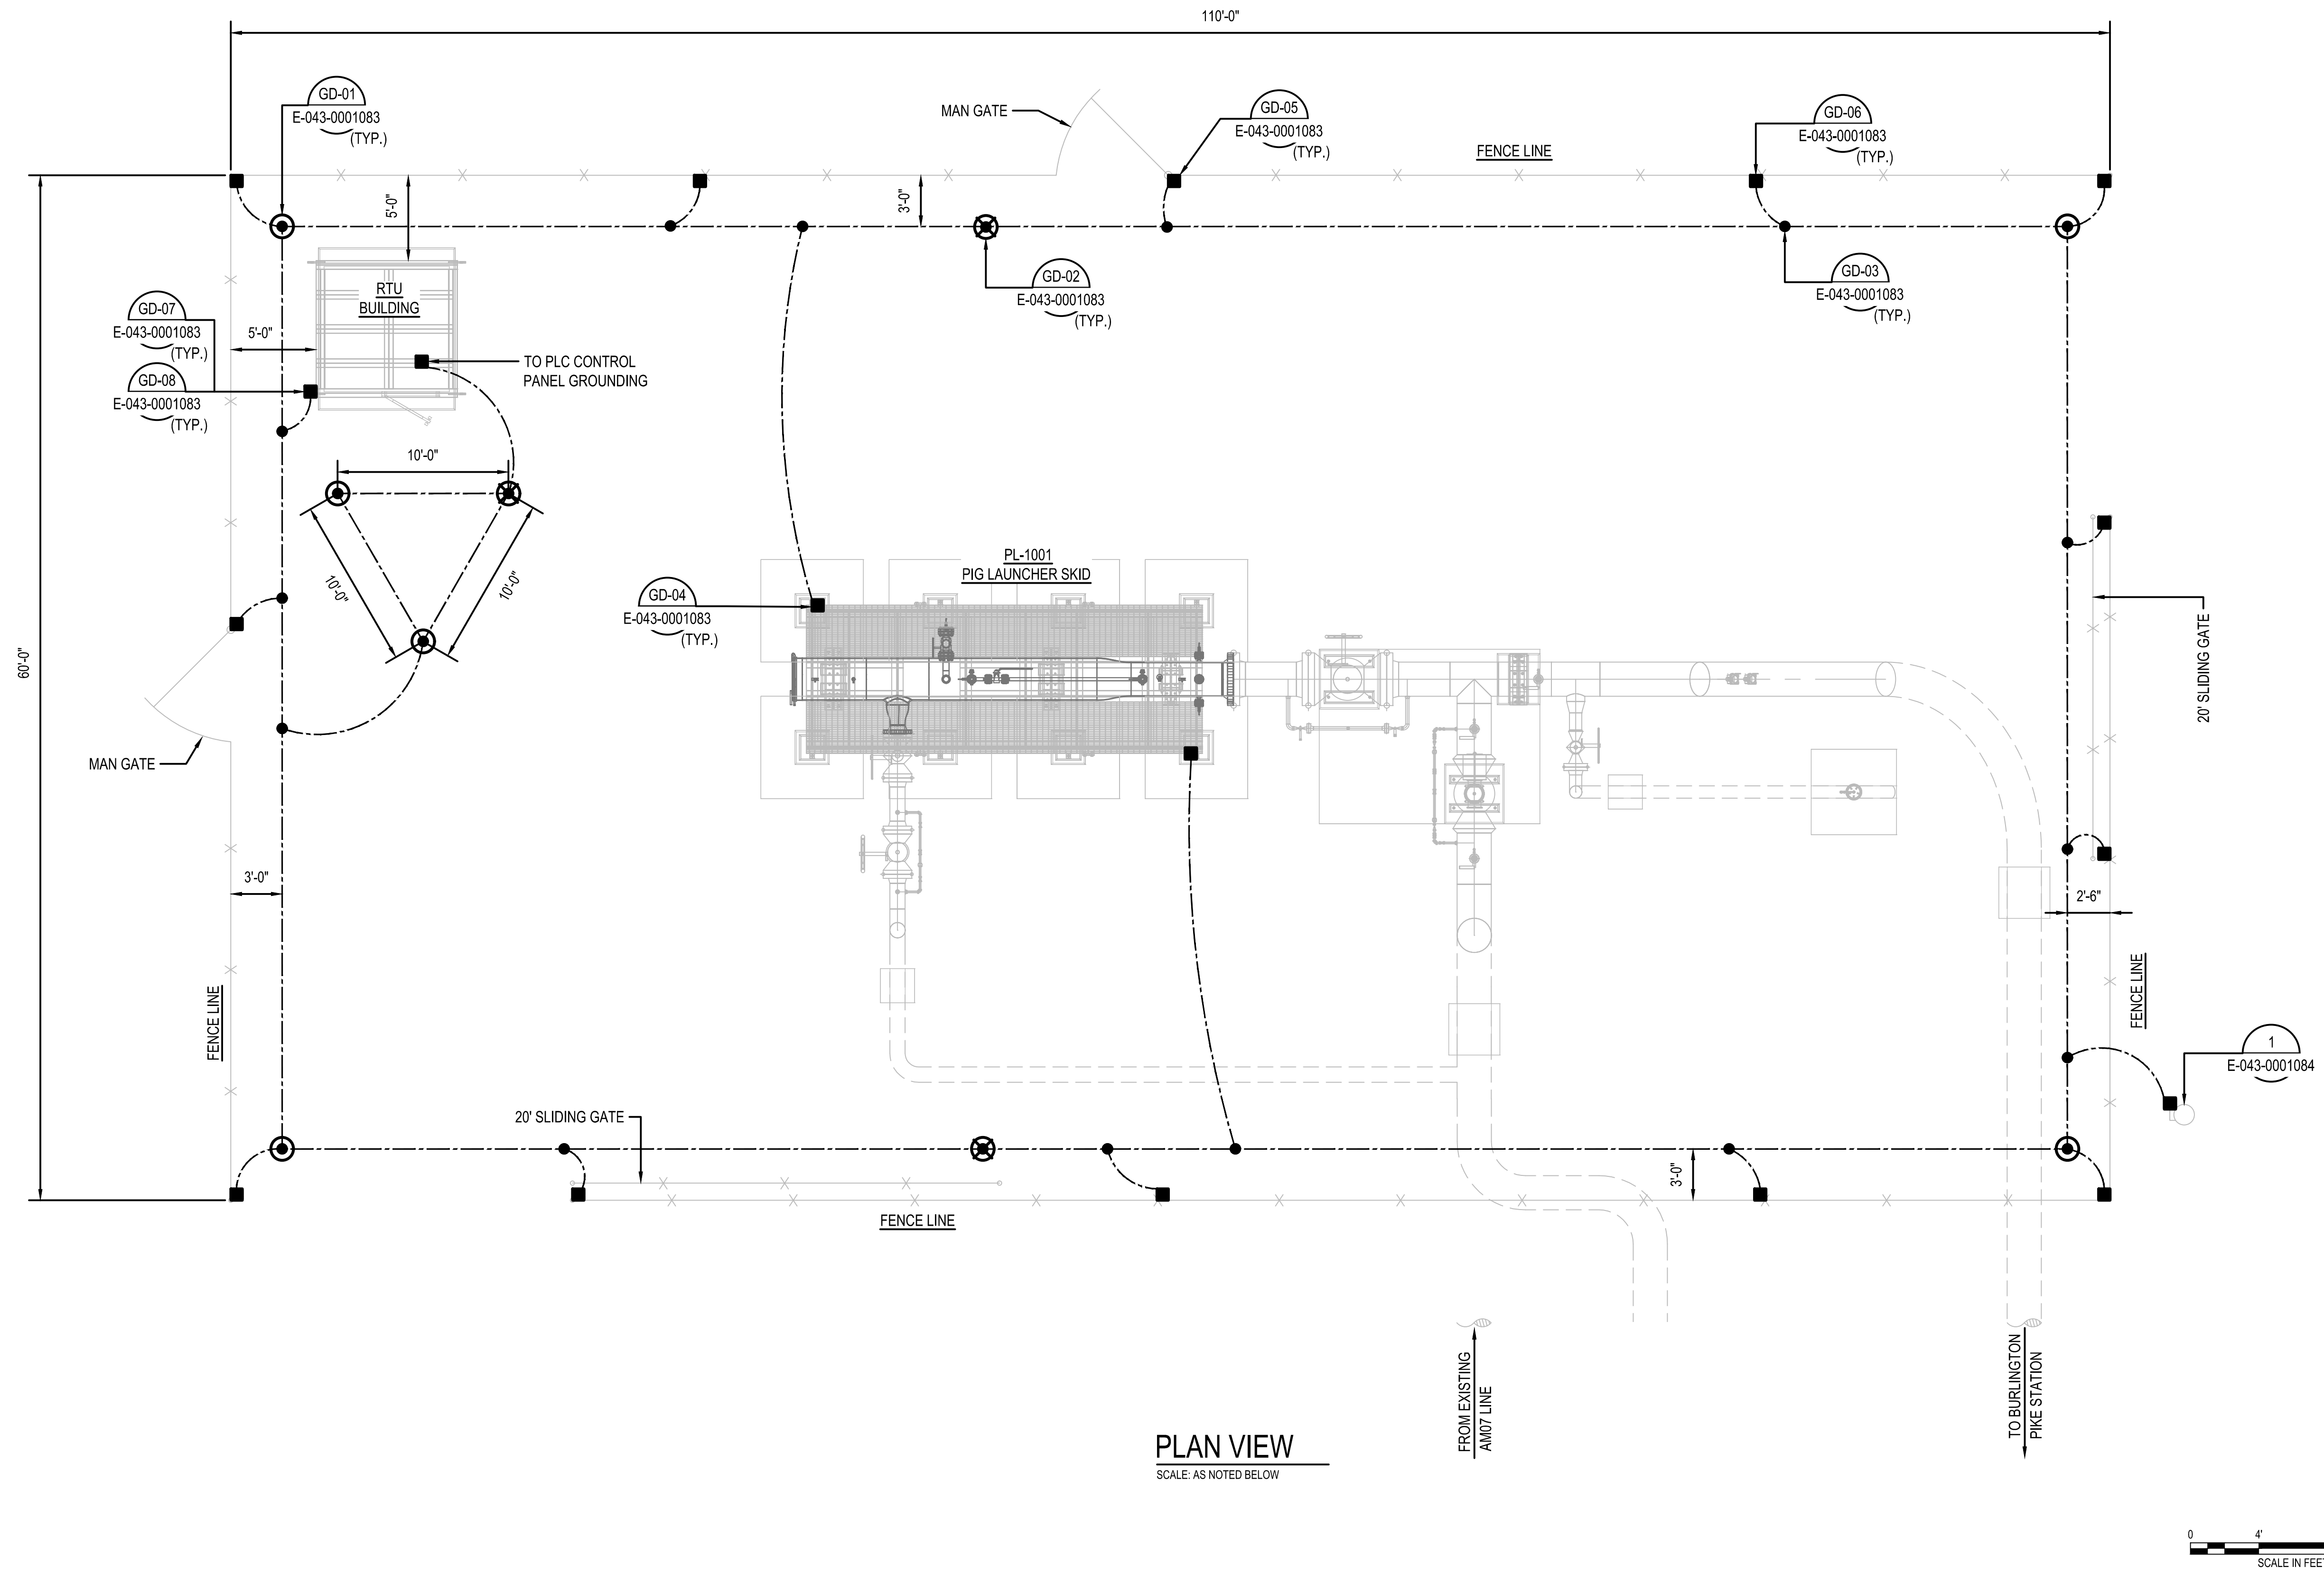

PLAN VIEW
SCALE: AS NOTED BELOW

ELECTRIC LINES PLACED AT 1.5' DEPTH.

BURNS & MCDONNELL
STATE LICENSE #43

YEVGENIY KHISLAVSKIY
04/17/2020
KENTUCKY
SEAL 34514

PROFESSIONAL ENG/ARCH STAMP

PIEDMONT'S NATURAL GAS FACILITY DRAWINGS ARE CONSIDERED CONFIDENTIAL (OM-1095) * DRAWING IS CURRENT ONLY THROUGH THE LATEST REVISED DATE * TO ENSURE THERE IS NO RISK OF INAPPROPRIATE DISCLOSURE ALL PREVIOUS PAPER COPIES OF THIS DRAWING MUST BE DESTROYED IN ACCORDANCE WITH RECORDS & INFO. MANAGEMENT (RIM) POLICY 1001


REF. DWG(S)

NO.	DATE	REVISION(S) DESCRIPTION	BY	CHK	APPD	DESCRIPTION	DATE	INITIALS	APPROVALS
0	02-19-2021	ISSUED FOR AS-BUILT	MCR	KM	AHD	AREA CODE	-	N/A	N/A
			MCR	KM	AHD	ACCOUNT NUMBER	-	N/A	N/A
						PROJECT NUMBER	V8351	N/A	N/A
						DRAWING BY	MCR	N/A	N/A
						STATION ID	S0903K1	04-17-2020	YBK
						CHECKER INITIALS	KM		

DUKE ENERGY | Piedmont Natural Gas
MGR TECH REC & STD
PRINCIPAL ENGINEER
COPYRIGHT 2018


**UL60/AM07 INTERCONNECT
ELECTRICAL GROUNDING PLAN
BOONE COUNTY, KY**
ERLANGER, KY

SHEET(S)	1 OF 1	DWG SCALE	3/16" = 1'-0"
DWG DATE	06/26/2019	SUPERSEDED	
DRAWING NUMBER	PNG - E-043-0001078		
REVISION	0		
DISCIPLINE / RESOURCE CENTER / LINE NUMBER			

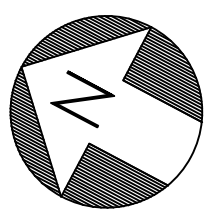


NOTES:

1. CONDUIT RUNS ARE SHOWN DIAGRAMMATIC IN NATURE. CONTRACTOR TO FIELD ROUTE CONDUITS IN ACCORDANCE WITH NEC REQUIREMENT AND AS DIRECTED BY OWNER'S REPRESENTATIVE.
2. REFER TO CABLE SCHEDULE FOR CABLE AND CONDUIT INFORMATION.
3. REFER TO INSTALLATION DETAILS ON DRAWING PNG-E-043-0001084, PNG-E-043-0001085.
4. COMBINATION METER, DISCONNECT, CIRCUIT PANEL BY ELECTRICAL SUBCONTRACTOR. ELECTRICAL SUBCONTRACTOR TO SECURE AND PASS ALL PERMITS AND COORDINATE POWER INSTALLATION WITH UTILITY. 100 AMP @ 120/240 VAC, SINGLE PHASE SERVICE.
5. RTU BUILDING SHOWN BASED ON TYPICAL DUKE ENERGY STANDARD LAYOUT. CONTRACTOR SHALL VERIFY EXACT DIMENSIONS, LAYOUT AND ORIENTATION WITH OWNER PRIOR TO COMMENCING WORK. REFER TO CONSOLIDATED ANALYTICAL SYSTEMS DRAWING #19.4003, DUKE UL60.

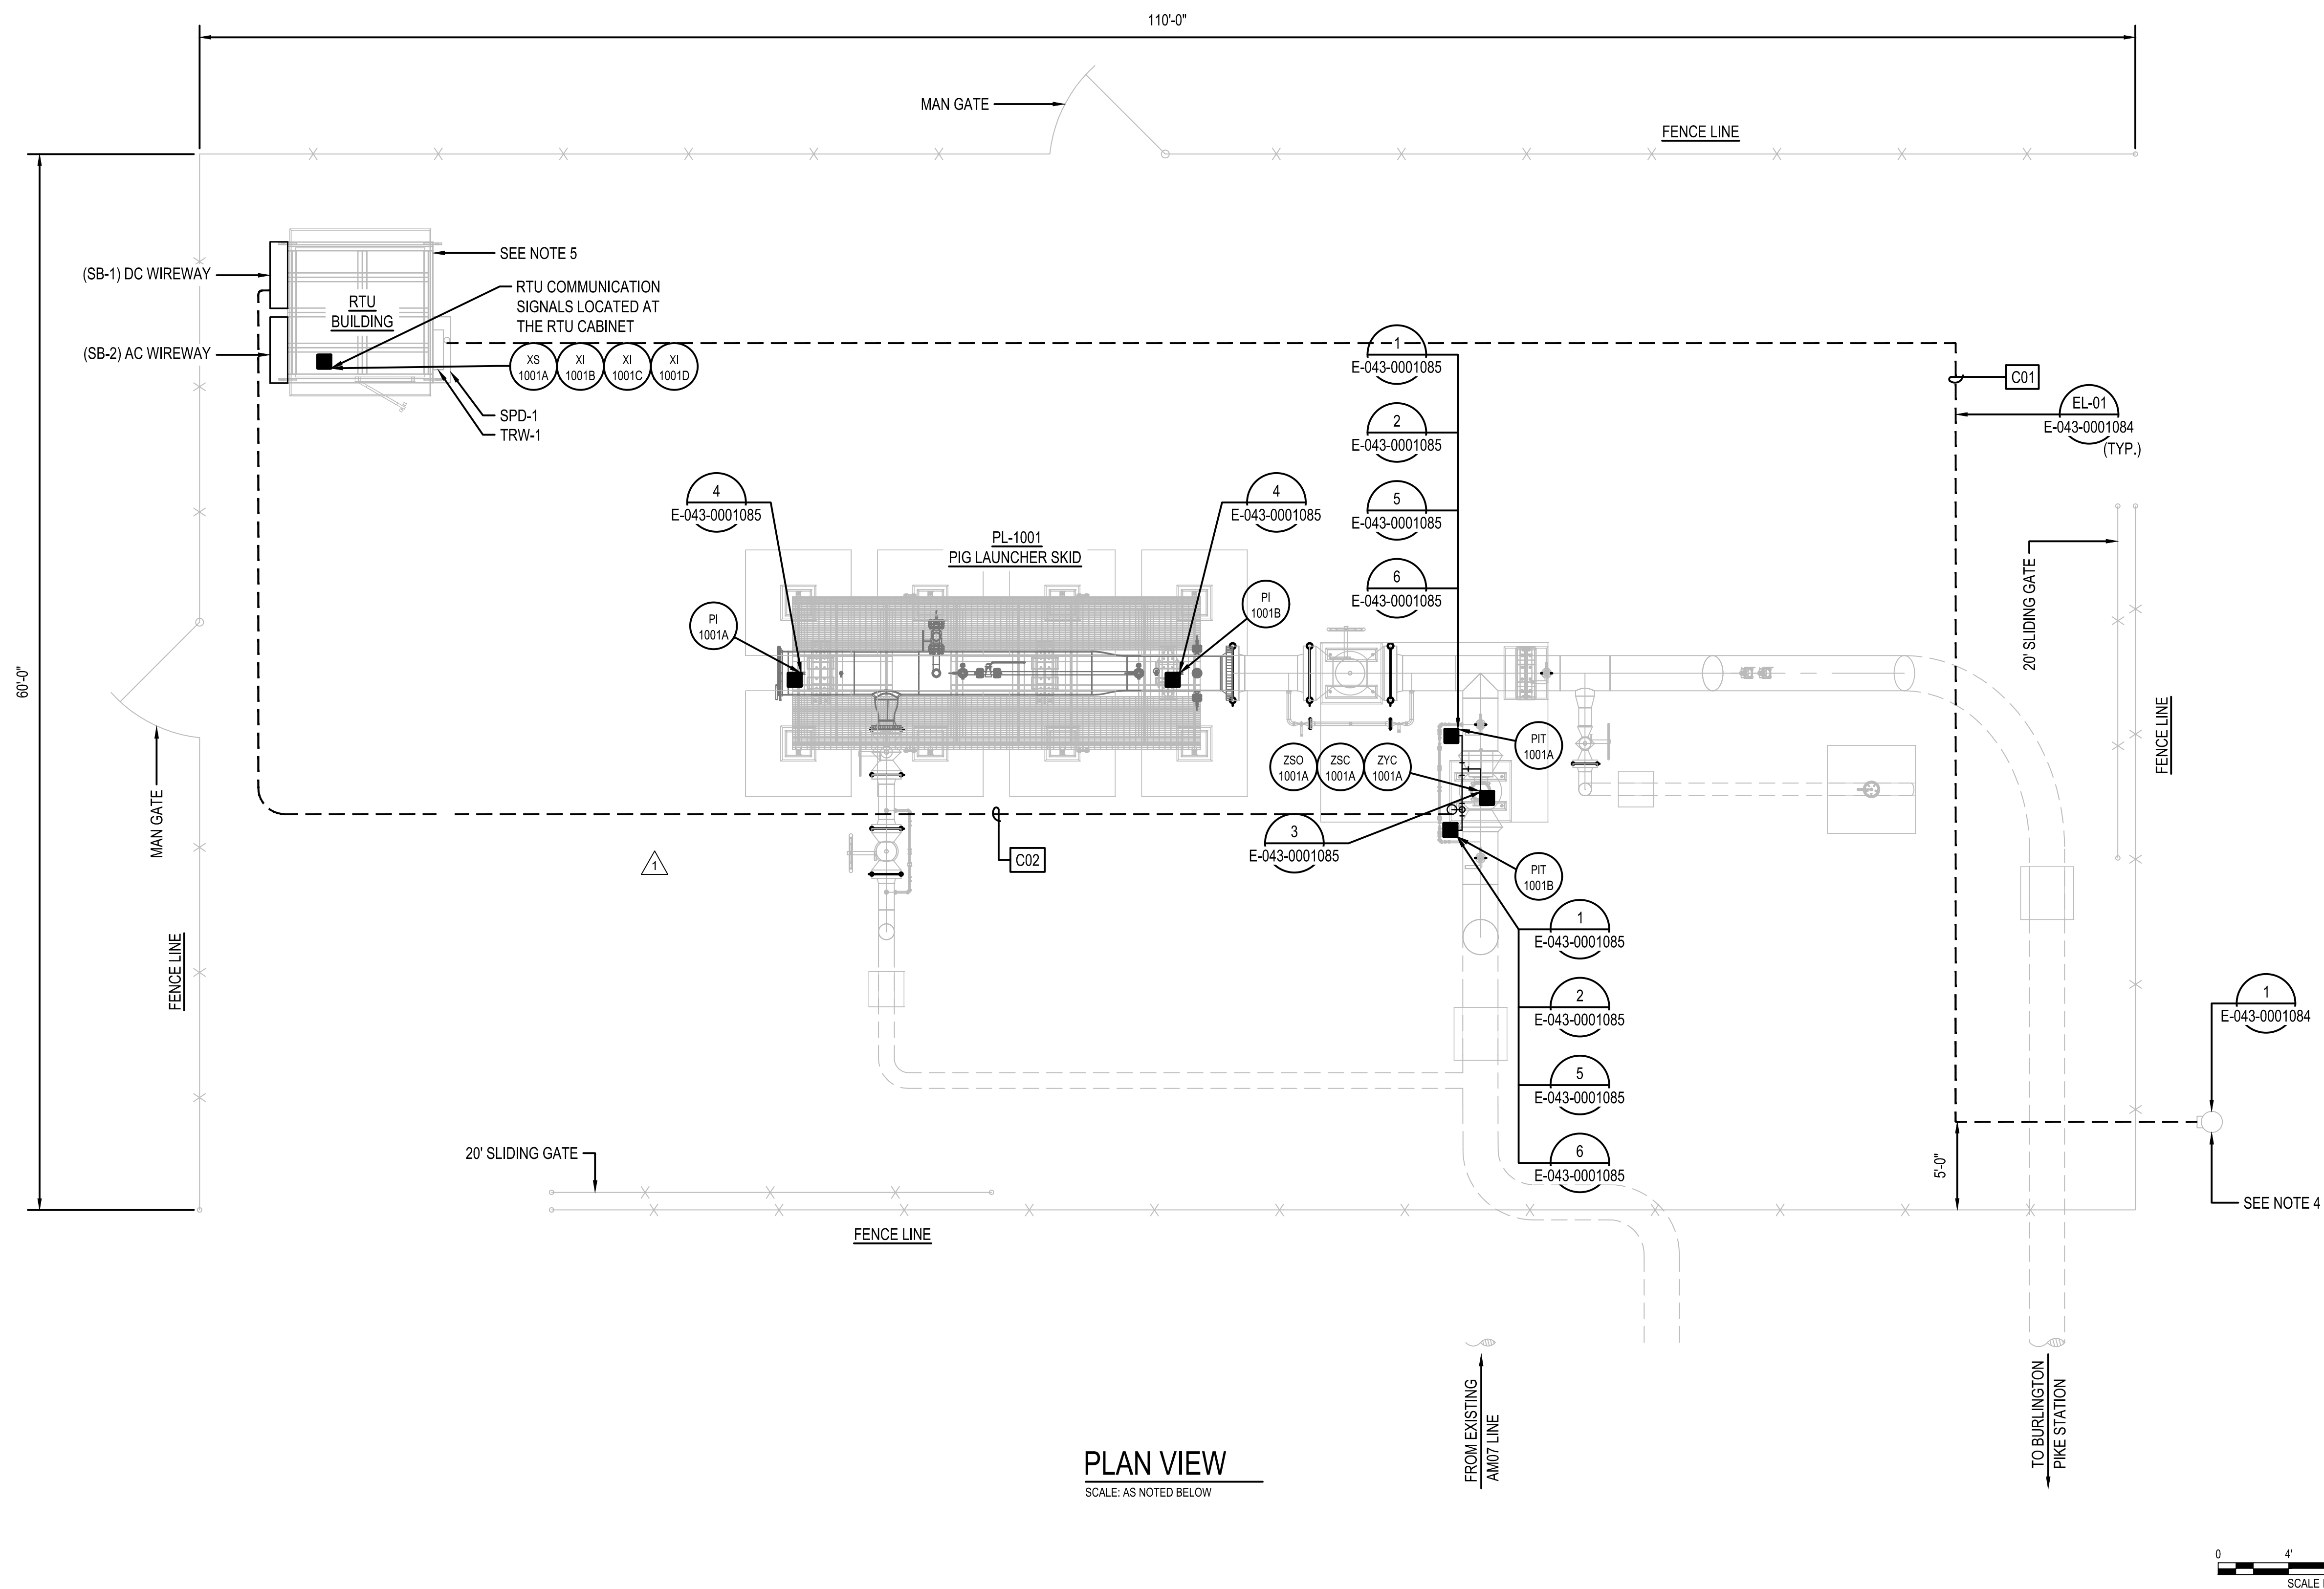

PLAN VIEW
SCALE: AS NOTED BELOW

ELECTRIC LINES PLACED AT 1.5' DEPTH.

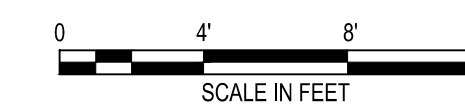

BURNS & MCDONNELL
STATE LICENSE #43

YEVGENIY KHISLAVSKIY
04/17/2020
KENTUCKY
SEAL 34514

PROFESSIONAL ENG/ARCH STAMP

PIEDMONT'S NATURAL GAS FACILITY DRAWINGS ARE CONSIDERED CONFIDENTIAL (OM-1095) * DRAWING IS CURRENT ONLY THROUGH THE LATEST REVISED DATE * TO ENSURE THERE IS NO RISK OF INAPPROPRIATE DISCLOSURE ALL PREVIOUS PAPER COPIES OF THIS DRAWING MUST BE DESTROYED IN ACCORDANCE WITH RECORDS & INFO. MANAGEMENT (RIM) POLICY 1001

REF. DWG(S)


NO.	DATE	REVISION(S) DESCRIPTION	BY	CHK	APPD	DESCRIPTION	DATE	INITIALS	APPROVALS
0	02-19-2021	ISSUED FOR AS-BUILT	MCR	KM	AHD	AREA CODE	-	N/A	REGIONAL ENGINEER
						ACCOUNT NUMBER	-	N/A	MGR TECH REC & STD
						PROJECT NUMBER	V8351	N/A	PRINCIPAL ENGINEER
						DRAWING BY	MCR	YBK	
						STATION ID	S0903K1		
						CHECKER INITIALS	KM		



**UL60/AM07 INTERCONNECT
ELECTRICAL CONDUIT & INSTRUMENT PLAN
BOONE COUNTY, KY**

ERLANGER, KY


SHEET(S)	1 OF 1	DWG SCALE	3/16" = 1'-0"
DWG DATE	07/12/2019	SUPERSEDED	-
DRAWING NUMBER		REVISION	
PNG - E-043-0001079		0	
DISCIPLINE / RESOURCE CENTER / LINE NUMBER			

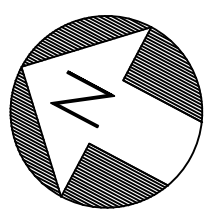

LEGEND:

	CLASS 1, DIVISION 1, GROUP D, T1
	CLASS 1, DIVISION 2, GROUP D, T1
	UNCLASSIFIED

- NOTES:**
1. AREA CLASSIFICATION ARE PER THE LATEST EDITION OF AMERICAN GAS ASSOCIATION AGA-XL1001
 2. ELECTRICAL WORK IN AREA CLASSIFICATION SHALL BE IN COMPLIANCE WITH THE LATEST EDITION OF NATIONAL ELECTRIC CODE, ARTICLE 500, 501 AND 504, AND PER STATE, LOCAL AND OSHA REGULATIONS.

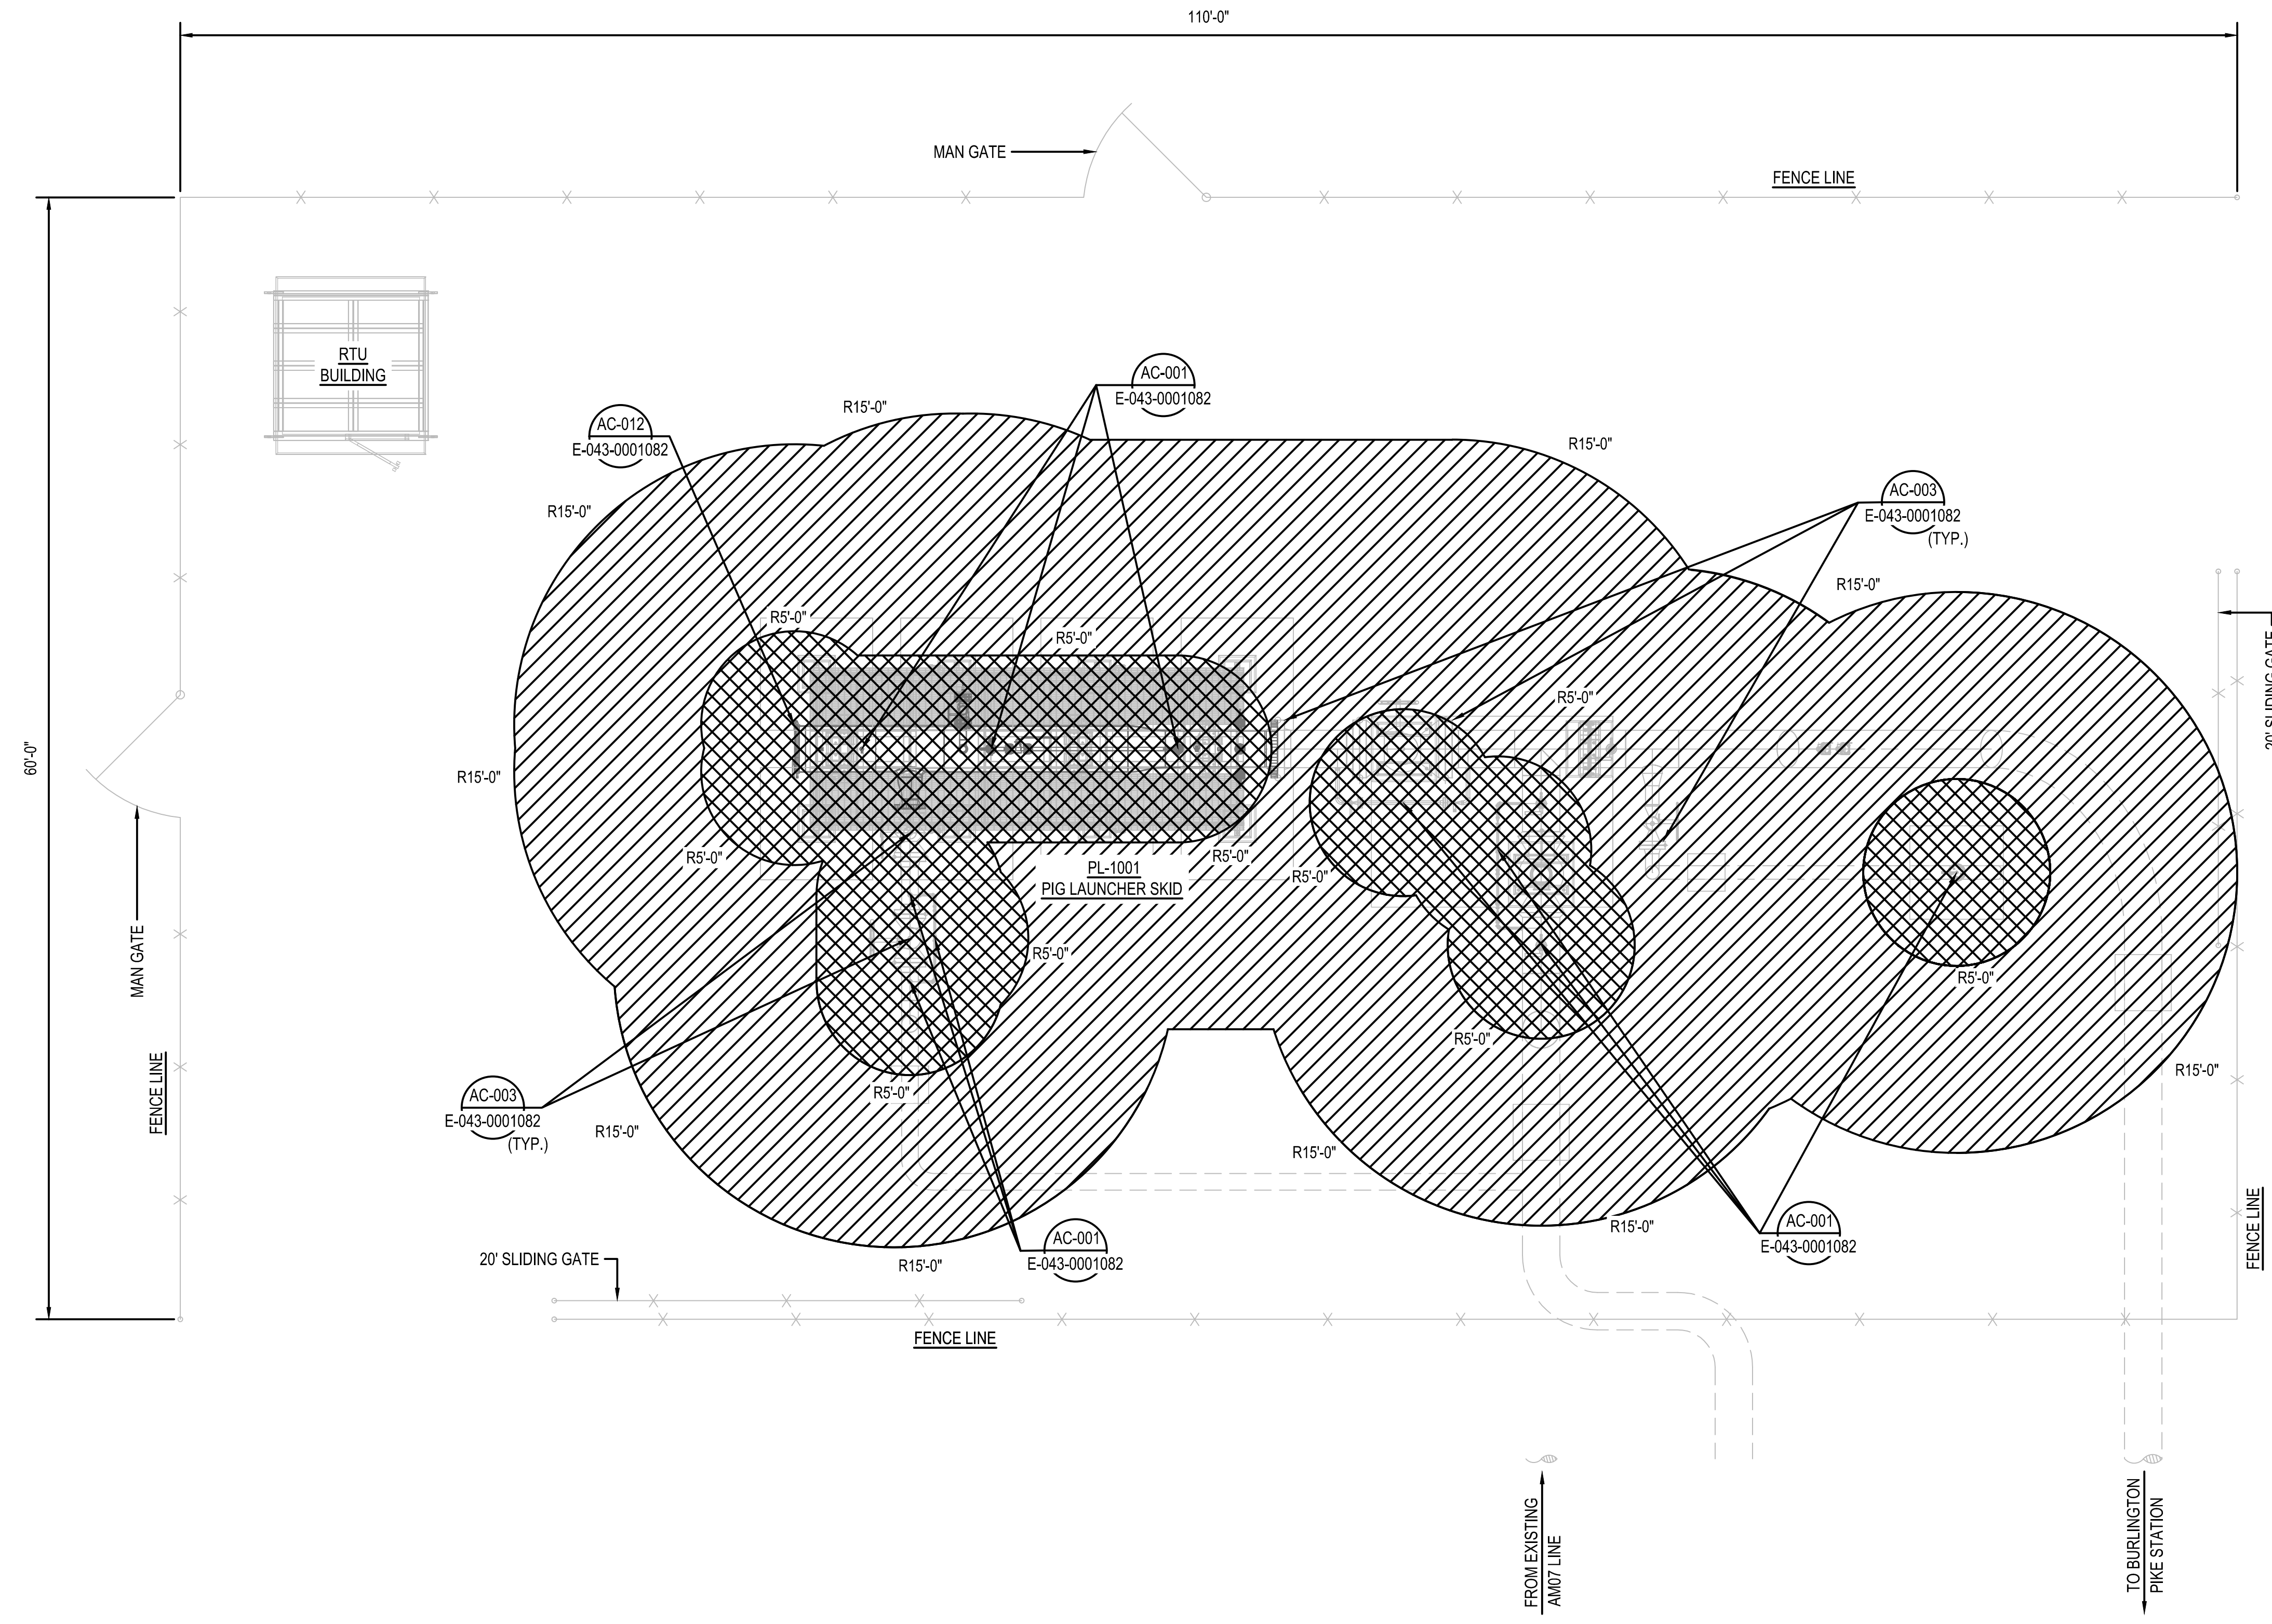

PLAN VIEW
SCALE: AS NOTED BELOW

BURNS & MCDONNELL
STATE LICENSE #43

YEVGENIY KHISLAVSKIY
04/17/2020
KENTUCKY
SEAL 34514

PROFESSIONAL ENG/ARCH STAMP

PIEDMONT'S NATURAL GAS FACILITY DRAWINGS ARE CONSIDERED CONFIDENTIAL (OM-1095) * DRAWING IS CURRENT ONLY THROUGH THE LATEST REVISED DATE * TO ENSURE THERE IS NO RISK OF INAPPROPRIATE DISCLOSURE ALL PREVIOUS PAPER COPIES OF THIS DRAWING MUST BE DESTROYED IN ACCORDANCE WITH RECORDS & INFO. MANAGEMENT (RIM) POLICY 1001

REF. DWG(S)

NO.	DATE	REVISION(S) DESCRIPTION	BY	CHK	APPD	DESCRIPTION	APPROVALS
0	02-19-2021	ISSUED FOR AS-BUILT	MCR	KM	AHD	AREA CODE - ACCOUNT NUMBER - PROJECT NUMBER V8351 DRAWING BY MCR STATION ID S0903K1 CHECKER INITIALS KM	DATE N/A INITIALS N/A DATE N/A INITIALS N/A DATE 04-17-2020 INITIALS YBK

COPYRIGHT 2018	

**UL60/AM07 INTERCONNECT
ELECTRICAL HAZARDOUS AREA CLASSIFICATION PLAN
BOONE COUNTY, KY**
ERLANGER, KY

SHEET(S) 1 OF 1	DWG SCALE 3/16" = 1'-0"
DWG DATE 07/02/2019	SUPERSEDED
DRAWING NUMBER	REVISION
PNG - E-043-0001080	0
DISCIPLINE / RESOURCE CENTER / LINE NUMBER	

AM07 CONDUIT SCHEDULE								
CONDUIT NUMBER	CONDUIT SIZE	CONDUIT TYPE	% FILL	CONTENT	FROM	TO	LENGTH (FT.)	NOTES
C01	2"	RGS	23.98%	K01	UTILITY METER RACK	LP-1, AC PANEL	225	ROUTED VIA SURGE SUPPRESSION ENCLOSURE (SPD-1) AND TRANSFER SWITCH (TRW-1)
C02	1.5"	RGS	34.22%	K02, K03, K04, K05, K06	RTU, CONTROL PANEL	CV-1001A	125	

SCHEDULE NOTES:

- POWER CABLES ARE SIZED IN ACCORDANCE WITH TYPICAL DUKE PANELBOARD SCHEDULE, 20 CIRCUIT LOAD CENTER, 240/120VAC, SINGLE PHASE WITH 100A MAIN BREAKER.
- CABLE LENGTH ARE FOR REFERENCE AND CONTRACTOR TO FIELD VERIFY AND RESIZE AS NEEDED BASED ON FINAL ROUTING.

AM07 CABLE SCHEDULE								
CABLE NUMBER	INSTRUMENT TAG	NUMBER OF CABLE	CONDUCTORS (COPPER) (600V INSULATION)	WORKING VOLTAGE	FROM	TO	LENGTH (FT.)	NOTES
K01	N/A	1	3-1/C #2 AWG + #8 AWG GND, THWN-2	120 VAC	UTILITY METER RACK	LP-1, AC PANEL	225	
K02	PIT-1001A	1	1PR #18 AWG TSP, THWN-2	24 VDC	RTU, CONTROL PANEL	PIT-1001A	125	
K03	PIT-1001B	1	1PR #18 AWG TSP, THWN-3	24 VDC	RTU, CONTROL PANEL	PIT-1001B	125	
K04	ZYC-1001A	1	1PR #18 AWG TSP, THWN-4	24 VDC	RTU, CONTROL PANEL	CV-1001A	125	
K05	ZSC-1001A	1	1PR #18 AWG TSP, THWN-5	24 VDC	RTU, CONTROL PANEL	CV-1001A	125	
K06	ZSO-1001A	1	1PR #18 AWG TSP, THWN-6	24 VDC	RTU, CONTROL PANEL	CV-1001A	125	

SCHEDULE NOTES:

- POWER CABLES ARE SIZED IN ACCORDANCE WITH TYPICAL DUKE PANELBOARD SCHEDULE, 20 CIRCUIT LOAD CENTER, 240/120VAC, SINGLE PHASE WITH 100A MAIN BREAKER.
- CABLE LENGTH ARE FOR REFERENCE AND CONTRACTOR TO FIELD VERIFY AND RESIZE AS NEEDED BASED ON FINAL ROUTING.
- MULTIPAIR CONDUCTOR MAY BE USED IN PLACE OF SINGLE PAIR INSTRUMENT CABLE WITH OWNER'S APPROVAL.

BURNS & MCDONNELL
STATE LICENSE #43

YEVGENIY KHISLAVSKIY
04/17/2020
KENTUCKY
SEAL 34514

PROFESSIONAL ENG/ARCH STAMP

PIEDMONT 'S NATURAL GAS FACILITY DRAWINGS ARE CONSIDERED CONFIDENTIAL (OM-1095) * DRAWING IS CURRENT ONLY THROUGH THE LATEST REVISED DATE * TO ENSURE THERE IS NO RISK OF INAPPROPRIATE DISCLOSURE ALL PREVIOUS PAPER COPIES OF THIS DRAWING MUST BE DESTROYED IN ACCORDANCE WITH RECORDS & INFO. MANAGEMENT (RIM) POLICY 1001

NO.	DATE	REVISION(S) DESCRIPTION	BY	CHK	APPD	DESCRIPTION	APPROVALS	
0	02-19-2021	ISSUED FOR AS-BUILT	MCR	KM	AHD	AREA CODE - ACCOUNT NUMBER - PROJECT NUMBER V8351 DRAWING BY MCR STATION ID S0903K1 CHECKER INITIALS KM	DATE N/A INITIALS N/A DATE N/A INITIALS N/A DATE 04-17-2020 INITIALS YBK	REGIONAL ENGINEER MGR TECH REC & STD PRINCIPAL ENGINEER



REF. DWG(S)

SHEET(S) 1 OF 1 | DWG SCALE NONE

DWG DATE 07/09/2019 | SUPERSEDED


DRAWING NUMBER PNG - E-043-0001081 | REVISION 0

DISCIPLINE / RESOURCE CENTER / LINE NUMBER

UL60/AM07 INTERCONNECT
CABLE AND CONDUIT SCHEDULE
BOONE COUNTY, KY
ERLANGER, KY


	CLASS 1, DIVISION 1, GROUP D, T1
	CLASS 1, DIVISION 2, GROUP D, T1
	UNCLASSIFIED

- NOTES:**
1. AREA CLASSIFICATIONS ARE PER THE LATEST EDITION OF AMERICAN GAS ASSOCIATION AGA-XL1001.
 2. ELECTRICAL WORK AND EQUIPMENT INSTALLED IN AREA CLASSIFICATION SHALL BE IN COMPLIANCE WITH THE LATEST EDITION OF NATIONAL ELECTRIC CODE, ARTICLE 500, 501, AND 504, PER INDUSTRY STANDARDS, AND PER STATE, LOCAL, AND OSHA REGULATIONS.
 3. HAZARDOUS AREA CLASSIFICATION BASED ON:
CLASS 1 - FLAMMABLE GASES OR VAPORS
DIVISION 1 - NORMALLY HAZARDOUS *
DIVISION 2 - NOT NORMALLY HAZARDOUS OR EXTENSION OF DIVISION 1*
GROUP D - NATURAL GAS
(*DEFINED BY NEC ARTICLE 500-5)
 4. ENSURE THAT ELECTRICAL EQUIPMENT ENCLOSURES INCLUDING JUNCTION BOXES, AND CONDUIT FITTINGS DO NOT HAVE CL.1 DIV.1 INSTALLATION, OR SHALL MEET HAZARDOUS AREA CLASSIFICATION AS INDICATED ON THE DRAWINGS.
 5. SOLENOIDS AND VALVES SHALL BE HAZARDOUS RATED AND STAMPED CL.1 DIV. 2 GROUP D, T1. VENTS OFF OF BLOW DOWN VALVES SHALL BE PIPED AT LEAST 5 FT. ABOVE ANY ELECTRICAL COMPONENTS OF THE VALVES.

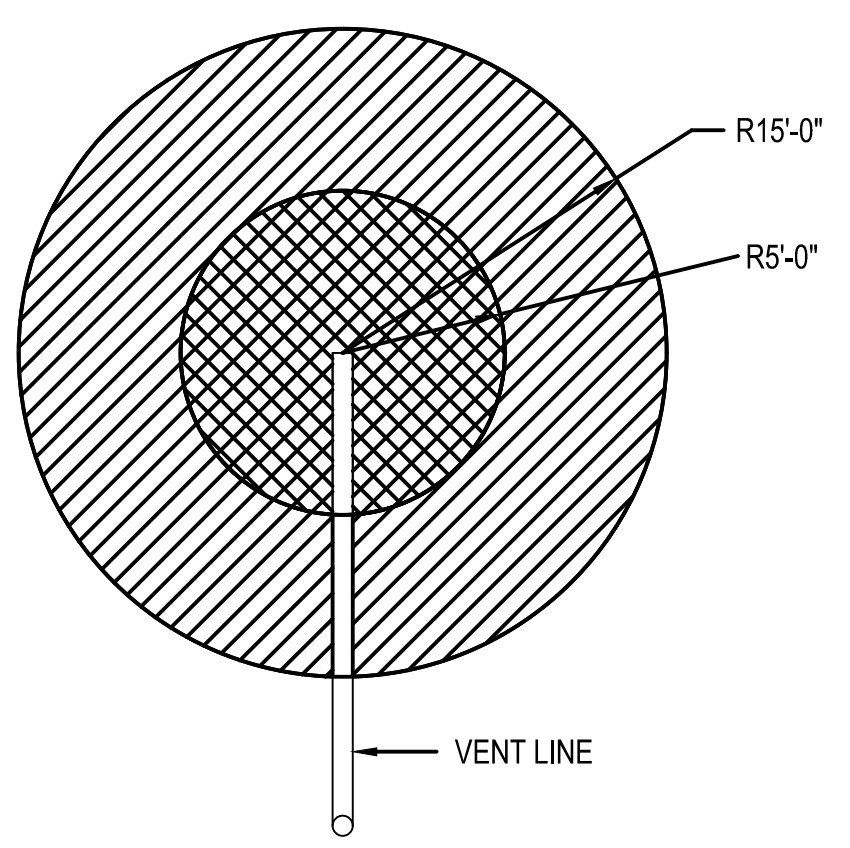


DETAIL AC-001
SCALE: N.T.S.

(REF: AGA XL1001, FIG. 1)
VENT RELIEF VALVE OR BLOWDOWN IN ADEQUATELY VENTILATED NON-ENCLOSED AREA

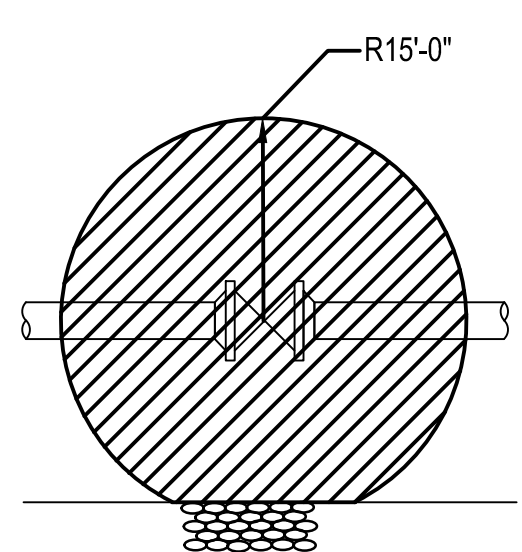


DETAIL AC-003
SCALE: N.T.S.

(REF: AGA XL1001, FIG. 3)
VALVES, FLANGES, SCREWED FITTINGS - ADEQUATELY VENTILATED ENCLOSED AND NON-ENCLOSED AREA

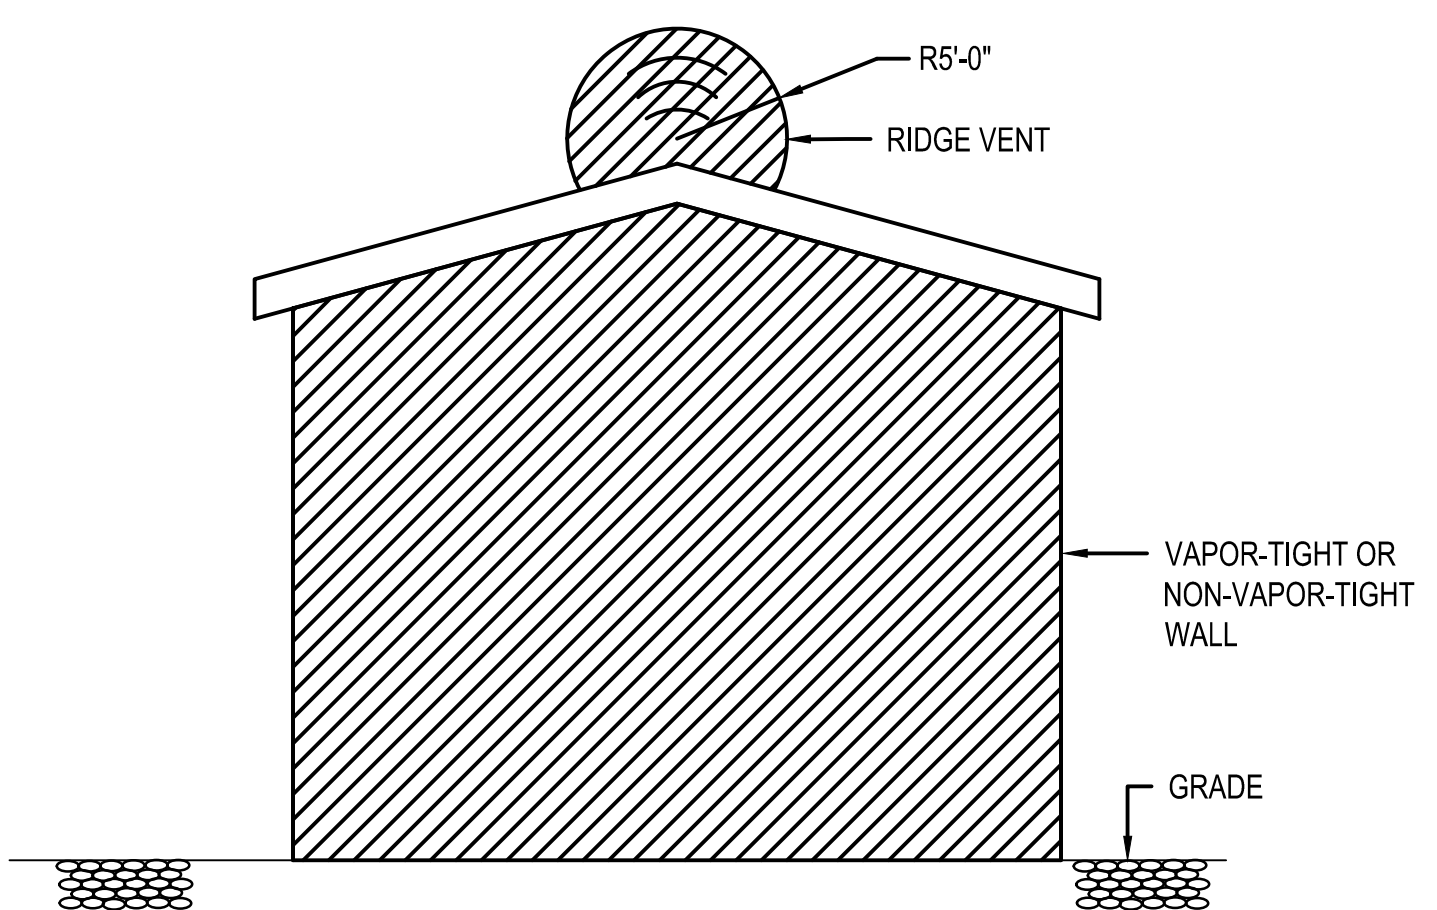


DETAIL AC-006
SCALE: N.T.S.

(REF: AGA XL1001, FIG. 6)
CLASS 1 DIVISION 2 ENCLOSURE

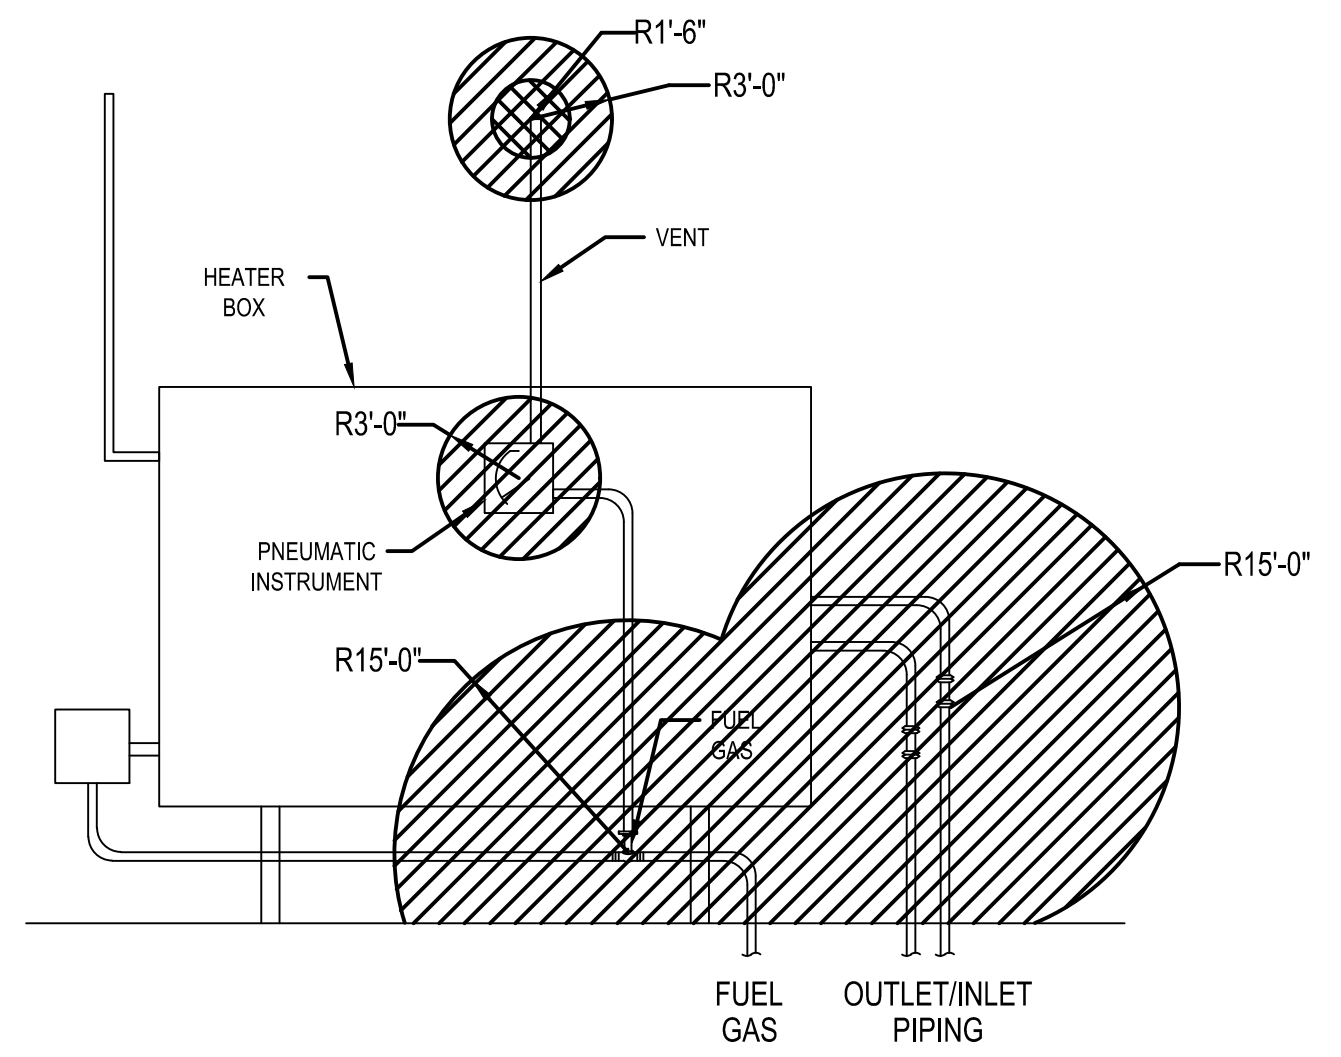


DETAIL AC-011
SCALE: N.T.S.

(REF: AGA XL1001, FIG. 11)
FIRED EQUIPMENT: INDIRECT/DIRECT-FIRED HEATERS

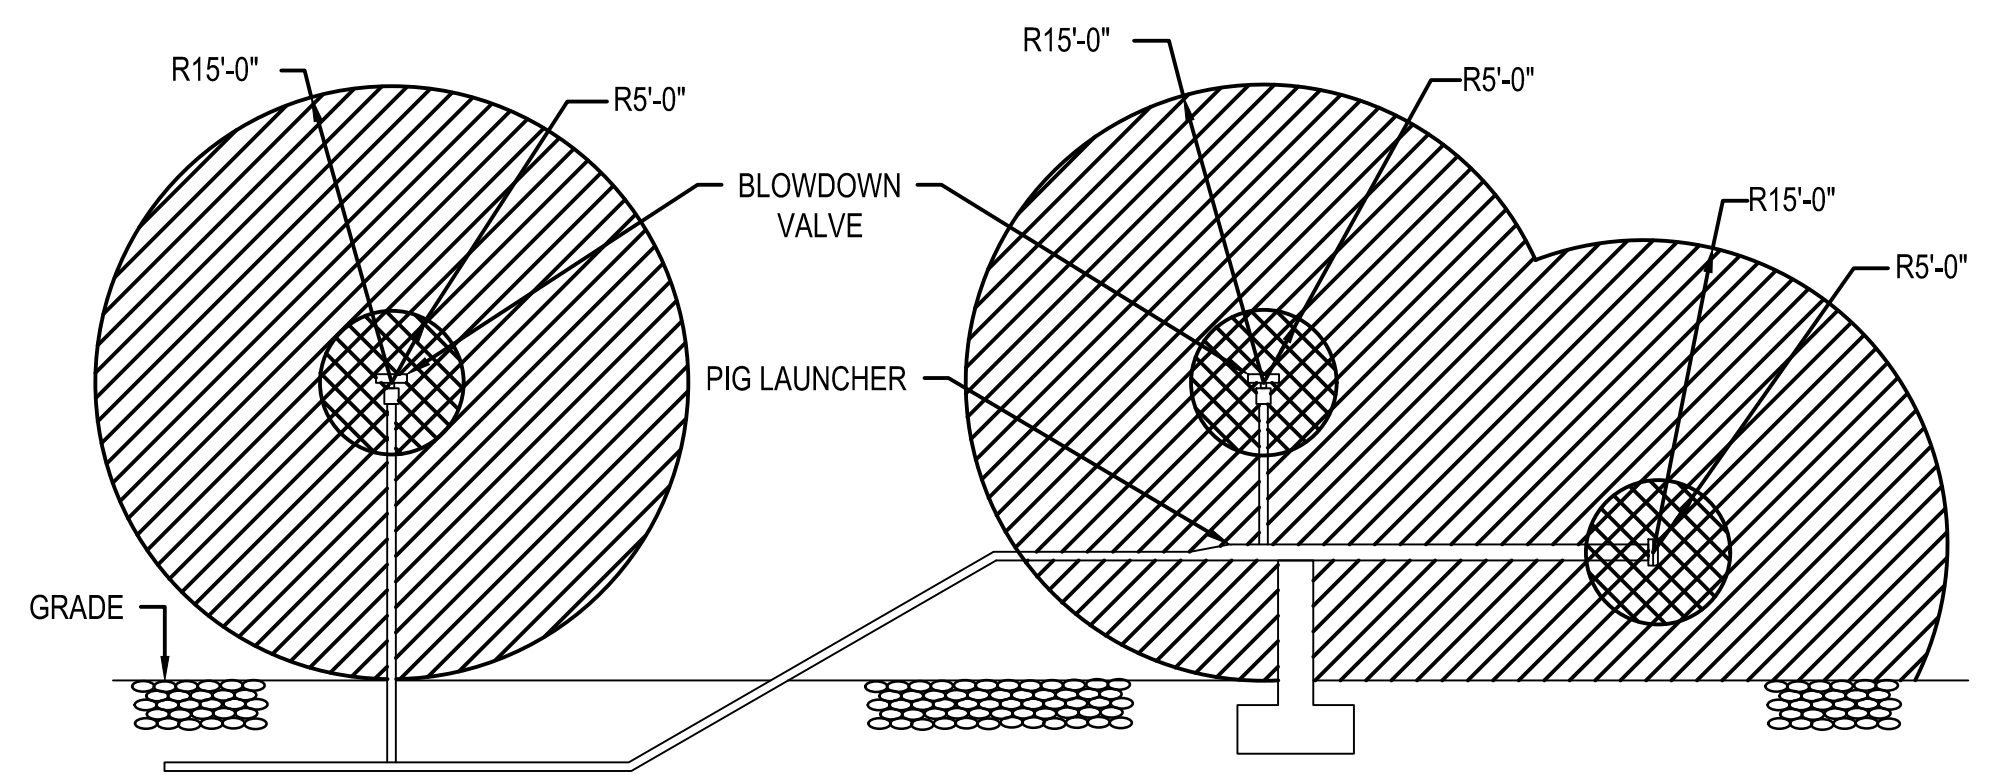

DETAIL AC-012
SCALE: N.T.S.

(REF: AGA XL1001, FIG. 12)
PIG LAUNCHERS / RECEIVERS AND BLOW OFF

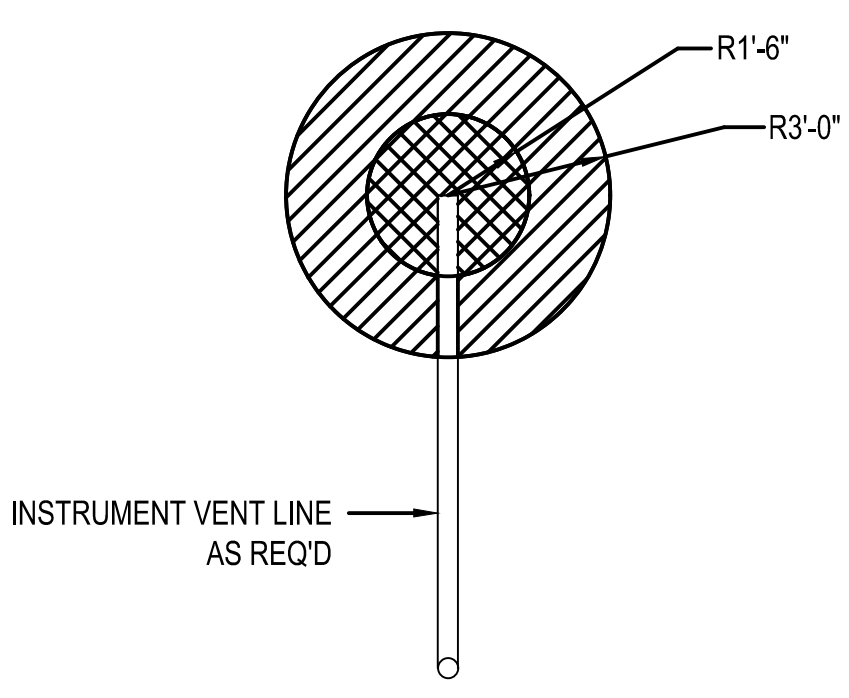

DETAIL AC-016
SCALE: N.T.S.

(REF: AGA XL1001, FIG. 16)
INSTRUMENT OR CONTROL DEVICE VENT IN ADEQUATELY VENTILATED NON-ENCLOSED AREA

BURNS & MCDONNELL
STATE LICENSE #43

YEVGENIY KHISLAVSKIY
02/12/2020
KENTUCKY
SEAL 34514

PROFESSIONAL ENG/ARCH STAMP

PIEDMONT'S NATURAL GAS FACILITY DRAWINGS ARE CONSIDERED CONFIDENTIAL (OM-1095) * DRAWING IS CURRENT ONLY THROUGH THE LATEST REVISED DATE * TO ENSURE THERE IS NO RISK OF INAPPROPRIATE DISCLOSURE ALL PREVIOUS PAPER COPIES OF THIS DRAWING MUST BE DESTROYED IN ACCORDANCE WITH RECORDS & INFO. MANAGEMENT (RIM) POLICY 1001

REF. DWG(S)

NO.	DATE	REVISION(S) DESCRIPTION	BY	CHK	APPD	DESCRIPTION	DATE	INITIALS	APPROVALS
0	02-19-2021	ISSUED FOR AS-BUILT	MCR	KM	AHD	AREA CODE	-	N/A	N/A
						ACCOUNT NUMBER	-	N/A	N/A
						PROJECT NUMBER	V8351	N/A	N/A
						DRAWING BY	MCR	N/A	N/A
						STATION ID	-	N/A	N/A
						CHECKER INITIALS	KM	02-12-2020	YBK

COPYRIGHT 2018

UL60 PROJECTS
HAZARDOUS AREA CLASSIFICATION DETAILS
BOONE COUNTY, KY
ERLANGER, KY

SHEET(S)	1 OF 1	DWG SCALE	NONE
DWG DATE	04/30/2019	SUPERSEDED	-
DRAWING NUMBER		REVISION	
PNG - E-043-0001082		0	
DISCIPLINE / RESOURCE CENTER / LINE NUMBER			

- NOTES:**
- GROUNDING INSTALLATION MUST COMPLY WITH OSHA AND NATIONAL ELECTRICAL CODE REQUIREMENTS, EXCEPT WHERE LOCAL CODE PREVAILS.
 - A TEST MEASUREMENT OF THE RESISTANCE OF THE GROUNDING SYSTEM MUST BE TAKEN WHEN INSTALLED. IF THE RESISTANCE TO GROUND IS GREATER THAN 5 OHMS, ADDITIONAL GROUND RODS MUST BE INSTALLED UNTIL A COMBINED RESISTANCE OF 5 OHMS OR LESS IS OBTAINED.
 - WHERE GROUNDING CONDUCTORS ARE ROUTED EXPOSED, THEY MUST BE SECURED MINIMUM EVERY 24".
 - BILL OF MATERIAL SHALL BE AS DESCRIBED IN DETAIL OR APPROVED EQUAL BY OWNER PRIOR TO INSTALLATION.
 - CONTRACTOR SHALL SUPPLY AND INSTALL ALL MATERIALS UNLESS OTHERWISE NOTED.

ITEM	QTY.	DESCRIPTION (QUANTITY ARE FOR ONE INSTALLATION)
1	1	GROUNDING, POST BURNDY# GZ4C-12
2	1	GROUNDING, SERVIT POST BURNDY# KC23

DETAIL GD-04
SCALE: N.T.S.
EQUIPMENT GROUNDING

ITEM	QTY.	DESCRIPTION (QUANTITY ARE FOR ONE INSTALLATION)
1	A/R	EXOTHERMIC WELD, CABLE TO CABLE, CADWELD TYPE.
2	A/R	EXOTHERMIC WELD, TEE TYPE, BURNDY BCS-1 (OR) BCS-2 (OR) BCS-4

DETAIL GD-03
SCALE: N.T.S.
EXOTHERMIC WELD CONNECTION

ITEM	QTY.	DESCRIPTION (QUANTITY ARE FOR ONE INSTALLATION)
1	1	GROUND CONNECTOR BURNDY TYPE "YGHR-C"
2	1	GALV. STEEL COATED GROUND ROD, 3/4"x10'-0", 10MIL THICK MIN. COATED
3	1	8" X 1'-6" VITRIFIED CLAY PIPE

DETAIL GD-02
SCALE: N.T.S.
TEST WELL

ITEM	QTY.	DESCRIPTION (QUANTITY ARE FOR ONE INSTALLATION)
1	A/R	GALVANIZED STEEL COATED GROUND ROD, 3/4"x10'-0", 10MIL THICK MIN

DETAIL GD-01
SCALE: N.T.S.
GROUND ROD

ITEM	QTY.	DESCRIPTION (QUANTITY ARE FOR ONE INSTALLATION)
1	1	CONDUIT, 1" PVC, SCHEDULE 40 (LENGTH AS REQ.)
2	2	CONDUIT STRAP, 1", ONE HOLE, O-Z GEDNEY 14-100G
3	2	BOLT, 1/4"-20x1", CADMIUM-PLATED
4	2	ANCHOR, MASONRY, FOR 1/4"-20 BOLT, RAWL 9320
5	1	COMPRESSION LUG, TWO-HOLE, 2/0 AWG, BURNDY YA262LN
6	1	HEX SCREW, NUT 1/2-13 x 1" S.S

DETAIL GD-08
SCALE: N.T.S.
BUILDING GROUND PENETRATION

ITEM	QTY.	DESCRIPTION (QUANTITY ARE FOR ONE INSTALLATION)
1	1	CONDUIT, 1" PVC, SCHEDULE 40 (LENGTH AS REQ.)
2	2	CONDUIT STRAP, 1", ONE HOLE, O-Z GEDNEY 14-100G
3	2	BOLT, 1/4"-20x1", CADMIUM-PLATED
4	2	ANCHOR, MASONRY, FOR 1/4"-20 BOLT, RAWL 9320
5	1	COMPRESSION LUG, TWO-HOLE, 2/0 AWG, BURNDY YA262LN
6	1	HEX SCREW, NUT 1/2-13 x 1" S.S

DETAIL GD-07
SCALE: N.T.S.
BUILDING & SKID GROUNDING

ITEM	QTY.	DESCRIPTION (QUANTITY ARE FOR ONE INSTALLATION)
1	A/R	COPPER COMPRESSION TAP, BURNDY #YGH2C2
2	2	GROUND CONNECTOR, BURNDY TYPE GAR, SIZE AS REQ.D
3	1	EXOTHERMIC WELD, CABLE TO STEEL PIPE, TYPE BURNDY BCS-3 - NOTE 2

DETAIL GD-06
SCALE: N.T.S.
FENCE GROUNDING

ITEM	QTY.	DESCRIPTION (QUANTITY ARE FOR ONE INSTALLATION)
1	1	EXOTHERMIC WELD, CABLE TO STEEL PIPE, TYPE BURNDY BCS-3 - NOTE 2
2	1	FLEXIBLE COPPER BRAID, BURNDY TYPE BD, LENGTH AS REQUIRED
3	2	GROUND CONNECTOR, BURNDY TYPE GAR, SIZE AS REQ.D

DETAIL GD-05
SCALE: N.T.S.
GATE GROUNDING

REF. DWG(S)	SHEET(S) 1 OF 1	DWG SCALE NONE
	DWG DATE 07/09/2019	SUPERSEDED
	DRAWING NUMBER	REVISION
	PNG - E-043-0001083	0
DISCIPLINE / RESOURCE CENTER / LINE NUMBER		

UL60 PROJECTS
ELECTRICAL INSTALLATION DETAILS: GROUNDING
BOONE COUNTY, KY
ERLANGER, KY



PROPRIETARY & CONFIDENTIAL ALL RIGHTS RESERVED * DO NOT SCALE THIS DRAWING * USE DIMENSIONS ONLY
PIEDMONT'S NATURAL GAS FACILITY DRAWINGS ARE CONSIDERED CONFIDENTIAL (OM-1095) * DRAWING IS CURRENT ONLY THROUGH THE LATEST REVISED DATE * TO ENSURE THERE IS NO RISK OF INAPPROPRIATE DISCLOSURE ALL PREVIOUS PAPER COPIES OF THIS DRAWING MUST BE DESTROYED IN ACCORDANCE WITH RECORDS & INFO. MANAGEMENT (RIM) POLICY 1001

APPROVALS			
DATE	INITIALS	REGIONAL ENGINEER	
DATE	INITIALS	MGR TECH REC & STD	
DATE	INITIALS	PRINCIPAL ENGINEER	

NO.	DATE	REVISION(S) DESCRIPTION	BY	CHK	APPD	DESCRIPTION
0	02-19-2021	ISSUED FOR AS-BUILT	MCR	KM	AHD	AREA CODE - ACCOUNT NUMBER - PROJECT NUMBER V8351 DRAWING BY MCR STATION ID - CHECKER INITIALS KM

BURNS & MCDONNELL
STATE LICENSE #43

YEVGENIY KHISLAVSKIY
02/12/2020
KENTUCKY
SEAL 34514

PROFESSIONAL ENG/ARCH STAMP


NOTES:

- BILL OF MATERIAL SHALL BE AS DESCRIBED IN DETAIL OR APPROVED EQUAL BY OWNER PRIOR TO INSTALLATION.
- CONTRACTOR SHALL SUPPLY AND INSTALL ALL MATERIALS UNLESS OTHERWISE NOTES.

ITEM	QTY.	DESCRIPTION (QUANTITY ARE FOR ONE INSTALLATION)
1	1	WOOD POLE, SOUTHERN PINE, CLASS 2, 20 FT
2	A/R	UNISTRUT CHANNEL, P-1000, GALV. WITH HARDWARE
3	1	METER, 240V, 1Ø
4	3	MYERS HUB FITTING, ZINC, SIZE AS REQUIRED
5	A/R	STAPLE, 1/4" X 1/4"
6	A/R	TWO HOLE STRAP, R.G.S., 2"
7	1	WEATHERHEAD FITTING, 2", R.G.S.
8	A/R	COPPER COMPRESSION TAP, BURNDY TYPE #YGH, SIZE AS REQUIRED

ITEM	QTY.	DESCRIPTION
1	1	SQUARE HINGED STEEL POLE, 20' TALL, W/4" TENON, GRD. LUG, 12" BOLT CIRCLE, 1" DIA. BOLTS, VALMONT #DSF10-641A200
2	1	LOWERING WINCH VALMONT #M136 (ONLY ONE NEEDED PER SITE)


ITEM	QTY.	DESCRIPTION
1	4	FLOODLIGHT, C-H, #FMV-13L-C-Y/120 WITH FACTORY INSTALLED PHOTOCELL, CH #EV21H20
2	1	BULLHORN BRACKET, 4 TENON, 90°, 2 3/8" O.D. VALMONT #MX104-040-010

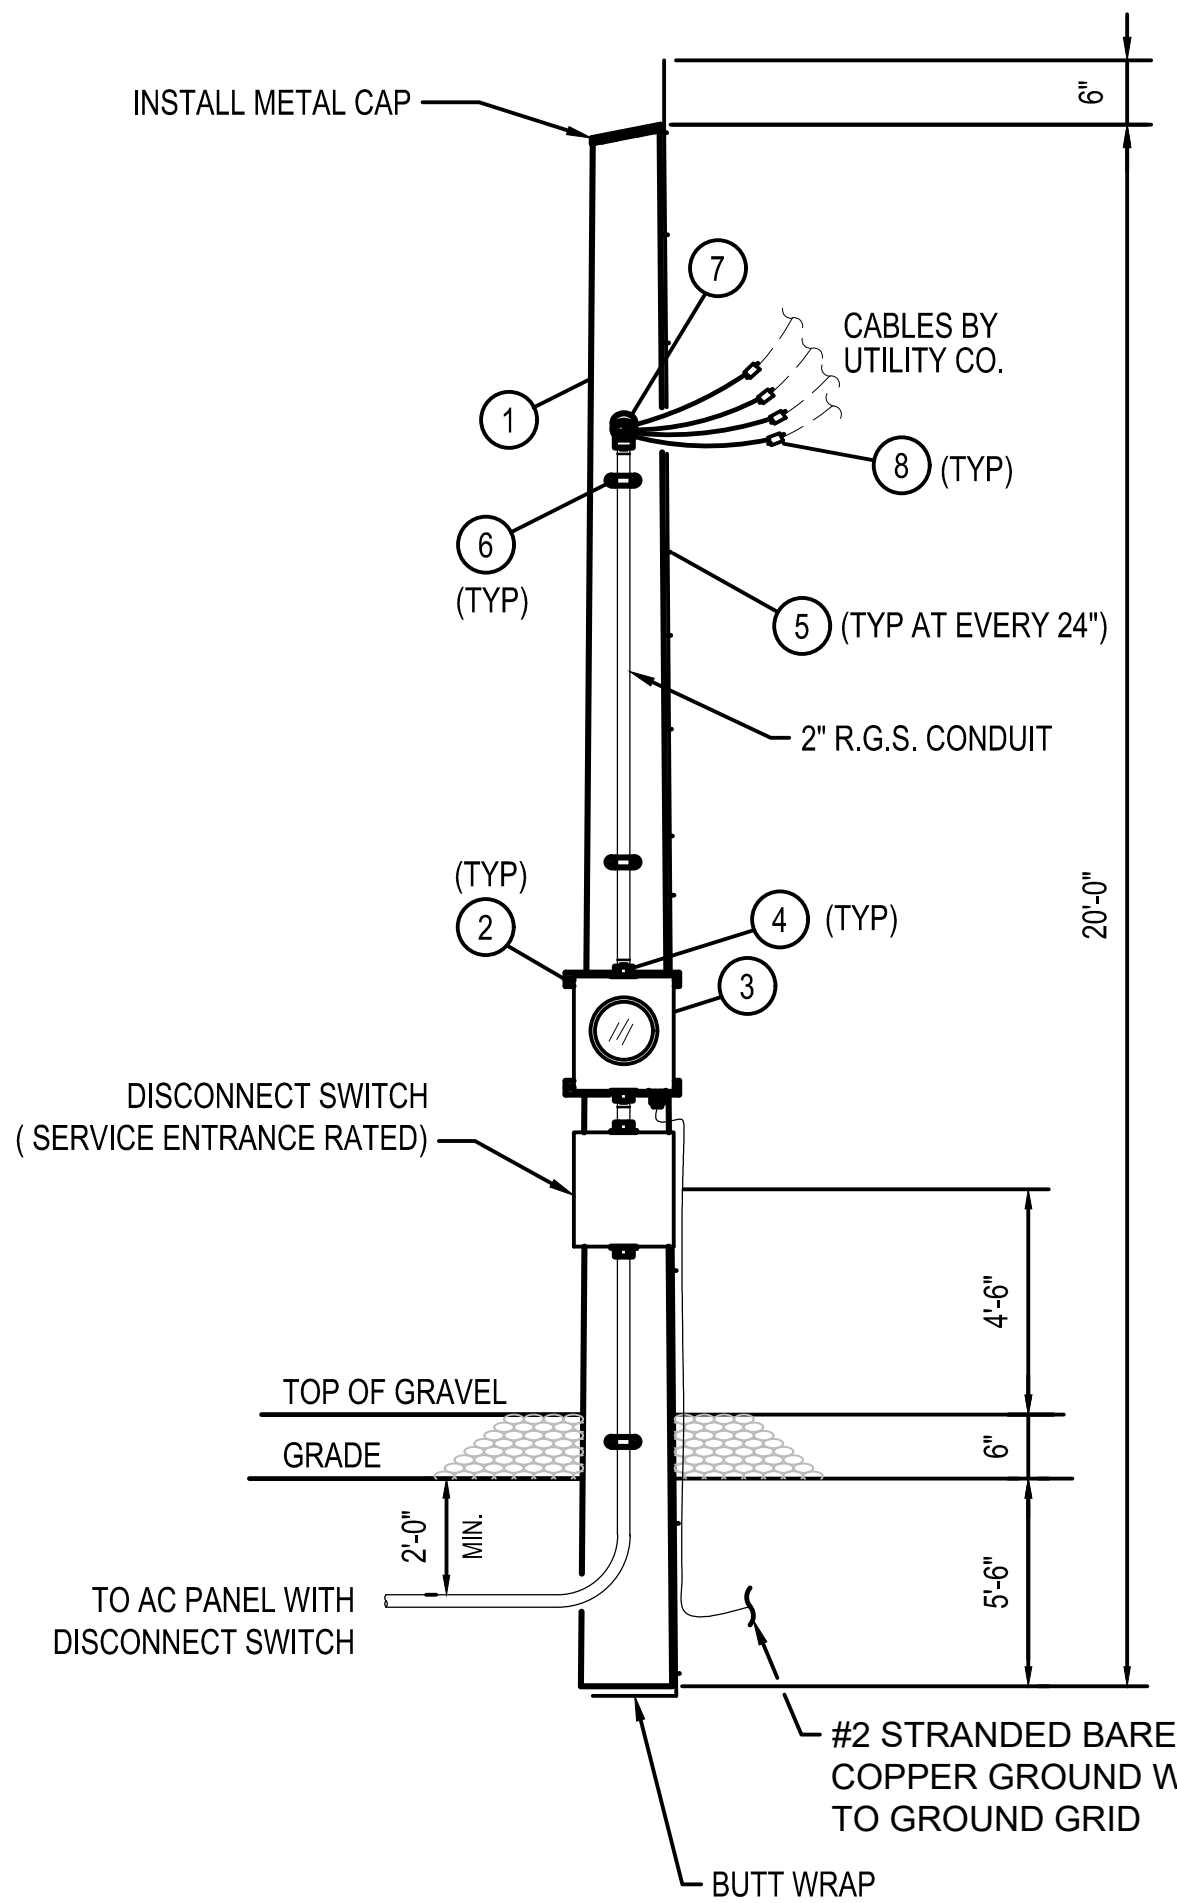

- NOTES:**
- CONTRACTOR SHALL RUN 2" EMPTY R.G.S. CONDUIT WITH PULL WIRE TO UTILITY POWER SUPPLY POLE, TERMINATE CONDUIT 5'-0" ABOVE GRADE. UTILITY COMPANY WILL FURNISH AND PULL WIRE.


DETAIL 1
SCALE: N.T.S.
POLE / METER INSTALLATION FOR OVERHEAD POWER SUPPLY

TYPICAL DUKE METER RACK DESIGN. TO BE INSTALL AND COORDINATE BY DUKE'S FIELD CONTRACTOR

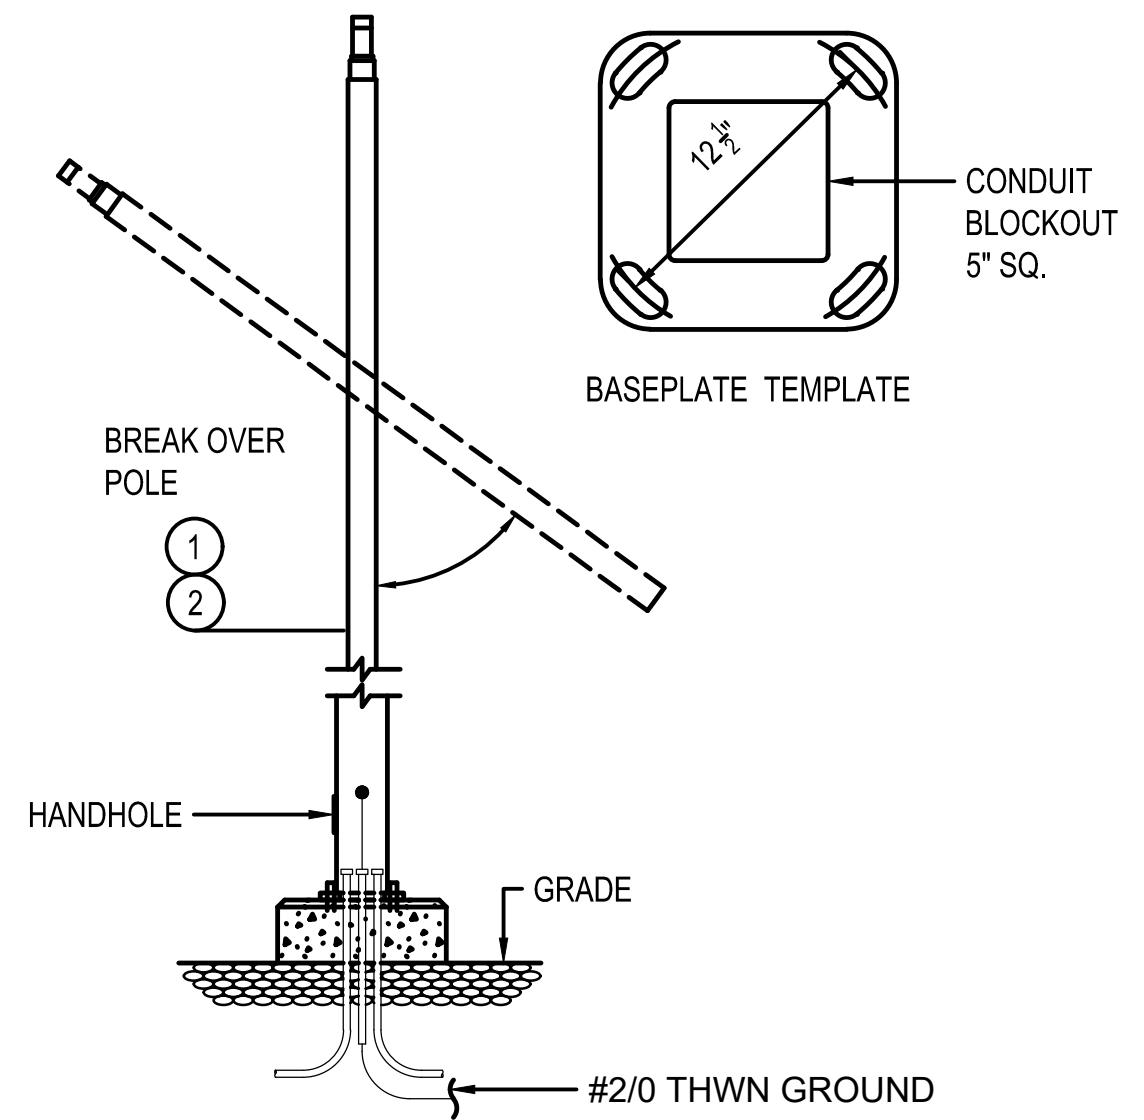


- NOTES:**
- REFER TO STRUCTURAL DETAILS FOR FOUNDATION DESIGN
 - LIGHT POLE IS BREAK OVER POLE. CONTRACTOR SHALL INSTALL LIGHT POLE WITH 30° CLEARANCE IN THE DIRECTION THAT THE LIGHT POLE SHALL SWING DOWNWARD. NO STRUCTURE SHALL BE ON THE PATH WHERE LIGHT POLE SWING DOWNWARD.

DETAIL LT-02
SCALE: N.T.S.
LIGHT FIXTURE

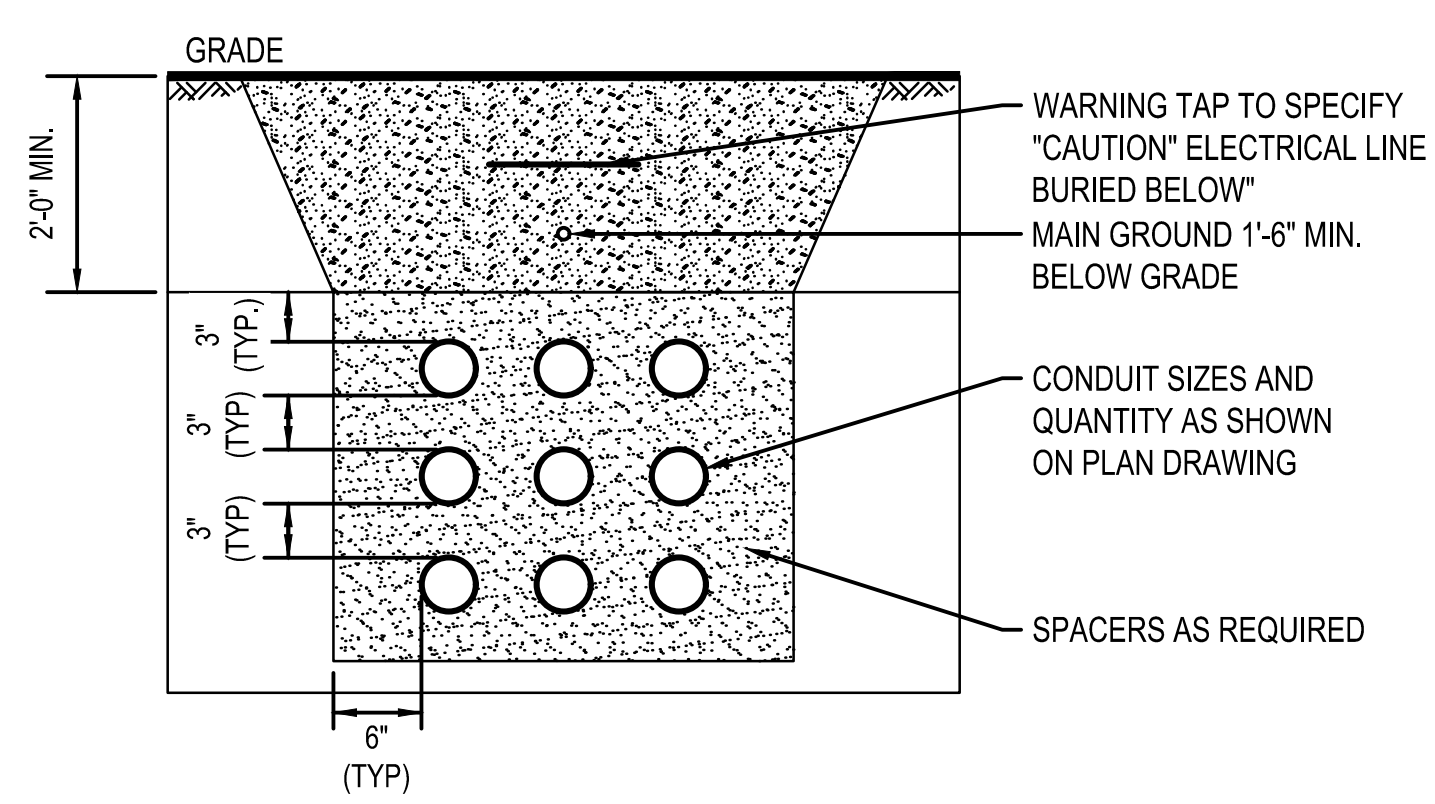


- NOTES:**
- RESTORE SURFACE (GRADE) TO EXISTING CONDITIONS.
 - FOR PAVEMENT REPLACEMENT, THICKNESS OF ALL REPLACEMENT COURSES SHALL BE EQUAL TO EXISTING BUT ASPHALTIC CONCRETE SHALL NOT BE LESS THAN 2 INCHES AND AGGREGATE BASE COURSE SHALL NOT BE LESS THAN 6 INCHES. EXISTING PAVEMENT TO BE REMOVED SHALL BE SAWCUT. EXTEND AGGREGATE BASE COURSE 1'-0" BEYOND EXCAVATION LIMITS AND EXTEND ASPHALTIC CONCRETE 1'-0" BEYOND THE AGGREGATE BASE COURSE LIMITS. APPLY TACK COAT TO THE EXPOSED EXISTING ASPHALTIC CONCRETE SURFACES.

DETAIL EL-01
SCALE: NOT TO SCALE
TYPICAL DIRECT BURIED CONDUIT

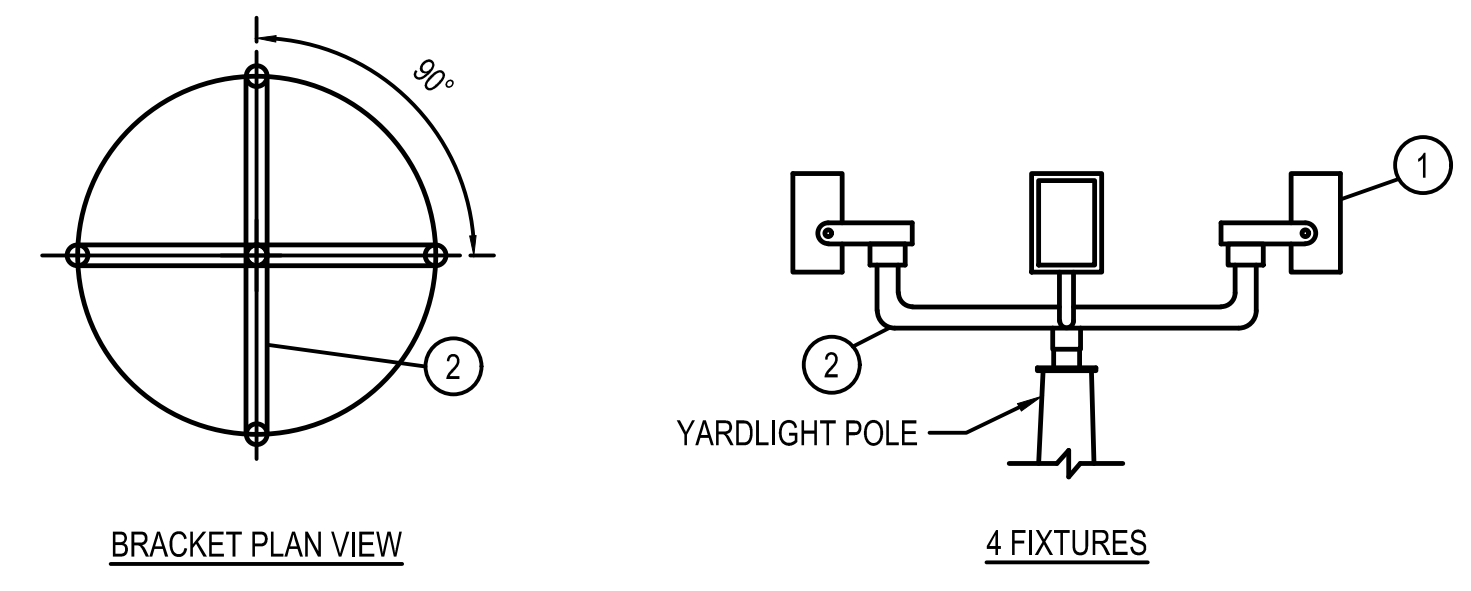

DETAIL LT-02
SCALE: N.T.S.
LIGHT FIXTURE

ITEM	QTY.	DESCRIPTION (ALL MANUFACTURERS ARE "OR EQUAL")	ITEM	QTY.	DESCRIPTION (ALL MANUFACTURERS ARE "OR EQUAL")
1	1	PANELBOARD, NEMA 3R ENCLOSURE, 100A MAIN BREAKER, 18 CIRCUITS MAXIMUM, 120/240V, WITH NEUTRAL BUS, 4-20A SINGLE POLE CIRCUIT BREAKER, SQUARE D TYPE NQOD	5	3	CONDUIT COUPLING, R.G.S., SIZE AS REQUIRED
2	1	EXOTHERMIC WELD, CABLE TO STEEL PIPE, TYPE BURNDY BCS-3	6	A/R	UNISTRUT CHANNEL, P-1000, GALV. WITH HARDWARE
3	3	"DRAIN SEAL FITTING, M/F, SIZE AS REQUIRED, CROUSE-HINDS TYPE EYD	7	A/R	WIDE FLANGE, W6X12, ASTM A36
4	4	MYERS HUB FITTING, ZINC, SIZE AS REQUIRED	8	A/R	PLATE C.S. 1/2", ASTM A36
			9	A/R	C.S. ANGLE 2" x 2" x 1/4"
			10	4	H.H. 1/2" NUT, ASTM A325

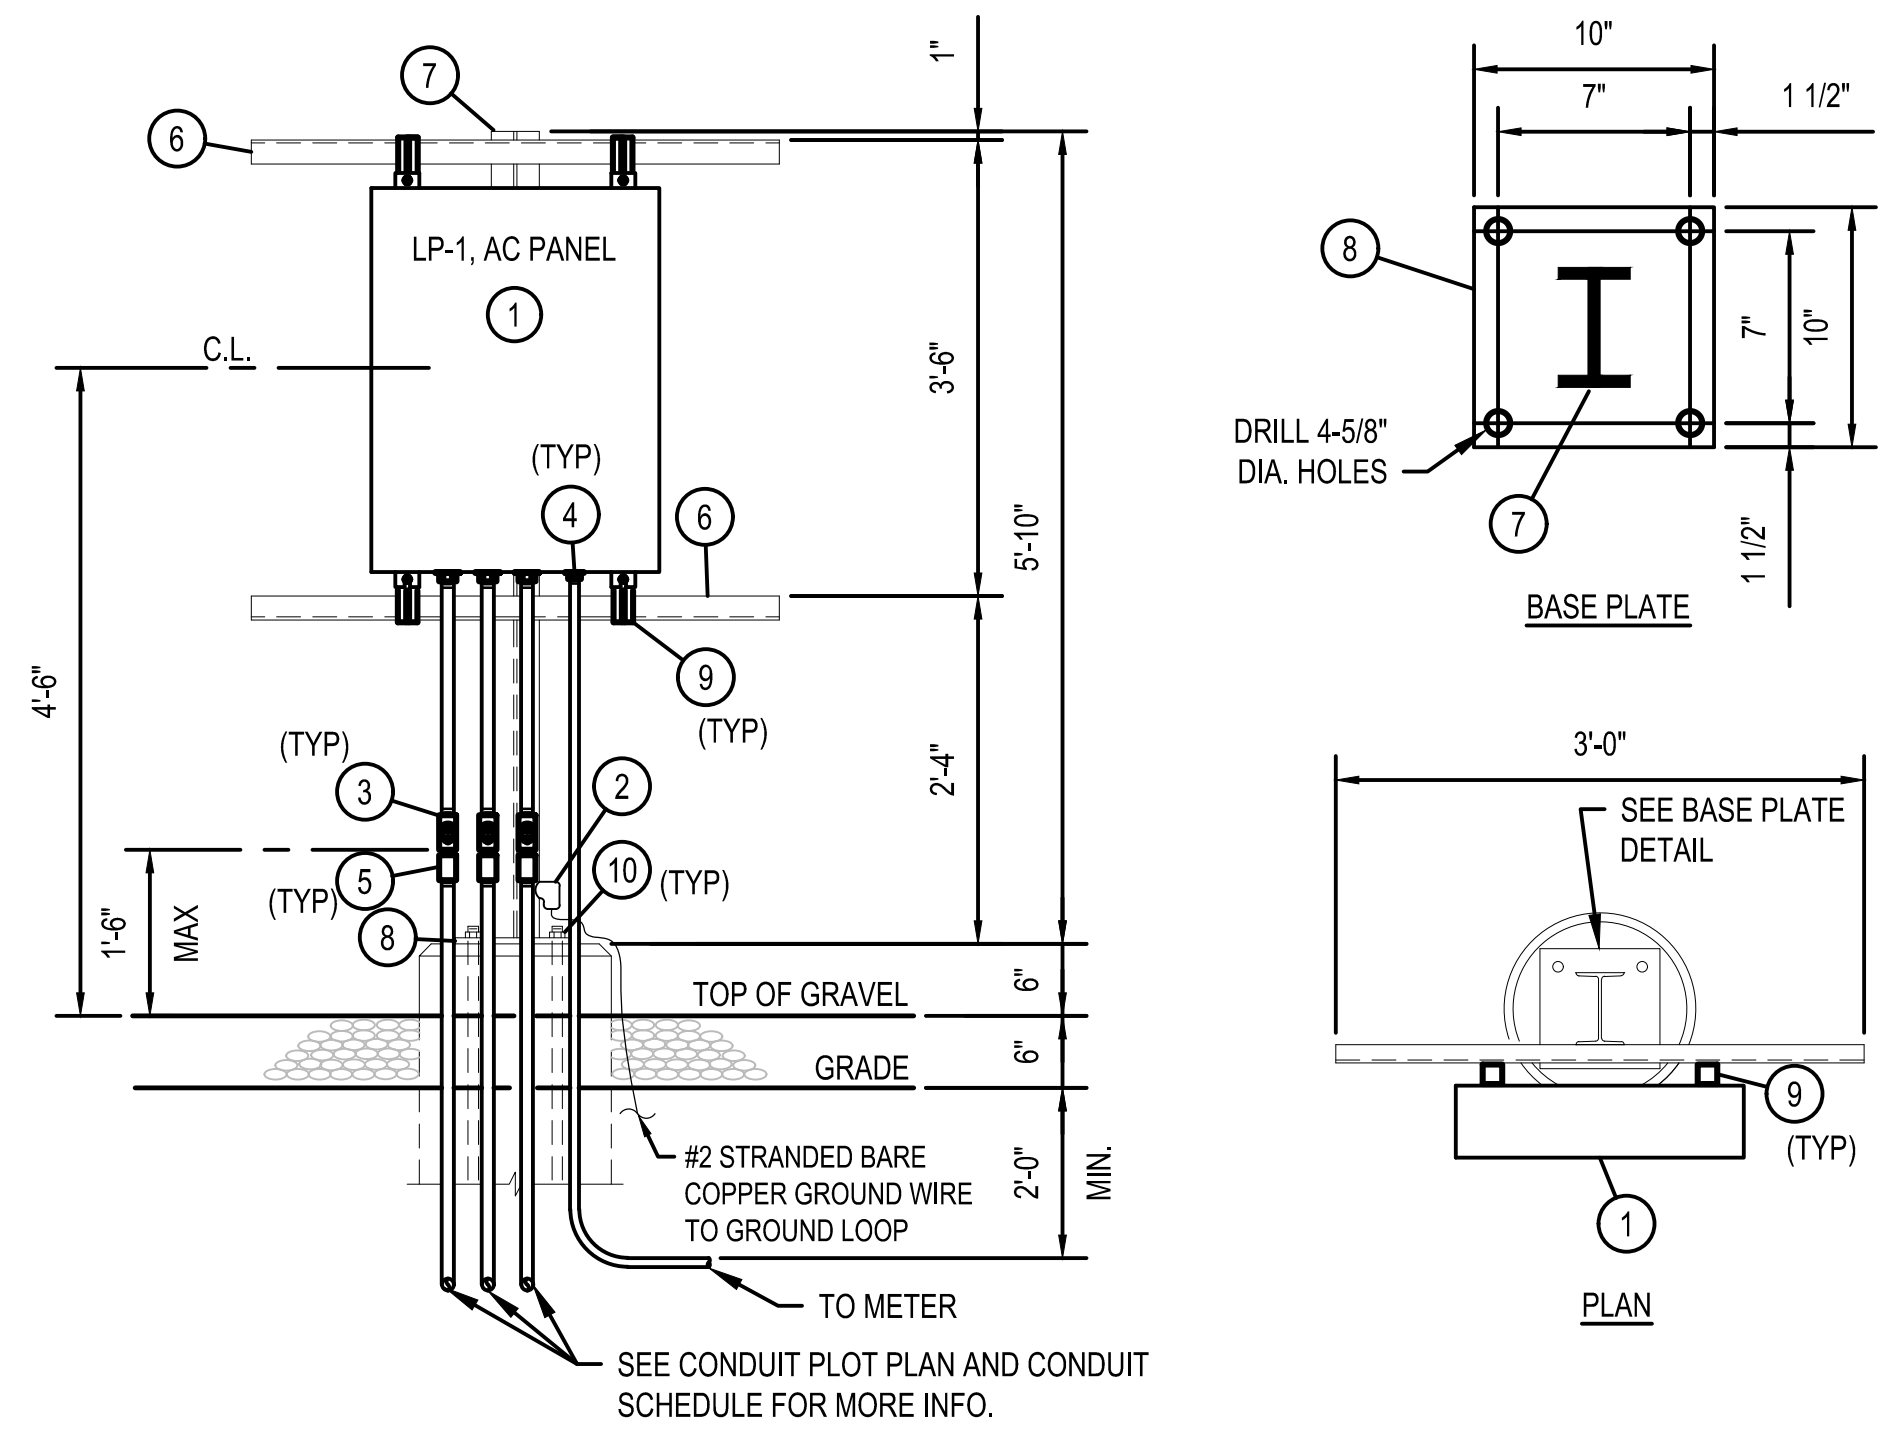

DETAIL 2
SCALE: NOT TO SCALE
PNG-E-043-0001002
TYPICAL AC PANEL INSTALLATION

BURNS & MCDONNELL
STATE LICENSE #43

YEVGENIY KHISLAVSKIY
02/12/2020
KENTUCKY
SEAL 34514

PROFESSIONAL ENG/ARCH STAMP

PIEDMONT'S NATURAL GAS FACILITY DRAWINGS ARE CONSIDERED CONFIDENTIAL (OM-1095) * DRAWING IS CURRENT ONLY THROUGH THE LATEST REVISED DATE * TO ENSURE THERE IS NO RISK OF INAPPROPRIATE DISCLOSURE ALL PREVIOUS PAPER COPIES OF THIS DRAWING MUST BE DESTROYED IN ACCORDANCE WITH RECORDS & INFO. MANAGEMENT (RIM) POLICY 1001

REF. DWG(S)

NO.	DATE	REVISION(S) DESCRIPTION	BY	CHK	APPD	DESCRIPTION	DATE	INITIALS	APPROVALS
0	02-19-2021	ISSUED FOR AS-BUILT	MCR	KM	AHD	AREA CODE	-	N/A	REGIONAL ENGINEER
						ACCOUNT NUMBER	-	N/A	MGR TECH REC & STD
						PROJECT NUMBER	V8351	N/A	PRINCIPAL ENGINEER
						DRAWING BY	MCR	YBK	
						STATION ID	-		
						CHECKER INITIALS	KM		



UL60 PROJECTS
ELECTRICAL INSTALLATION DETAILS: MISCELLANEOUS
BOONE COUNTY, KY
ERLANGER, KY

SHEET(S)	1 OF 1	DWG SCALE	NONE
DWG DATE	07/09/2019	SUPERSEDED	-
DRAWING NUMBER	PNG - E-043-0001084		
REVISION	0		
DISCIPLINE / RESOURCE CENTER / LINE NUMBER			

NOTES:

- BILL OF MATERIAL SHALL BE AS DESCRIBED IN DETAIL OR APPROVED EQUAL BY OWNER PRIOR TO INSTALLATION.
- CONTRACTOR SHALL SUPPLY AND INSTALL ALL MATERIALS UNLESS OTHERWISE NOTED.

ITEM	QTY	DESCRIPTION (ALL MANUFACTURERS ARE "OR EQUAL")
1	1	CONDUIT SEAL, MF, 3/4", CROUSE-HINDS #EYS216
2	1	EXPLOSION PROOF FLEX COUPLING, MF, 3/4", 8" LONG, CROUSE-HIND #ECLK28
3	1	CONDULET W/2-3/4" HUBS, CROUSE-HINDS #QUAL26
4	1	CONDUIT UNION, 3/4", CROUSE-HINDS #UNY205

ELECTRICAL DETAIL FOR INSTRUMENT WITHOUT PIG-TAIL
(CLASS 1, DIVISION 1 AREA)

DETAIL 1
SCALE: N.T.S.

ITEM	QTY	DESCRIPTION (QUANTITY FOR ONE INSTALLATION)
1	1	DRAIN SEAL FITTING, MF, SIZE A/R, CROUSE-HINDS TYPE EYD
2	1	CONDUIT COUPLING, R.G.S., SIZE AS REQ'D
3	1	REDUCING BUSHING, 1" X 3/4" (FOR DETAIL 1 ONLY)

TO INSTRUMENT
SEE DETAILS 1 THIS SHEET

CLASS 1, DIV. 2
UNCLASSIFIED
1'-6" MAX.
2'-0" MIN.
TOP OF GRAVEL
GRADE

FOR DETAIL 1 THIS DWG.

TYPICAL CONDUIT STUB-UP

DETAIL 2
SCALE: N.T.S.

ITEM	QTY	DESCRIPTION (QUANTITY FOR ONE INSTALLATION)
1	1	1/2" TUBE TEE, 316 S.S.
2	1	1/2" TUBE CAP, 316 S.S.
3	2	1/2" T x 1/2" N.P.T. MALE CONNECTOR, 316 S.S.
4	A/R	1/2" O.D. x .035" WALL 316 S.S. TUBING SMLS

VALVE ACTUATOR
NOTE 1
1/2"
TO PROCESS LINE
BY PIPING

NOTES:
1. SLOPE TUBING DOWN TO DRAIN VALVE 1" PER 1'-0" MIN., DO NOT POCKET.
2. SUPPORT INSTRUMENT TUBING AT TAPS AND AT 5'-0" INTERVALS.

INSTRUMENT INSTALLATION DETAIL
INSTRUMENT MOUNTED ABOVE
PROCESS LINE

DETAIL 3
SCALE: N.T.S.

VERTICAL MOUNT
HORIZONTAL MOUNT

PRESSURE GAUGE WITH BALL VALVE

DETAIL 4
SCALE: N.T.S.

ITEM	QTY	DESCRIPTION (QUANTITY FOR ONE INSTALLATION)
1	1	TUBE CONNECTOR, MALE 316SS, 1/2" T x 1/2" MNPT, SWAGelok
2	1	TUBE CONNECTOR, MALE 316SS, 1/2" T x 3/4" MNPT, SWAGelok
3	A/R	TUBING, 316SS SEAMLESS, 1/2" O.D. x 0.035", ASTM A-269

PIPING INSTRUMENTATION
VERTICAL VESSEL OR LINE TAPS
PIT
ELECTRICAL CONNECTION
2" PIPE STAND
MANIFOLD VALVE FURNISHED WITH TRANSMITTER 1/2" MNPT CONNECTIONS
SLOPE
3/4" INSTRUMENTATION PIPING
VERTICAL VESSEL OR LINE TAPS

PRESSURE TRANSMITTER

DETAIL 5
SCALE: N.T.S.

ITEM	QTY	DESCRIPTION (QUANTITY FOR ONE INSTALLATION)
1	A/R	2-3/8" O.D., SCH 80, HOT-DIPPED GALVANIZED STEEL PIPE
2	A/R	2"x2" NOMINAL, 5/16" THICK, SQUARE TUBING
3	1	9"x9", 3/8" THICK PLATE
4	2	2-3/8", 1/4" THICK CAP PLATE
5	2	2-5/8"x2-5/8", 1/4" THICK CAP PLATE

2'-0"
2"
10"
10"
2"
1'-0"
5'-0"
4'-0"
2"
10"
2"
1"
7"
1"
5/8" Ø HOLES (TYP. 4)
4 1/2"
9"
4 1/2"
1"9"

SIDE VIEW
FRONT VIEW
BASE PLATE (SEE BASE PLATE DETAIL)
BASE PLATE DETAIL

DUAL / TRIPLE INSTRUMENT SUPPORT WITH PIPE STAND

DETAIL 6
SCALE: N.T.S.

BURNS & MCDONNELL STATE LICENSE #43
YEVGENIY KHISLAVSKIY 02/12/2020 KENTUCKY SEAL 34514
PROFESSIONAL ENG/ARCH STAMP

PIEDMONT'S NATURAL GAS FACILITY DRAWINGS ARE CONSIDERED CONFIDENTIAL (OM-1095) * DRAWING IS CURRENT ONLY THROUGH THE LATEST REVISED DATE * TO ENSURE THERE IS NO RISK OF INAPPROPRIATE DISCLOSURE ALL PREVIOUS PAPER COPIES OF THIS DRAWING MUST BE DESTROYED IN ACCORDANCE WITH RECORDS & INFO. MANAGEMENT (RIM) POLICY 1001

REF. DWG(S) -

NO.	DATE	REVISION(S) DESCRIPTION	BY	CHK	APPD	DESCRIPTION	DATE	INITIALS	APPROVALS
0	02-19-2021	ISSUED FOR AS-BUILT	MCR	KM	AHD	AREA CODE	-	N/A	REGIONAL ENGINEER
						ACCOUNT NUMBER	-	N/A	MGR TECH REC & STD
						PROJECT NUMBER	V8351	N/A	PRINCIPAL ENGINEER
						DRAWING BY	MCR	YBK	
						STATION ID	-		
						CHECKER INITIALS	KM		

SHEET(S)	1 OF 1	DWG SCALE	NONE
DWG DATE	07/09/2019	SUPERSEDED	-
DRAWING NUMBER		REVISION	
PNG - E-043-0001085		0	
DISCIPLINE / RESOURCE CENTER / LINE NUMBER			



UL60 PROJECTS
INSTRUMENT INSTALLATION DETAILS
BOONE COUNTY, KY
ERLANGER, KY