

WOOD CREEK WATER DISTRICT
KY 490 / US 25 N. WATERLINE REPLACEMENT
LAUREL COUNTY, KENTUCKY




KENVIRONS, INC.
 FRANKFORT, KENTUCKY



PROJECT NO
2017036

SHEET NO
11

KY 490

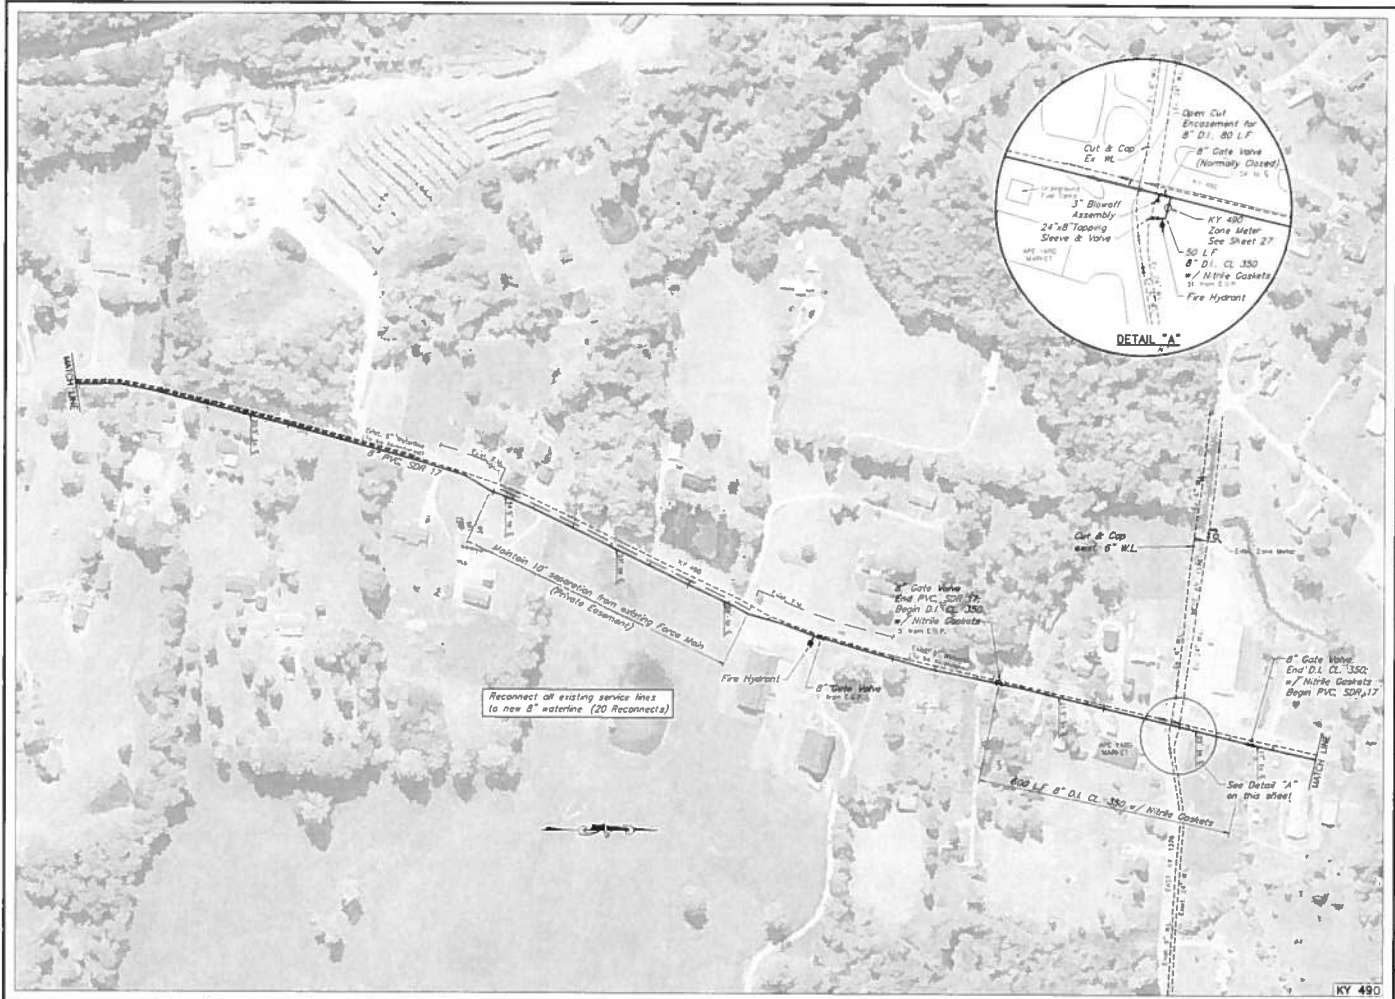

WOOD CREEK WATER DISTRICT
 KY 490 / US 25 N. WATERLINE REPLACEMENT
 LAUREL COUNTY, KENTUCKY



DATE	DESCRIPTION
12/15/2023	ISSUED FOR PERMIT
12/15/2023	ISSUED FOR CONSTRUCTION
12/15/2023	ISSUED FOR RECORD


KENVIRONS, INC.
 FRANKFORT, KENTUCKY



PROJECT NO.
2017036
 SHEET NO.
12

KY 490

\\p01\proj\2017036\2017036.dwg, 13/07/2017 10:00:00 AM, 13/07/2017 10:00:00 AM

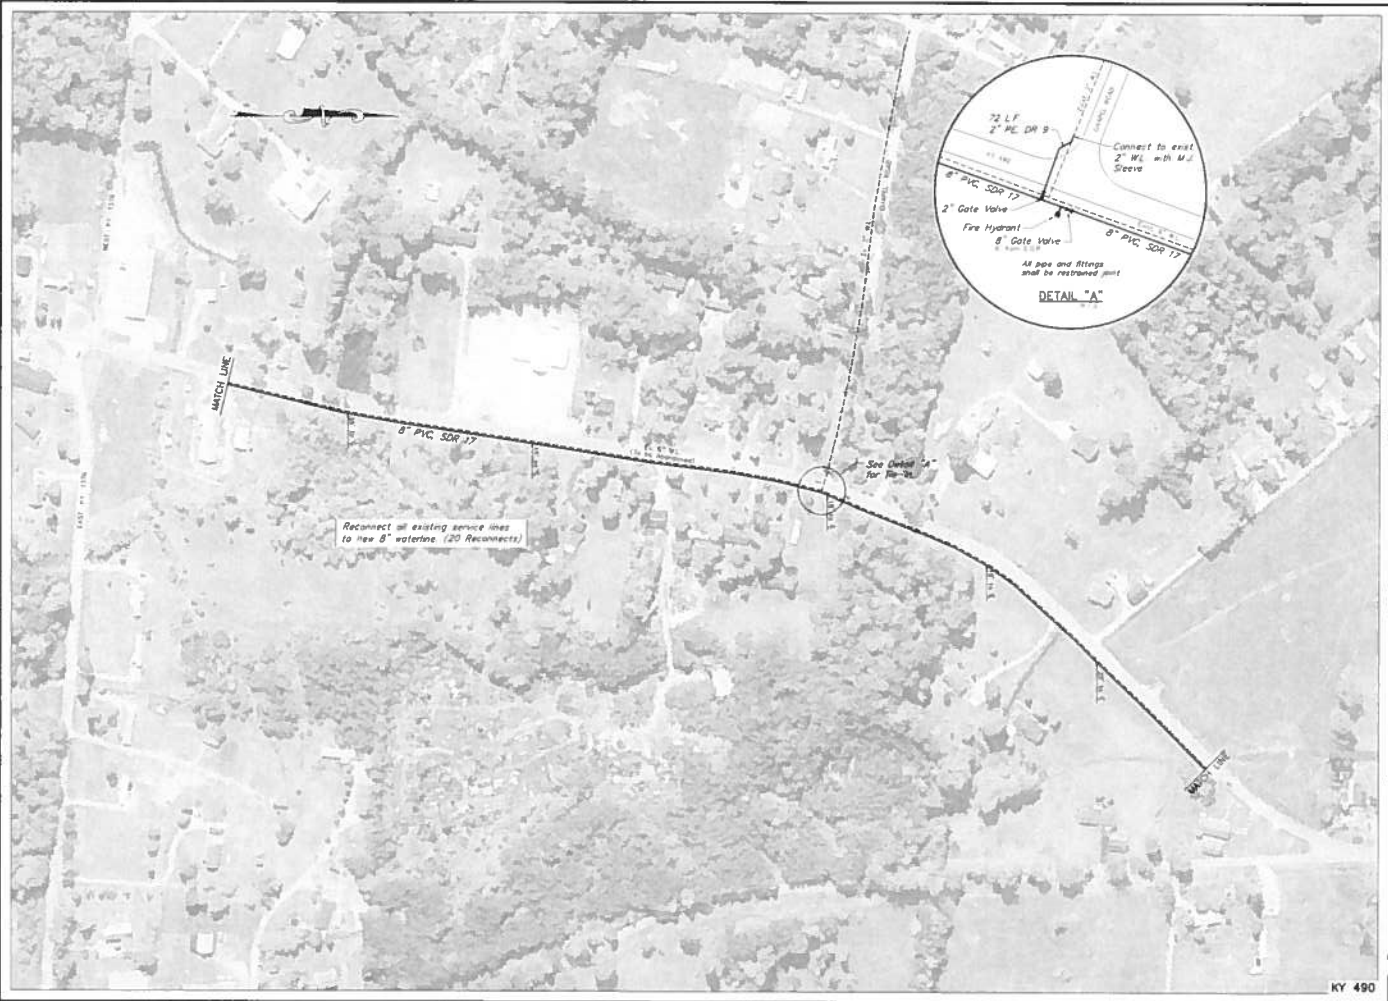

KY 490

WOOD CREEK WATER DISTRICT
KY 490 / US 25 N. WATERLINE REPLACEMENT
LAUREL COUNTY, KENTUCKY






DATE	10/10/17
BY	Ken Virons
CHECKED	
DATE	
BY	
CHECKED	
DATE	
BY	

KENVIRONS, INC.
 FRANKFORT, KENTUCKY



PROJECT NO
2017036

SHEET NO
13

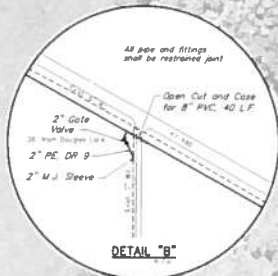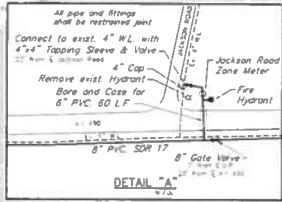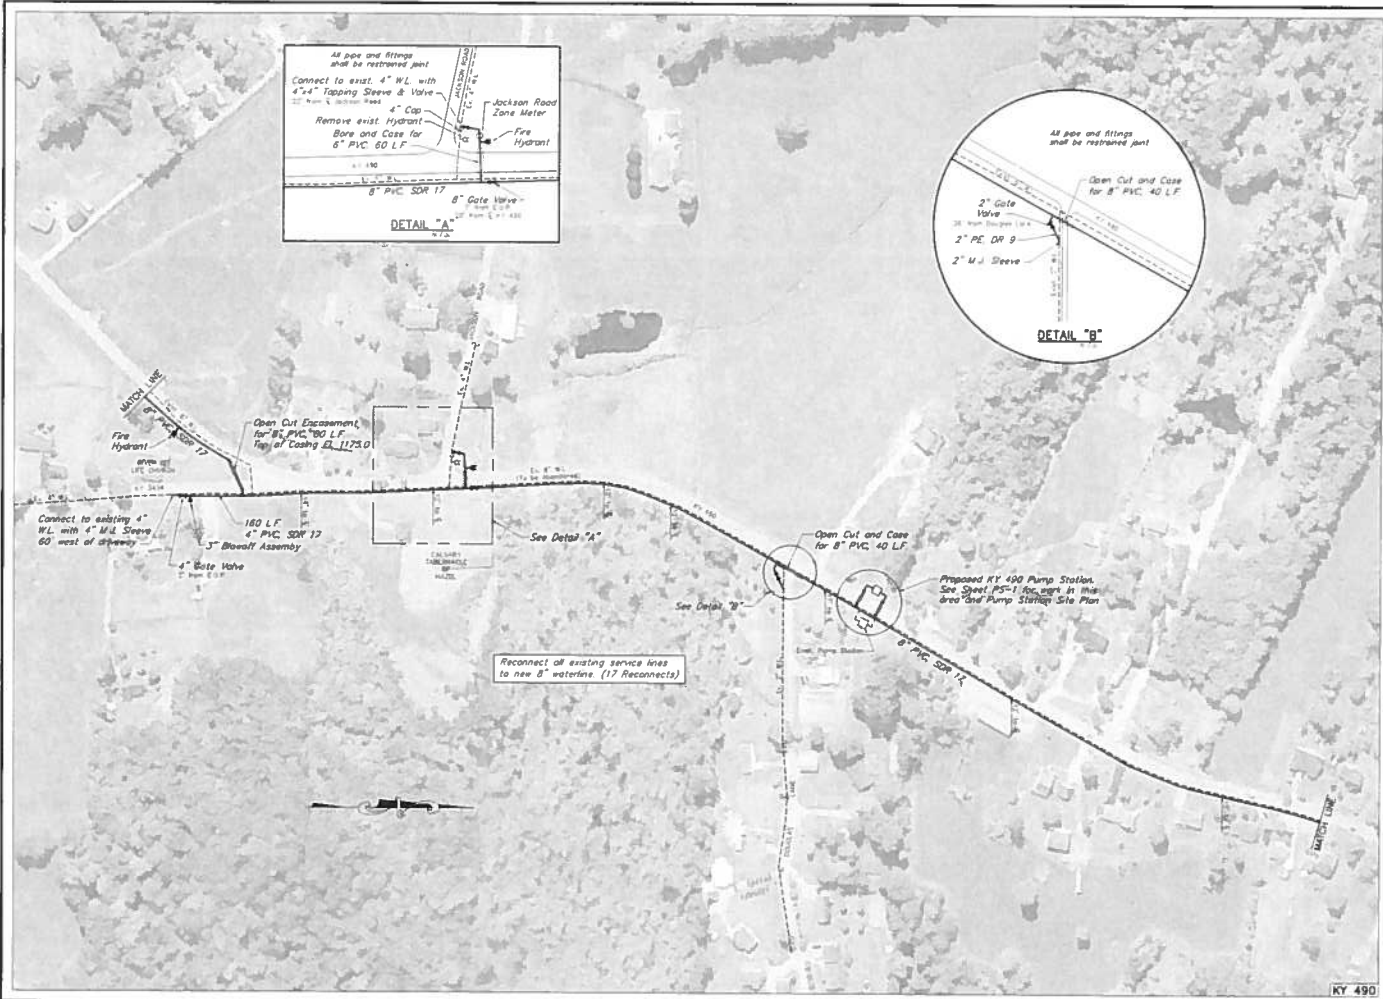

WOOD CREEK WATER DISTRICT
 KY 490 / US 25 N. WATERLINE REPLACEMENT
 LAUREL COUNTY, KENTUCKY



DATE	DESCRIPTION

KENVIRONS, INC.
 FRANKFORT, KENTUCKY



PROJECT NO
2017036
 SHEET NO
14

KY 490

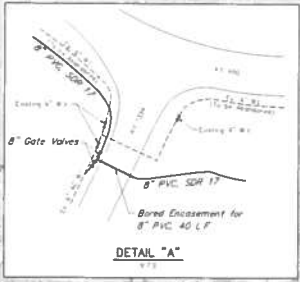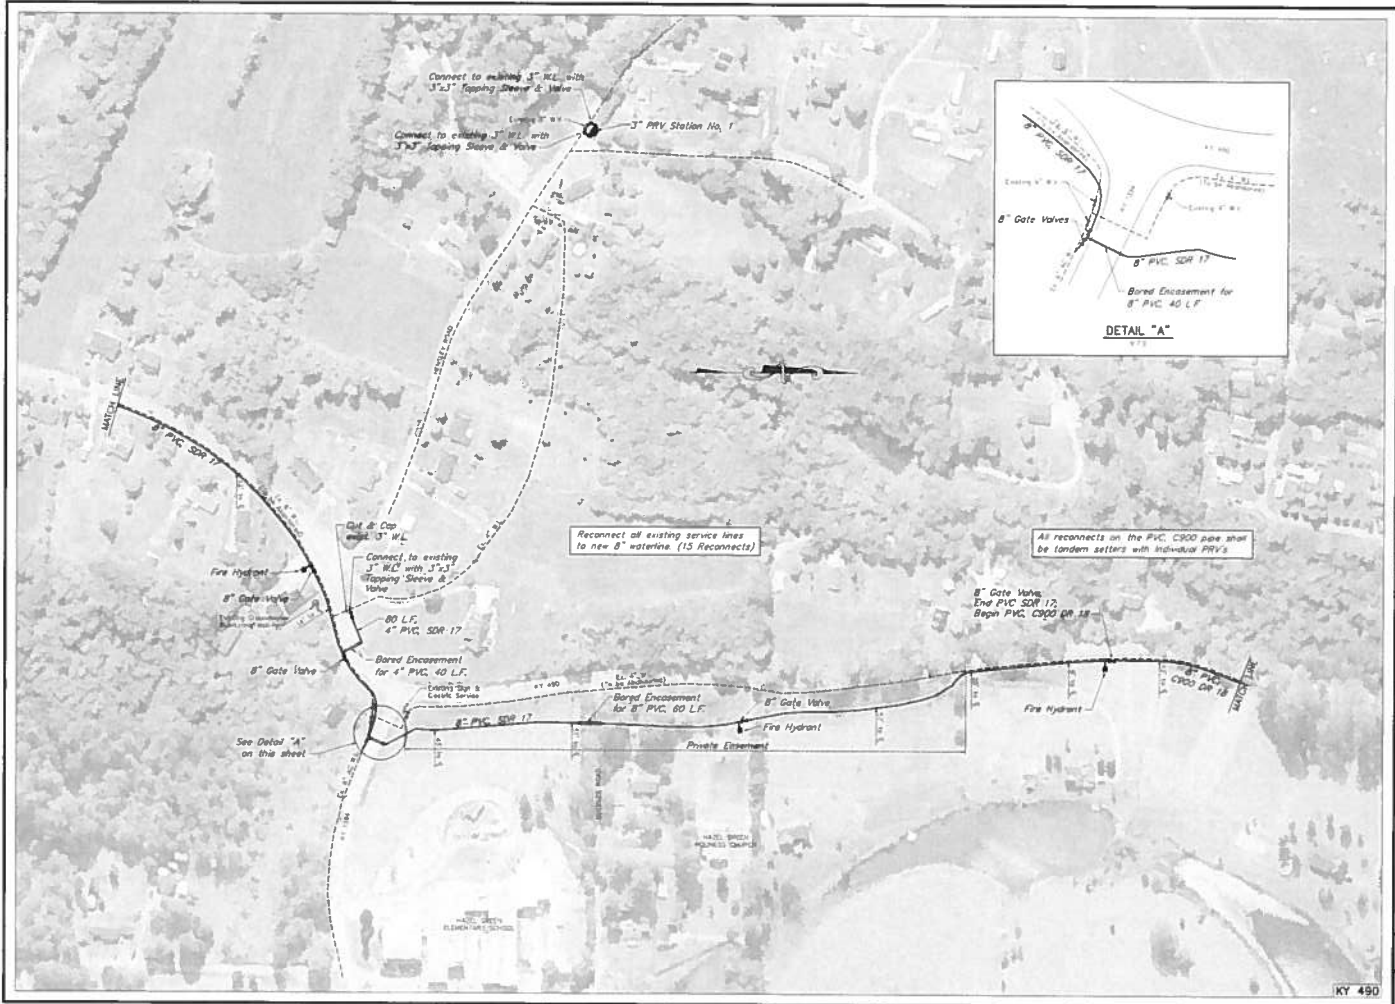

WOOD CREEK WATER DISTRICT
 KY 490 / US 25 N. WATERLINE REPLACEMENT
 LAUREL COUNTY, KENTUCKY


DATE	BY	REVISION

KENVIRONS, INC.
 FRANKFORT, KENTUCKY



PROJECT NO
2017036
 SHEET NO
15

KY 490

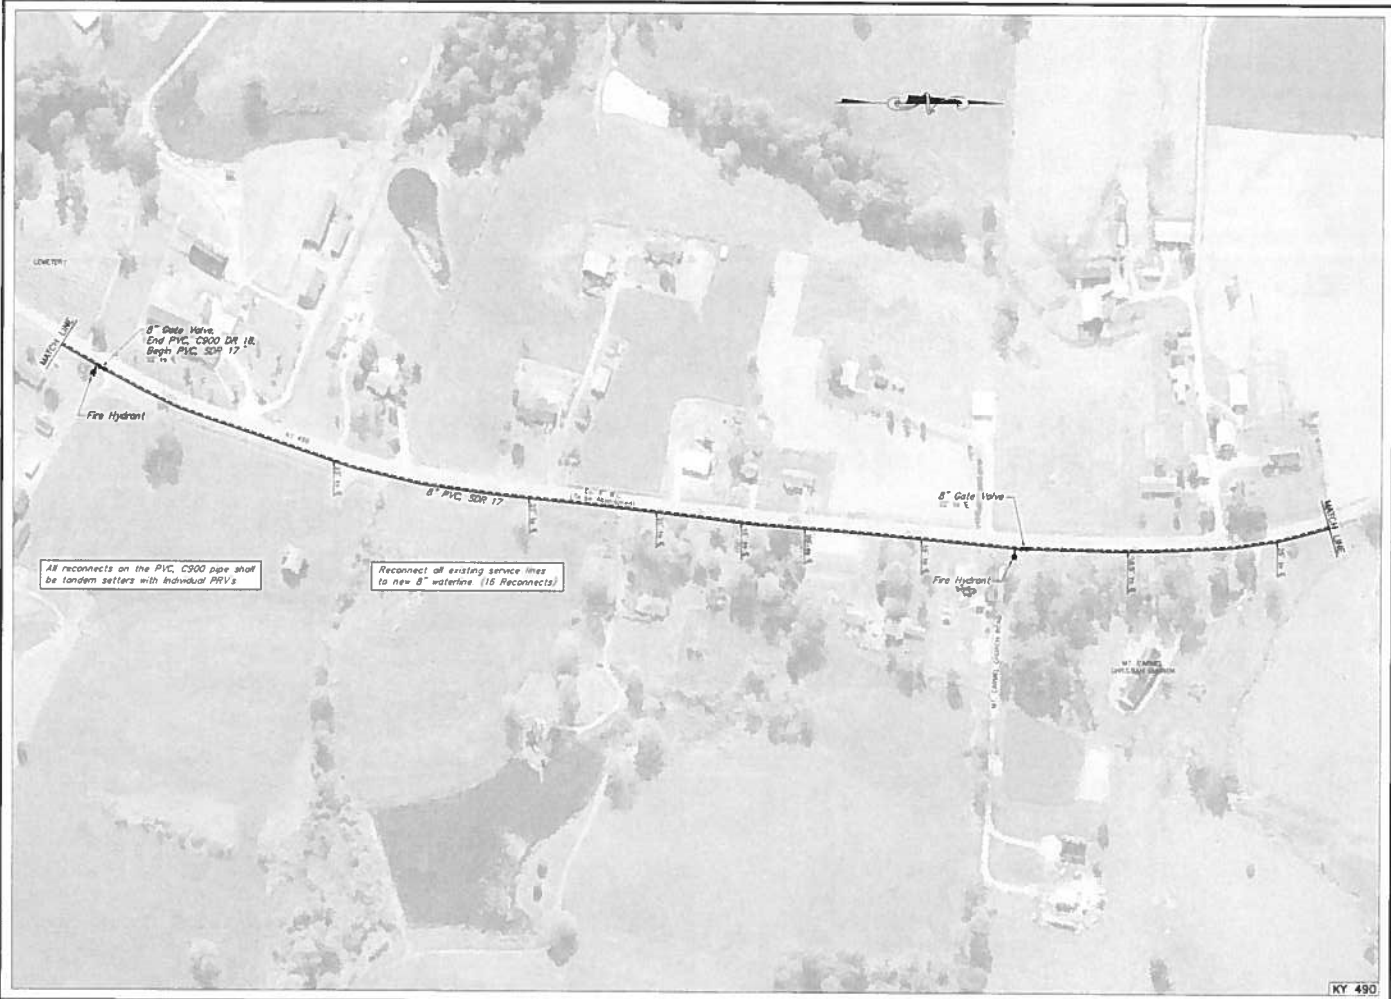

WOOD CREEK WATER DISTRICT
 KY 490 / US 25 N. WATERLINE REPLACEMENT
 LAUREL COUNTY, KENTUCKY

DATE	DESCRIPTION

KENVIRONS, INC.
 FRANKFORT, KENTUCKY



PROJECT NO
 2017036
 SHEET NO
 17

KY 490

Small vertical text at the bottom left corner, likely a scale or reference note.