


KENTUCKY-AMERICAN WATER COMPANY MILLERSBURG WATER SUPPLY PROJECT BOURBON COUNTY, KENTUCKY

PREPARED BY:



LEGEND:

- SIGN
- SANITARY SEWER MANHOLE
- STORM SEWER MANHOLE
- TELE/COMM BOX
- GAS VALVE
- GUY WIRE
- UTILITY POLE
- UTILITY/TRAFFIC POLE WITH EQUIPMENT
- LIGHT POLE
- ELECTRIC BOX
- ELECTRIC METER
- BENCHMARK
- WATER METER
- WATER VALVE
- FIRE HYDRANT
- RIGHT OF WAY MONUMENT
- TREE LINE
- FENCE
- RIGHT OF WAY LINE
- OVERHEAD ELECTRIC
- UNDERGROUND ELECTRIC
- GAS
- SANITARY SEWER
- STORM SEWER
- OVERHEAD WIRE
- OVERHEAD TELE/COMM
- PARCEL LINE/PROPERTY/ROW BOUNDARY
- WATER LINE
- EDGE OF SURFACE WATER
- GUARDRAIL

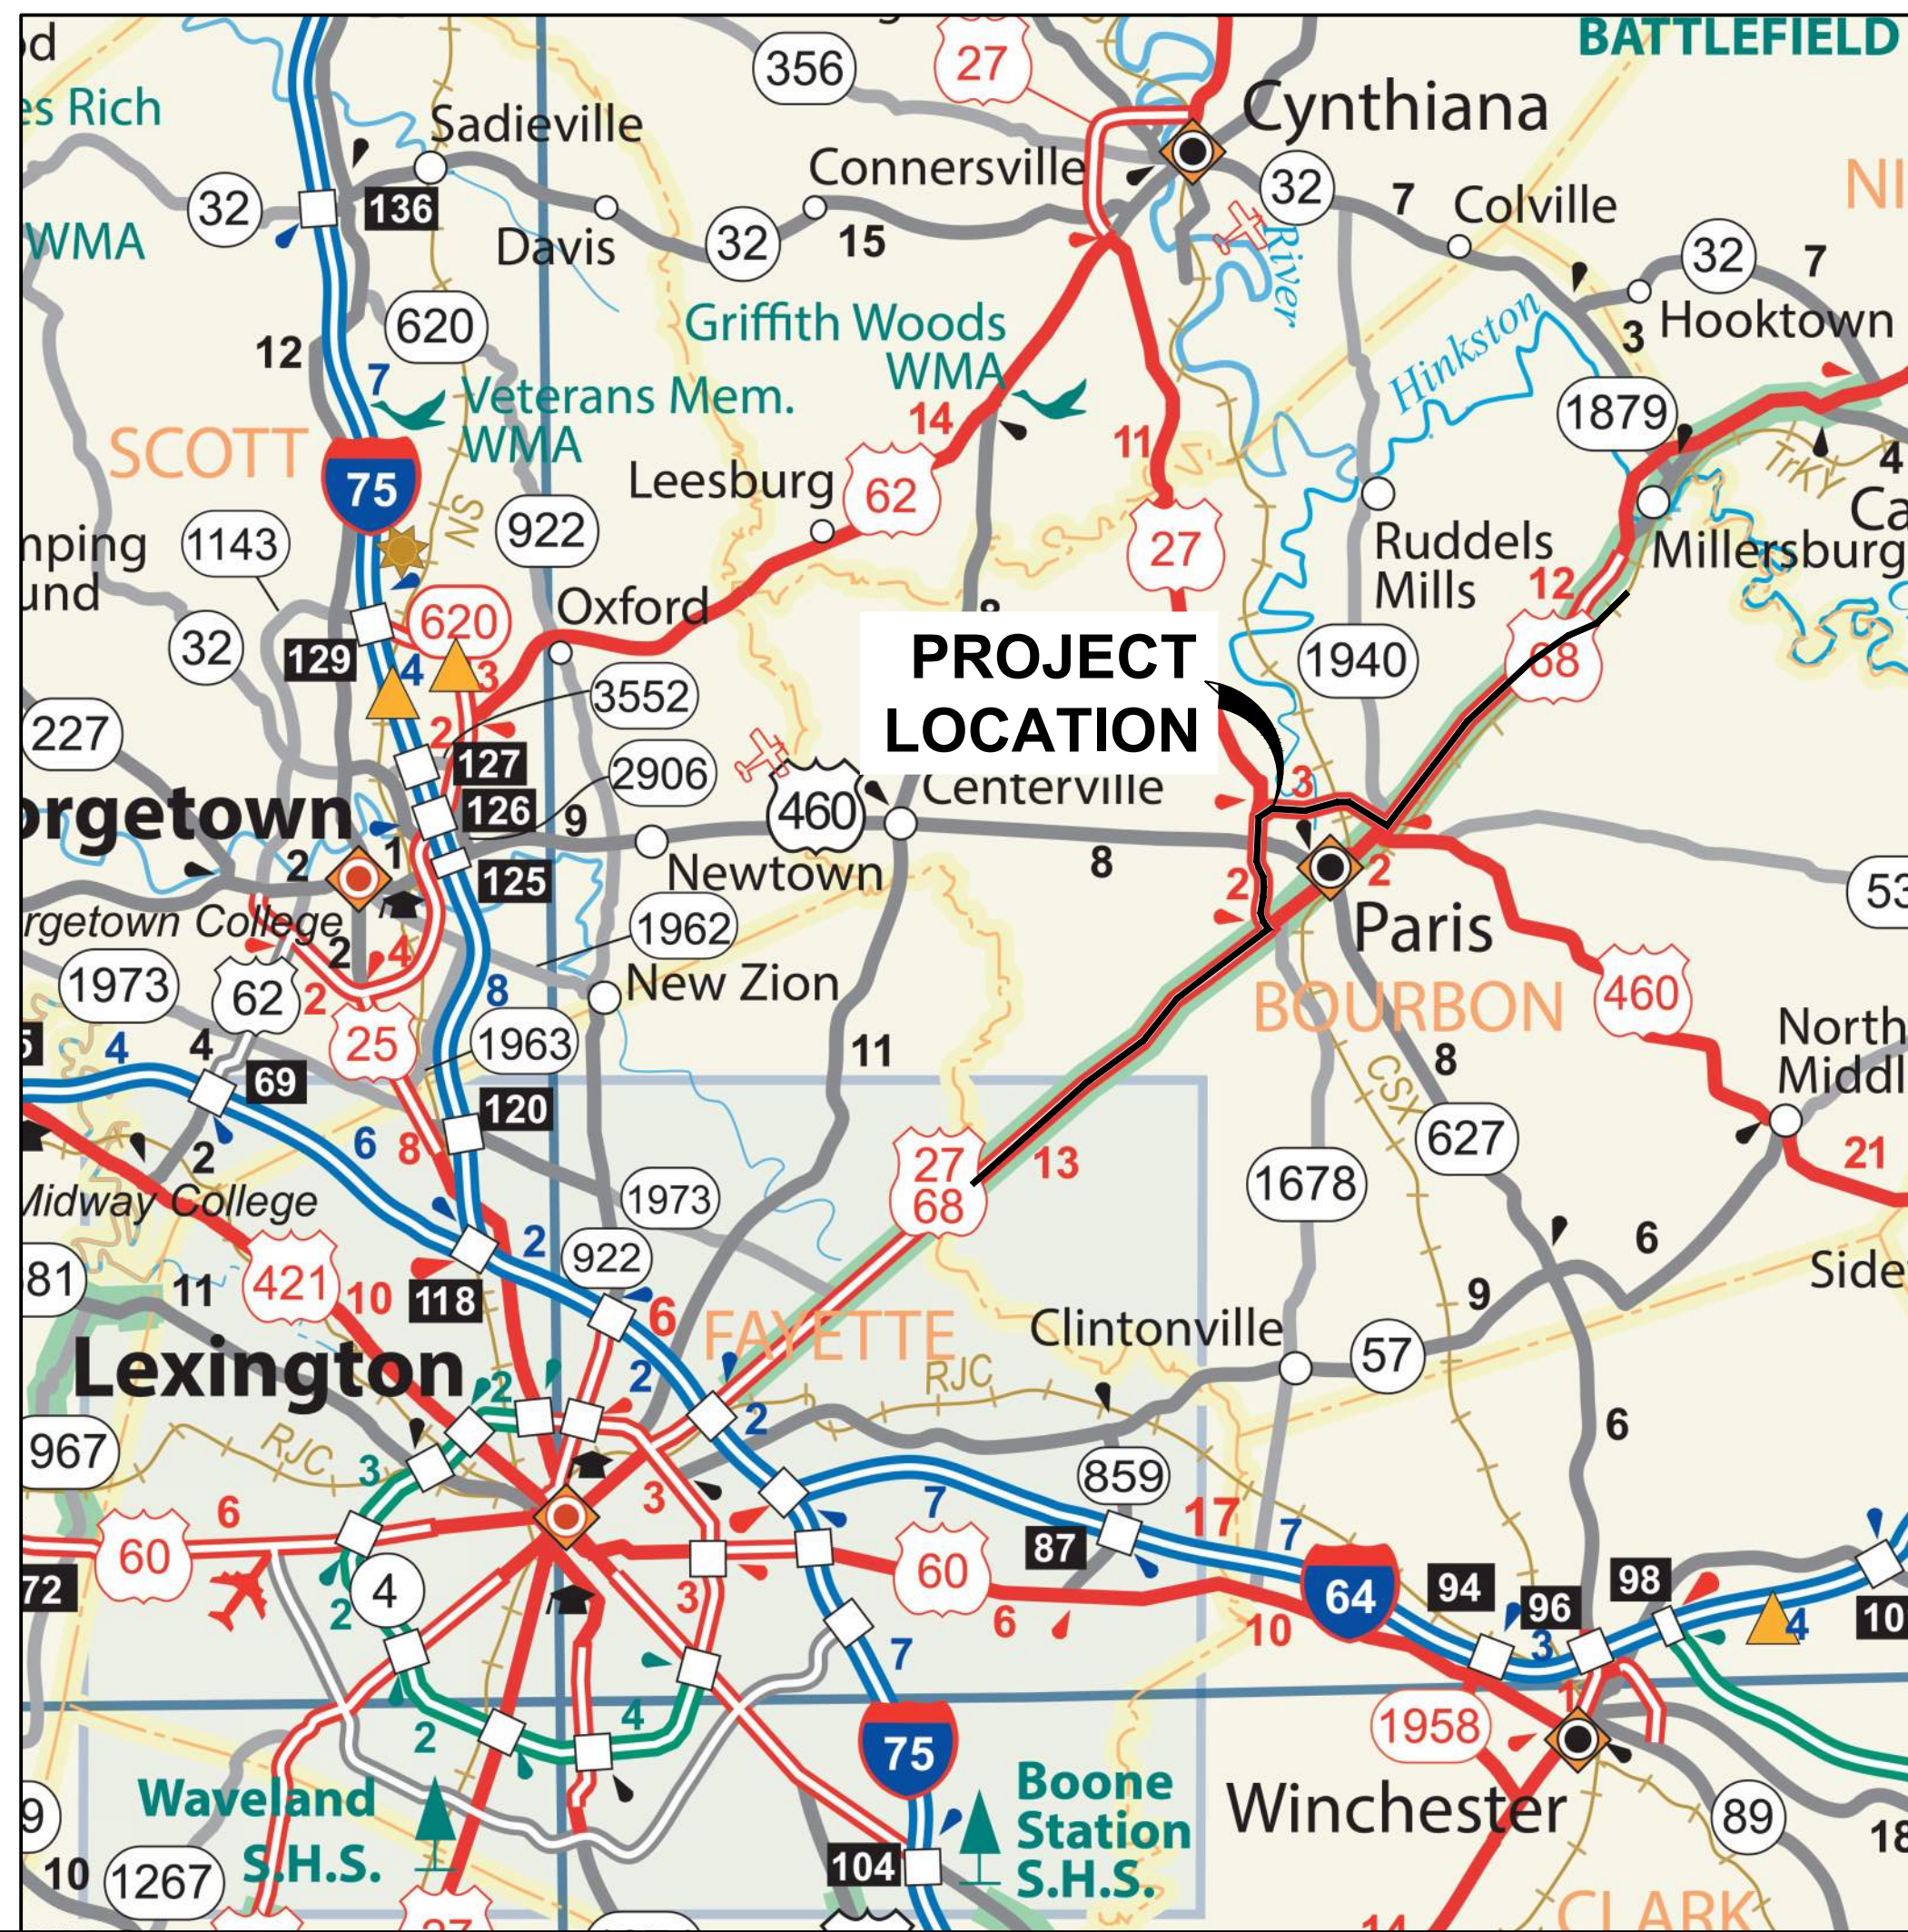


SHEET INDEX

- GENERAL
G01 COVER SHEET
- CIVIL
C01 - C47 WATERLINE PLAN

NOTE:
INFORMATION SHOWN BASED ON FIELD DATA
COLLECTED BY KENTUCKY AMERICAN WATER.



REVISIONS		REVISIONS		REVISIONS	
A	ISSUED FOR BID 2024-04-03	△		△	
B	ISSUED FOR BID 2024-04-22	△		△	
C	ISSUED FOR CONSTRUCTION 2024-06-19	△		△	
D	AS-BUILT DRAWINGS 2025-05-28	△		△	
E	AS-BUILT DRAWINGS 2026-04-07	△		△	

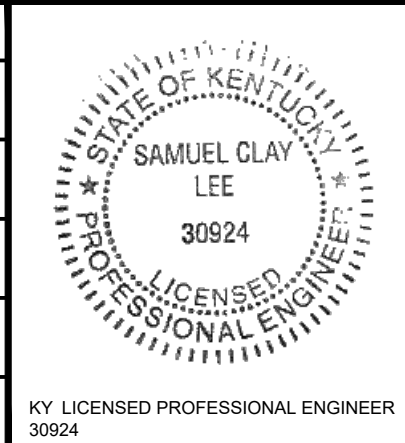

Stantec
3052 BEAUMONT CENTRE CIRCLE
LEXINGTON, KENTUCKY 40513
STANTEC.COM


DRAWN BY: RPG, TCG, BMP, EOK, NBK, ZWP
PROJECT ENGR: SL

DATE: APRIL 2026

PROJECT: 175569504

MILLERSBURG WATER SUPPLY PROJECT CIVIL GENERAL NOTES			
KENTUCKY-AMERICAN WATER COMPANY	MILLERSBURG WATER SUPPLY PROJECT	USE DIMENSIONS ONLY SCALE: AS SHOWN	
USE APPROVED DRAWINGS ONLY FOR CONSTRUCTION PURPOSES		AS-BUILT DRAWINGS	G01

File Date: 2026/04/07 7:26 AM User: Mgr/McGrath, Bentley
 Project: Millersburg Water Supply Project - Bourbon County, KY
 Drawing: G01 - COVER SHEET

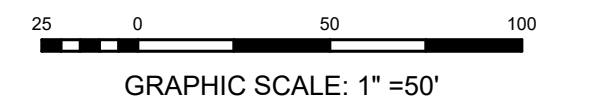


NOTE:
 INFORMATION SHOWN BASED ON FIELD DATA
 COLLECTED BY KENTUCKY AMERICAN WATER.

P:\Data\2026\04\07 7:41 AM Login\MD\right\Bentley - Project\Millersburg Water Supply\Drawings\Station 0+00 to 14+50\Station 0+00 to 14+50.dwg, 03/11/2026, 10:50:00 AM, 100%



REVISIONS		REVISIONS		REVISIONS	
△ A	ISSUED FOR BID 2024-04-03	△		△	
△ B	ISSUED FOR BID 2024-04-22	△		△	
△ C	ISSUED FOR CONSTRUCTION 2024-06-19	△		△	
△ D	AS-BUILT DRAWINGS 2025-05-28	△		△	
△ E	AS-BUILT DRAWINGS 2026-04-07	△		△	

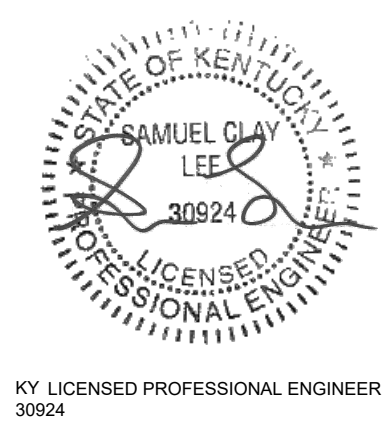


Stantec
 3052 BEAUMONT CENTRE CIRCLE
 LEXINGTON, KENTUCKY 40513
 STANTEC.COM

DRAWN BY: RPG, TCG, BMP, EOK, NBK, ZWP
 PROJECT ENGR: SL

DATE: APRIL 2026

PROJECT: 175569504

MILLERSBURG WATER SUPPLY PROJECT CIVIL STATION 0+00 TO 14+50			
KENTUCKY-AMERICAN WATER COMPANY	MILLERSBURG WATER SUPPLY PROJECT	USE DIMENSIONS ONLY SCALE: AS SHOWN	
USE APPROVED DRAWINGS ONLY FOR CONSTRUCTION PURPOSES		AS-BUILT DRAWINGS	C01

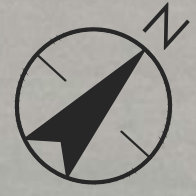


HORIZONTAL SCALE: 1" = 50'

NOTE:
INFORMATION SHOWN BASED ON FIELD DATA
COLLECTED BY KENTUCKY AMERICAN WATER.



REVISIONS		REVISIONS		REVISIONS	
△ A	ISSUED FOR BID 2024-04-03	△		△	
△ B	ISSUED FOR BID 2024-04-22	△		△	
△ C	ISSUED FOR CONSTRUCTION 2024-06-19	△		△	
△ D	AS-BUILT DRAWINGS 2025-05-28	△		△	
△ E	AS-BUILT DRAWINGS 2026-04-07	△		△	

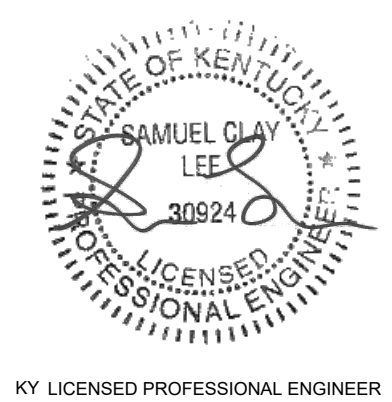

Stantec
3052 BEAUMONT CENTRE CIRCLE
LEXINGTON, KENTUCKY 40513
STANTEC.COM


DRAWN BY: RPG, TCG, BMP, EOK, NBK, ZWP
PROJECT ENGR: SL

DATE: APRIL 2026

PROJECT: 175569504

MILLERSBURG WATER SUPPLY PROJECT CIVIL STATION 72+50 TO 87+00		
KENTUCKY-AMERICAN WATER COMPANY	MILLERSBURG WATER SUPPLY PROJECT	USE DIMENSIONS ONLY SCALE: AS SHOWN
USE APPROVED DRAWINGS ONLY FOR CONSTRUCTION PURPOSES	AS-BUILT DRAWINGS	C06


P:\01\2026\04\07_2026\175569504\Drawings\Station 72+50 to 87+00\C06.dwg
 Project: 175569504
 Date: 2026-04-07 2:03 PM
 User: mchugh@kentuckyamericanwater.com

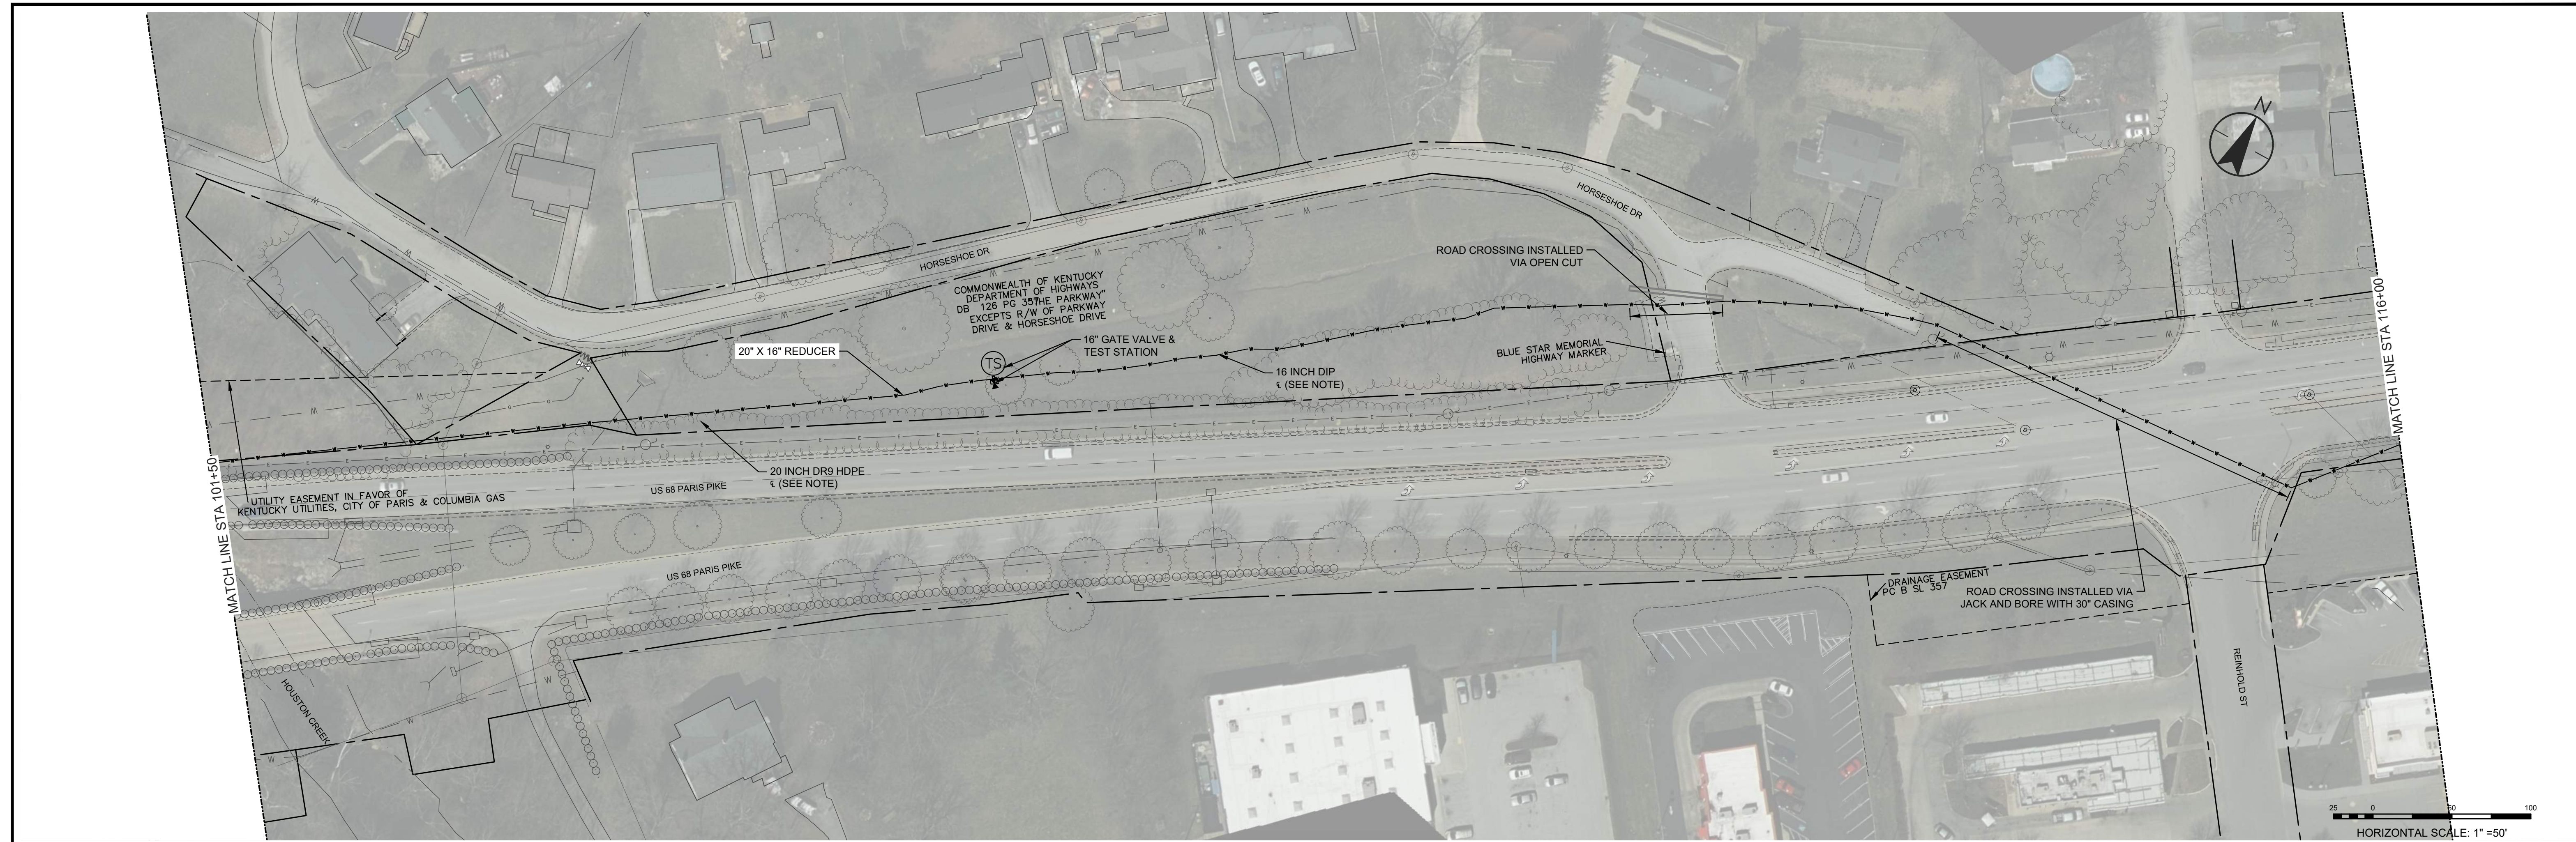

NOTE:
 INFORMATION SHOWN BASED ON FIELD DATA
 COLLECTED BY KENTUCKY AMERICAN WATER.



REVISIONS		REVISIONS		REVISIONS	
	ISSUED FOR BID 2024-04-03				
	ISSUED FOR BID 2024-04-22				
	ISSUED FOR CONSTRUCTION 2024-06-19				
	AS-BUILT DRAWINGS 2025-05-28				
	AS-BUILT DRAWINGS 2026-04-07				

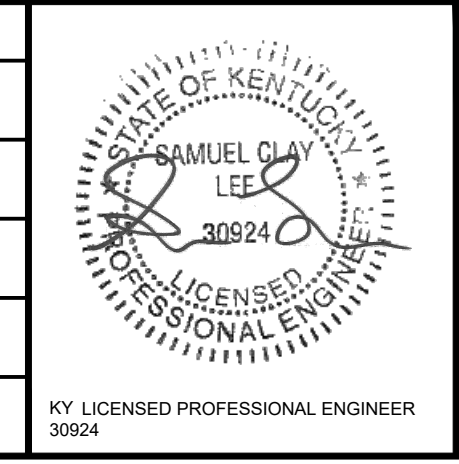

Stantec
 3052 BEAUMONT CENTRE CIRCLE
 LEXINGTON, KENTUCKY 40513
 STANTEC.COM



DRAWN BY: RFG, TCG, BMP, EOK, NBK, ZWP
 PROJECT ENGR: SL

DATE: APRIL 2026

PROJECT: 175569504

MILLERSBURG WATER SUPPLY PROJECT CIVIL STATION 101+50 TO 116+00			
KENTUCKY-AMERICAN WATER COMPANY	MILLERSBURG WATER SUPPLY PROJECT	USE DIMENSIONS ONLY SCALE: AS SHOWN	
USE APPROVED DRAWINGS ONLY FOR CONSTRUCTION PURPOSES	AS-BUILT DRAWINGS	C08	

P:\Data\2026\0407_2026\175569504\Drawings\Station 101+50 to 116+00\Civil\175569504_Station 101+50 to 116+00_Civil.dwg, 05/21/2026, 10:00 AM

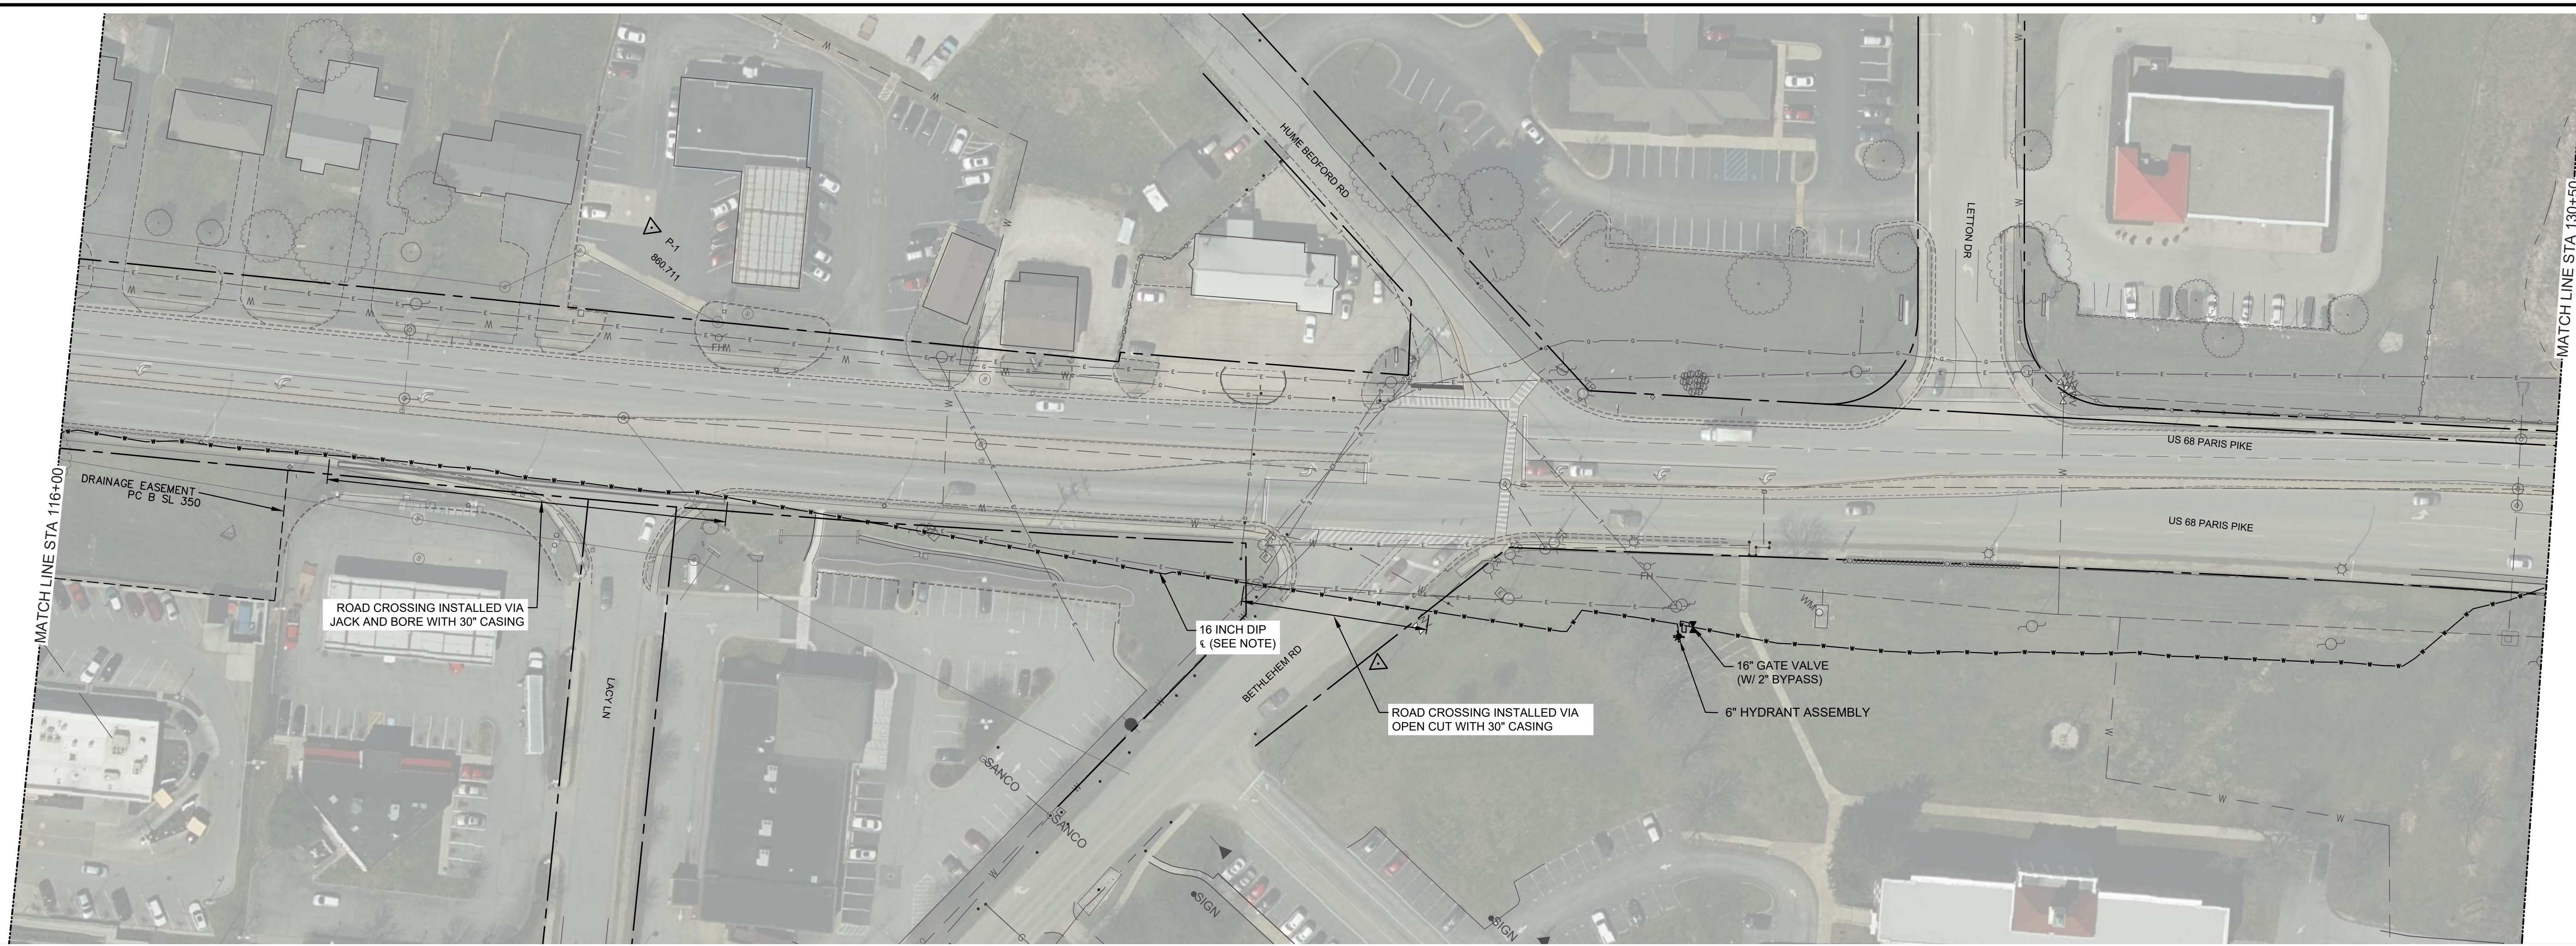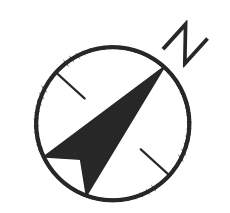

HORIZONTAL SCALE: 1" = 50'

NOTE:
INFORMATION SHOWN BASED ON FIELD DATA
COLLECTED BY KENTUCKY AMERICAN WATER.



REVISIONS		REVISIONS		REVISIONS	
A	ISSUED FOR BID 2024-04-03	△		△	
B	ISSUED FOR BID 2024-04-22	△		△	
C	ISSUED FOR CONSTRUCTION 2024-06-19	△		△	
D	AS-BUILT DRAWINGS 2025-05-28	△		△	
E	AS-BUILT DRAWINGS 2026-04-07	△		△	



Stantec
3052 BEAUMONT CENTRE CIRCLE
LEXINGTON, KENTUCKY 40513
STANTEC.COM

DRAWN BY: RPG, TCG, BMP, EOK, NBK, ZWP
PROJECT ENGR: SL



DATE: APRIL 2026

PROJECT: 175569504

**MILLERSBURG WATER SUPPLY PROJECT
CIVIL
STATION 116+00 TO 130+50**

KENTUCKY-AMERICAN WATER COMPANY	MILLERSBURG WATER SUPPLY PROJECT	USE DIMENSIONS ONLY SCALE: AS SHOWN
USE APPROVED DRAWINGS ONLY FOR CONSTRUCTION PURPOSES	AS-BUILT DRAWINGS	C09

P:\Data\2026\04\07_2026 PM Logon\McGrath, Leahy
 Project: Millersburg Water Supply Project
 Drawing: Station 116+00 to 130+50
 Date: 2026-04-07 2:33 PM
 User: Leahy, McGrath

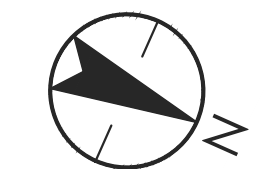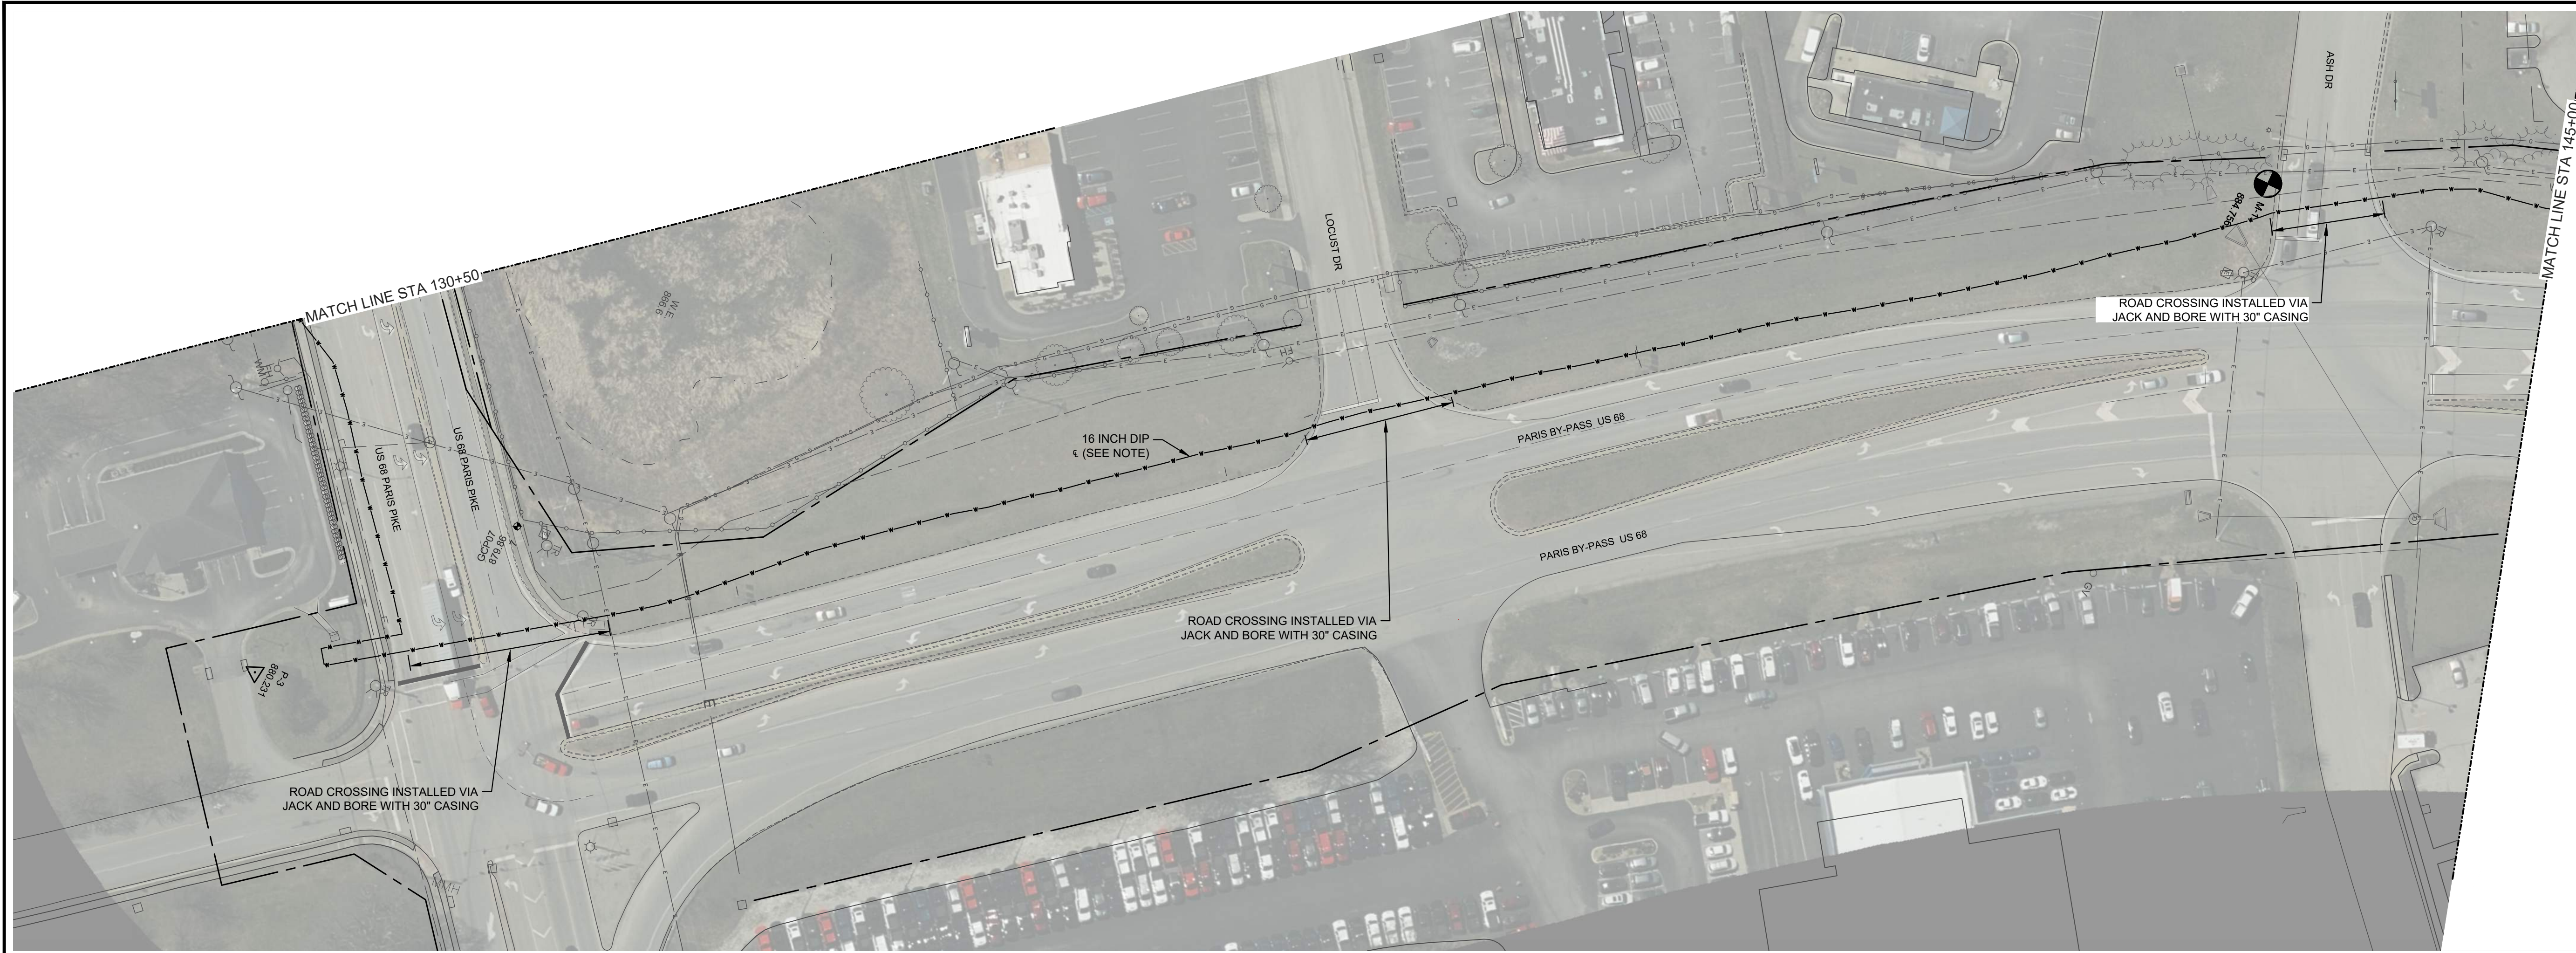

25 0 50 100
HORIZONTAL SCALE: 1" = 50'

NOTE:
INFORMATION SHOWN BASED ON FIELD DATA
COLLECTED BY KENTUCKY AMERICAN WATER.



REVISIONS		REVISIONS		REVISIONS	
△ A	ISSUED FOR BID 2024-04-03	△		△	
△ B	ISSUED FOR BID 2024-04-22	△		△	
△ C	ISSUED FOR CONSTRUCTION 2024-06-19	△		△	
△ D	AS-BUILT DRAWINGS 2025-05-28	△		△	
△ E	AS-BUILT DRAWINGS 2026-04-07	△		△	



Stantec
3052 BEAUMONT CENTRE CIRCLE
LEXINGTON, KENTUCKY 40513
STANTEC.COM



DRAWN BY: RPG, TCG, BMP, EOK, NBK, ZWP
PROJECT ENGR: SL

DATE: APRIL 2026

PROJECT: 175569504

MILLERSBURG WATER SUPPLY PROJECT CIVIL STATION 130+50 TO 145+00		
KENTUCKY-AMERICAN WATER COMPANY	MILLERSBURG WATER SUPPLY PROJECT	USE DIMENSIONS ONLY SCALE: AS SHOWN
USE APPROVED DRAWINGS ONLY FOR CONSTRUCTION PURPOSES	AS-BUILT DRAWINGS	C10


P:\Data\2026\04\07_2026 PM Logon\McGrath, Leahy
 Project: Millersburg Water Supply Project - Civil
 Drawing: STANTEC\Projects\2026\04\07_2026 PM Logon\McGrath, Leahy\Drawings\AS-BUILT\175569504_05_2.dwg
 Date: 2026-04-07 2:03 PM
 User: Leahy, McGrath

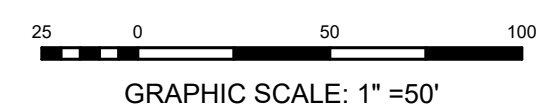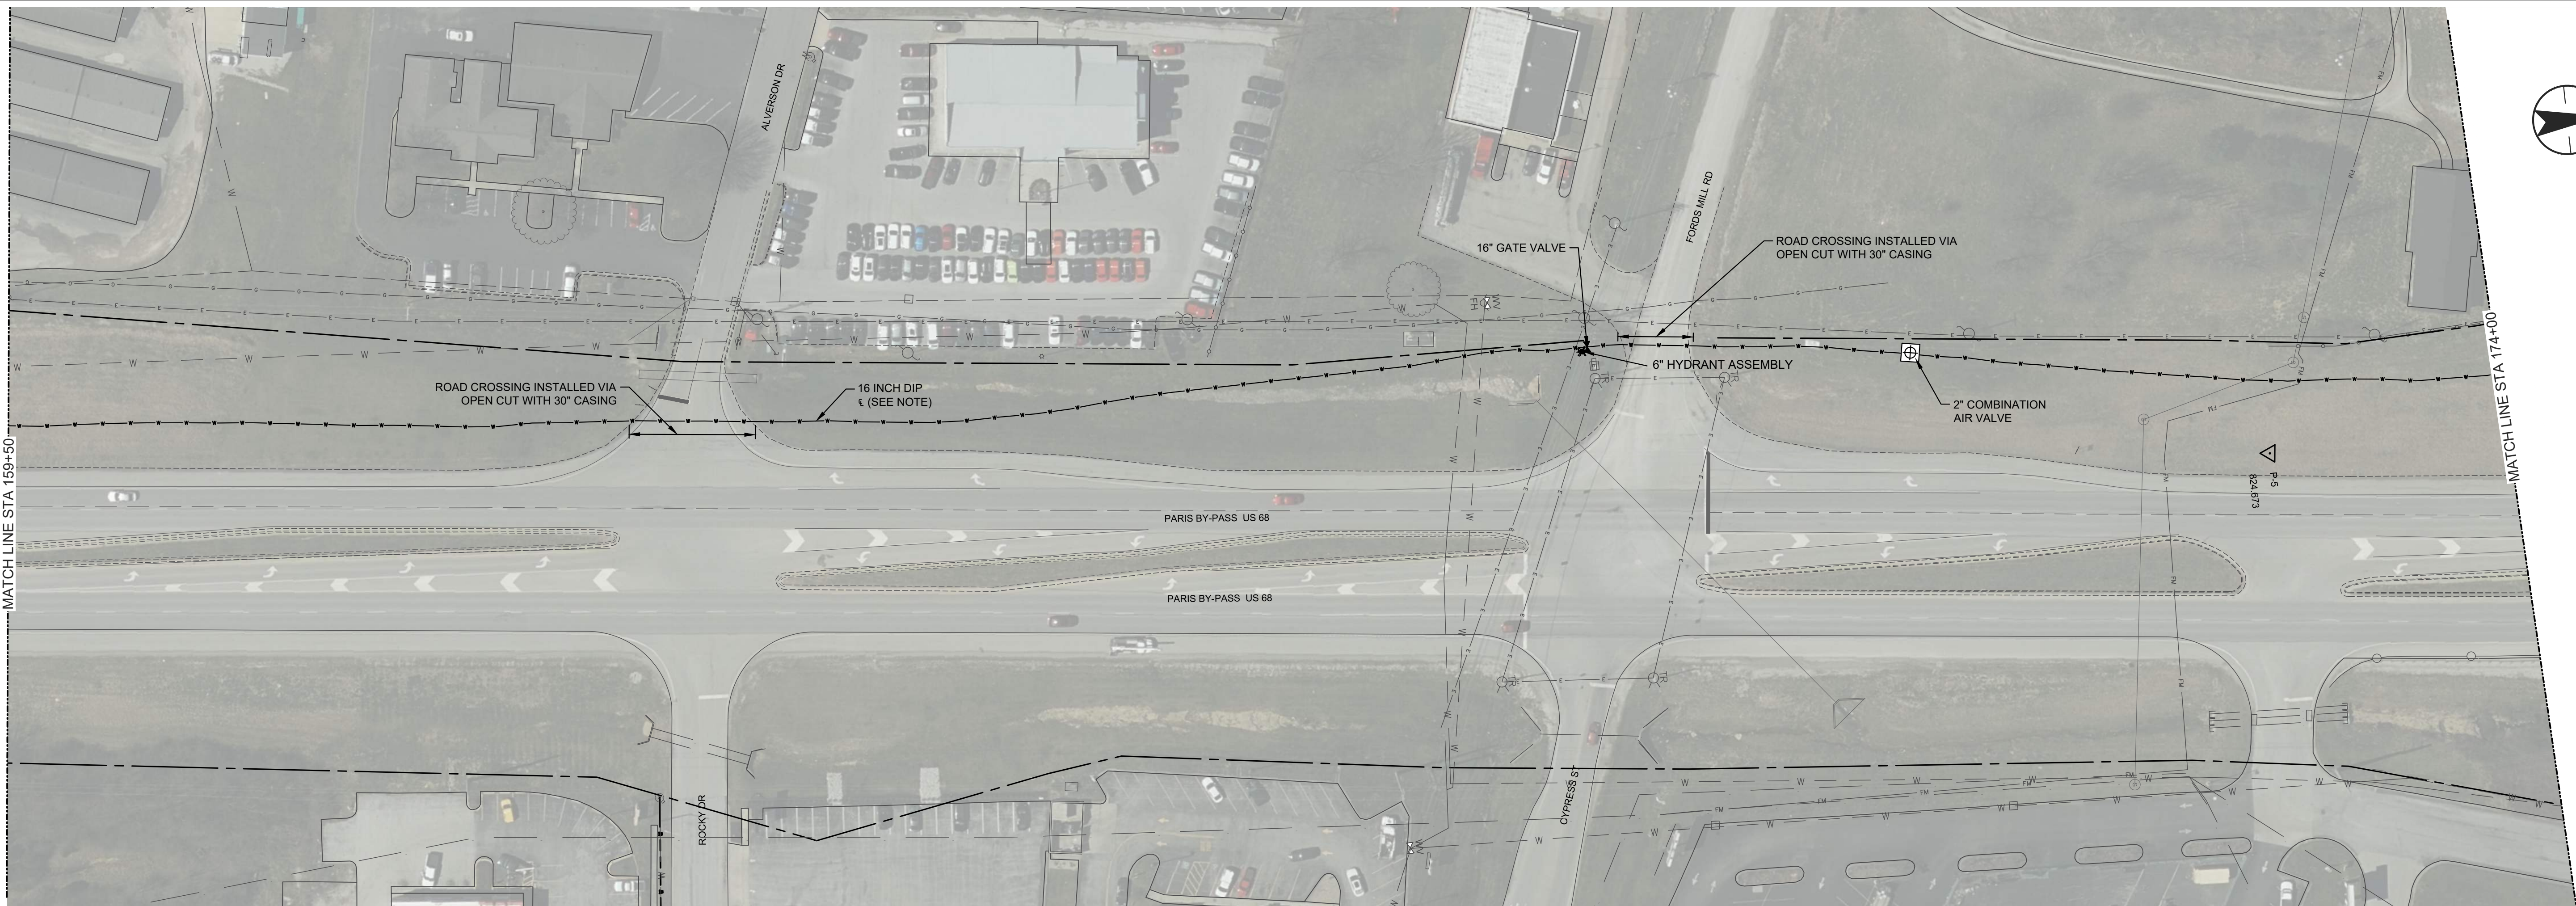

NOTE:
 INFORMATION SHOWN BASED ON FIELD DATA
 COLLECTED BY KENTUCKY AMERICAN WATER.



REVISIONS		REVISIONS		REVISIONS	
△ A	ISSUED FOR BID 2024-04-03	△		△	
△ B	ISSUED FOR BID 2024-04-22	△		△	
△ C	ISSUED FOR CONSTRUCTION 2024-06-19	△		△	
△ D	AS-BUILT DRAWINGS 2025-05-28	△		△	
△ E	AS-BUILT DRAWINGS 2026-04-07	△		△	

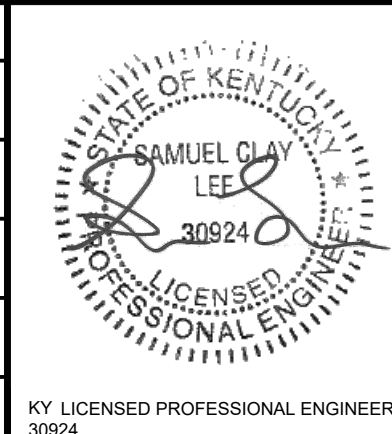

Stantec
 3052 BEAUMONT CENTRE CIRCLE
 LEXINGTON, KENTUCKY 40513
 STANTEC.COM



DRAWN BY: RFG, TCG, BMP, EOK, NBK, ZWP
 PROJECT ENGR: SL

DATE: APRIL 2026

PROJECT: 175569504

MILLERSBURG WATER SUPPLY PROJECT CIVIL STATION 159+50 TO 174+00		
KENTUCKY-AMERICAN WATER COMPANY	MILLERSBURG WATER SUPPLY PROJECT	USE DIMENSIONS ONLY SCALE: AS SHOWN
USE APPROVED DRAWINGS ONLY FOR CONSTRUCTION PURPOSES	AS-BUILT DRAWINGS	C12


File Date: 2026-04-07 3:01 PM, Login: Mcdough, User: ...
 Project: Millersburg Water Supply Project - Station 159+50 to 174+00
 Drawing: Station 159+50 to 174+00 - Civil - C12

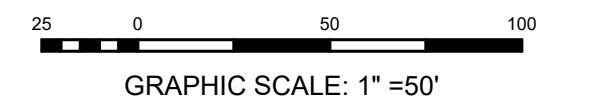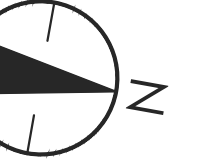

NOTE:
 INFORMATION SHOWN BASED ON FIELD DATA
 COLLECTED BY KENTUCKY AMERICAN WATER.



REVISIONS		REVISIONS		REVISIONS	
△ A	ISSUED FOR BID 2024-04-03	△		△	
△ B	ISSUED FOR BID 2024-04-22	△		△	
△ C	ISSUED FOR CONSTRUCTION 2024-06-19	△		△	
△ D	AS-BUILT DRAWINGS 2025-05-28	△		△	
△ E	AS-BUILT DRAWINGS 2026-04-07	△		△	

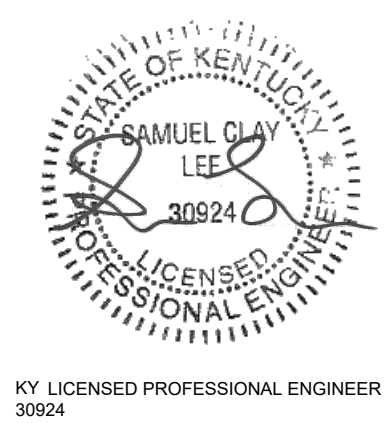

Stantec
 3052 BEAUMONT CENTRE CIRCLE
 LEXINGTON, KENTUCKY 40513
 STANTEC.COM


DRAWN BY: RPG, TCG, BMP, EOK, NBK, ZWP
 PROJECT ENGR: SL

DATE: APRIL 2026

PROJECT: 175569504

MILLERSBURG WATER SUPPLY PROJECT CIVIL STATION 174+00 TO 188+50			
KENTUCKY-AMERICAN WATER COMPANY	MILLERSBURG WATER SUPPLY PROJECT	USE DIMENSIONS ONLY SCALE: AS SHOWN	
USE APPROVED DRAWINGS ONLY FOR CONSTRUCTION PURPOSES		AS-BUILT DRAWINGS	C13


P:\Data\2026\04\07_2026_Plan_Millersburg_Civil.dwg
 Project: Millersburg Water Supply Project
 Date: 2026-04-07 10:53:53 AM
 User: samuel.clay@stantec.com
 Plot Date: 2026-04-07 10:53:53 AM
 Plot Scale: 1"=50'
 Plot Size: 11.00 x 17.00
 Plot Title: MILLERSBURG WATER SUPPLY PROJECT CIVIL STATION 174+00 TO 188+50

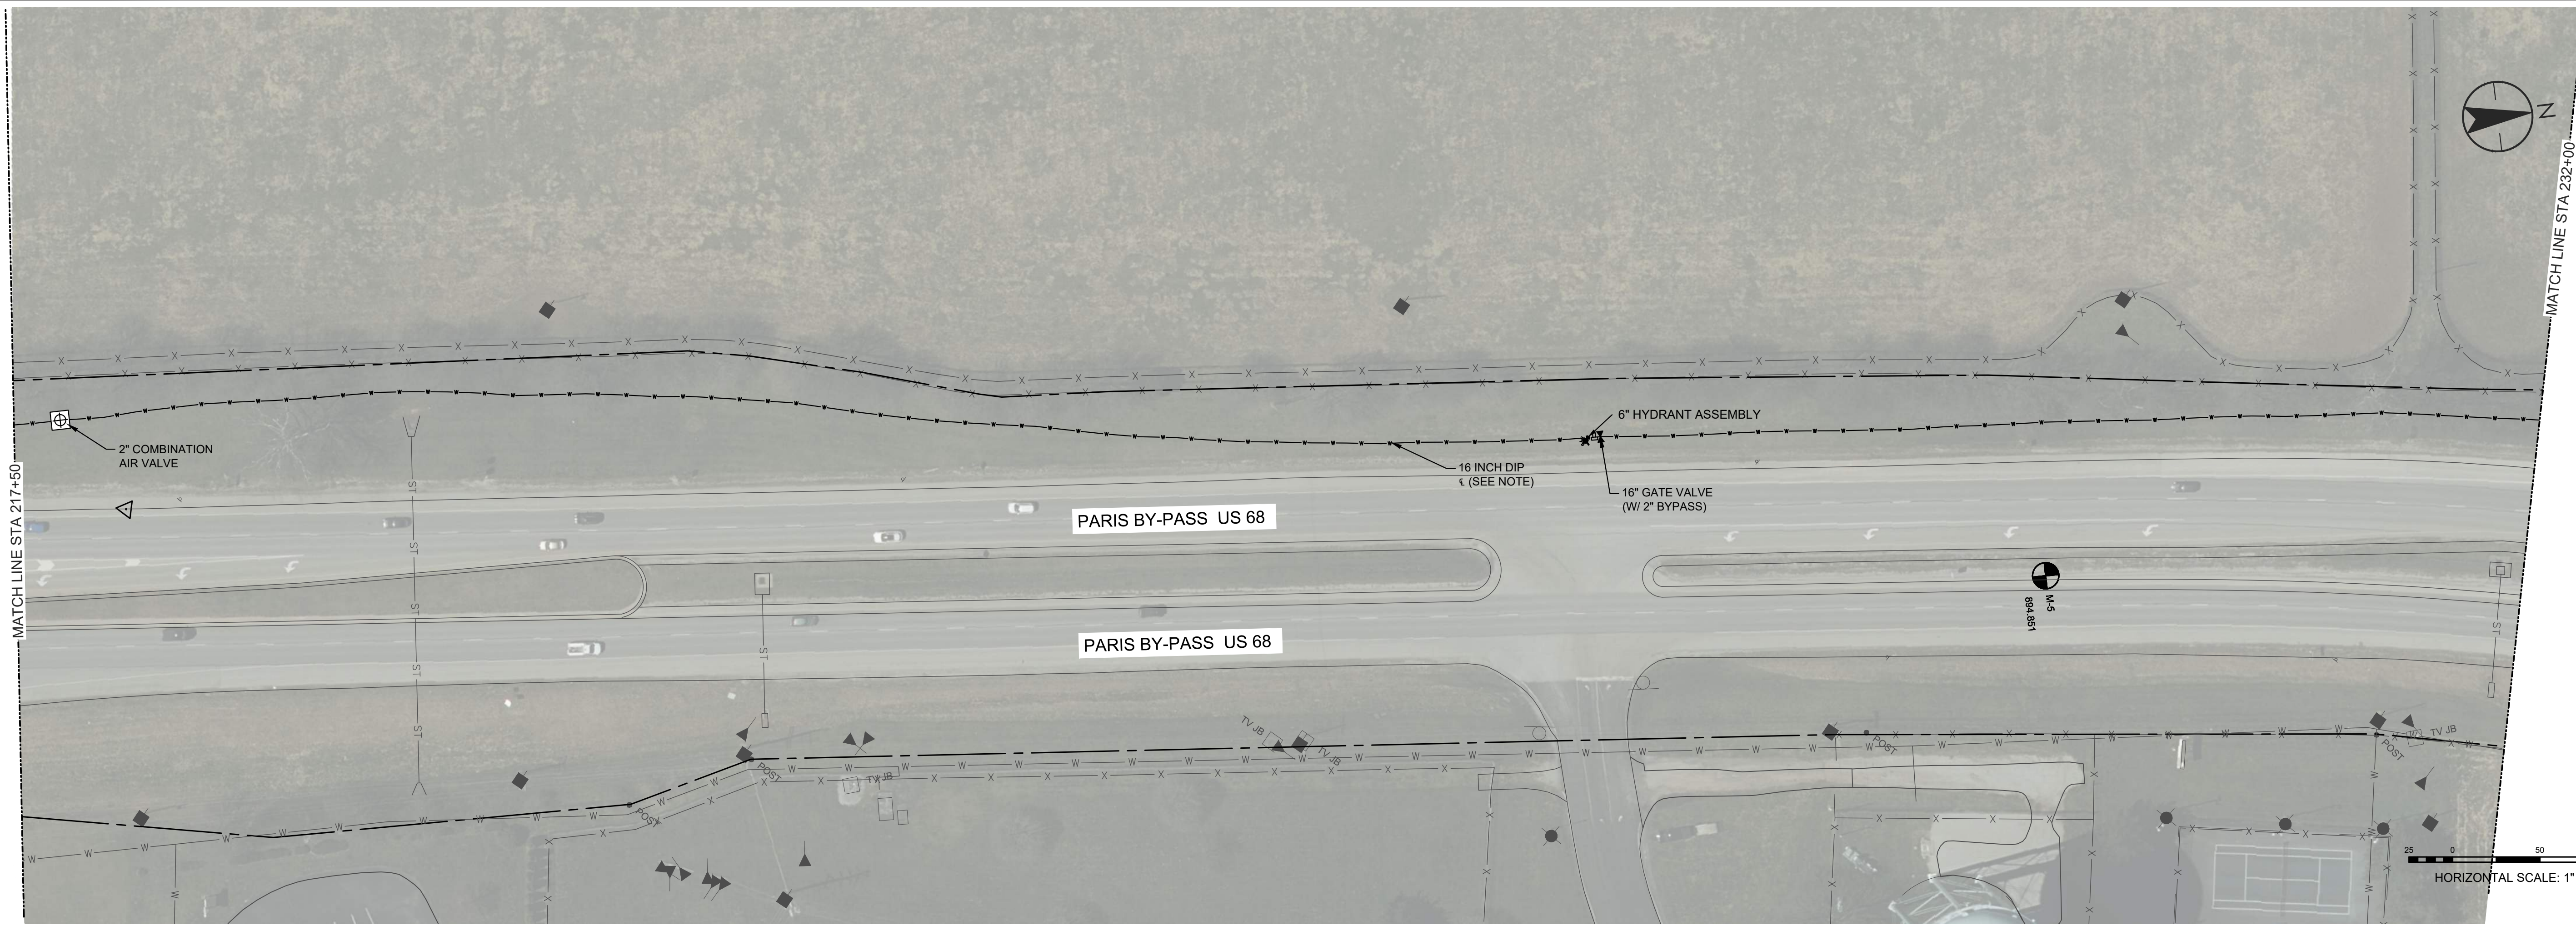

NOTE:
 INFORMATION SHOWN BASED ON FIELD DATA
 COLLECTED BY KENTUCKY AMERICAN WATER.



REVISIONS		REVISIONS		REVISIONS	
△ A	ISSUED FOR BID 2024-04-03	△		△	
△ B	ISSUED FOR BID 2024-04-22	△		△	
△ C	ISSUED FOR CONSTRUCTION 2024-06-19	△		△	
△ D	AS-BUILT DRAWINGS 2025-05-28	△		△	
△ E	AS-BUILT DRAWINGS 2026-04-07	△		△	

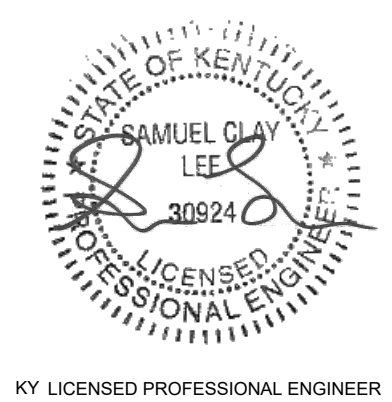

Stantec
 3052 BEAUMONT CENTRE CIRCLE
 LEXINGTON, KENTUCKY 40513
 STANTEC.COM

DRAWN BY: RPG, TCG, BMP, EOK, NBK, ZWP
 PROJECT ENGR: SL

DATE: APRIL 2026

PROJECT: 175569504

MILLERSBURG WATER SUPPLY PROJECT CIVIL STATION 217+50 TO 232+00		
KENTUCKY-AMERICAN WATER COMPANY	MILLERSBURG WATER SUPPLY PROJECT	USE DIMENSIONS ONLY SCALE: AS SHOWN
USE APPROVED DRAWINGS ONLY FOR CONSTRUCTION PURPOSES	AS-BUILT DRAWINGS	C16


P:\Data\2026\04\07_1030 AM Login\McGrath, Shelby - Paris By-Pass\Drawings\Station 217+50 to 232+00\Station 217+50 to 232+00 - C16.dwg
 2026-04-07 10:30 AM Login\McGrath, Shelby - Paris By-Pass\Drawings\Station 217+50 to 232+00\Station 217+50 to 232+00 - C16.dwg



NOTE:
INFORMATION SHOWN BASED ON FIELD DATA
COLLECTED BY KENTUCKY AMERICAN WATER.



REVISIONS		REVISIONS		REVISIONS	
A	ISSUED FOR BID 2024-04-03	△		△	
B	ISSUED FOR BID 2024-04-22	△		△	
C	ISSUED FOR CONSTRUCTION 2024-06-19	△		△	
D	AS-BUILT DRAWINGS 2025-05-28	△		△	
E	AS-BUILT DRAWINGS 2026-04-07	△		△	

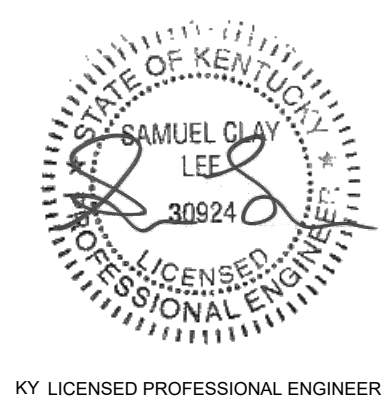

Stantec
3052 BEAUMONT CENTRE CIRCLE
LEXINGTON, KENTUCKY 40513
STANTEC.COM


DRAWN BY: RPG, TCG, BMP, EOK, NBK, ZWP
PROJECT ENGR: SL

DATE: APRIL 2026

PROJECT: 175569504

MILLERSBURG WATER SUPPLY PROJECT CIVIL STATION 275+50 TO 290+00		
KENTUCKY-AMERICAN WATER COMPANY	MILLERSBURG WATER SUPPLY PROJECT	USE DIMENSIONS ONLY SCALE: AS SHOWN
USE APPROVED DRAWINGS ONLY FOR CONSTRUCTION PURPOSES	AS-BUILT DRAWINGS	C20

P:\Data\2026\04\07_1030 AM Logon\McKnight, Shelby - Project\Millersburg Water Supply Project\Drawings\Station 275+50 to 290+00\26-04-07 - Station 275+50 to 290+00.dwg

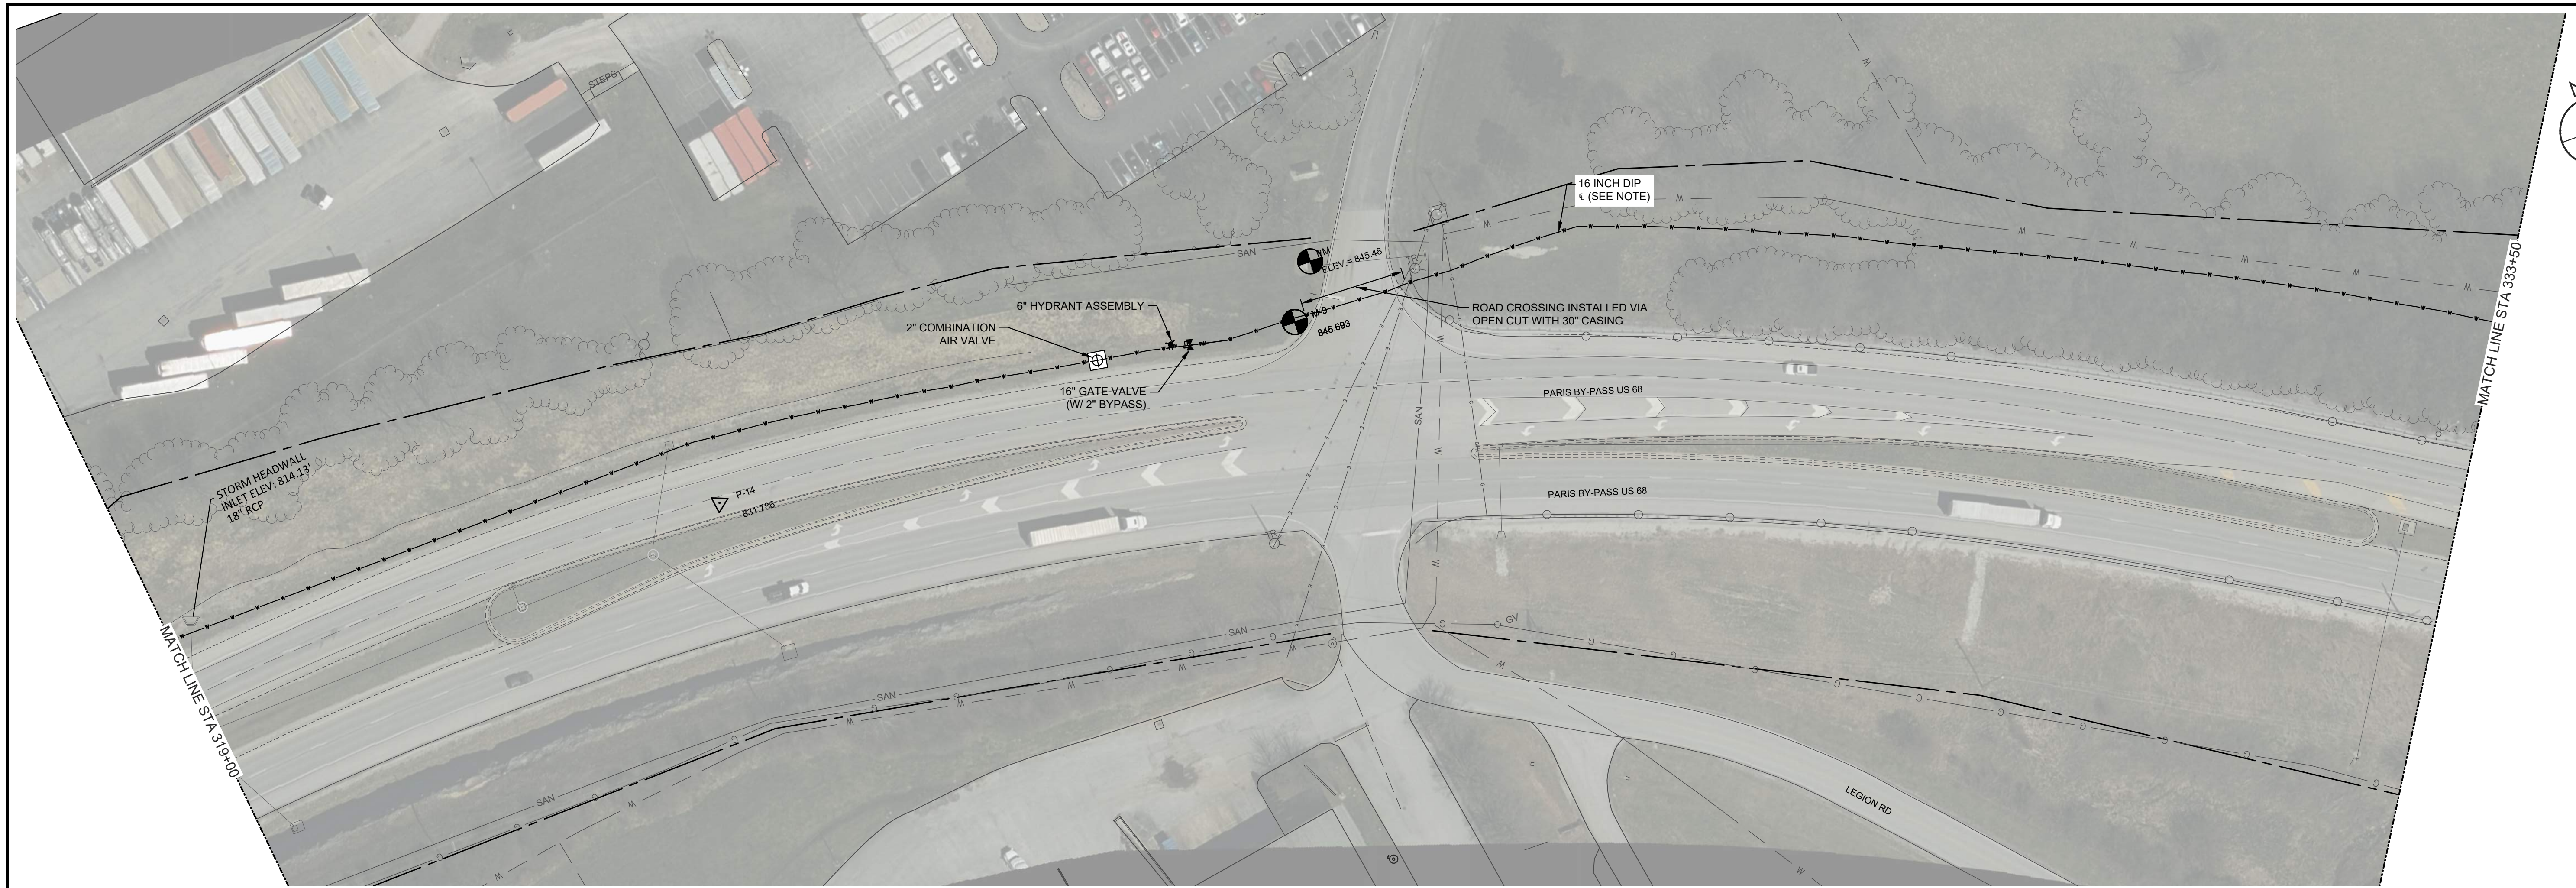


HORIZONTAL SCALE: 1" = 50'

NOTE:
INFORMATION SHOWN BASED ON FIELD DATA
COLLECTED BY KENTUCKY AMERICAN WATER.

File Date: 2/26/2024 10:07:38 AM User: Program: Bimotion
 Project: Millersburg Water Supply Project - Station 319+00 to 333+50
 Drawing: Millersburg Water Supply Project - Station 319+00 to 333+50 - C23.dwg



REVISIONS		REVISIONS		REVISIONS	
A	ISSUED FOR BID 2024-04-03	△		△	
B	ISSUED FOR BID 2024-04-22	△		△	
C	ISSUED FOR CONSTRUCTION 2024-06-19	△		△	
D	AS-BUILT DRAWINGS 2025-05-28	△		△	
E	AS-BUILT DRAWINGS 2026-04-07	△		△	

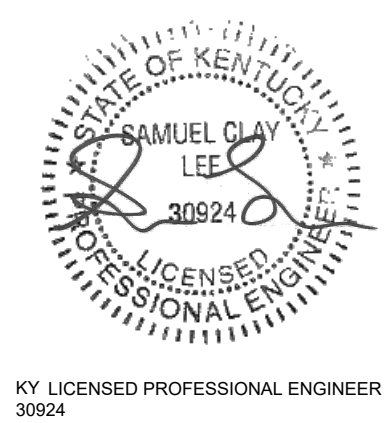

Stantec
 3052 BEAUMONT CENTRE CIRCLE
 LEXINGTON, KENTUCKY 40513
 STANTEC.COM

DRAWN BY: RPG, TCG, BMP, EOK, NBK, ZWP
 PROJECT ENGR: SL

DATE: APRIL 2026

PROJECT: 175569504

MILLERSBURG WATER SUPPLY PROJECT CIVIL STATION 319+00 TO 333+50		
KENTUCKY-AMERICAN WATER COMPANY	MILLERSBURG WATER SUPPLY PROJECT	USE DIMENSIONS ONLY SCALE: AS SHOWN
USE APPROVED DRAWINGS ONLY FOR CONSTRUCTION PURPOSES	AS-BUILT DRAWINGS	C23




HORIZONTAL SCALE: 1" = 50'

NOTE:
INFORMATION SHOWN BASED ON FIELD DATA
COLLECTED BY KENTUCKY AMERICAN WATER.



REVISIONS		REVISIONS		REVISIONS	
A	ISSUED FOR BID 2024-04-03	△		△	
B	ISSUED FOR BID 2024-04-22	△		△	
C	ISSUED FOR CONSTRUCTION 2024-06-19	△		△	
D	AS-BUILT DRAWINGS 2025-05-28	△		△	
E	AS-BUILT DRAWINGS 2026-04-07	△		△	

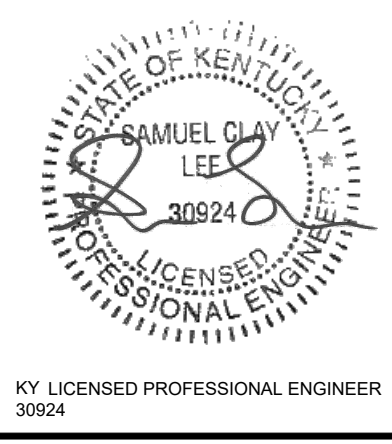

Stantec
3052 BEAUMONT CENTRE CIRCLE
LEXINGTON, KENTUCKY 40513
STANTEC.COM


DRAWN BY: RFG, TCG, BMP, EOK, NBK, ZWP
PROJECT ENGR: SL

DATE: APRIL 2026

PROJECT: 175569504

MILLERSBURG WATER SUPPLY PROJECT CIVIL STATION 333+50 TO 348+00			
KENTUCKY-AMERICAN WATER COMPANY	MILLERSBURG WATER SUPPLY PROJECT	USE DIMENSIONS ONLY SCALE: AS SHOWN	
USE APPROVED DRAWINGS ONLY FOR CONSTRUCTION PURPOSES		AS-BUILT DRAWINGS	C24

File Date: 2026/04/07 3:56 PM | User: Prabham Bhanu
 Project: Millersburg Water Supply Project - Construction
 Drawing: 175569504 - Millersburg Water Supply Project - Construction - Station 333+50 to 348+00 - Civil - C24

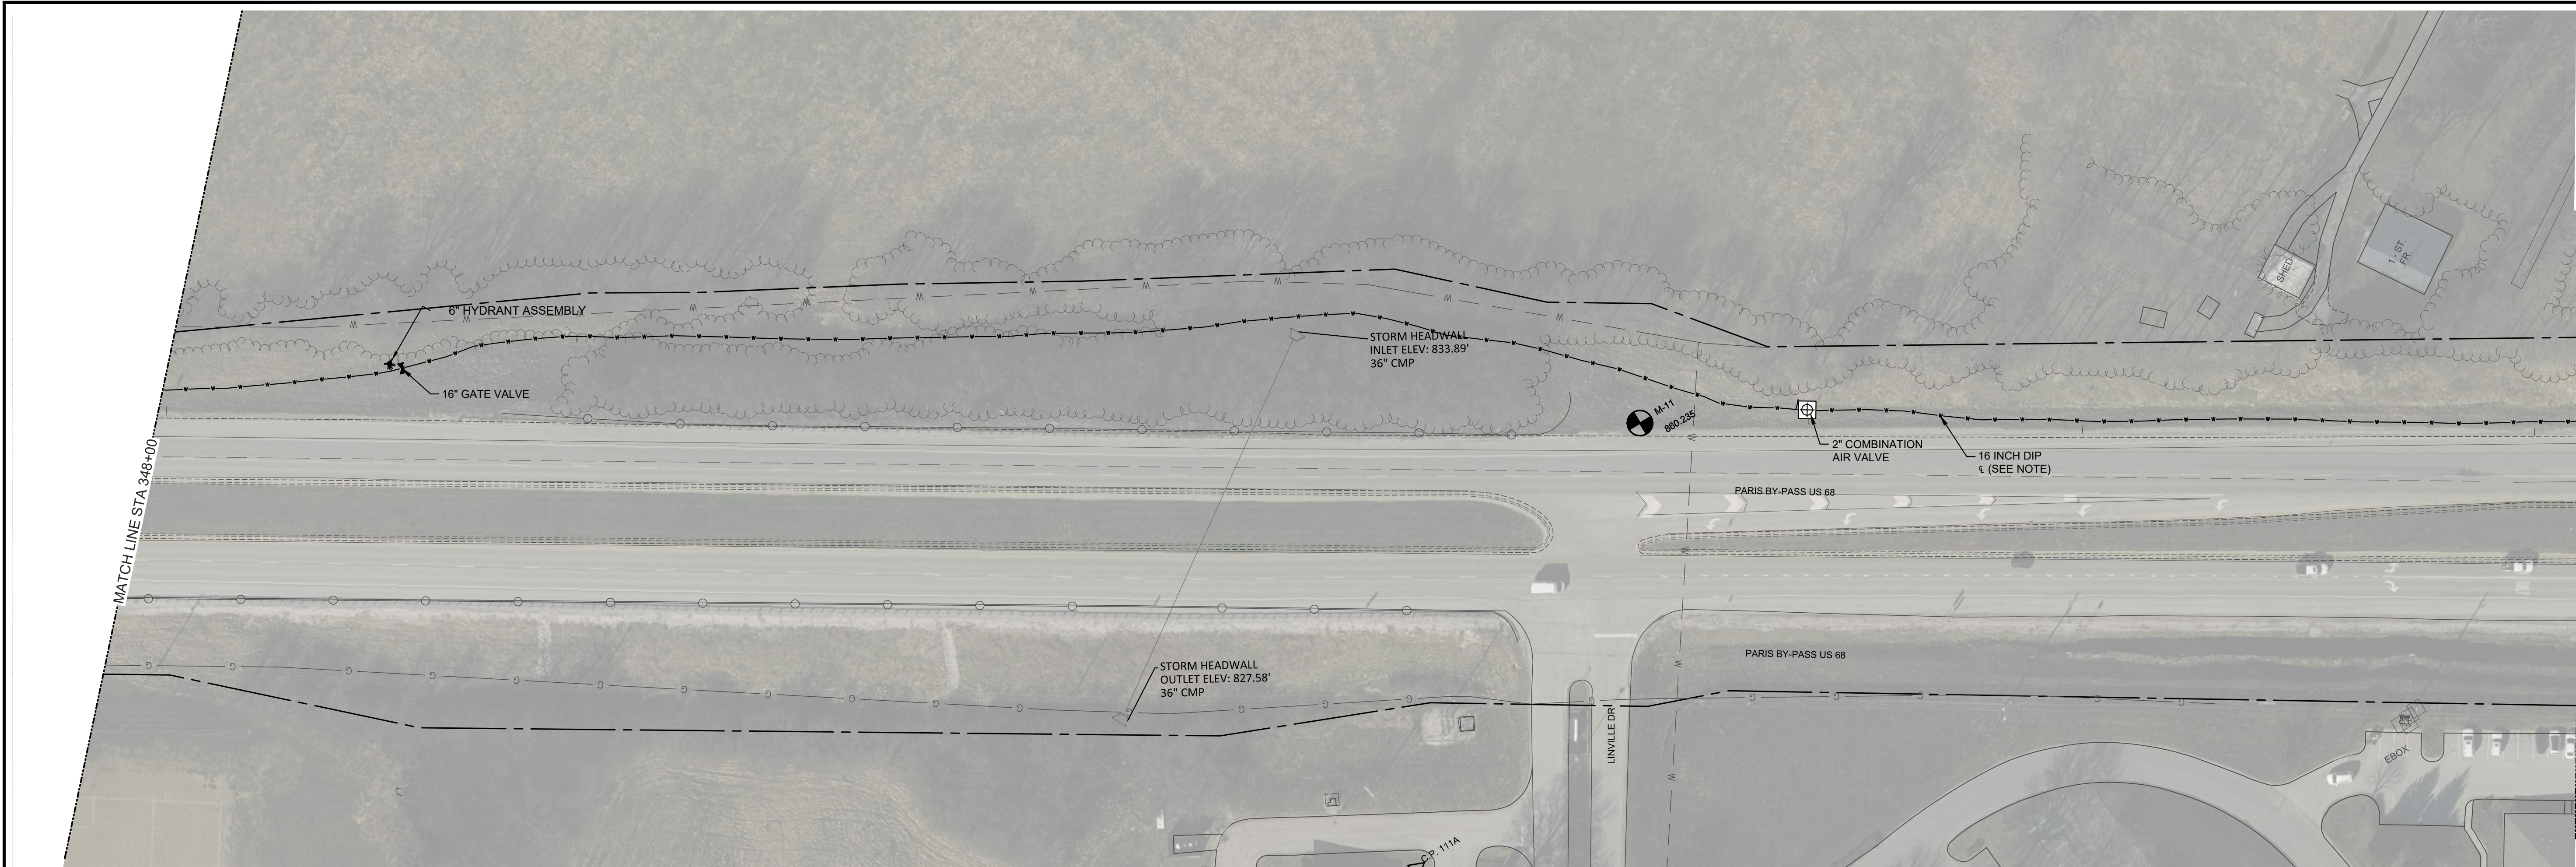


25 0 50 100
HORIZONTAL SCALE: 1" = 50'

NOTE:
INFORMATION SHOWN BASED ON FIELD DATA
COLLECTED BY KENTUCKY AMERICAN WATER.

File Date: 2/26/2024 10:07:38 AM User: P:\proj\175569504\175569504.dwg Plot Date: 2/26/2024 10:07:38 AM Plot User: P:\proj\175569504\175569504.dwg Plot Scale: 1" = 50' Plot Orientation: Landscape Plot Color: Black Plot Lineweight: 0.25 Plot Font: Arial Plot Font Size: 10 Plot Font Weight: Normal Plot Font Style: Regular Plot Font Color: Black Plot Font Background: None Plot Font Underline: None Plot Font Overline: None Plot Font Strikethrough: None Plot Font Color: Black Plot Font Background: None Plot Font Underline: None Plot Font Overline: None Plot Font Strikethrough: None



REVISIONS		REVISIONS		REVISIONS	
A	ISSUED FOR BID 2024-04-03	△		△	
B	ISSUED FOR BID 2024-04-22	△		△	
C	ISSUED FOR CONSTRUCTION 2024-06-19	△		△	
D	AS-BUILT DRAWINGS 2025-05-28	△		△	
E	AS-BUILT DRAWINGS 2026-04-07	△		△	

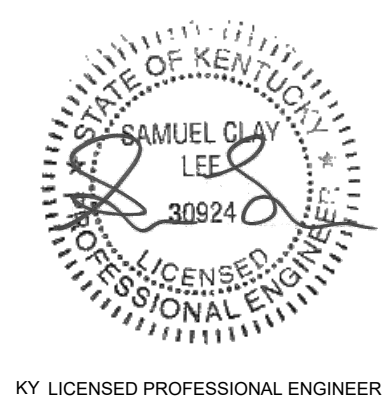




Stantec
3052 BEAUMONT CENTRE CIRCLE
LEXINGTON, KENTUCKY 40513
STANTEC.COM

DRAWN BY: RPG, TCG, BMP, EOK, NBK, ZWP
PROJECT ENGR: SL

DATE: APRIL 2026

PROJECT: 175569504

MILLERSBURG WATER SUPPLY PROJECT CIVIL STATION 348+00 TO 362+50		
KENTUCKY-AMERICAN WATER COMPANY	MILLERSBURG WATER SUPPLY PROJECT	USE DIMENSIONS ONLY SCALE: AS SHOWN
USE APPROVED DRAWINGS ONLY FOR CONSTRUCTION PURPOSES	AS-BUILT DRAWINGS	C25

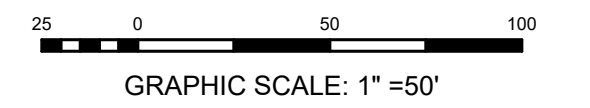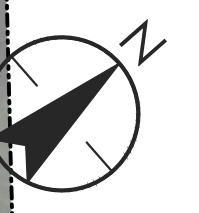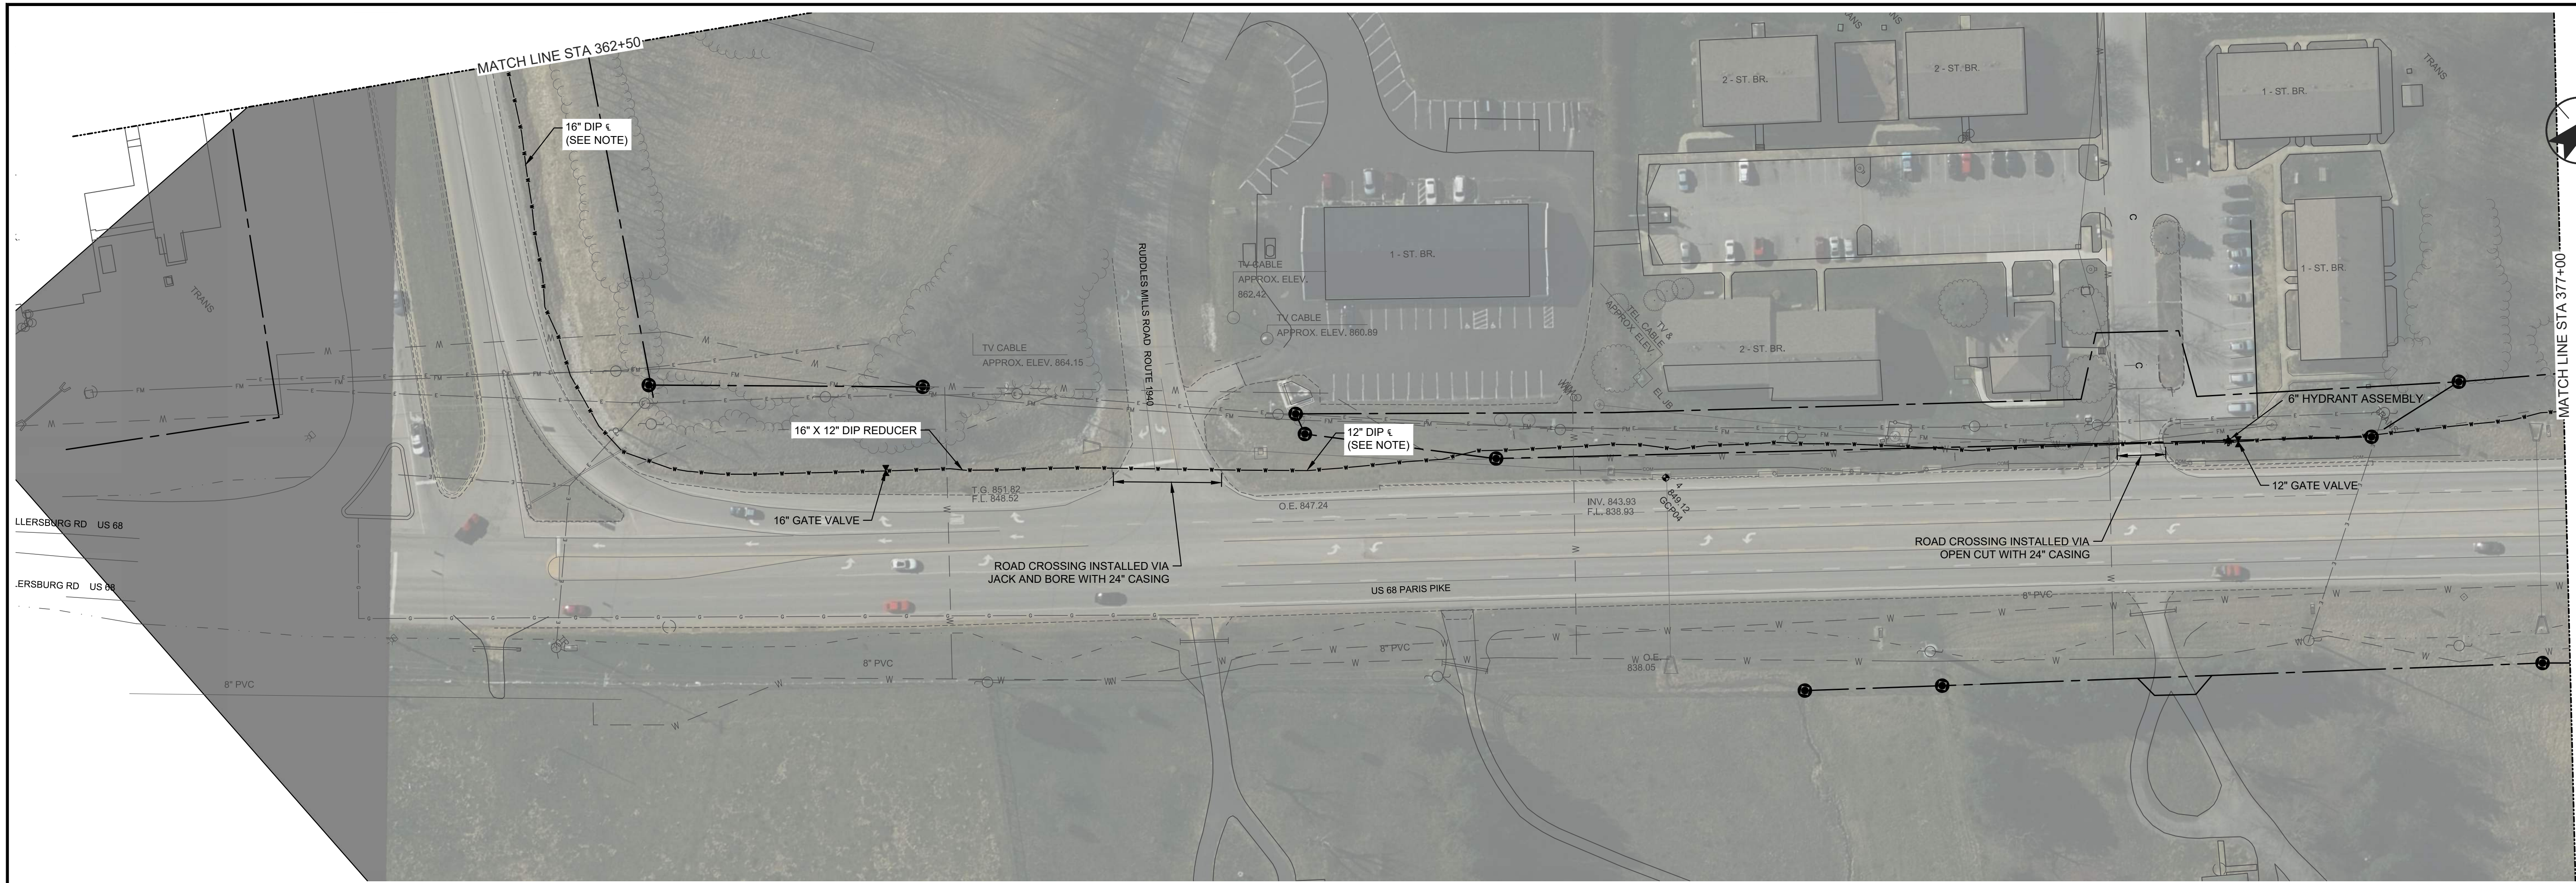


NOTE:
 INFORMATION SHOWN BASED ON FIELD DATA
 COLLECTED BY KENTUCKY AMERICAN WATER.

Plot Date: 2026/04/07 11:07 AM Login: MCFrighi, Kresley
 Project: Millersburg Water Supply Project - Station 362+50 to 377+00
 Drawing: Millersburg Water Supply Project - Station 362+50 to 377+00 - C26.dwg



REVISIONS		REVISIONS		REVISIONS	
A	ISSUED FOR BID 2024-04-03	A		A	
B	ISSUED FOR BID 2024-04-22	B		B	
C	ISSUED FOR CONSTRUCTION 2024-06-19	C		C	
D	AS-BUILT DRAWINGS 2025-05-28	D		D	
E	AS-BUILT DRAWINGS 2026-04-07	E		E	

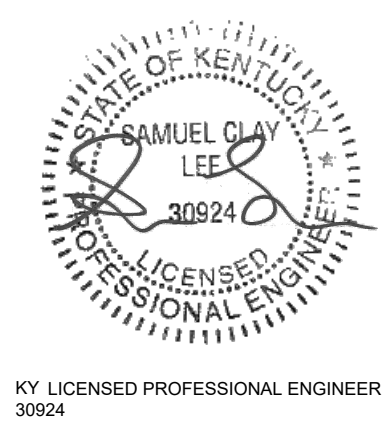



Stantec
 3052 BEAUMONT CENTRE CIRCLE
 LEXINGTON, KENTUCKY 40513
 STANTEC.COM

DRAWN BY: RFG, TCG, BMP, EOK, NBK, ZWP
 PROJECT ENGR: SL

DATE: APRIL 2026

PROJECT: 175569504


MILLERSBURG WATER SUPPLY PROJECT CIVIL STATION 362+50 TO 377+00			
KENTUCKY-AMERICAN WATER COMPANY	MILLERSBURG WATER SUPPLY PROJECT	USE DIMENSIONS ONLY SCALE AS SHOWN	
USE APPROVED DRAWINGS ONLY FOR CONSTRUCTION PURPOSES	AS-BUILT DRAWINGS	C26	

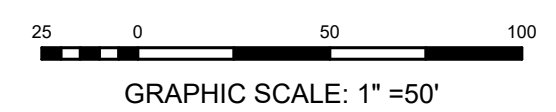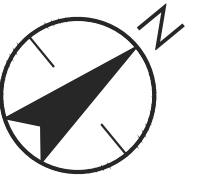

NOTE:
 INFORMATION SHOWN BASED ON FIELD DATA
 COLLECTED BY KENTUCKY AMERICAN WATER.



REVISIONS		REVISIONS		REVISIONS	
△ A	ISSUED FOR BID 2024-04-03	△		△	
△ B	ISSUED FOR BID 2024-04-22	△		△	
△ C	ISSUED FOR CONSTRUCTION 2024-06-19	△		△	
△ D	AS-BUILT DRAWINGS 2025-05-28	△		△	
△ E	AS-BUILT DRAWINGS 2026-04-07	△		△	

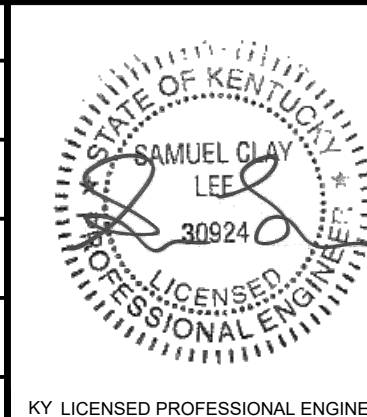

Stantec
 3052 BEAUMONT CENTRE CIRCLE
 LEXINGTON, KENTUCKY 40513
 STANTEC.COM




DRAWN BY: RPG, TCG, BMP, EOK, NBK, ZWP
 PROJECT ENGR: SL

DATE: APRIL 2026

PROJECT: 175569504

MILLERSBURG WATER SUPPLY PROJECT CIVIL STATION 406+00 TO 420+50			
KENTUCKY-AMERICAN WATER COMPANY	MILLERSBURG WATER SUPPLY PROJECT	USE DIMENSIONS ONLY SCALE: AS SHOWN	
USE APPROVED DRAWINGS ONLY FOR CONSTRUCTION PURPOSES		AS-BUILT DRAWINGS	C29


P:\Data\2026\04\07_1107 AM Logon\McKnight\Ksley - Project\Millersburg\Millersburg-Civil\2026-04-07\2026-04-07.dwg
 25.4.dwg

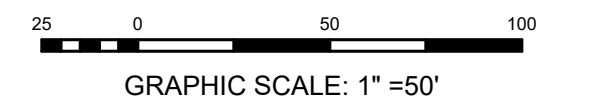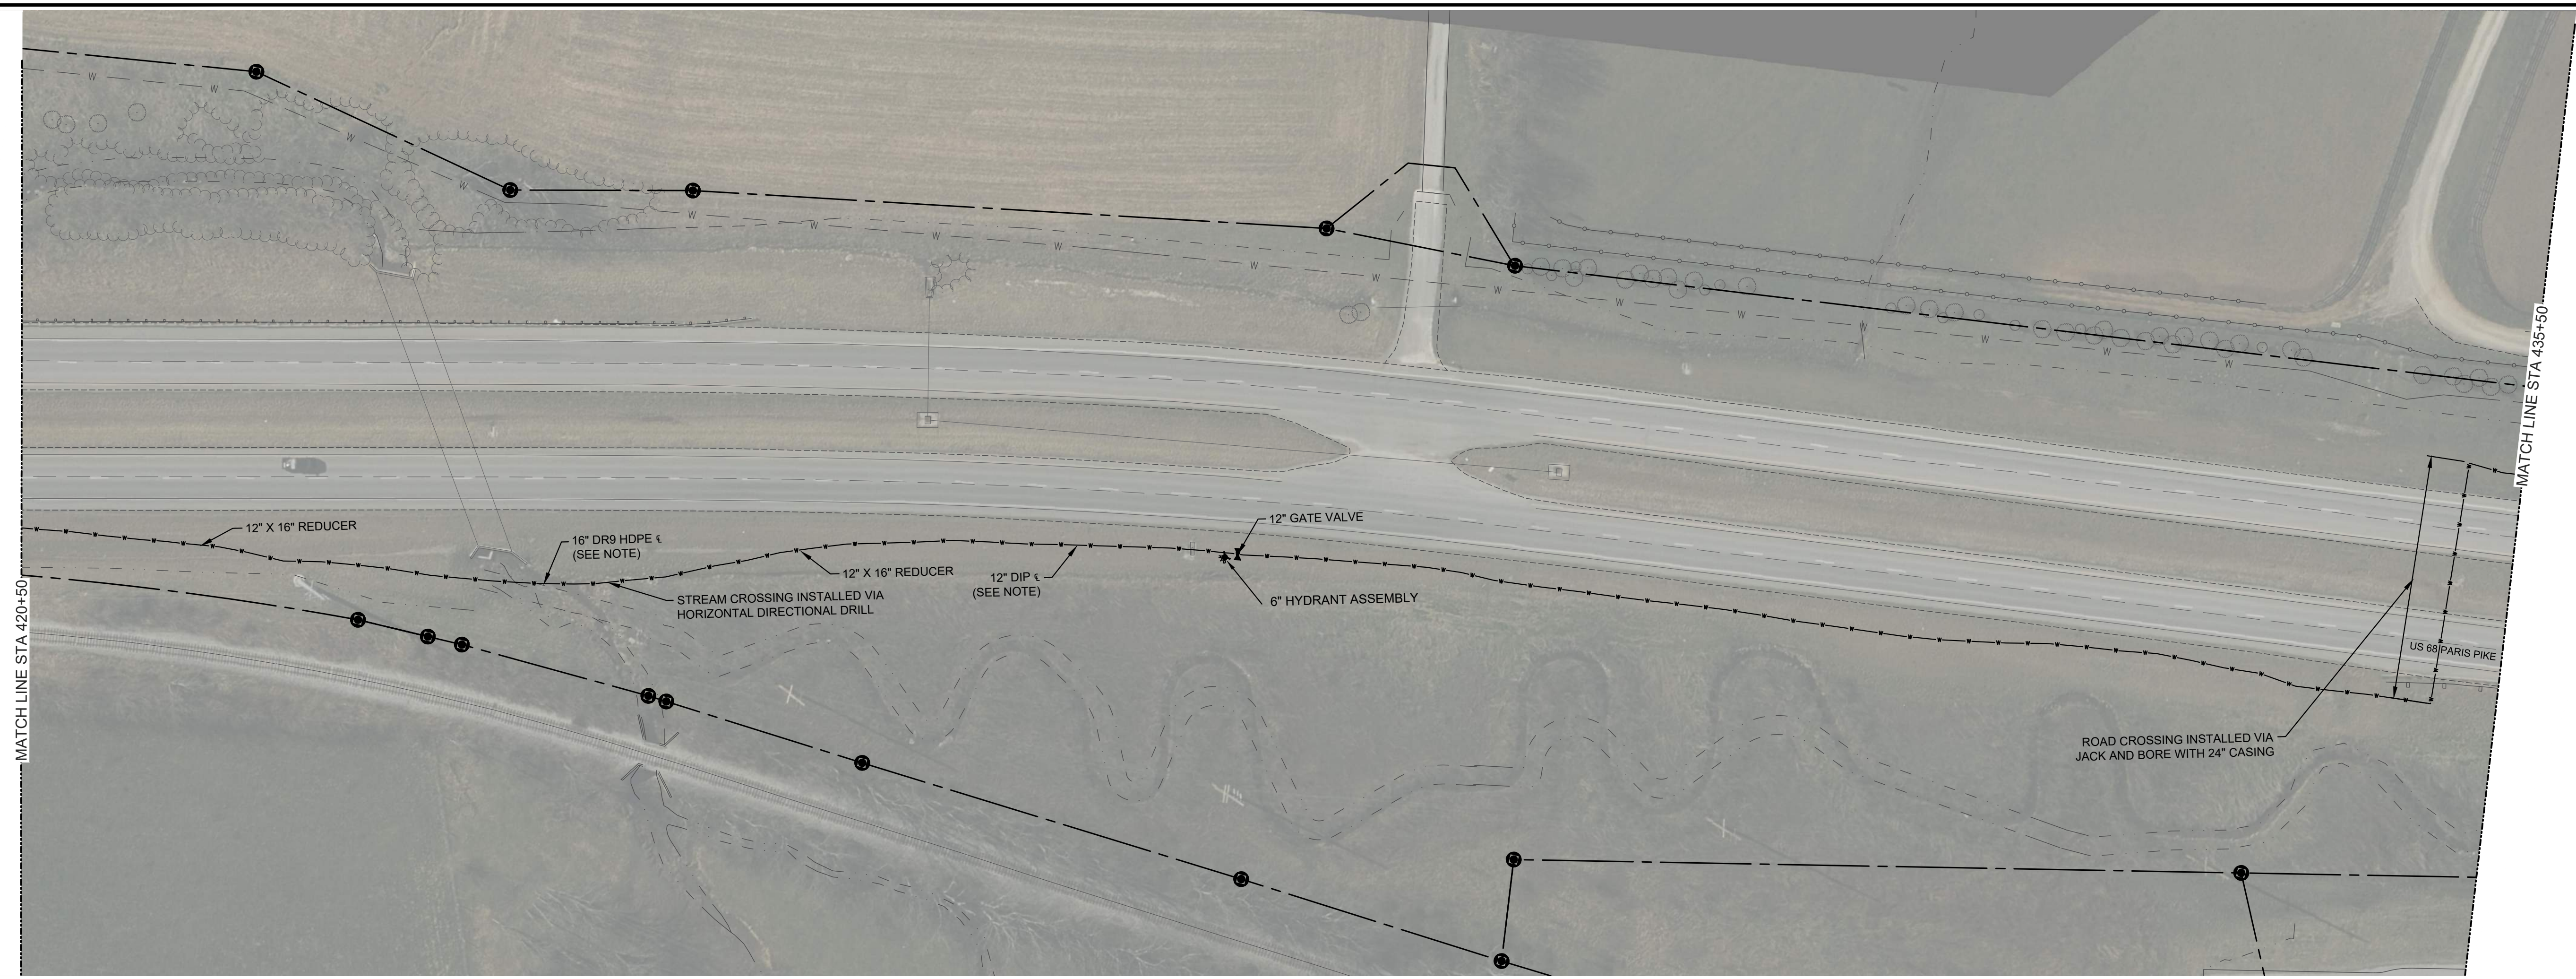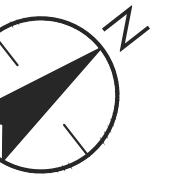

NOTE:
 INFORMATION SHOWN BASED ON FIELD DATA
 COLLECTED BY KENTUCKY AMERICAN WATER.



REVISIONS		REVISIONS		REVISIONS	
A	ISSUED FOR BID 2024-04-03	A		A	
B	ISSUED FOR BID 2024-04-22	B		B	
C	ISSUED FOR CONSTRUCTION 2024-06-19	C		C	
D	AS-BUILT DRAWINGS 2025-05-28	D		D	
E	AS-BUILT DRAWINGS 2026-04-07	E		E	

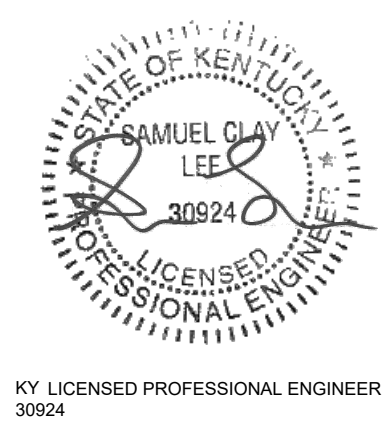

Stantec
 3052 BEAUMONT CENTRE CIRCLE
 LEXINGTON, KENTUCKY 40513
 STANTEC.COM



DRAWN BY: RPG, TCG, BMP, EOK, NBK, ZWP
 PROJECT ENGR: SL

DATE: APRIL 2026

PROJECT: 175569504

MILLERSBURG WATER SUPPLY PROJECT CIVIL STATION 420+50 TO 435+50		
KENTUCKY-AMERICAN WATER COMPANY	MILLERSBURG WATER SUPPLY PROJECT	USE DIMENSIONS ONLY SCALE: AS SHOWN
USE APPROVED DRAWINGS ONLY FOR CONSTRUCTION PURPOSES	AS-BUILT DRAWINGS	C30


P:\Data\2026\04\07_1107 AM Logon\McKnight\Ksley - Project\Millersburg\Drawings\Station 420+50 to 435+50\Civil\Station 420+50 to 435+50\C30.dwg

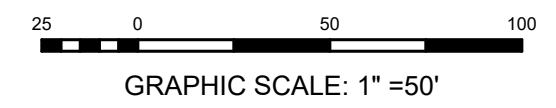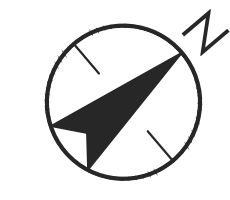

NOTE:
 INFORMATION SHOWN BASED ON FIELD DATA
 COLLECTED BY KENTUCKY AMERICAN WATER.



REVISIONS		REVISIONS		REVISIONS	
△ A	ISSUED FOR BID 2024-04-03	△		△	
△ B	ISSUED FOR BID 2024-04-22	△		△	
△ C	ISSUED FOR CONSTRUCTION 2024-06-19	△		△	
△ D	AS-BUILT DRAWINGS 2025-05-28	△		△	
△ E	AS-BUILT DRAWINGS 2026-04-07	△		△	

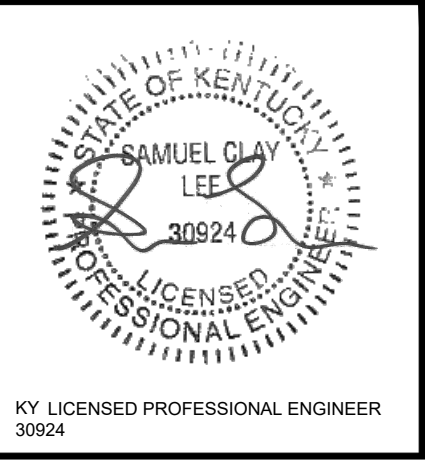

Stantec
 3052 BEAUMONT CENTRE CIRCLE
 LEXINGTON, KENTUCKY 40513
 STANTEC.COM


DRAWN BY: RPG, TCG, BMP, EOK, NBK, ZWP
 PROJECT ENGR: SL

DATE: APRIL 2026

PROJECT: 175569504

MILLERSBURG WATER SUPPLY PROJECT CIVIL STATION 464+00 TO 478+50		
KENTUCKY-AMERICAN WATER COMPANY	MILLERSBURG WATER SUPPLY PROJECT	USE DIMENSIONS ONLY SCALE: AS SHOWN
USE APPROVED DRAWINGS ONLY FOR CONSTRUCTION PURPOSES	AS-BUILT DRAWINGS	C33


P:\Data\2026\04\07_2026 AM Loggin\McGrath, Benley
 Project: Millersburg Water Supply Project - Civil
 Drawing: C33 - AS-BUILT DRAWINGS
 Date: 2026-04-07
 Author: Benley, McGrath
 Checker: Benley, McGrath
 Title: Project Engineer
 Scale: As Shown
 Status: For Construction
 Job No: 175569504

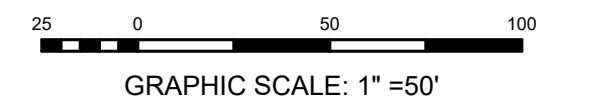

NOTE:
 INFORMATION SHOWN BASED ON FIELD DATA
 COLLECTED BY KENTUCKY AMERICAN WATER.



REVISIONS		REVISIONS		REVISIONS	
	ISSUED FOR BID 2024-04-03				
	ISSUED FOR BID 2024-04-22				
	ISSUED FOR CONSTRUCTION 2024-06-19				
	AS-BUILT DRAWINGS 2025-05-28				
	AS-BUILT DRAWINGS 2026-04-07				

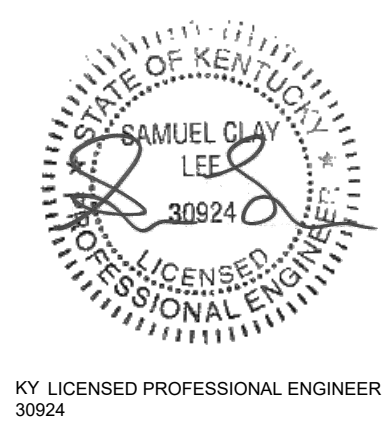

Stantec
 3052 BEAUMONT CENTRE CIRCLE
 LEXINGTON, KENTUCKY 40513
 STANTEC.COM

DRAWN BY: RPG, TCG, BMP, EOK, NBK, ZWP
 PROJECT ENGR: SL




DATE: APRIL 2026

PROJECT: 175569504

MILLERSBURG WATER SUPPLY PROJECT
 CIVIL
 STATION 493+00 TO 507+50

KENTUCKY-AMERICAN WATER COMPANY	MILLERSBURG WATER SUPPLY PROJECT	USE DIMENSIONS ONLY SCALE: AS SHOWN
USE APPROVED DRAWINGS ONLY FOR CONSTRUCTION PURPOSES	AS-BUILT DRAWINGS	C35


P:\Data\2026\04\07_2026 AM Loggin McDrigh-Bentley
 Project: Millersburg Water Supply Project - Civil
 Drawing: STANTEC\Projects\2026\04\07_2026 AM Loggin McDrigh-Bentley\Drawings\AS-BUILT\AS-BUILT DRAWINGS 2026-04-07.dwg
 Date: 2026-04-07 10:24:15 AM
 User: sl

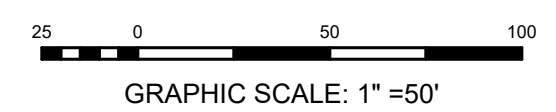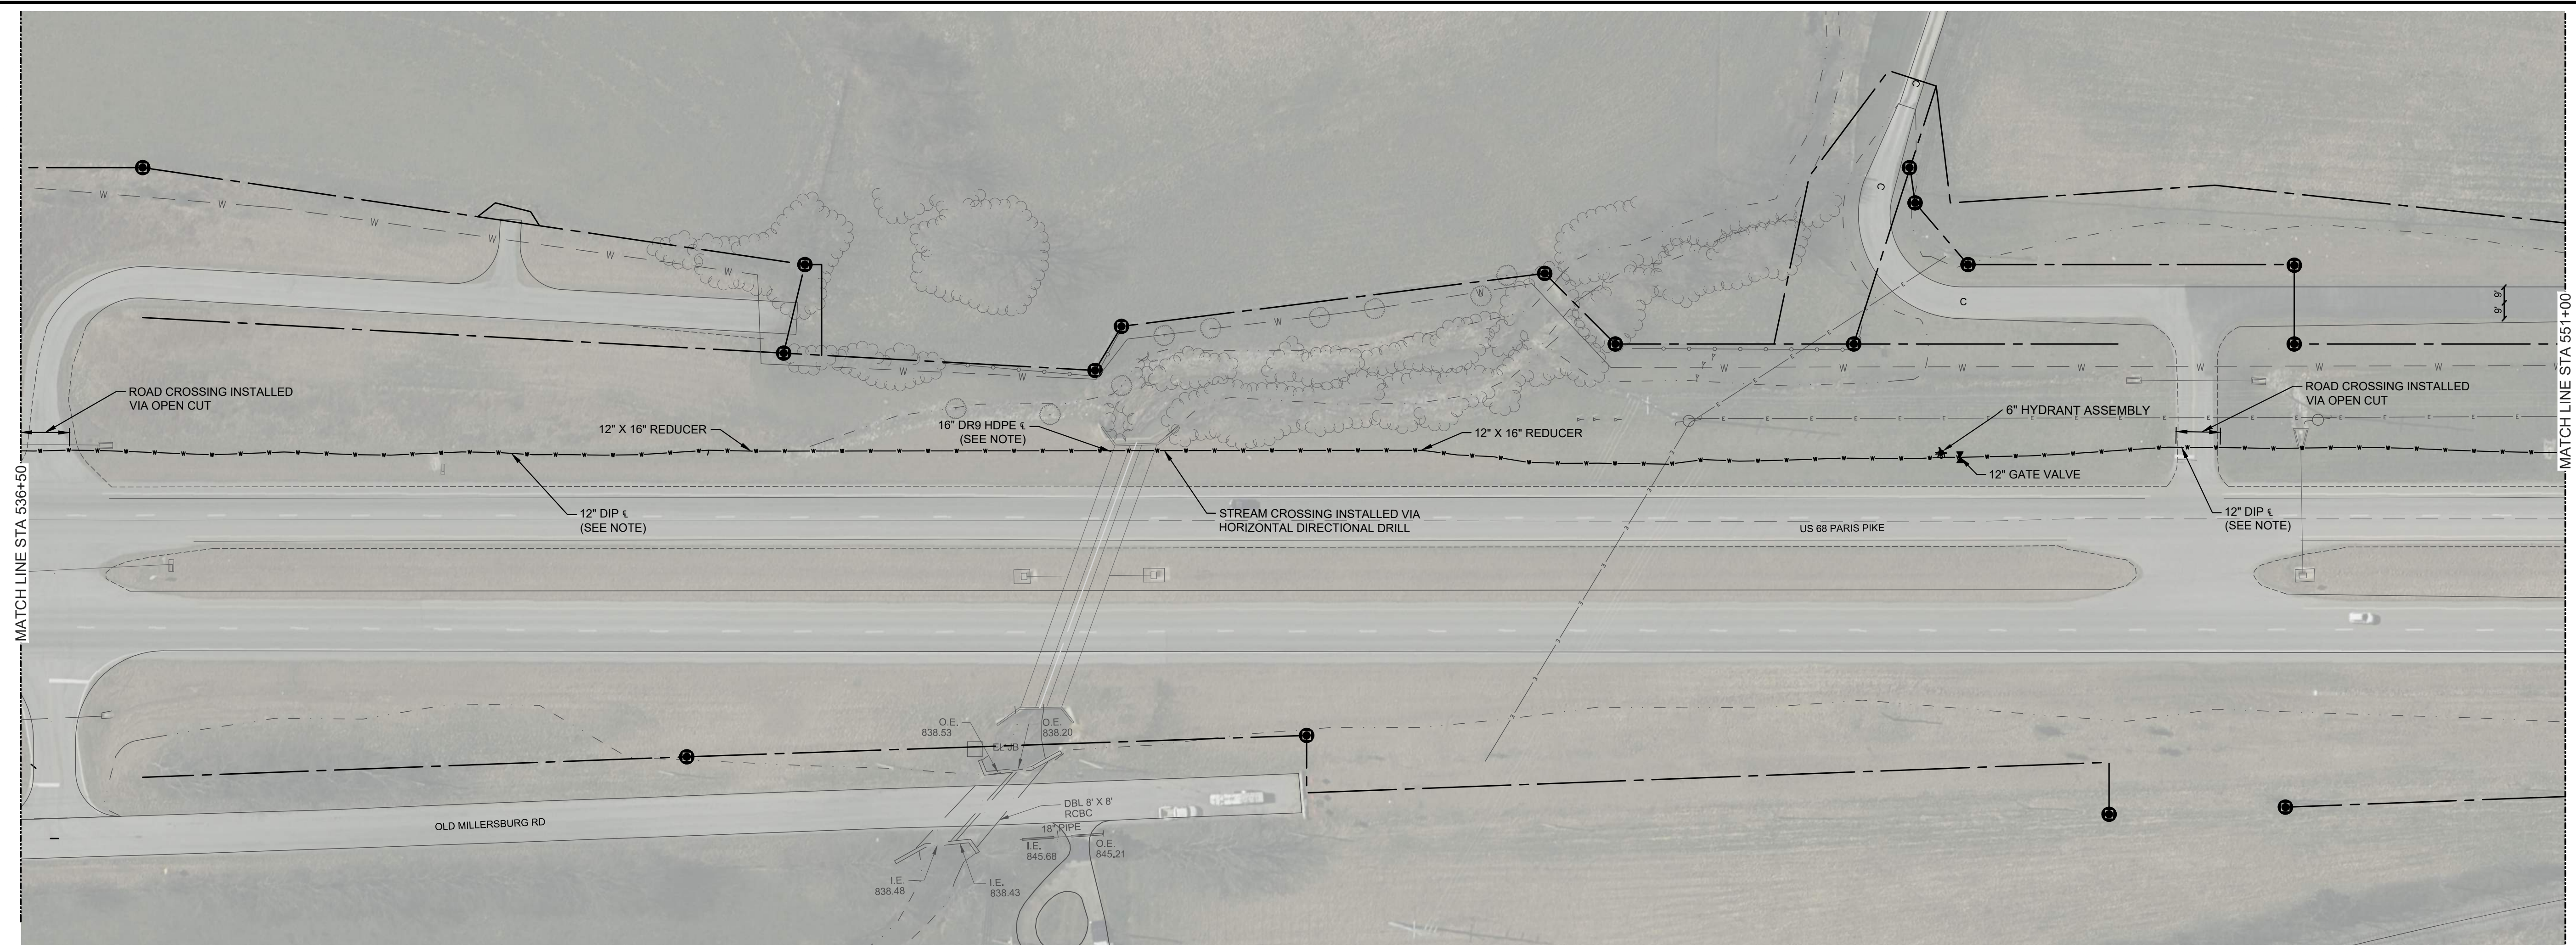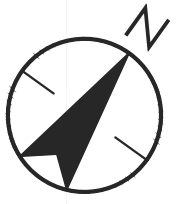

NOTE:
 INFORMATION SHOWN BASED ON FIELD DATA
 COLLECTED BY KENTUCKY AMERICAN WATER.



REVISIONS		REVISIONS		REVISIONS	
△ A	ISSUED FOR BID 2024-04-03	△		△	
△ B	ISSUED FOR BID 2024-04-22	△		△	
△ C	ISSUED FOR CONSTRUCTION 2024-06-19	△		△	
△ D	AS-BUILT DRAWINGS 2025-05-28	△		△	
△ E	AS-BUILT DRAWINGS 2026-04-07	△		△	

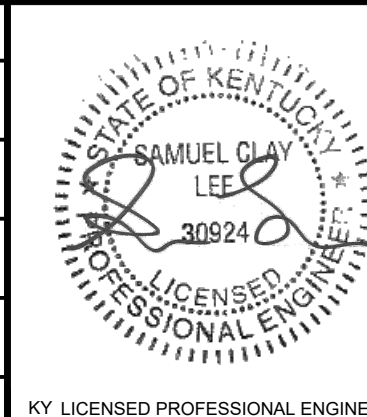

Stantec
 3052 BEAUMONT CENTRE CIRCLE
 LEXINGTON, KENTUCKY 40513
 STANTEC.COM



DRAWN BY: RPG, TCG, BMP, EOK, NBK, ZWP
 PROJECT ENGR: SL

DATE: APRIL 2026

PROJECT: 175569504

MILLERSBURG WATER SUPPLY PROJECT CIVIL STATION 536+50 TO 551+00		
KENTUCKY-AMERICAN WATER COMPANY	MILLERSBURG WATER SUPPLY PROJECT	USE DIMENSIONS ONLY SCALE: AS SHOWN
USE APPROVED DRAWINGS ONLY FOR CONSTRUCTION PURPOSES	AS-BUILT DRAWINGS	C38


P:\Data\2026\04\07_2026 AM Loggin McDrigh-Bentley
 Project: Millersburg Water Supply Project - Station 536+50 to 551+00
 Drawing: Station 536+50 to 551+00 - Civil
 Date: 2026-04-07 10:58:00 AM
 User: samuel.clay@stantec.com

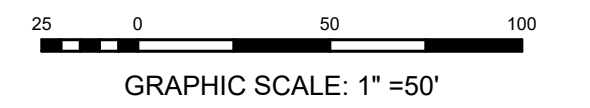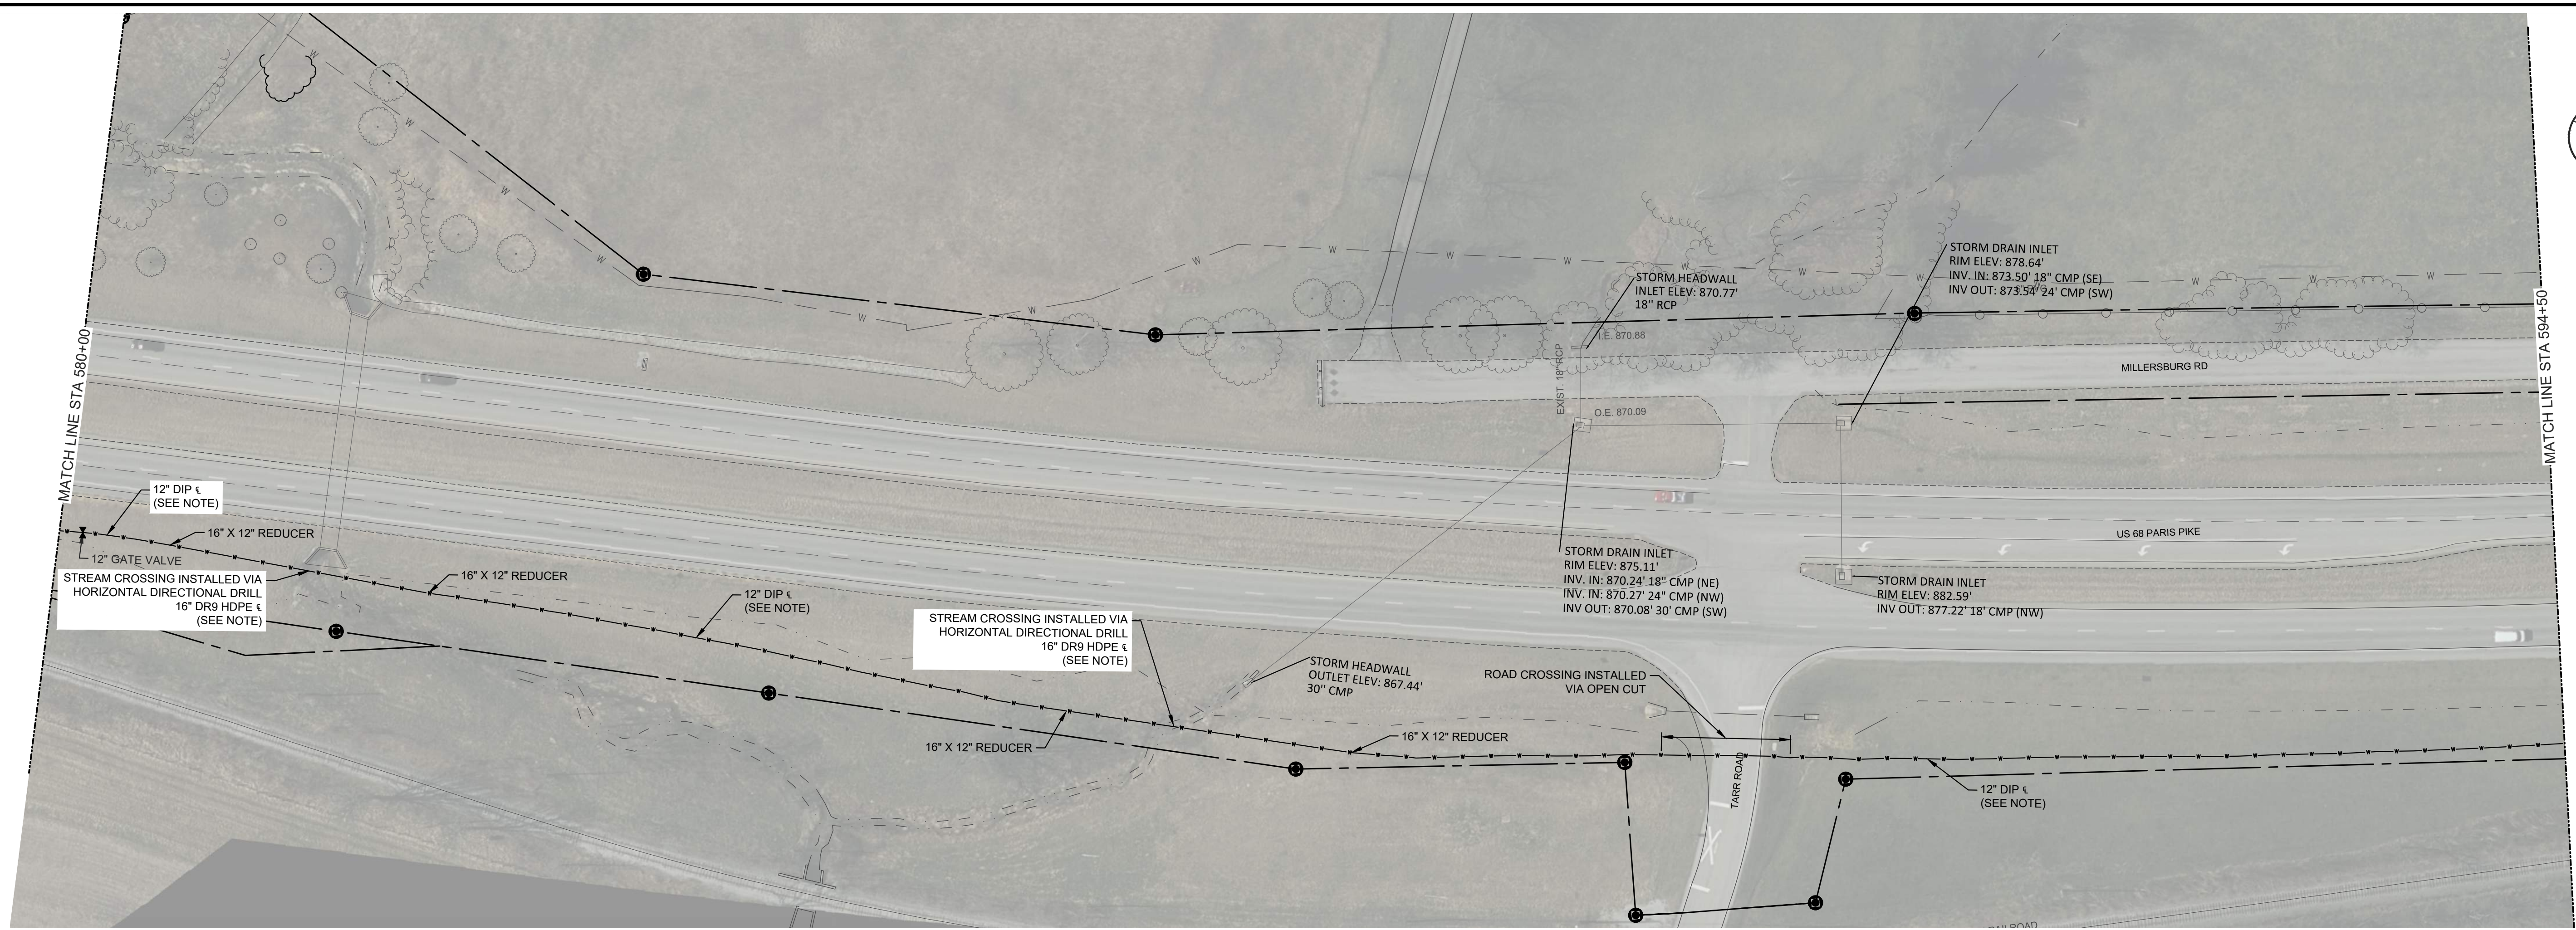

NOTE:
 INFORMATION SHOWN BASED ON FIELD DATA
 COLLECTED BY KENTUCKY AMERICAN WATER.



REVISIONS		REVISIONS		REVISIONS	
A	ISSUED FOR BID 2024-04-03	A		A	
B	ISSUED FOR BID 2024-04-22	B		B	
C	ISSUED FOR CONSTRUCTION 2024-06-19	C		C	
D	AS-BUILT DRAWINGS 2025-05-28	D		D	
E	AS-BUILT DRAWINGS 2026-04-07	E		E	

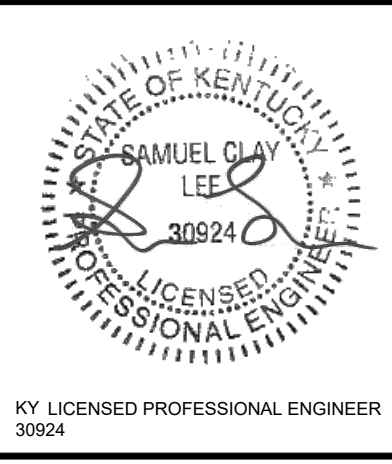

Stantec
 3052 BEAUMONT CENTRE CIRCLE
 LEXINGTON, KENTUCKY 40513
 STANTEC.COM

DRAWN BY: RPG, TCG, BMP, EOK, NBK, ZWP
 PROJECT ENGR: SL

DATE: APRIL 2026

PROJECT: 175569504

**MILLERSBURG WATER SUPPLY PROJECT
 CIVIL
 STATION 580+00 TO 594+50**

KENTUCKY-AMERICAN WATER COMPANY	MILLERSBURG WATER SUPPLY PROJECT	USE DIMENSIONS ONLY SCALE: AS SHOWN
USE APPROVED DRAWINGS ONLY FOR CONSTRUCTION PURPOSES	AS-BUILT DRAWINGS	C41

File Date: 2026/04/07 3:47 PM | User: Mchugh | Path: \\p01\projects\2024\Millersburg\Drawings\Civil\580+00 to 594+50\C41.dwg | Plot Date: 2026/04/07 3:47 PM | Plot Path: \\p01\projects\2024\Millersburg\Drawings\Civil\580+00 to 594+50\C41.dwg | Plot Scale: 1"=50' | Plot Orientation: Landscape | Plot Color: Black | Plot Lineweight: 0.20 | Plot Linetype: Solid | Plot Font: Arial | Plot Font Size: 10 | Plot Font Color: Black | Plot Font Weight: Normal | Plot Font Style: Regular | Plot Font Orientation: Horizontal | Plot Font Underline: None | Plot Font Color: Black | Plot Font Weight: Normal | Plot Font Style: Regular | Plot Font Orientation: Horizontal | Plot Font Underline: None

