

# HAROLD SEWER PROJECT (PRIDE ON THE RIVER)

## PHASES 1 & 2: SX21195121/SX21071218 CONTRACT 1 - WASTEWATER TREATMENT PLANT FLOYD COUNTY, KENTUCKY

### OWNER:

**Southern Water and Sewer District**  
245 KY Route 680  
McDowell, KY 41647

#### SOUTHERN WATER & SEWER BOARD MEMBERS

- 1) Paula Johnson (Chairman)
- 2) Hayes Hamilton
- 3) Scarlet Stumbo
- 4) Bert Layne
- 5) Cleveland Tackett



#### SOUTHERN WATER & SEWER DISTRICT OPERATIONS CREW

Office - (606) 377-9296 Mon-Thurs 8am-4pm, Fri 8am-2pm.  
After Hours contact 606-874-2007.

- 1) Hubert Halbert (SWSD Manager) mobile: 606-791-6622
- 2) Dean Hall (Water and Sewer Systems Operator) mobile: 606-794-884
- 3) Anthony Castle (Wastewater Plants Operator) mobile: 606-454-9974
- 4) Gary Hillbrook (Part-time Wastewater Plants Operator) mobile: 606-226-9960

#### EMERGENCY CONTACT NUMBERS

| NOTICE YOU NO. (NO)   |  |   |
|---|--|---|
| 1-800-734-6667<br>2-12 Business Days Prior to Digging.  |  |   |
| <b>Water &amp; Sewer</b>  | <b>TV &amp; Fiber Optic</b>  | <b>Gas (Continued)</b>  |
| Dean Hall<br>Southern Water and Sewer<br>245 KY Route 680<br>McDowell, KY 41647<br>(606) 377-9296                           | Jim Kubic<br>Sullivan Lutz<br>PO Box 1219<br>Mt. Cay NY 20381<br>(304) 987-4727 (cell) | David Barnes<br>Inverness Crs<br>347 Thompson Road<br>Pleasant, Ky 41581<br>(606) 437-8147  |
| <b>Power</b>  | <b>Intermountain Cable</b>   | <b>Bus Bus</b>  |
| Case Sumner<br>207<br>5149 North Way Trail<br>Franklin, KY 41501<br>Office (606) 437-3814<br>Cell (606) 213-3702            | Roy Heron<br>(606) 478-9408 x222   | B & H Gas Company<br>P.O. Box 155<br>Harold, KY 41625<br>(606) 478-3851   |
| <b>Phone</b>  | <b>Gas</b>   | <b>Drug Businesses</b>  |
| Bill South<br>Jack Carter<br>78 West Branch<br>Providence, Kentucky 41591<br>1-800-433-7791                                 | Ann Rogers<br>Knox Building<br>PO Box 159<br>Aman, KY 41601<br>(606) 477-5638          | Cherokee Livery<br>4278 KY Route 585<br>Cappell, KY 41621<br>(606) 284-9402 ext. 62671  |
| <b>KITC</b>   | <b>Army Oil &amp; Gas (Service)</b>  | <b>Kentucky &amp; West Virginia Gas Company</b><br>(Available Gas Company - Near Supplier)<br>Pay Auditor-Permit Field Inspector<br>City, Office Contact<br>Providence, Kentucky 41593<br>1-800-368-7223-Pay Auditor<br>1-800-688-2311-Office |
| Kentucky Department of<br>Transportation<br>District 13<br>108 Lanning Street<br>Franklin, Kentucky 41501<br>1-800-433-7791 | 2433 Sand Creek Rd<br>Providence, KY 41501<br>(606) 437-7897                           | <b>Kentucky State Planning Inspector</b>  |
| <b>Inspection</b>   | <b>Cherokee Natural Resources</b>  | Hyatt County, KY<br>Franklin, KY<br>Stanley, KY<br>P.O. Box 158<br>Providence, Kentucky 41593<br>1-800-433-7791   |
| Tom Harts<br>Noland Street<br>1-800-433-7830  | Cherry, Kentucky 41603<br>P.O. Box 158<br>Providence, Kentucky 41593<br>1-800-433-7791 |   |

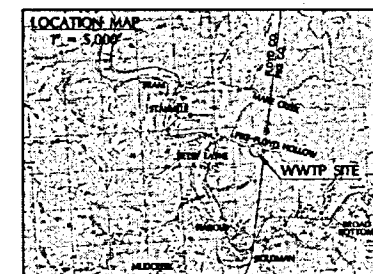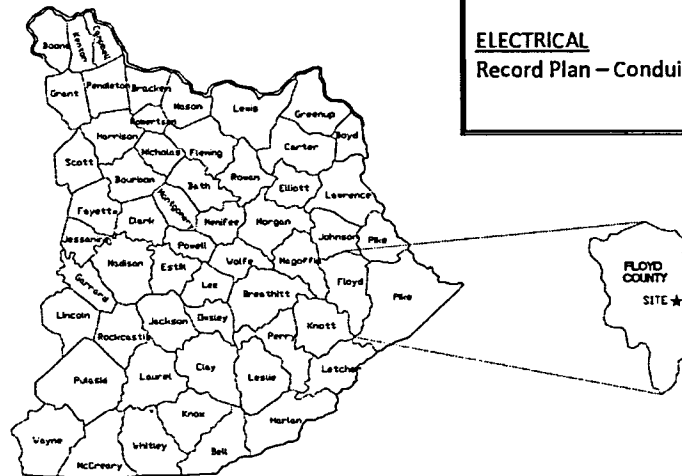

### INDEX OF DRAWINGS

#### GENERAL SHEETS

Cover Sheet G-1

#### CIVIL - SITE

Dimension Control and Final Surfaces C-1

Record Plan - Yard Pipe Runs C-5

#### PLANT PROCESSES

Headworks - Plan and Section Views P-1

Phase 1 - 100,000 GPD WWTP - Plan and Section Views P-2

Phase 1 - 100,000 GPD WWTP - Section Views P-3

Chlorine Contact and Post Aeration - Plan and Section Views P-4

#### ARCHITECTURAL

Bevco Building #1 - Hypochlorite Chemical Building A-1

#### ELECTRICAL

Record Plan - Conduit Plans

HAROLD SEWER PROJECT PHASES 1 & 2 - CONTRACT 1 WWTP  
PROJECT PLANS (05-4517503.006)

PLANS PREPARED BY:  
**SUMMIT ENGINEERING, INC.**

120 PROSPEROUS PLACE, SUITE 101  
LEXINGTON, KENTUCKY 40509  
(859) 264-9860

Record Drawing  
December 2013